

O.D.O.T. DISTRICT 2 SURVEY OFFICE (USE ONLY)

PERSONNEL \_\_\_\_\_ REFERENCE NO. 22 C SHEET 10 OF 35  
 NOTES BARNHISEL DATE 4/14/92 ROUTE US 25  
 H.C. VAN DUSEN WEATHER CLOUDY COUNTY WOOD  
 R.C. BARNHISEL TEMP. 40° TOWNSHIP PLAIN  
 DWG BY RHOADES PID \_\_\_\_\_ SECTION 25  
 T 5 N R 10 E

TYPE MONUMENT P.K.NAIL

ON SURFACE - ~~BELOW~~ ON \_\_\_\_\_


OFFSET  $\phi$  PAVEMENT ON \_\_\_\_\_ LT : RT

22.3' TO LT CURB

STATION: 496+51


HORIZ.DATUM: \_\_\_\_\_ GEOID: \_\_\_\_\_

GRID: NORTHING: \_\_\_\_\_ EASTING: \_\_\_\_\_

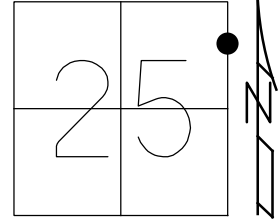

RECORD:  
 FD P.K.NAIL  
 4/14/92, MB  
 SET P.K./WASHER  
 9/18/92, MB

SET SHI  
 CONC.WALK  
 JOINT  
 0.8' FR/EDGE

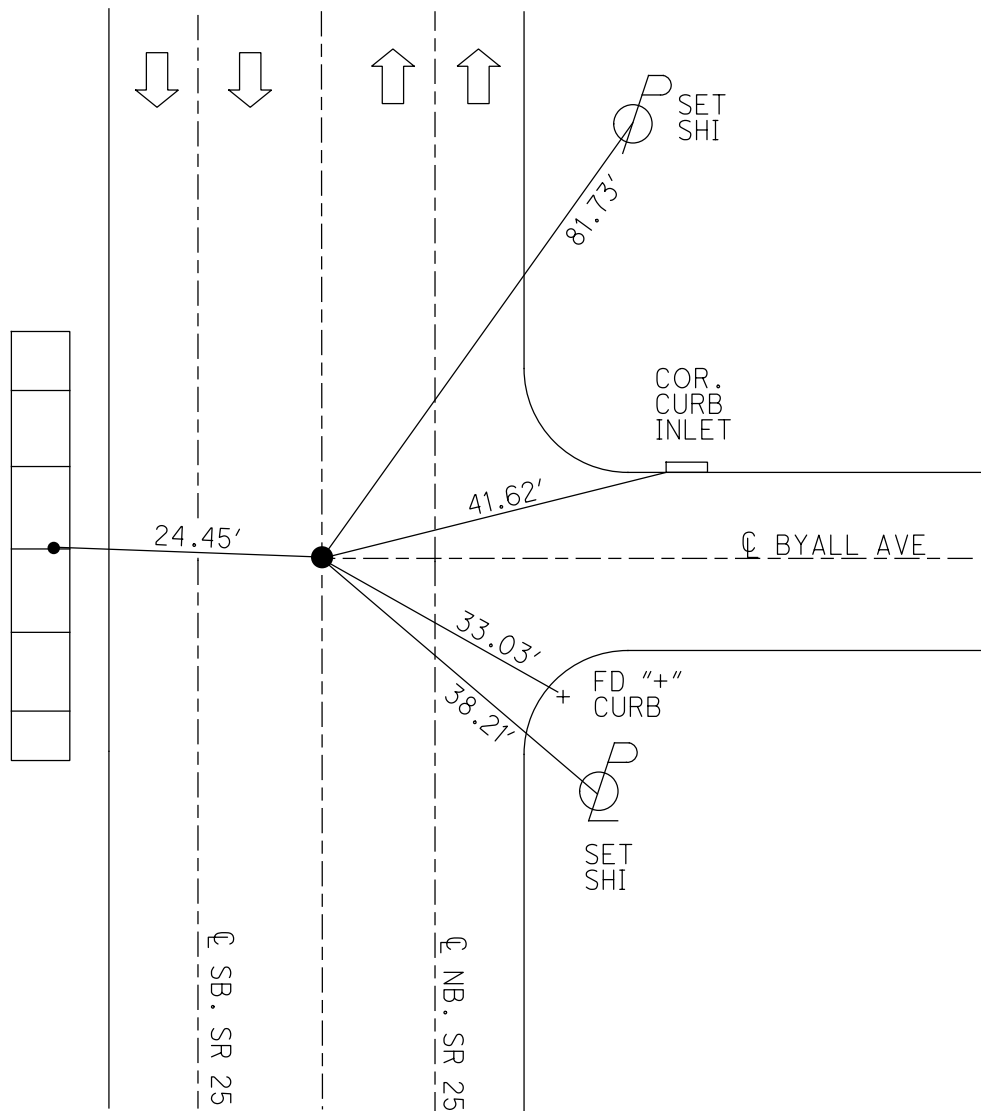

# O.D.O.T. DISTRICT 2 SURVEY OFFICE

PERSONNEL

REFERENCE NO. 22-C

SHEET 5 OF 22

NOTES BARNHISEL

H.C. VAN DUSEN

R.C. BARNHISEL

DATE 4-14-92

WEATHER cloudy

TEMP. +40°

ROUTE U.S. 25

COUNTY WOOD

TOWNSHIP PLAIN

SECTION 25

T. 5 N R. 10 E


TYPE MONUMENT P.K. NAIL

ON SURFACE - BELOW YES

LEFT - & PAV'T. - RIGHT YES



22.3 TO LT. EDGE PAVEMENT CURB

S.L.M. 496+51

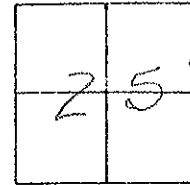

Set PK & WASHER  
9-18-72  
MB

Set Shi  
IN JOINT OF  
S.WALK  
0.8' IN FROM  
E. Edge

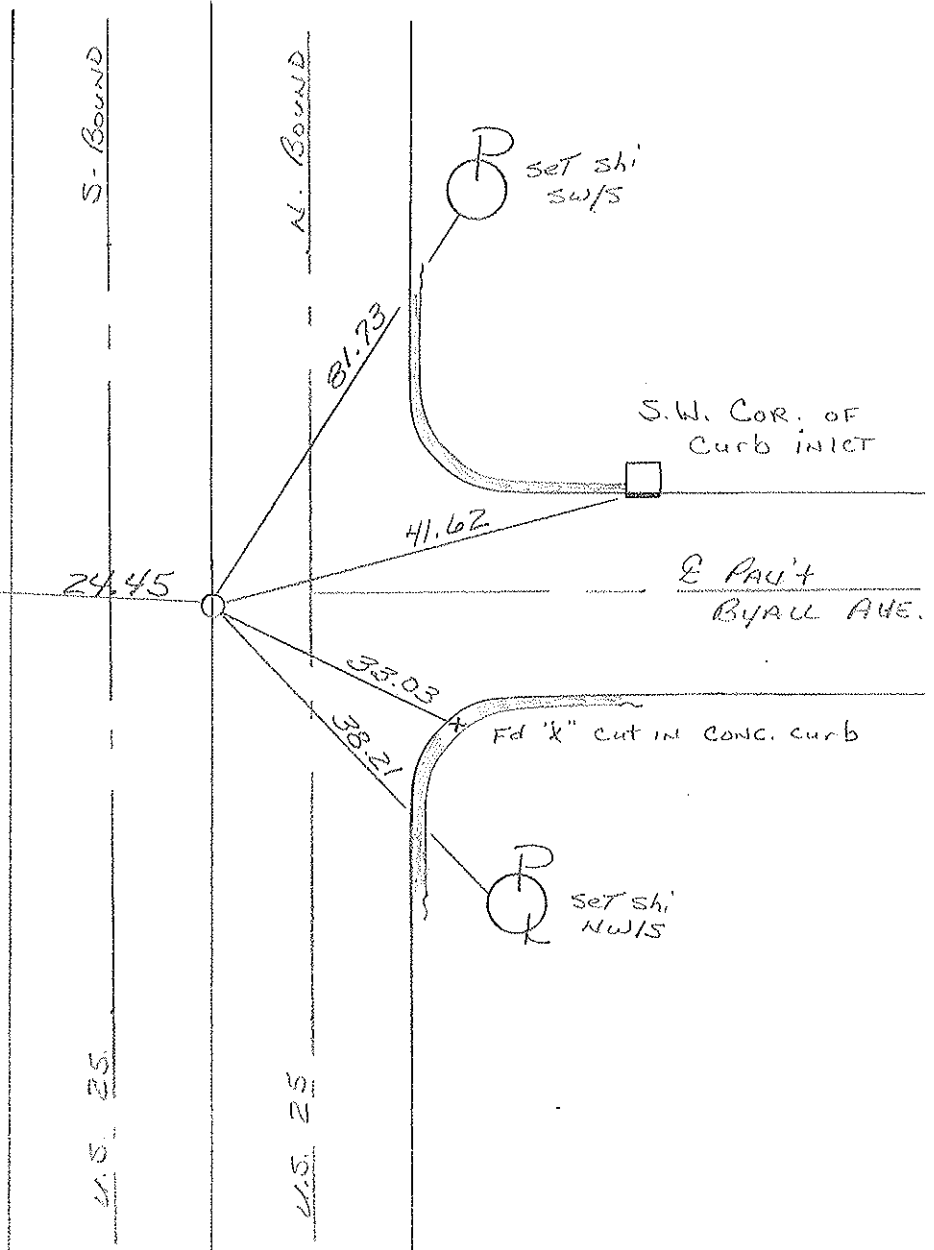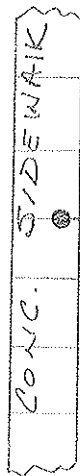

O.D.O.T. DISTRICT 2 SURVEY OFFICE

SHEET OF

County WOOD <sup>U.S.</sup> ~~S.R.~~ 25

Date 3-26-75

Township PLAIN

Weather PT. CLOUDY

Section 25


Temp. 26°

T5N, R10E


Personnel BURNSIDE

SMITH


BOWERS

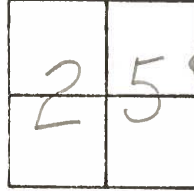


22-C-22D

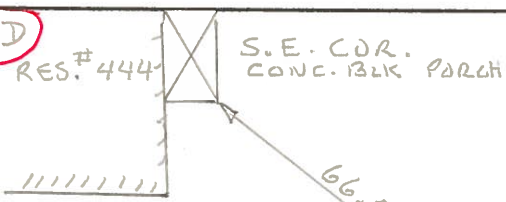

FD. P.K. NAIL @ SURFACE

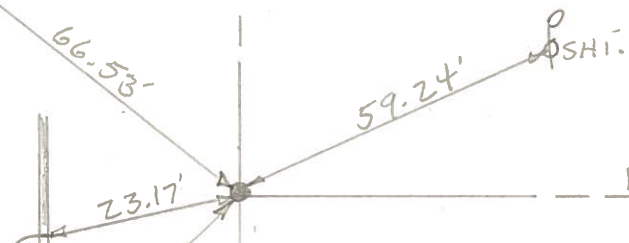

PALMER AVE

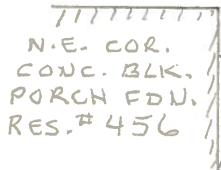


U.S. 25

FD. P.K. NAIL @ SURFACE

"4" CUT IN WALK 6" ± W. OF E. EDGE



24.19'

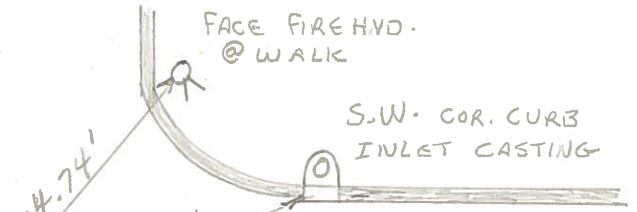

BYALL AVE

33.03'

"4" CUT TOP CONC. CURB

