

O.D.O.T. DISTRICT 2 SURVEY OFFICE (USE ONLY)

PERSONNEL

REFERENCE NO. 22 D

SHEET 11 OF 35

NOTES BARNHEISEL

DATE 4/14/92

ROUTE US 25

H.C. VAN DUSEN

WEATHER CLOUDY

COUNTY WOOD

R.C. BARNHEISEL

TEMP. 40°

TOWNSHIP PLAIN

SECTION 25

DWG BY RHOADES PID _____

T 5 N R 10 E

TYPE MONUMENT P.K.NAIL

ON SURFACE - ~~BELOW~~ ON

OFFSET C PAVEMENT ON LT : RT

22.3' TO LT CURB


STATION: 499+53

HORZ.DATUM: _____

GEOID: _____

GRID: NORTHING: _____

EASTING: _____

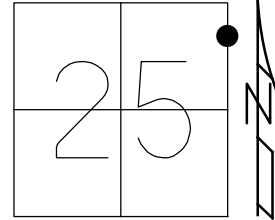


RECORD:
FD P.K.NAIL
4/14/92, MB
SET P.K./WASHER
9/18/92, MB



COR.CONC.
BLOCK PORCH
TOP 2ND BLK
UP



COR.CONC.
BLOCK PORCH
TOP 2ND BLK
UP

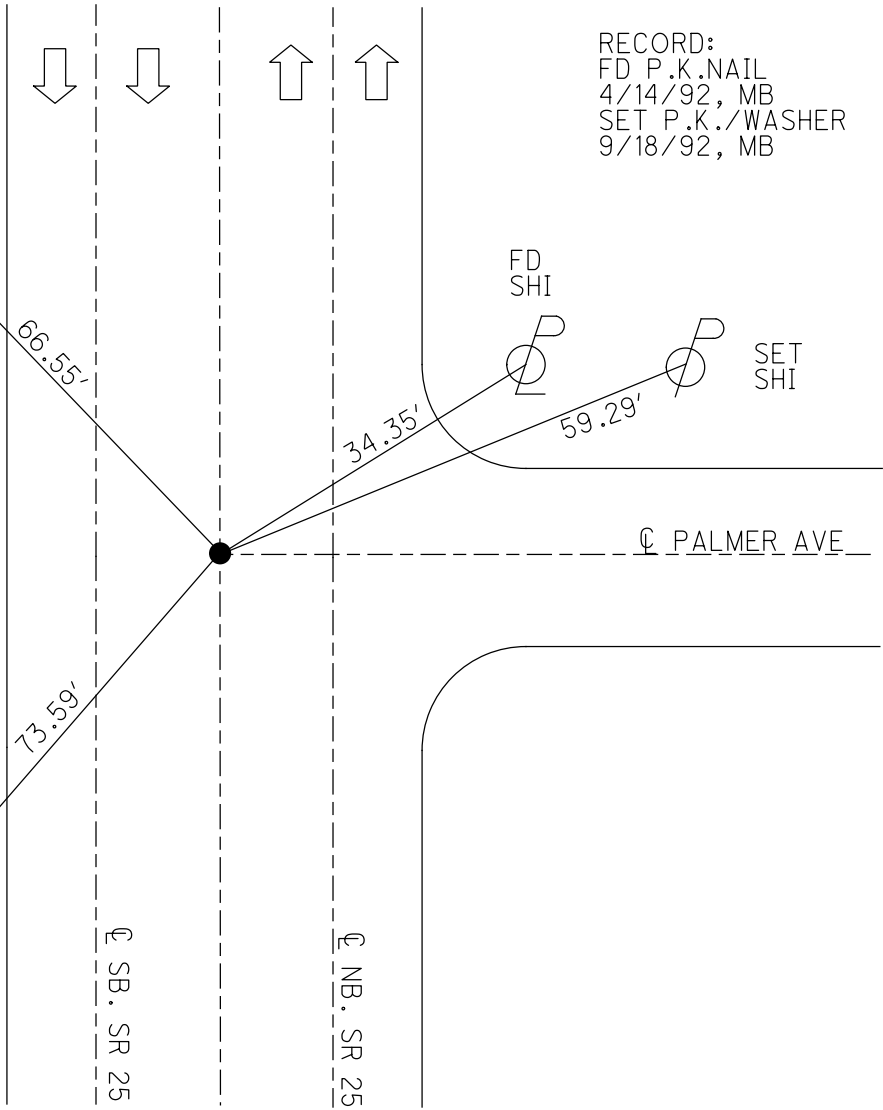

O.D.O.T. DISTRICT 2 SURVEY OFFICE

PERSONNEL

REFERENCE NO. 22 D

SHEET 6 OF 22

NOTES BARNHISEL

H.C. VAN DUSEN

DATE 4-14-92

ROUTE 115.25

R.C. BARNHISEL

WEATHER cloudy

COUNTY Wood

TEMP. +40°

TOWNSHIP Philm

SECTION 25

T. 5 N. R. 10 E.


TYPE MONUMENT P.K. NAIL

ON SURFACE - BELOW YES




LEFT - & PAV'T. - RIGHT YES

22.3 TO LT. EDGE PAVEMENT curb

S.L.M. 499+53

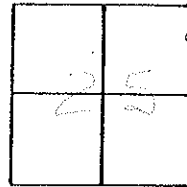

SET PK + WASHER
9-10-92
mB

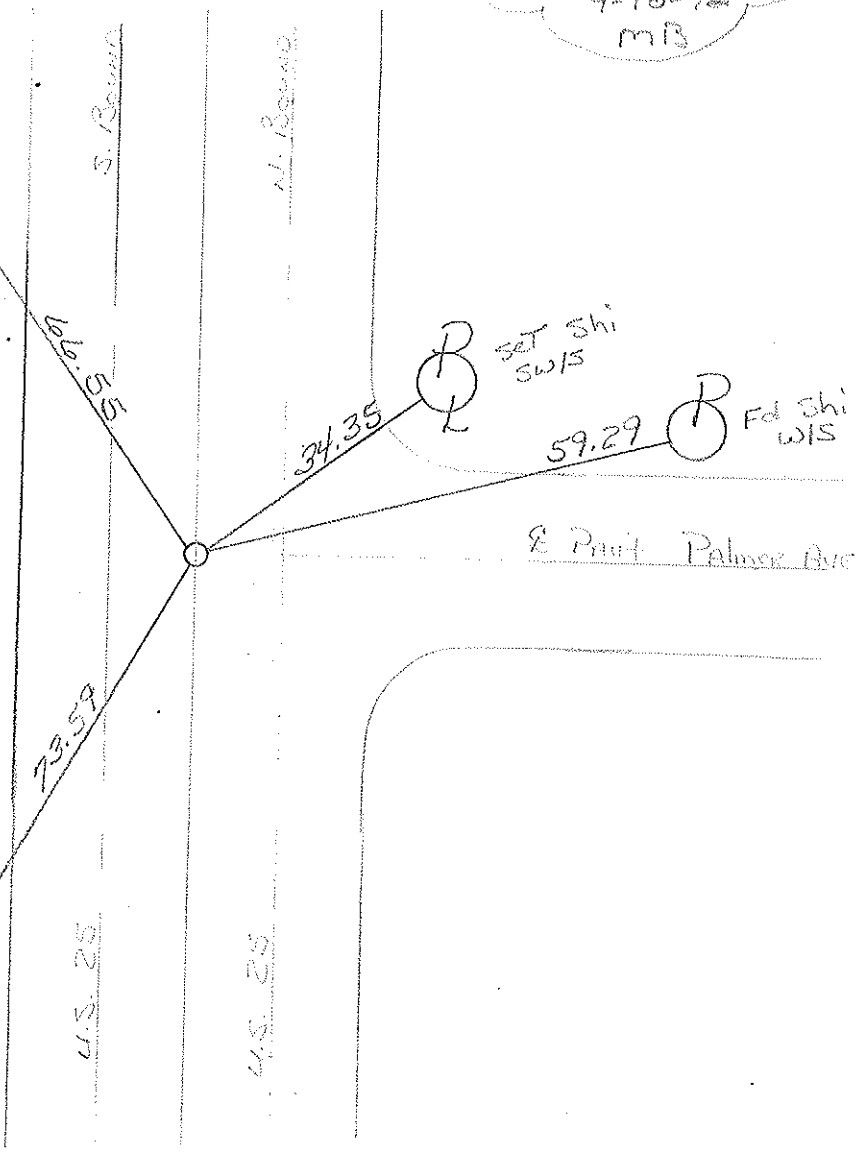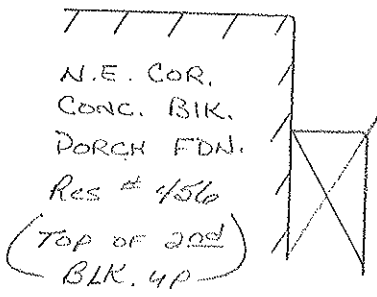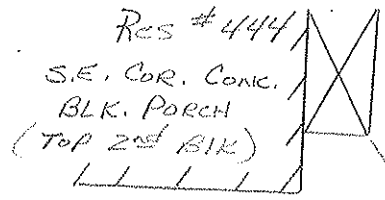

O.D.O.T. DISTRICT 2 SURVEY OFFICE

SHEET OF

County WOOD ^{U.S.} ~~S.R.~~ 25

Date 3-26-75

Township PLAIN

Weather PT. CLOUDY

Section 25

Temp. 26°

T5N, R10E

Personnel BURNSIDE

SMITH

BOWERS

