

O.D.O.T. DISTRICT 2 SURVEY OFFICE (USE ONLY)

PERSONNEL

REFERENCE NO. 24

SHEET 15 OF 35

NOTES BARNHEISEL

DATE 6/14/01

ROUTE US 25

H.C. CANTERBURY

WEATHER SUNNY

COUNTY WOOD

R.C. MOSER

TEMP. 90°

TOWNSHIP PLAIN

SECTION 24

DWG BY RHOADES

PID \_\_\_\_\_

T 5 N R 10 E

TYPE MONUMENT P.K./WASHER

ON SURFACE - ~~BELOW~~ ON \_\_\_\_\_

OFFSET  $\odot$  PAVEMENT 2.5' ~~LT~~ : RT

- TO - EDGE PAVEMENT


STATION: 522+90

HORZ. DATUM: \_\_\_\_\_

GEOID: \_\_\_\_\_

GRID: NORTHING: \_\_\_\_\_

EASTING: \_\_\_\_\_

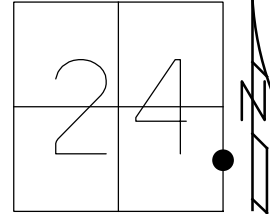

RECORD:  
FD R.R. SPIKE  
6/10/92, MB  
SET P.K./WASHER  
9/18/92, MB  
FD P.K./WASHER  
6/14/01, MB

NOTE:  
SR 64 REF 3Q

CHILDREN'S  
CLOTHING STORE

TRAVEL AGENCY

MID. OF  
DOOR JAM

MID. 3RD  
BRICK

62.77'

50.41'

$\odot$  SR 64-WOOSTER ST

1.3'S.

MID. 2ND  
BRICK

BOTTOM  
COLUMN ABOVE  
CROWN MOLDING

52.21'

50.16'

RAYLE & STEARNS  
ATTORNEYS

UHLMAN'S CLOTHING  
STORE

$\odot$  SB. SR 25

$\odot$  NB. SR 25

# O.D.O.T. DISTRICT 2 SURVEY OFFICE

PERSONNEL

REFERENCE NO. 24

SHEET 10 OF 22

NOTES BARNHISEL ✓

6-14-01

H.C. VAN DUSEN MC

DATE 6-10-92

ROUTE U.S. 25

R.C. BURNETT Mason

WEATHER SUNNY

COUNTY WOOD

TEMP. +65° 90

TOWNSHIP PLAIN

SECTION 24

T 5 N R 10 E

TYPE MONUMENT Sm RR Spk


ON SURFACE - ~~WOOD~~ yes ✓

~~EST~~ - PAV'T. - RIGHT 2.5 ✓

— TO — EDGE PAVEMENT

S.L.M. 522+90

1.3 S. OF E WEST

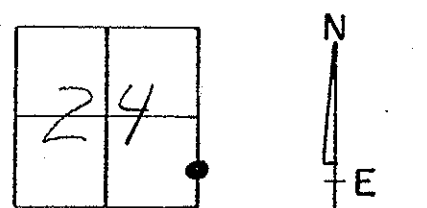

Black Pen 15 TO WOOD HUB Fed in Conc  
9-26-01

Set PK + WASHER  
9-18-92  
MB

COR. CONC. FDN.  
OF BRK FRONT  
at WALK

Children's  
CLOTHING STORE

Middle  
2nd  
OF DECK JAW

S. Bound

N. Bound

S.W. COR. CONC.  
FDN. FOR BRK  
PILLAR @ WALK

TRAVEL AGENCY

Middle 3rd

58.70

49.40

50.30

E PAVT

WOOSTEC ST.

62.55

53.30

49.70

52.15

54.19

Middle  
2nd  
BRICK

N.E. COR. CONC.  
FDN. OF BRK  
BLDG. at WALK

RAYLE & STEARNS  
ATTORNEYS

U.S. 25

U.S. 25

MID. COR. OF GAP OVER  
1/2" PILLAR 4" ABOVE  
WALK

LILMAN'S CLOTHING  
STORE

Bottom of Column  
ABOVE Crown molding

# O.D.O.T. DISTRICT 2 SURVEY OFFICE

PERSONNEL

REFERENCE NO. 24

SHEET 10 OF 22

NOTES BURNETT

H.C. VAN DUSEN

DATE 6-10-92

ROUTE 66.25

R.C. BURNETT

WEATHER SUNNY

COUNTY Wood

TEMP. +65°

TOWNSHIP Plain

SECTION 24

T.S. & R. 10 E


TYPE MONUMENT Sm RR Spk

ON SURFACE - BELOW yes

LEFT - & PAV'T. - RIGHT 2.5

— TO — EDGE PAVEMENT

S.L.M. 522+90 1.3 S. OF & WEST

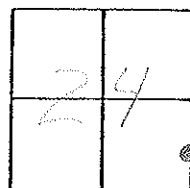

Set PK & WASHER  
9-18-92  
MB

COR. CONC. FDN.  
OF BRK FRONT  
at WALK

Children's  
CLOTHING STORE

S.W. COR. CONC.  
FDN. FOR BRK  
PILLAR @ WALK

TRAVEL AGENCY

& PAVL

WOODCOCK ST.

N.E. COR. CONC.  
FDN. OF BRK  
BLDG. at WALK

RAYLE & STEARNS  
ATTORNEYS

N.W. COR. OF CAP OVER  
1/2" PILLAR 4" ABOVE  
WALK

WILMAN'S CLOTHING  
STORE

S. Bound

N. Bound

52.15

62.53

49.70

50.30

U.S. 25

U.S. 25

# O.D.O.T. DISTRICT 2 SURVEY OFFICE

PERSONNEL

NOTES BRENNISEL

H.C. VAN DUSEN

R.C. BURNETT

REFERENCE NO. 24

SHEET 10 OF 22

3Q = SR64

DATE 6-10-92

WEATHER SUNNY

TEMP. +65°

ROUTE U.S. 25

COUNTY WOOD

TOWNSHIP PLAIN

SECTION 24

T. 5 N. R. 10 E

TYPE MONUMENT Sm RR Spk


ON SURFACE - ~~BELOW~~ YES

~~SET~~ - € PAV'T. - RIGHT 2.5

— TO — EDGE PAVEMENT

S.L.M. 522+90

1.3 S. OF € WEST

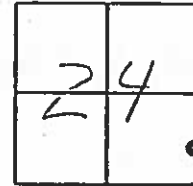

SET PK + WASHER  
9-18-92  
MB

COR. CONC. FDN. OF BRK FRONT at WALK

Children's CLOTHING STORE

S. Bound

N. Bound

S.W. COR. CONC. FDN. FOR BRK PILLAR @ WALK

TRAVEL AGENCY

50.30

€ PAV'T

WOOSTER ST.

62.53

52.15

49.70

N.E. COR. CONC. FDN. OF BRK BLDG. at WALK

RAYLE & STEARNS ATTORNEYS

U.S. 25

U.S. 25

N.W. COR. OF CAP OVER 1/2" PILLAR 4" ABOVE WALK

UHLMAN'S CLOTHING STORE

O.D.O.T. DISTRICT 2 SURVEY OFFICE

SHEET \_\_\_\_\_ OF \_\_\_\_\_

County WOOD <sup>U.S.</sup> ~~S.R.~~ 25

Date 3-25-76

Township PLAIN

Weather CLEAR

Section 24

Temp. 51°


T5N, R10E

Personnel BURNSIDE

SMITH

BOWERS

MEAD

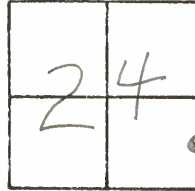

#24

EOR. CONC. FDN.  
OF BRICK FRONT  
@ WALK  
CLOTHES STORE

S.W. COR. CONC. FDN.  
FOR BRICK PILLAR @ WALK  
CENTER DRUG  
STORE

FD. SPK & SHINER  
SET BY POGGEMEYER

S.R. 64

(WOOSTER ST.)

N.E. COR. CONC.  
FDN. OF BRICK  
BLDG. @ WALK  
CAROUSEL  
CLOTHES STORE

N.W. COR. OF STONE  
PILLAR 4" ABOVE WALK  
UHLMAN'S CLOTHES  
STORE

(MAIN ST.)

U.S. 25

62.41'

50.18'

52.30'

49.86'