

O.D.O.T. DISTRICT 2 SURVEY OFFICE (USE ONLY)

PERSONNEL

REFERENCE NO. 24 BB

SHEET 21 OF 35

NOTES BARNHISEL

DATE 6/14/01

ROUTE US 25

H.C. CANTERBURY

WEATHER SUNNY

COUNTY WOOD

R.C. MOSER

TEMP. 90°

TOWNSHIP PLAIN

SECTION 24

DWG BY RHOADES

PID _____

T 5 N R 10 E

TYPE MONUMENT MONBOX W/3/4" IPIN

ON SURFACE - ~~BELOW~~ ON _____

OFFSET C PAVEMENT ON _____ LT : RT
 - TO - EDGE PAVEMENT


STATION: 536+27

HORIZ. DATUM: _____


GEOID: _____

GRID: NORTHING: _____

EASTING: _____

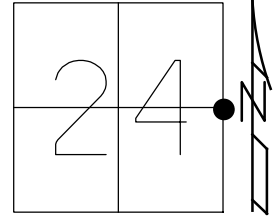

RECORD:
 STA. 777+99.85
 FD MONBOX
 W/ 3/8" IPIN
 FD MONBOX
 W/ 3/8" IPIN
 2" DOWN
 6/10/92
 6/14/01, MB

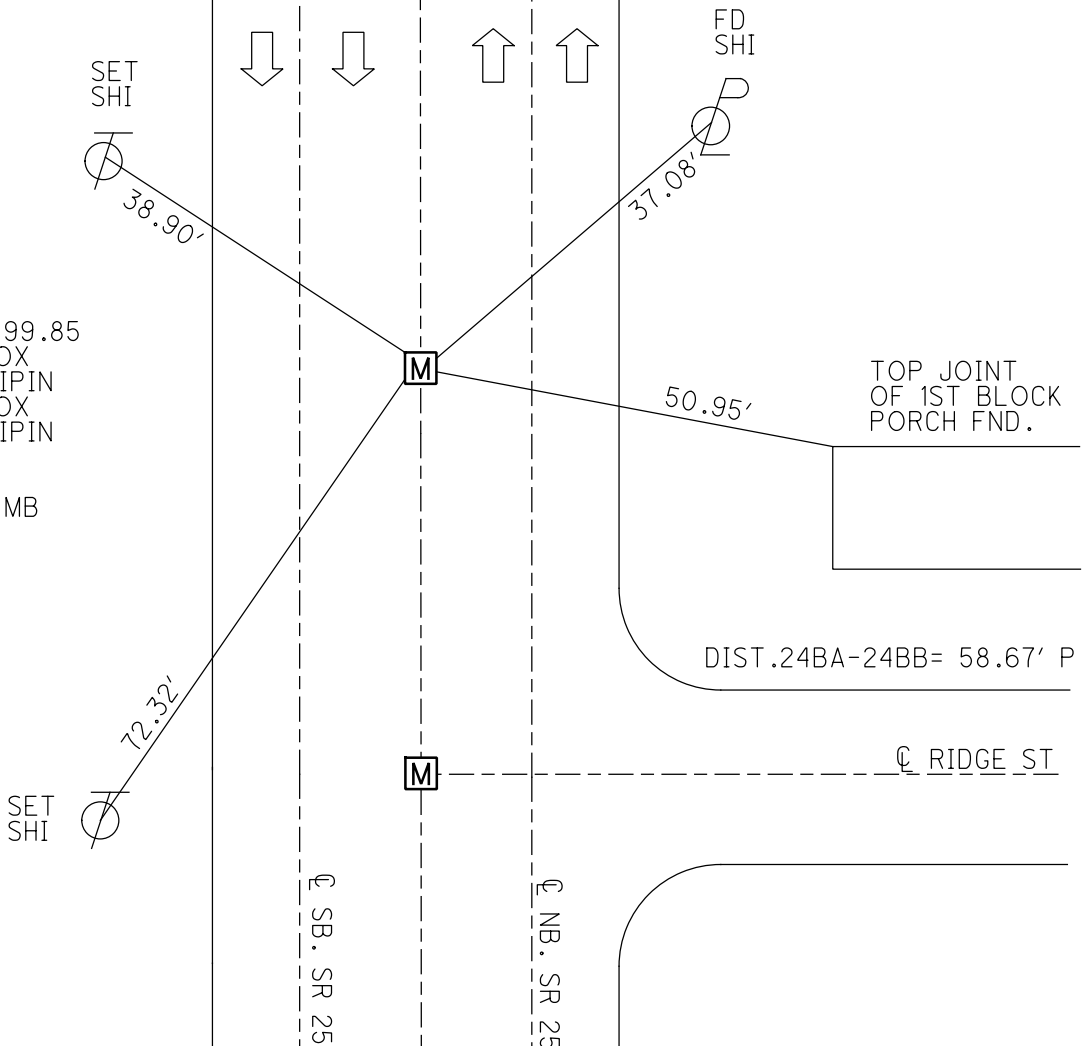

O.D.O.T. DISTRICT 2 SURVEY OFFICE

PERSONNEL

REFERENCE NO. 24-B

SHEET 13 OF 22

NOTES BARNHISEL ✓

6-14-01

H.C. VAN DUSEN MC

DATE 6-10-92

ROUTE U.S. 25

R.C. BARNHISEL Km

WEATHER SUNNY

COUNTY WOODS

TEMP. +65° 90

TOWNSHIP PLAIN

SECTION 24

T 5 N R 10 E



TYPE MONUMENT Mon. Boxes.

~~ON SURFACE~~ - BELOW ALL

~~LEFT - & PAV'T. - RIGHT~~ yes (ALL)

- TO - EDGE PAVEMENT

S.L.M. 534+70 / 537+67 / 536+27

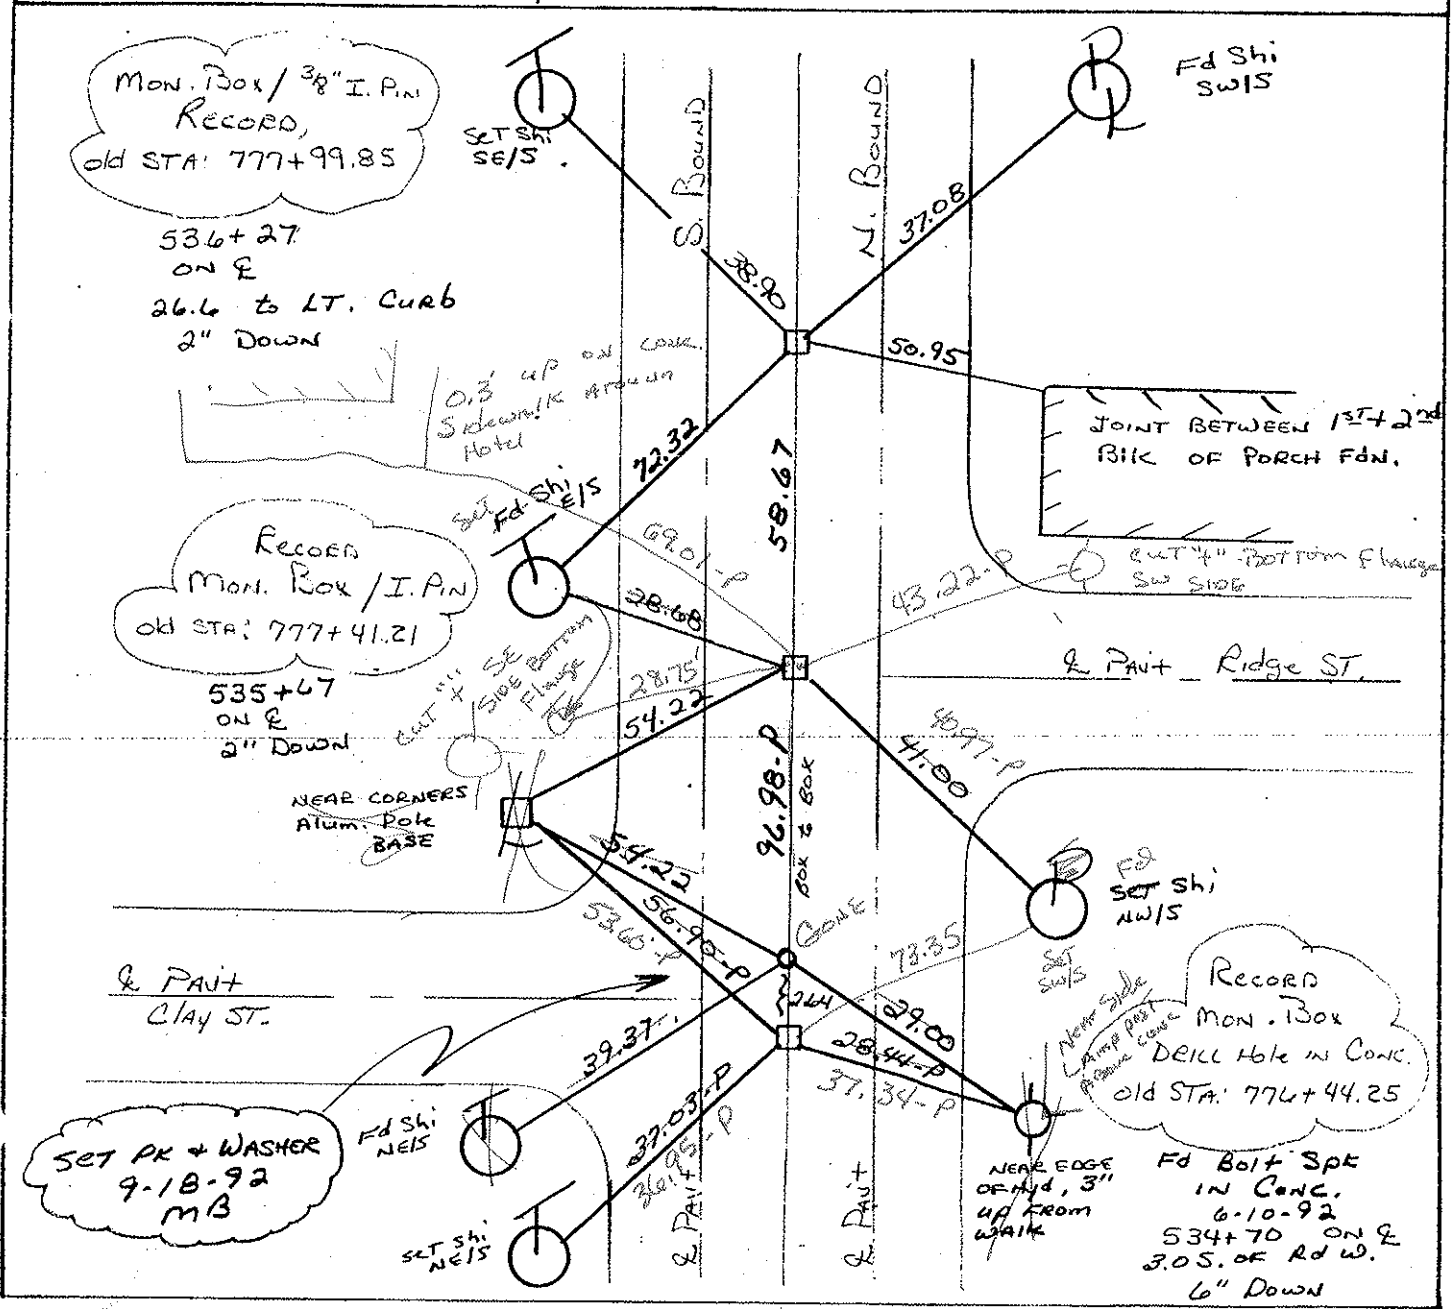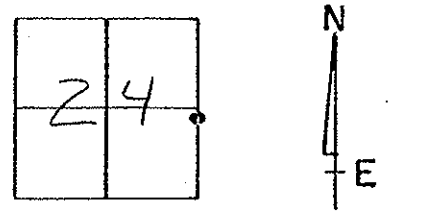

O.D.O.T. DISTRICT 2 SURVEY OFFICE

PERSONNEL

REFERENCE NO. 24-B

SHEET 13 OF 22

NOTES BARNHISEL

H.C. VAN DUSEN

DATE 6-10-92

ROUTE U.S. 25

R.C. BARNHISEL

WEATHER SUNNY

COUNTY Wood

TEMP. +65°

TOWNSHIP Plain

SECTION 24

T 5 R 10 E



TYPE MONUMENT Mon. Boxes.

ON SURFACE - BELOW ALL

LEFT - & PAV'T. - RIGHT YES (ALL)

TO EDGE PAVEMENT

S.L.M. 534+70 / 537+67 / 536+27

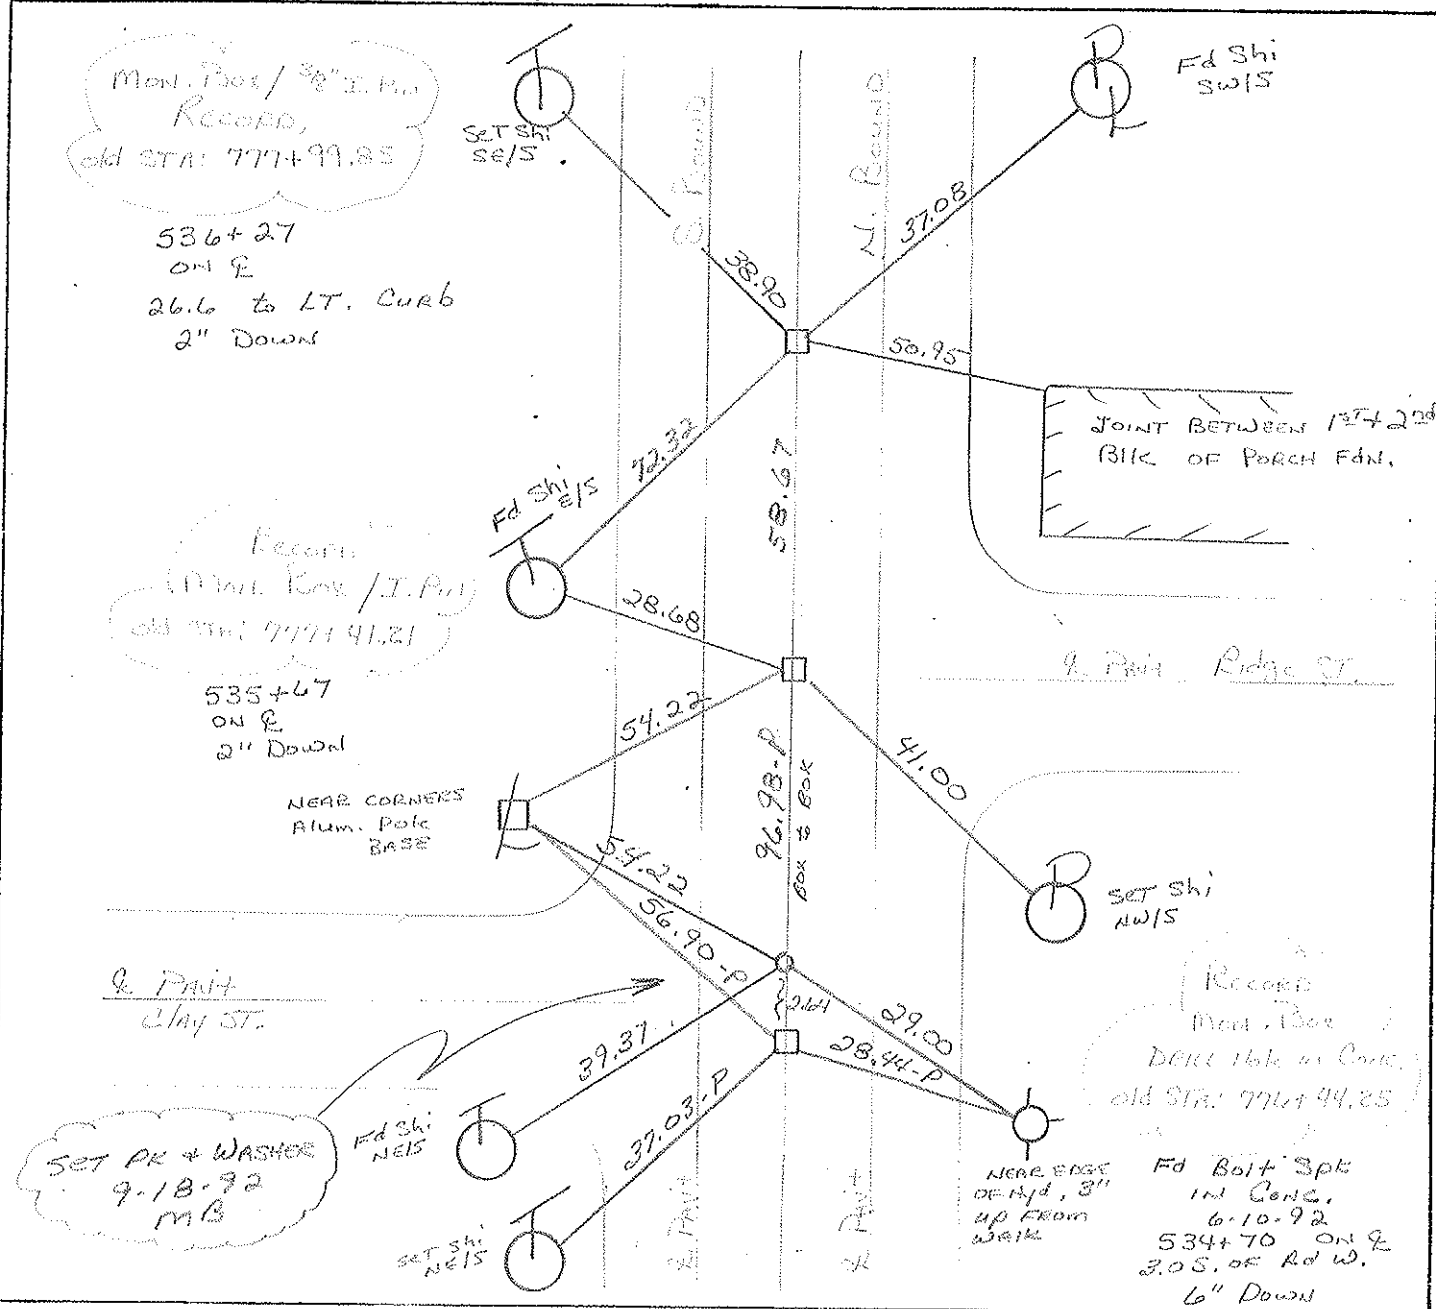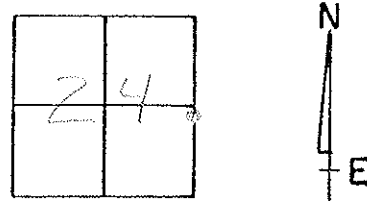

ODOT. DISTRICT 2 SURVEY OFFICE

SHEET _____ OF _____

County WOOD U.S. 25
S.R.

Date 3-31-75

Township PLAIN

Weather CLEAR

Section 24


Temp. 35°

T5N, R10E


Personnel BURNSIDE

SMITH

BOWERS

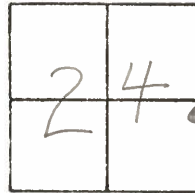

24-B

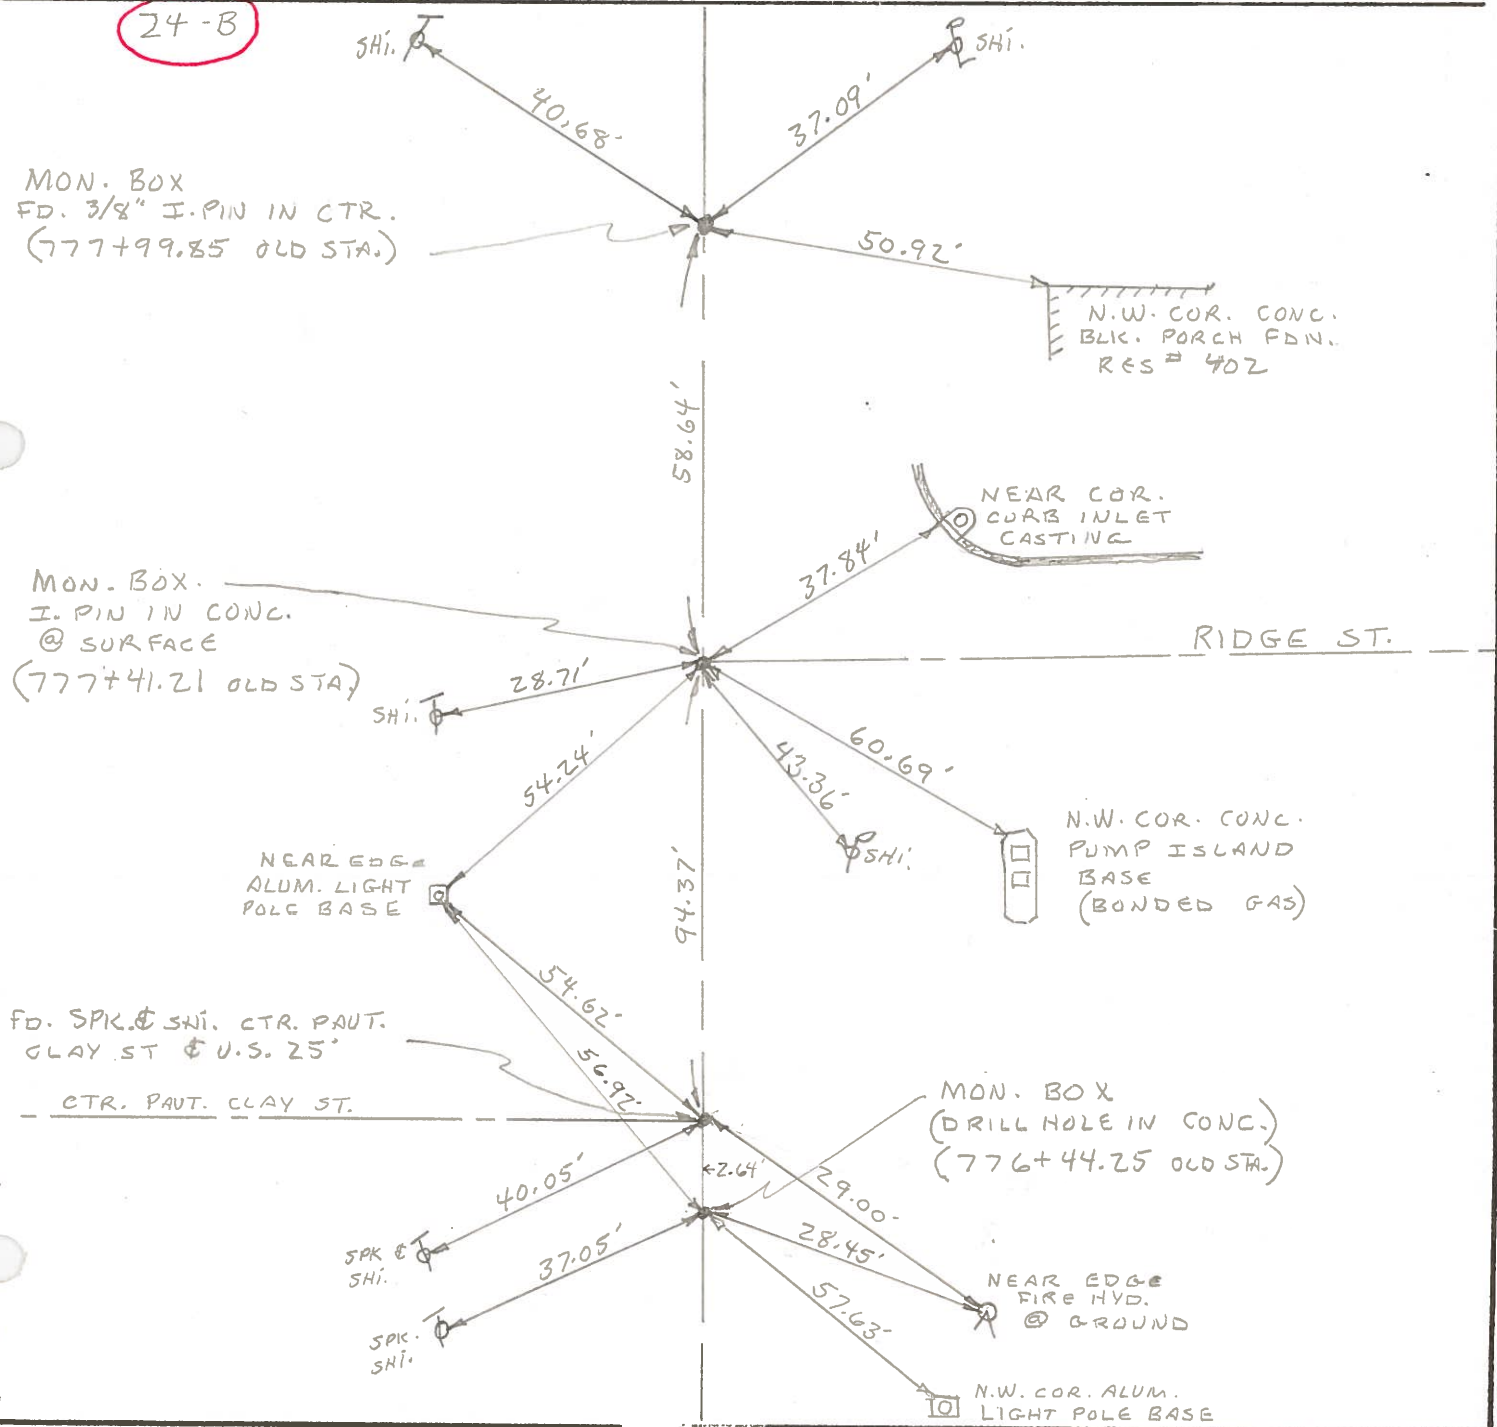

PERSONNEL	TITLE	PERSONNEL	TITLE	COUNTY <u>Wood</u>	DATE <u>4/22/58</u>
				S. R. <u>2.5</u>	WEATHER
				SEC. <u>B.G.</u>	TEMP.

DESCRIPTION	LEFT	CENTER LINE	RIGHT	JOB NO.
-------------	------	-------------	-------	---------

