



O.D.O.T. DISTRICT 2 SURVEY OFFICE (USE ONLY)

PERSONNEL \_\_\_\_\_ REFERENCE NO. 24 CA SHEET 23 OF 35  
 NOTES BARNHISEL DATE 6/10/92 ROUTE US 25  
 H.C. VAN DUSEN WEATHER SUNNY COUNTY WOOD  
 R.C. BARNHISEL TEMP. 65° TOWNSHIP PLAIN  
 SECTION 24  
 DWG BY RHOADES PID \_\_\_\_\_ T 5 N R 10 E

TYPE MONUMENT P.K.NAIL  
 ON SURFACE - ~~BELOW~~ ON  
 OFFSET Q PAVEMENT ON \_\_\_\_\_ LT : RT  
26.3' TO RT EDGE PAVEMENT  
 STATION: 537+90  
 HORZ.DATUM: \_\_\_\_\_ GEOID: \_\_\_\_\_  
 GRID: NORTHING: \_\_\_\_\_ EASTING: \_\_\_\_\_

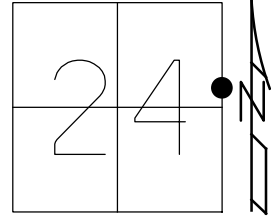

RECORD:  
 D.N.F. P.K.NAIL  
 6/10/92  
 SET P.K./WASHER  
 9/18/92, MB

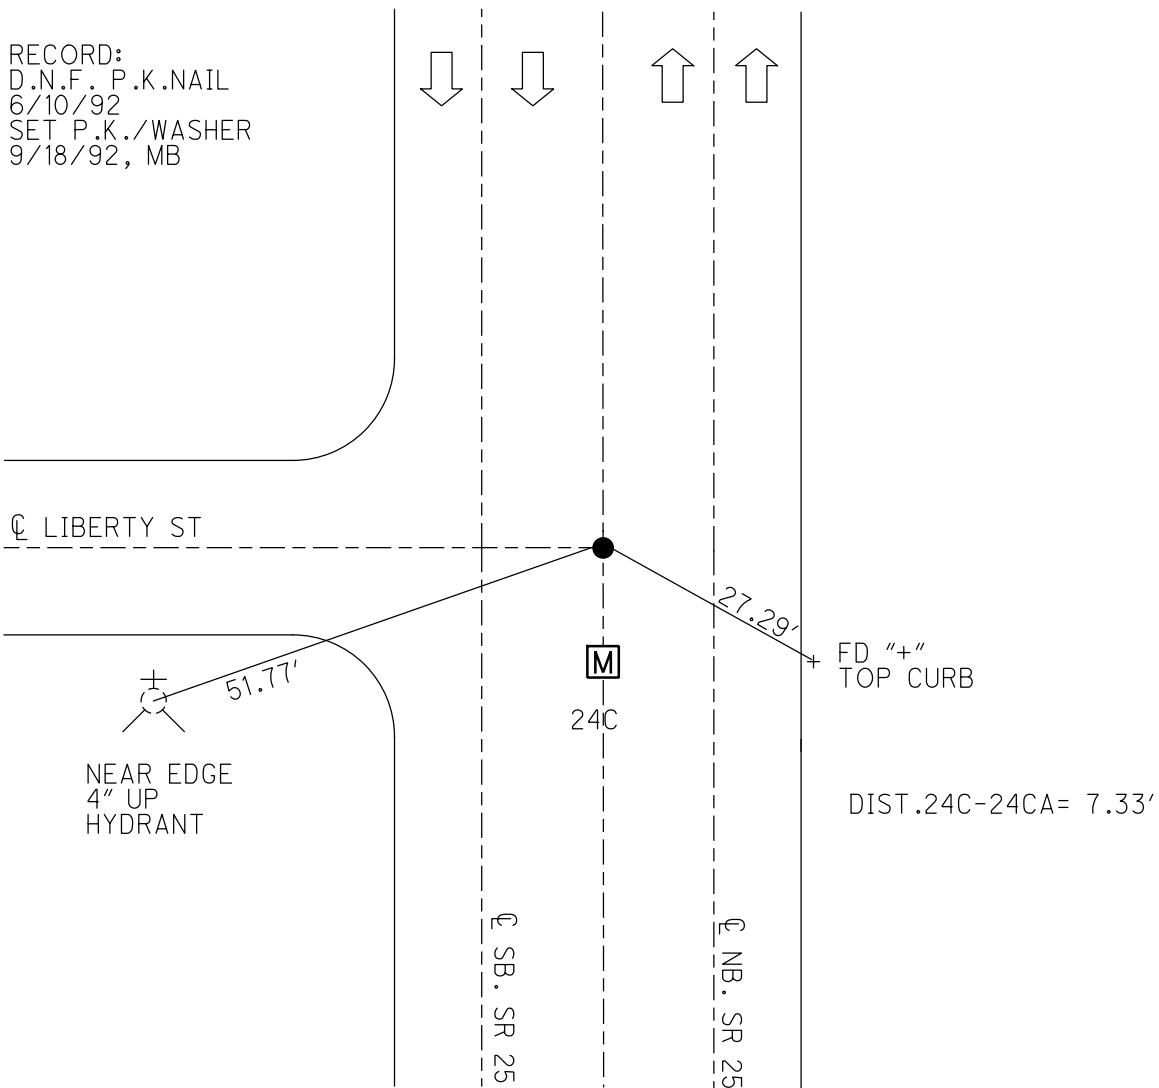

# O.D.O.T. DISTRICT 2 SURVEY OFFICE

PERSONNEL \_\_\_\_\_ REFERENCE NO. 24-C SHEET 14 OF 22

NOTES BARNASEL

H.C. UANI DUSEN DATE 6-10-92 ROUTE U.S. 25

R.C. BARNASEL WEATHER SUNNY COUNTY WOOD

\_\_\_\_\_ TEMP. +65° TOWNSHIP PLAIN

\_\_\_\_\_ SECTION 24

\_\_\_\_\_ T. 5 R. 10 E


TYPE MONUMENT MON. BOX (DESTROYED) PK.

ON SURFACE - BELOW 5" DOWN GONE SURFACE


~~LEFT~~ - RIGHT PAV'T. - RIGHT yes / yes

26.3 TO RT EDGE PAVEMENT curb

S.L.M. 537 + 83 MON. BOX 540 + 98  
ON E EAST

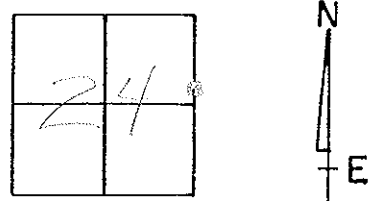

MON. BOX

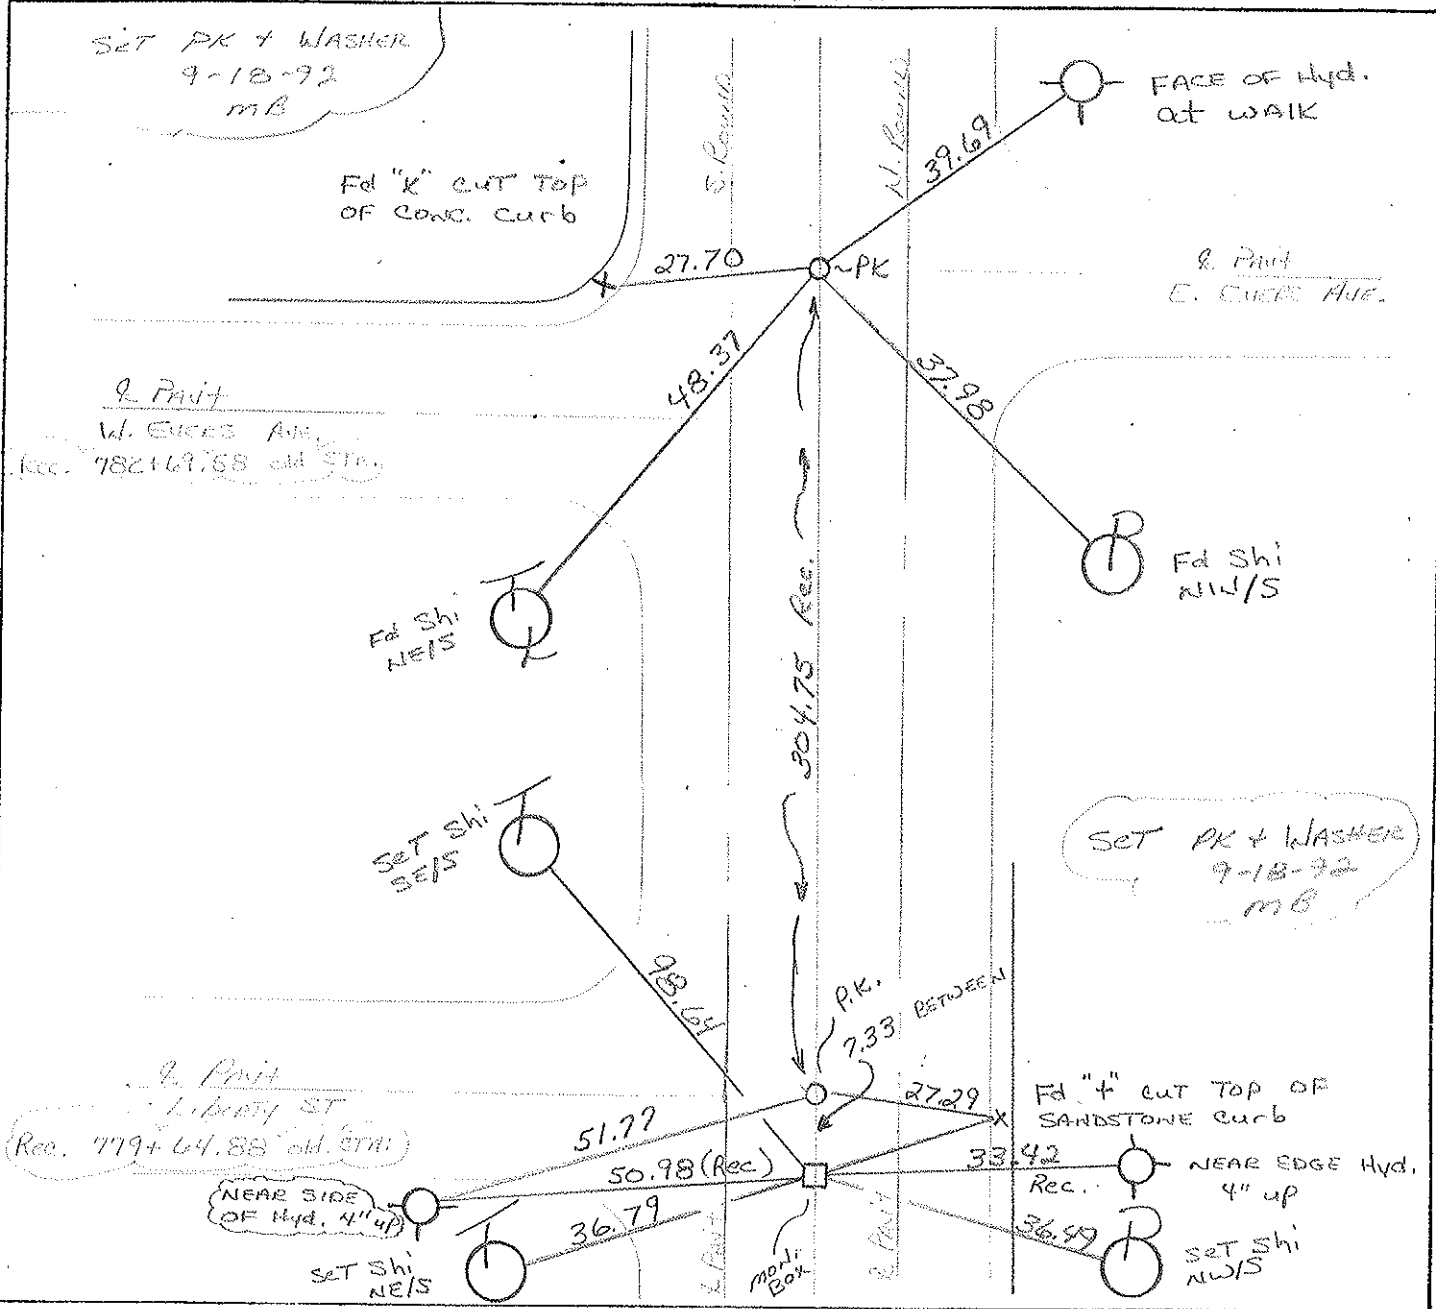

ODOT. DISTRICT 2 SURVEY OFFICE

SHEET \_\_\_\_\_ OF \_\_\_\_\_

County WOOD <sup>U.S.</sup> ~~S.R.~~ 25

Date 4-14-75

Township PLAIN

Weather CLOUDY

Section 24


Temp. 38°

T5N, R10E


Personnel BURNSIDE

SMITH

BOWERS

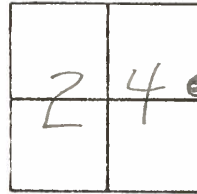

24-C

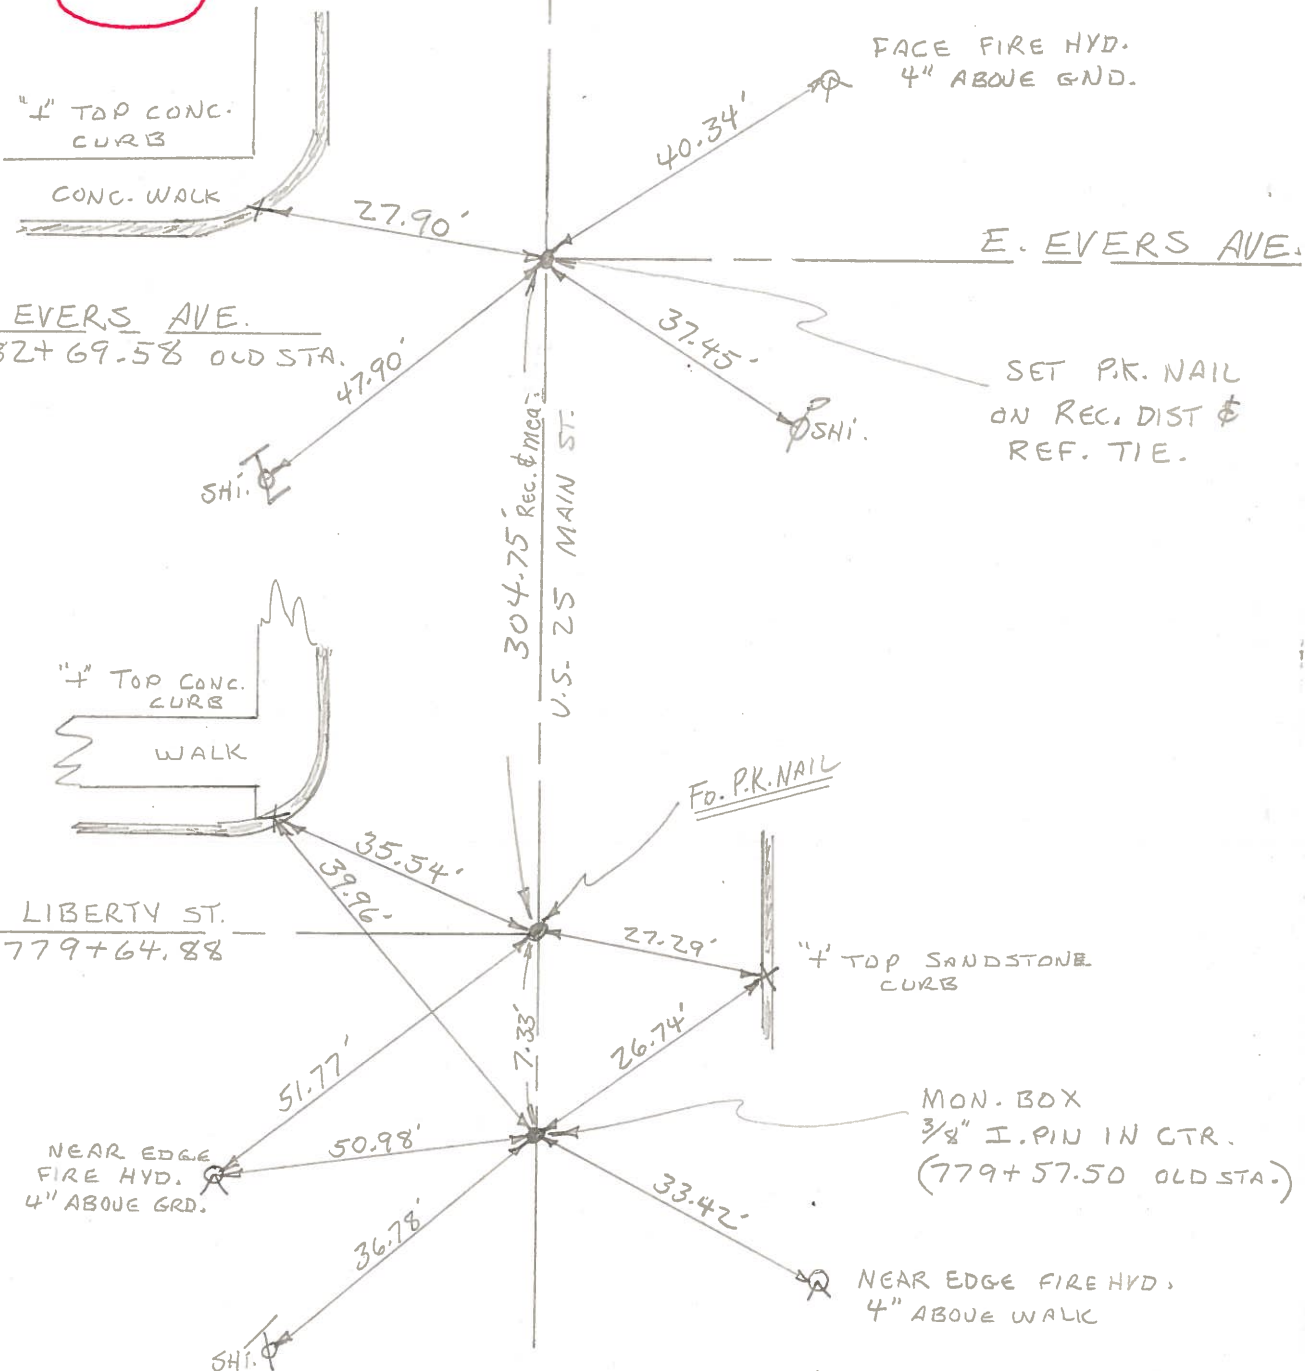

PERSONNEL	TITLE	PERSONNEL	TITLE	COUNTY	DATE	S. R.	WEATHER	SEC.	TEMP.
				Wood	4/22/58	25		B.G.	

