

O.D.O.T. DISTRICT 2 SURVEY OFFICE (USE ONLY)

PERSONNEL

REFERENCE NO. 24 C

SHEET 22 OF 35

NOTES BARNHISEL

DATE 6/10/92

ROUTE US 25

H.C. VAN DUSEN

WEATHER SUNNY

COUNTY WOOD

R.C. BARNHISEL

TEMP. 65°

TOWNSHIP PLAIN

SECTION 24

DWG BY RHOADES PID _____

T 5 N R 10 E

TYPE MONUMENT MONBOX

~~ON SURFACE~~ - BELOW 5"

OFFSET C PAVEMENT ON _____ LT : RT

26.3' TO RT EDGE PAVEMENT



STATION: 537+83

HORIZ.DATUM: _____

GEOID: _____

GRID: NORTHING: _____

EASTING: _____

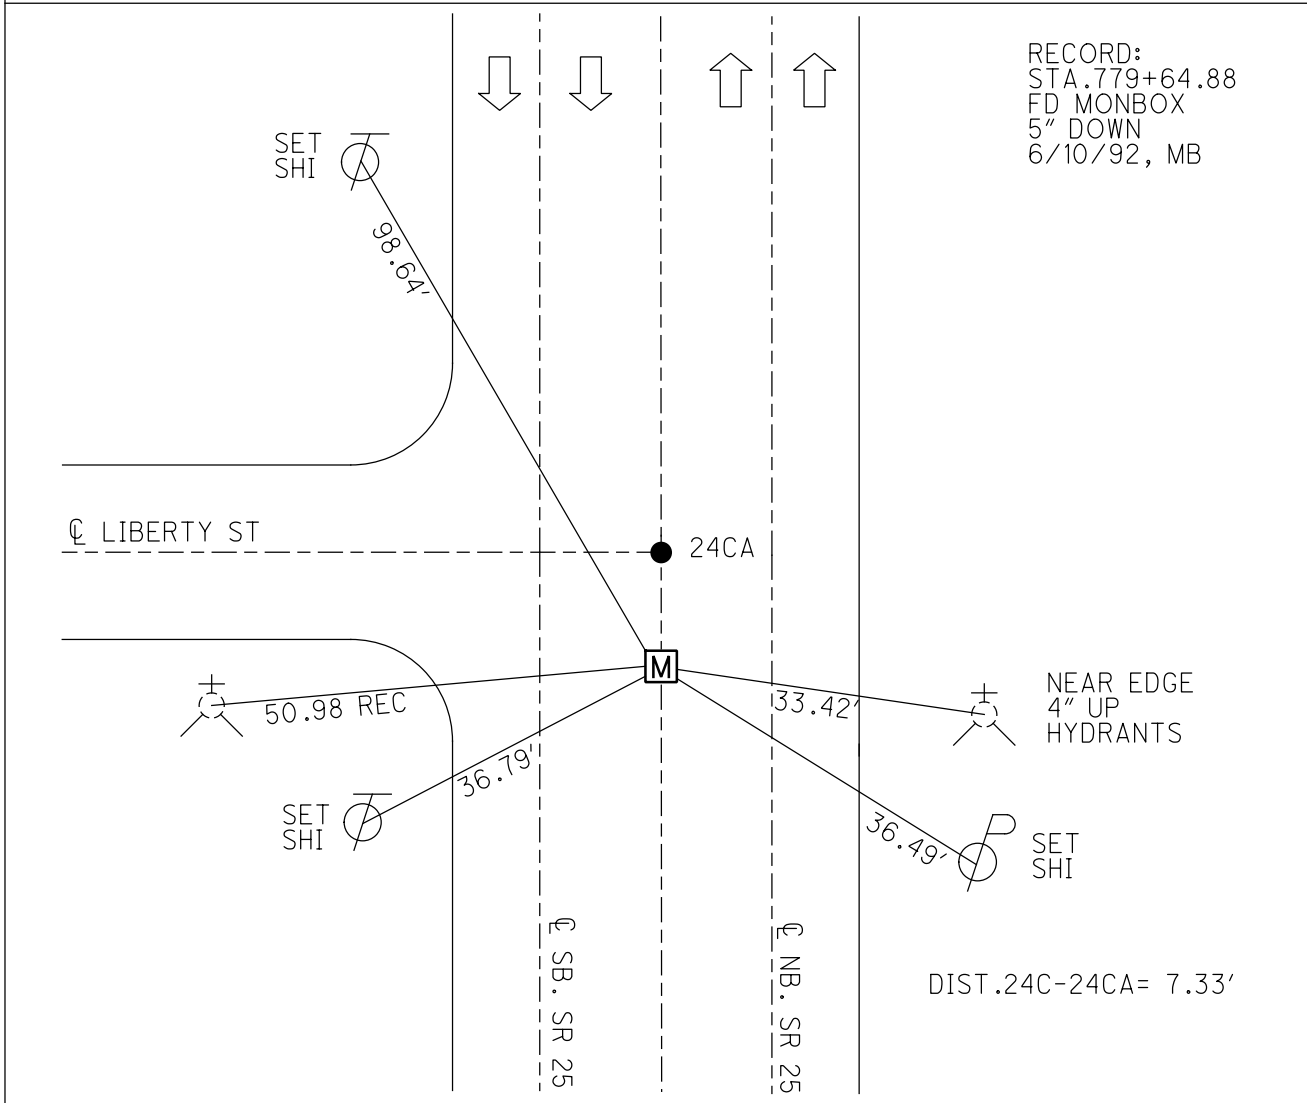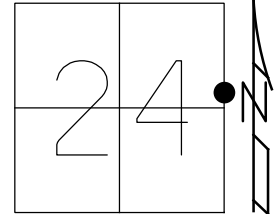

RECORD:
 STA. 779+64.88
 FD MONBOX
 5" DOWN
 6/10/92, MB

DIST. 24C-24CA = 7.33'

O.D.O.T. DISTRICT 2 SURVEY OFFICE

PERSONNEL

REFERENCE NO. 24-C

SHEET 14 OF 22

NOTES BARNASEL

H.C. Van Dusen

DATE 6-10-92

ROUTE U.S. 25

R.C. BARNASEL

WEATHER SUNNY

COUNTY Wood

TEMP. +65°

TOWNSHIP Plain

SECTION 24

T. 5 N. R. 10 E.


TYPE MONUMENT MON. BOX (DESTROYED) PK.

ON SURFACE - BELOW 5" DOWN GONE SURFACE


~~LEFT~~ - RIGHT PAV'T. - RIGHT yes / yes

26.3 TO RT EDGE PAVEMENT curb

S.L.M. 537 + 83 MON. BOX 540 + 98 ON E EAST

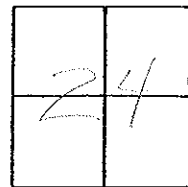

Mon.
Box

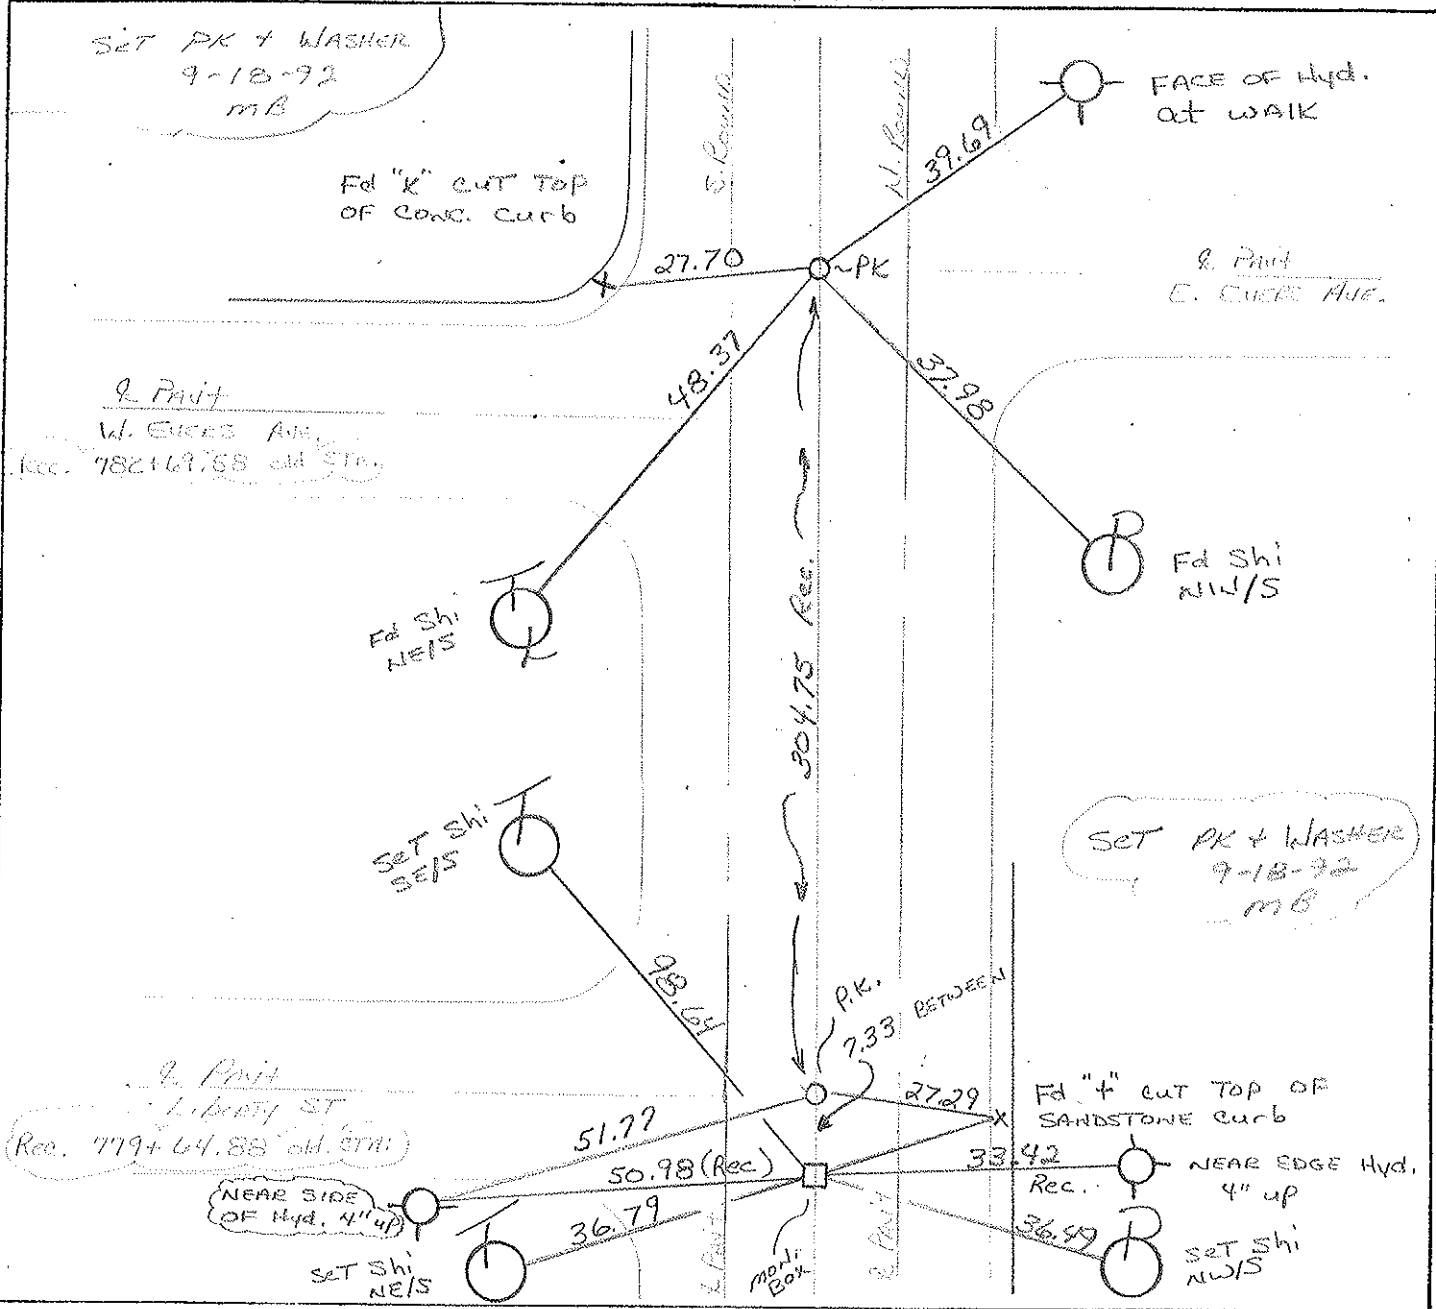

ODOT. DISTRICT 2 SURVEY OFFICE

SHEET _____ OF _____

County WOOD ^{U.S.} ~~S.R.~~ 25

Date 4-14-75

Township PLAIN

Weather CLOUDY

Section 24


Temp. 38°

T5N, R10E


Personnel BURNSIDE

SMITH

BOWERS

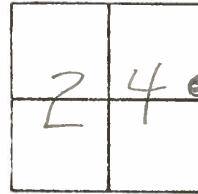

24-C

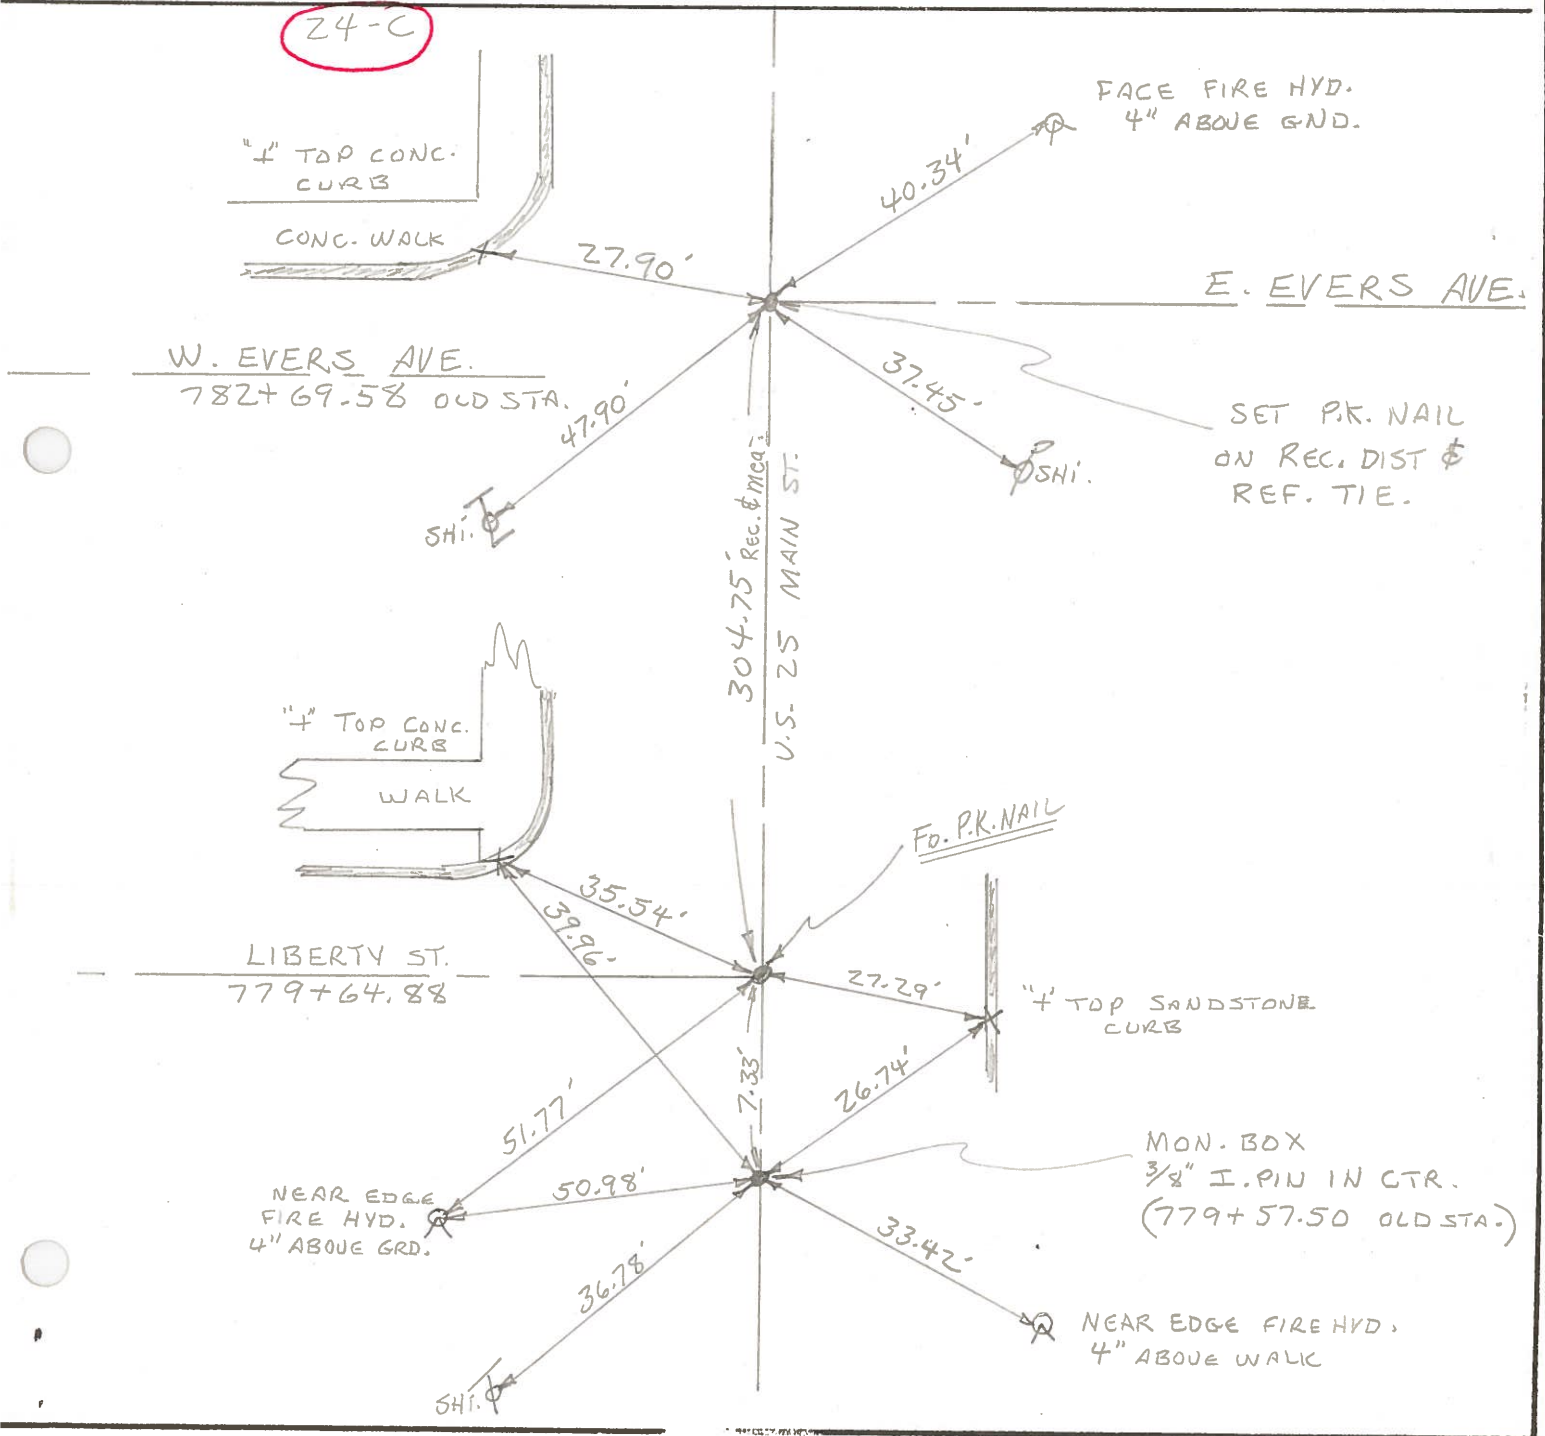

PERSONNEL	TITLE	PERSONNEL	TITLE	COUNTY	DATE	S. R.	WEATHER	SEC.	TEMP.
				Wood	4/22/58	25		B.G.	

