


O.D.O.T. DISTRICT 2 SURVEY OFFICE (USE ONLY)


PERSONNEL _____ REFERENCE NO. 24 CB SHEET 24 OF 35
 NOTES BARNHISEL DATE 6/10/92 ROUTE US 25
 H.C. VAN DUSEN WEATHER SUNNY COUNTY WOOD
 R.C. BARNHISEL TEMP. 65° TOWNSHIP PLAIN
 DWG BY RHOADES PID _____ SECTION 24
 T 5 N R 10 E

TYPE MONUMENT P.K.NAIL
 ON SURFACE - ~~BELOW~~ ON
 OFFSET ☐ PAVEMENT ON LT : RT
26.3' TO RT EDGE PAVEMENT
 STATION: 540+98

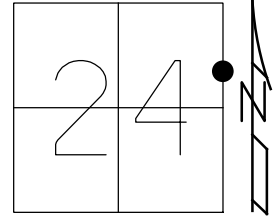

HORZ.DATUM: _____ GEOID: _____
 GRID: NORTHING: _____ EASTING: _____

RECORD:
 STA. 782+69.58
 FD P.K.NAIL
 6/10/92
 SET P.K./WASHER
 9/18/92, MB

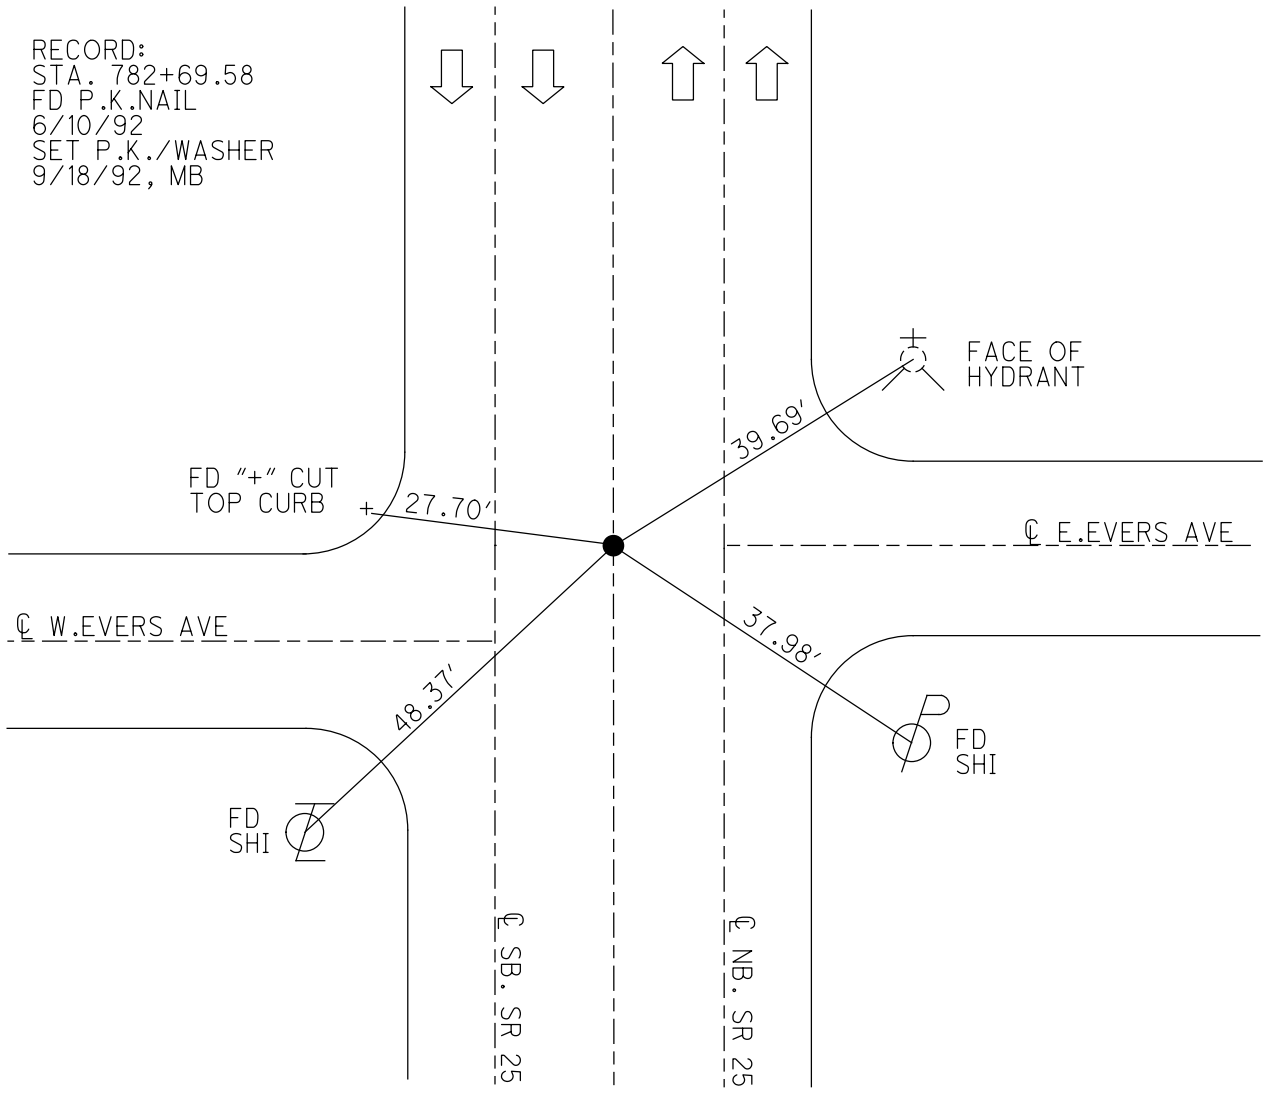

ODOT. DISTRICT 2 SURVEY OFFICE

SHEET _____ OF _____

County WOOD ^{U.S.} ~~S.R.~~ 25

Date 4-14-75

Township PLAIN

Weather CLOUDY

Section 24


Temp. 38°

T5N, R10E


Personnel BURNSIDE

SMITH

BOWERS

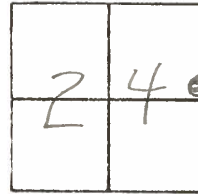

24-C

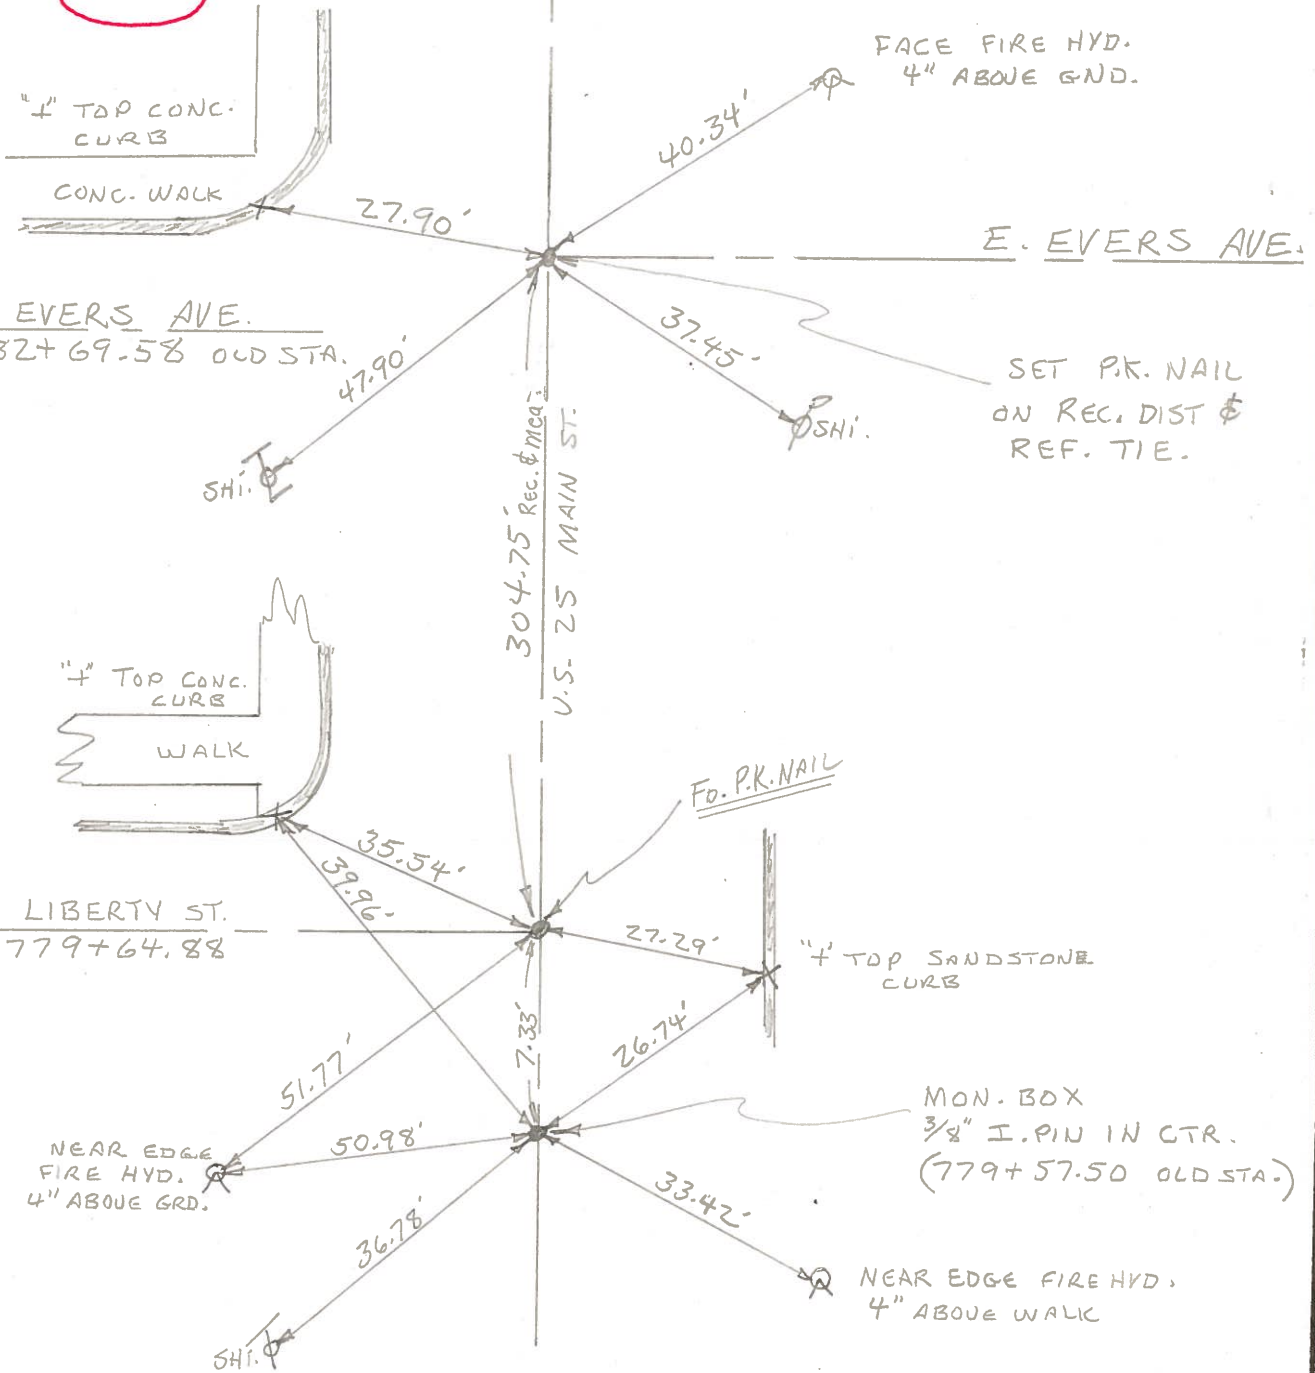

PERSONNEL	TITLE	PERSONNEL	TITLE	COUNTY	DATE	S. R.	WEATHER	SEC.	TEMP.
				Wood	4/22/58	25		B.G.	

