

O.D.O.T. DISTRICT 2 SURVEY OFFICE (USE ONLY)

PERSONNEL

REFERENCE NO. 24 CB

SHEET 25 OF 35

NOTES BARNHISEL

DATE 6/11/92

ROUTE US 25

H.C. VAN DUSEN

WEATHER SUNNY

COUNTY WOOD

R.C. BARNHISEL

TEMP. 60°

TOWNSHIP PLAIN

SECTION 24

DWG BY RHOADES

PID _____

T 5 N R 10 E

TYPE MONUMENT P.K.NAIL

ON SURFACE - ~~BELOW~~ ON _____

OFFSET \odot PAVEMENT ON _____ LT : RT

_____ TO _____ EDGE PAVEMENT



STATION: 545+11

HORZ.DATUM: _____

GEOID: _____

GRID: NORTHING: _____

EASTING: _____

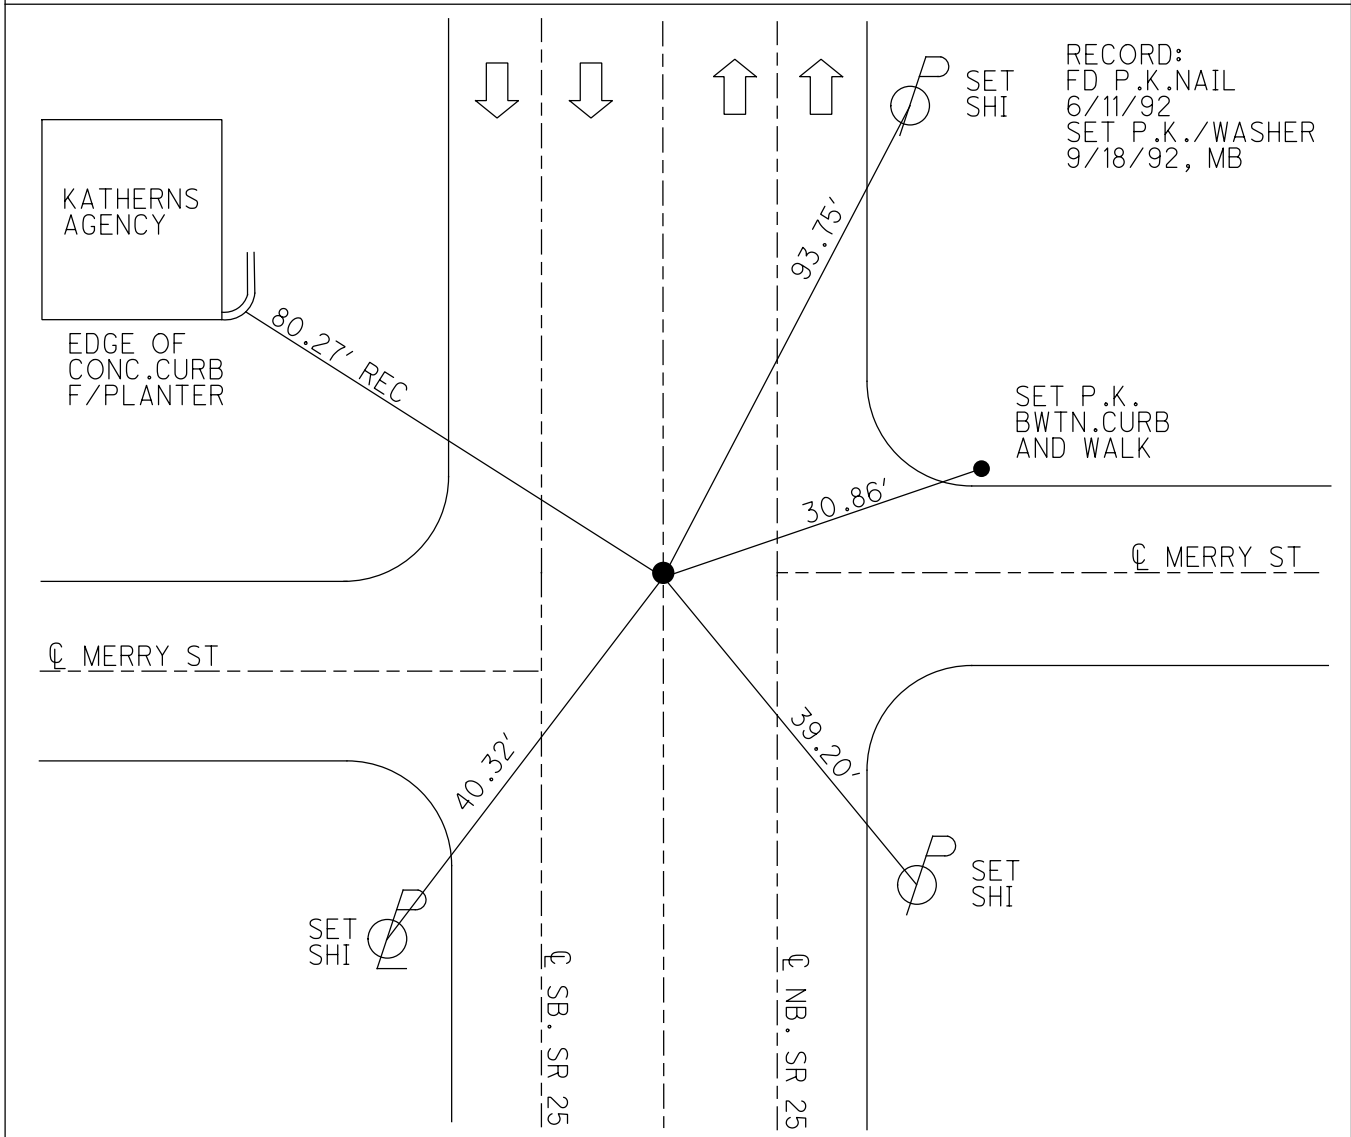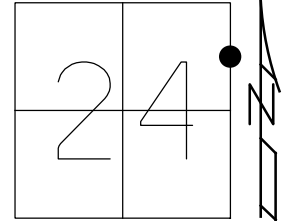

O.D.O.T. DISTRICT 2 SURVEY OFFICE

PERSONNEL

REFERENCE NO. 24-D

SHEET 15 OF 22

NOTES BARNHISEL

H.C. VAN DUSEN

DATE 6-11-92

ROUTE U.S. 25

R.C. BARNHISEL

WEATHER SUNNY

COUNTY WOOD

TEMP. +60°

TOWNSHIP PLAID

SECTION 24

T. 5 N. R. 10 E.

TYPE MONUMENT P.K. NAIL



ON SURFACE - BELOW YES

LEFT - PAV'T. - RIGHT YES

TO - EDGE PAVEMENT

S.L.M. 545+11

0.8 N. OF E EAST

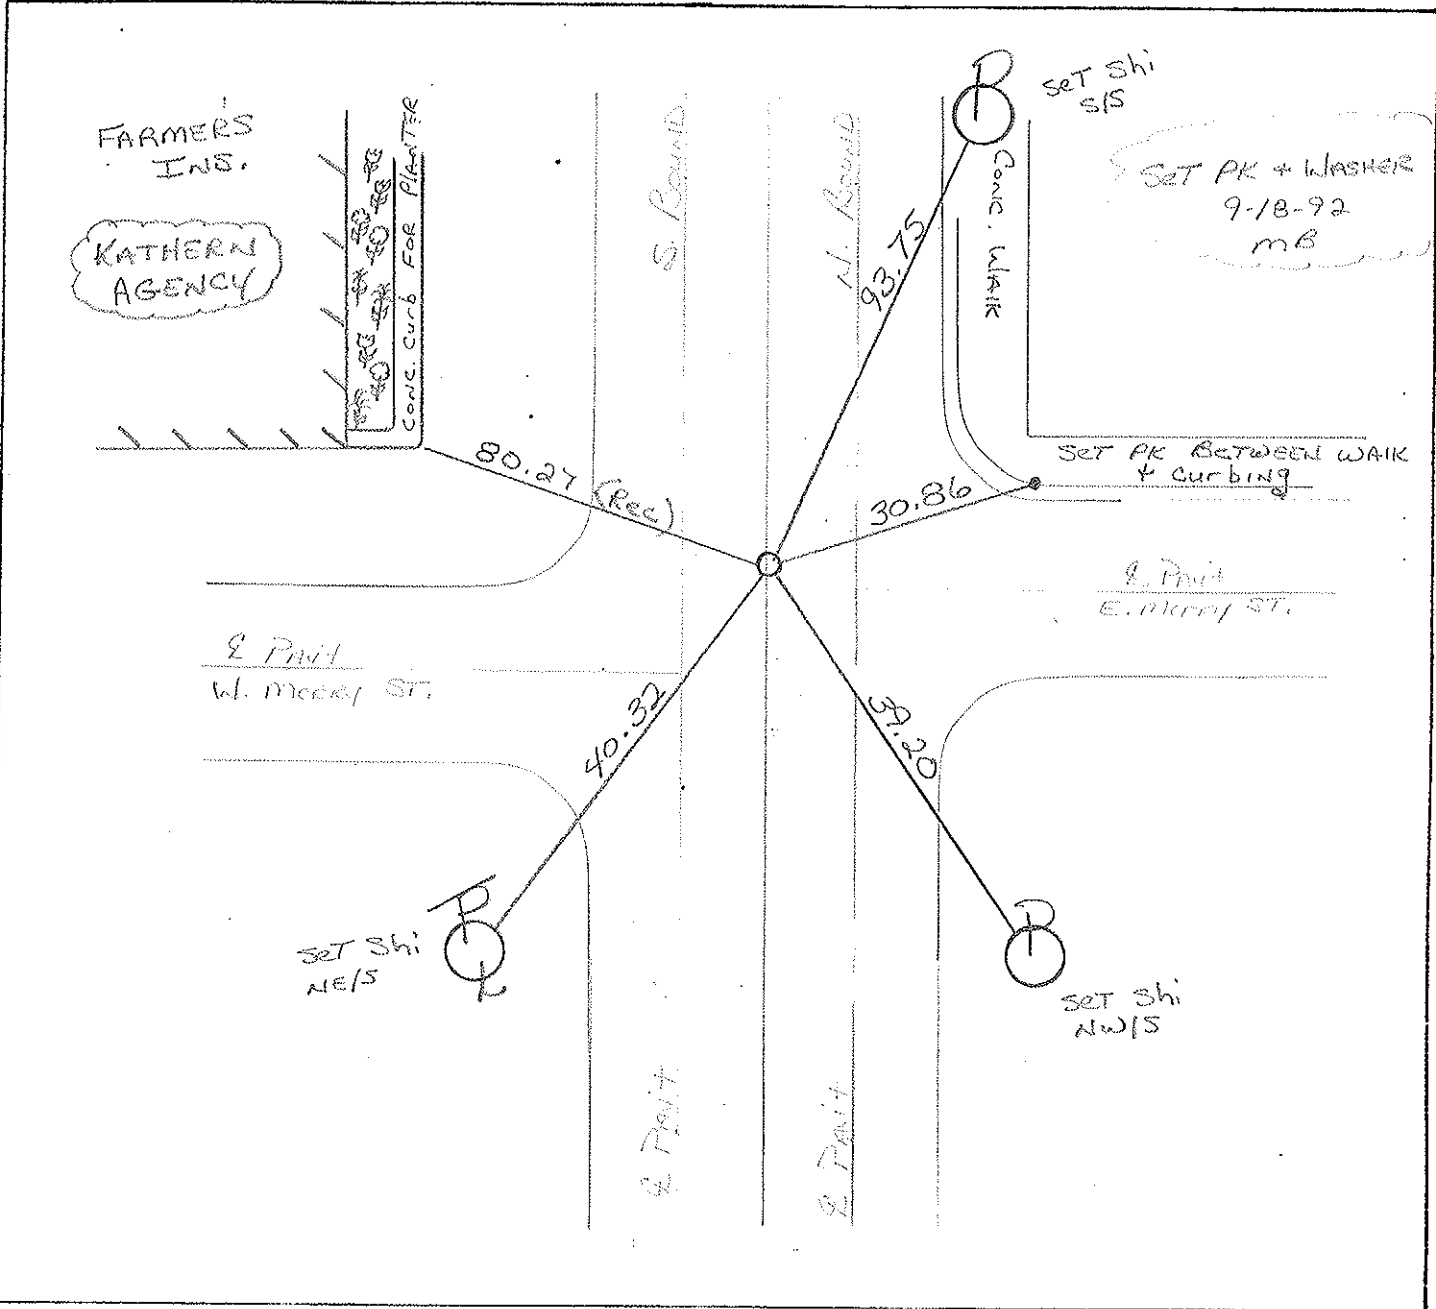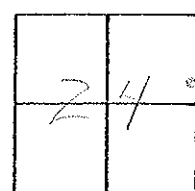

O.D.O.T. DISTRICT 2 SURVEY OFFICE

SHEET _____ OF _____

County WOOD ^{U.S.} S.R. 25

Date 4-14-75

Township PLAIN

Weather CLOUDY

Section 24


Temp. 42°

T5N, R10E

Personnel BURNSIDE

SMITH

BOWERS

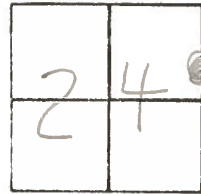

24-D

