

O.D.O.T. DISTRICT 2 SURVEY OFFICE (USE ONLY)

PERSONNEL

REFERENCE NO. 24 D

SHEET 26 OF 35

NOTES BARNHEISEL

DATE 6/11/92

ROUTE US 25

H.C. VAN DUSEN

WEATHER SUNNY

COUNTY WOOD

R.C. BARNHEISEL

TEMP. 60°

TOWNSHIP PLAIN

SECTION 24

DWG BY RHOADES

PID _____

T 5 N R 10 E

TYPE MONUMENT P.K.NAIL

ON SURFACE - ~~BELOW~~ ON _____

OFFSET \odot PAVEMENT ON LT : RT

- TO - EDGE PAVEMENT


STATION: 548+38

HORZ.DATUM: _____


GEOID: _____

GRID: NORTHING: _____

EASTING: _____

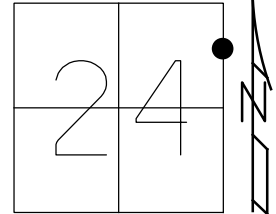

RECORD:
 STA. 790+11.22
 D.N.F. P.K.NAIL
 SET P.K./WASHER
 9/22/92, MB

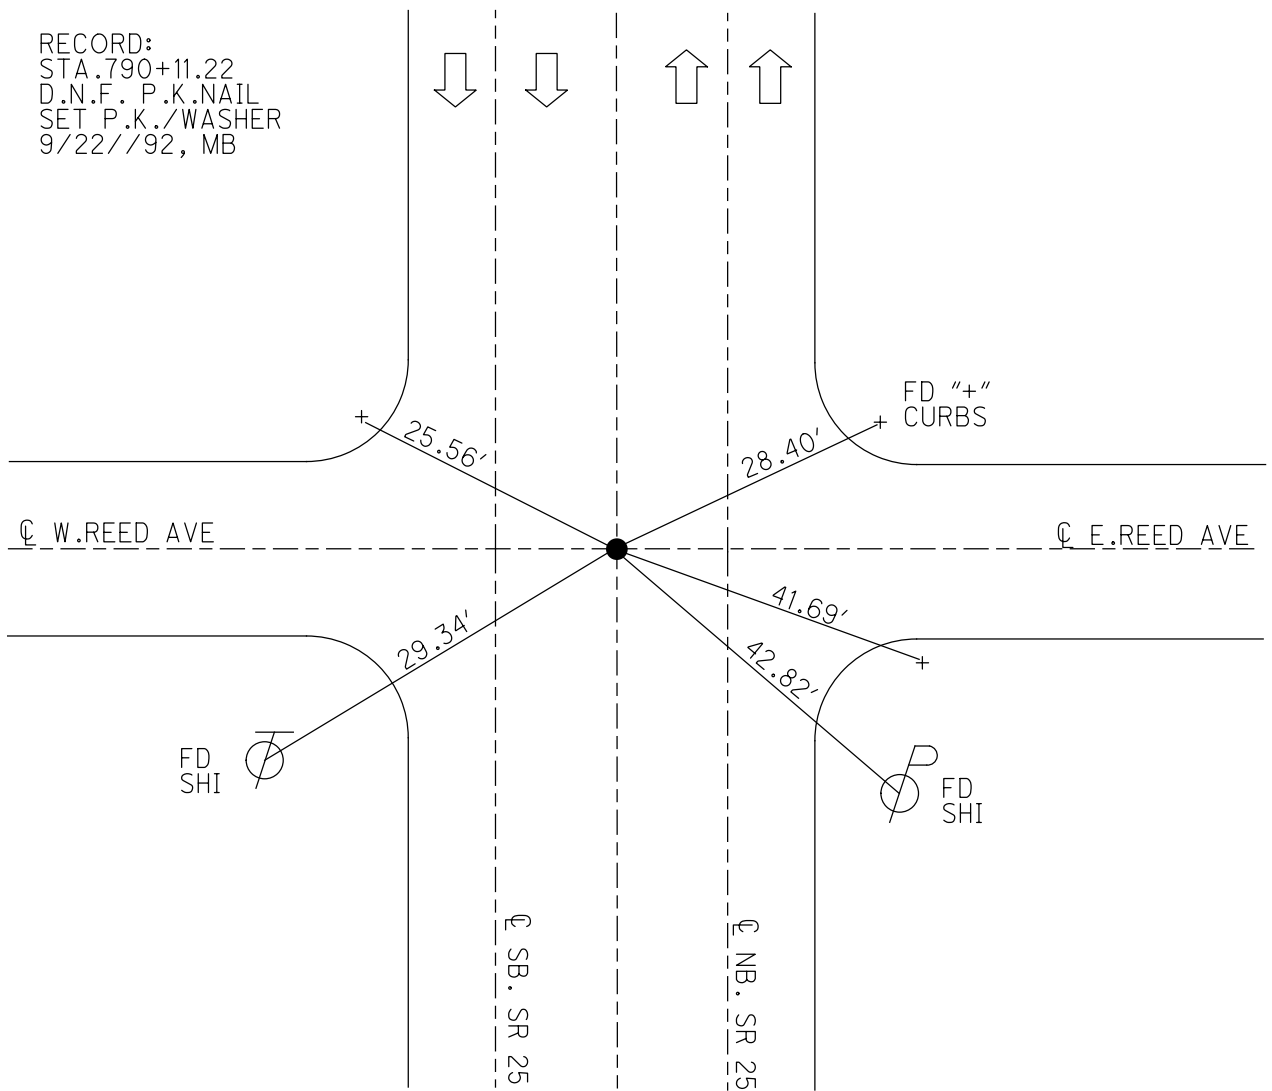

O.D.O.T. DISTRICT 2 SURVEY OFFICE

PERSONNEL

REFERENCE NO. 24-D-1

SHEET 16 OF 22

NOTES BARNHISEL

H.C. VAN DUSEN

R.C. BARNHISEL

DATE 6-11-92

WEATHER Sunny

TEMP. +60°

ROUTE U.S. 25

COUNTY Wood

TOWNSHIP Plain

SECTION 24

T.S. & R. 10 E

(Rec Pk.)


TYPE MONUMENT DESTROYED FROM SEWER LINE

ON SURFACE - BELOW

~~LEFT~~ - C PAV'T. - RIGHT YES E OF STREETS

- TO - EDGE PAVEMENT

S.L.M. 548+38

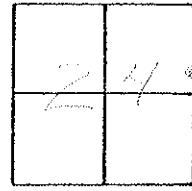


Record:

Old Sta: 190+11.22

Set PK + WASHER

9-22-92
mB

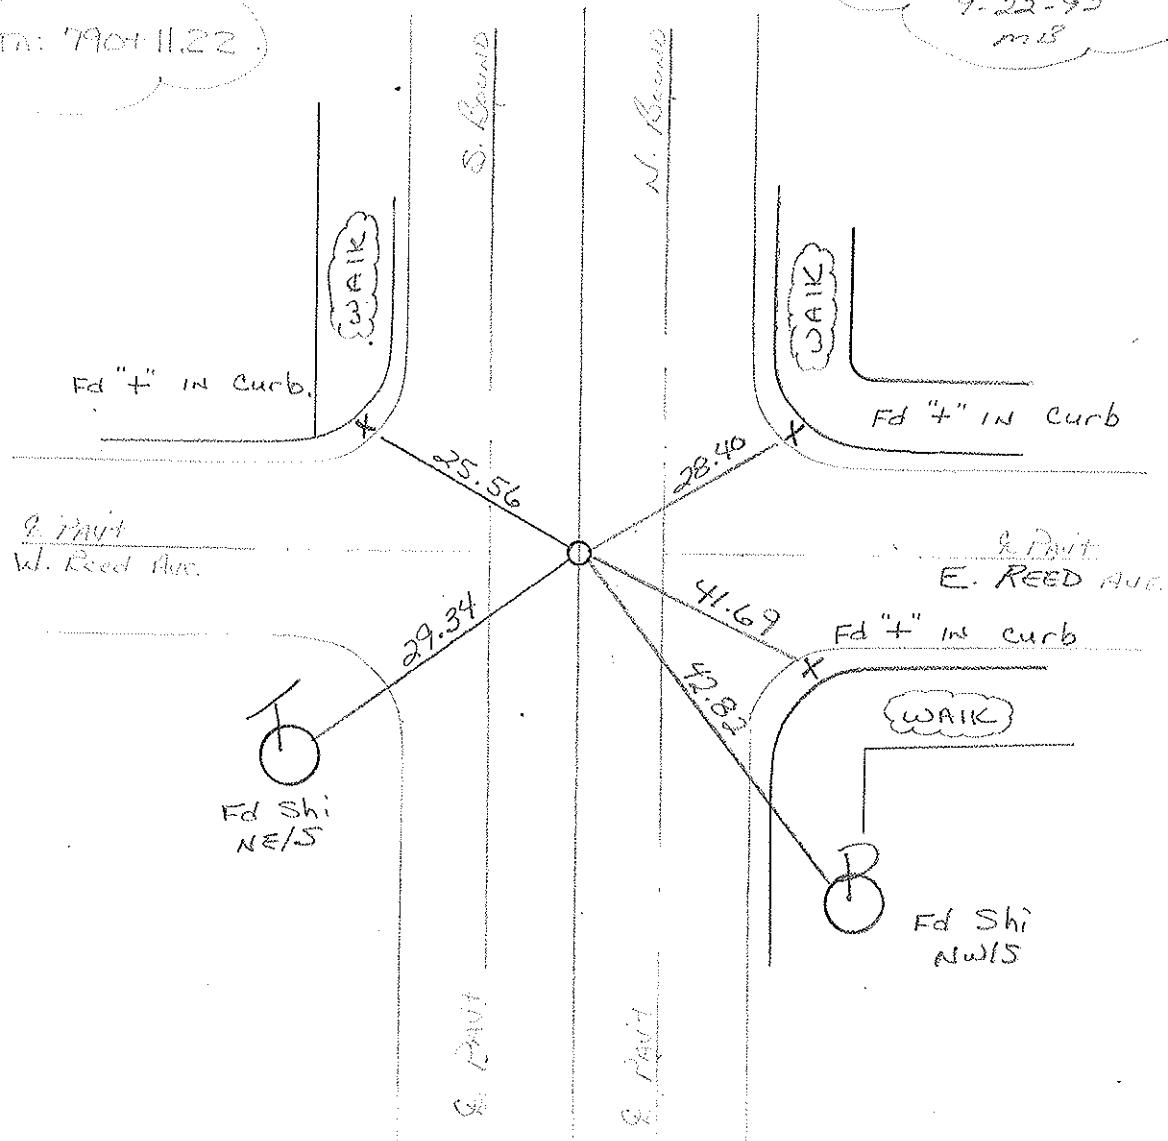

O.D.O.T. DISTRICT 2 SURVEY OFFICE

SHEET _____ OF _____

County WOOD ^{U.S.} S.R. 25

Date 4-14-75

Township PLAIN

Weather CLOUDY

Section 24


Temp. 42°

T5N, R10E


Personnel BURNSIDE

SMITH

BOWERS

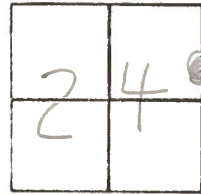

24-D

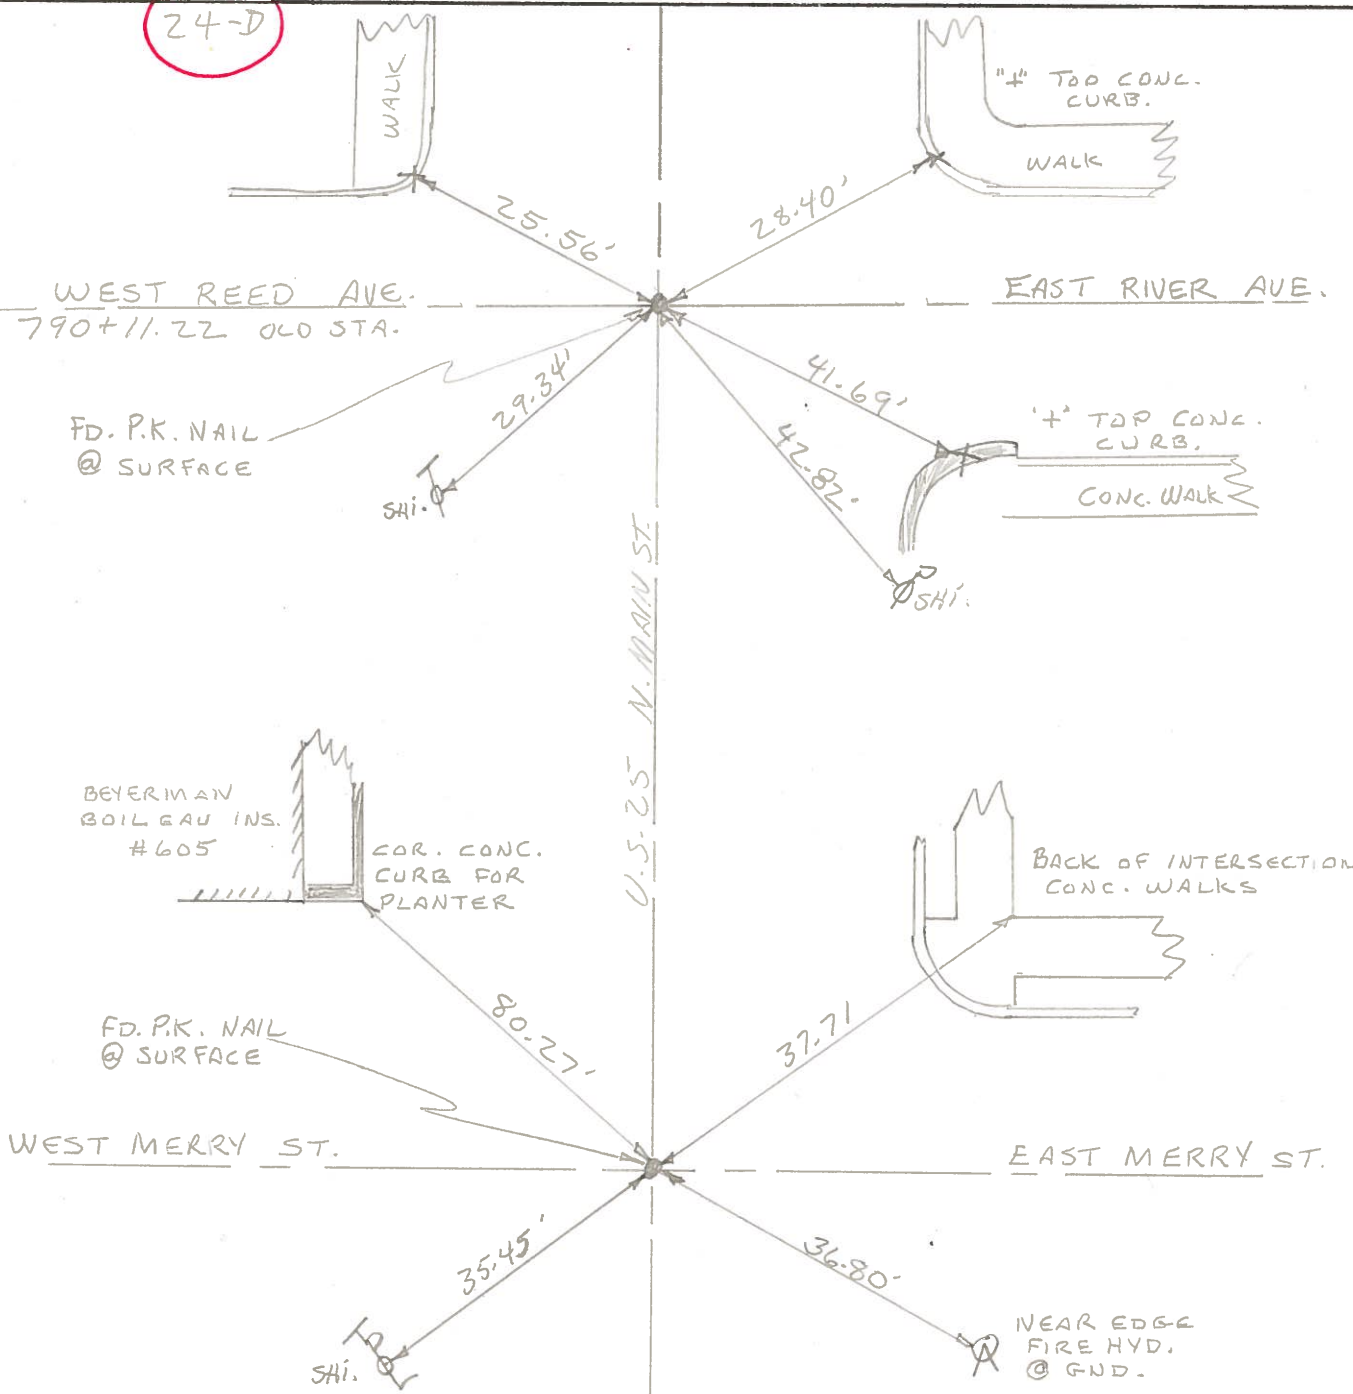

PERSONNEL TITLE PERSONNEL TITLE

COUNTY Wood

DATE 4/22/58

S. R. 25

WEATHER

SEC. B.G.

TEMP.

DESCRIPTION

LEFT

CENTER LINE

RIGHT

JOB NO.

872

817+80.10
W. Corp. line

Shiner Note: see sheet # 8E

871

816+73.10
E. Corp. line

P.K. Note: see sheet # 8E

870
869

804+79.1 End of conc. pavmt.
804+50.22 Pce Rd. W. man box

Note: see sheet # 8D


#868

803+70.40
Pce Rd. E. man box

Note: see sheet # 8D


#867

796+62.96
Frazee Ave.
Fd. + cut in pavmt.

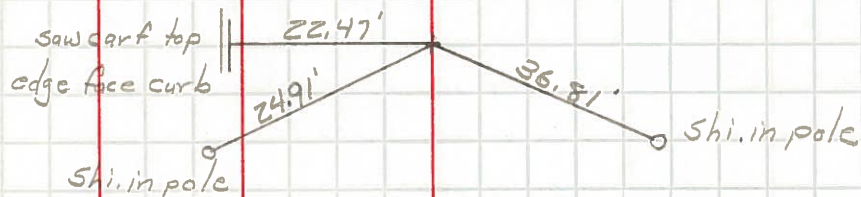


#866

793+37.09
Leroy Ave.
Fd + cut in pavmt.

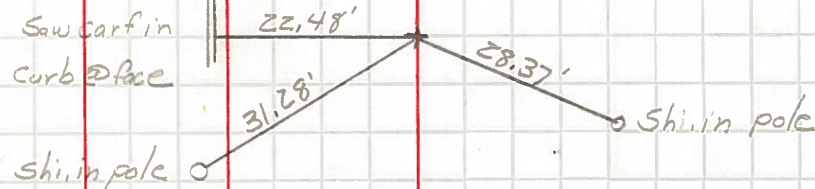

#865

790+11.22
Eced Ave. Fd. x-in pavmt.

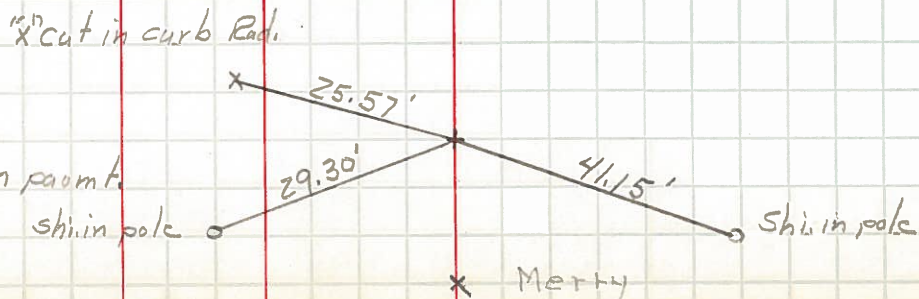

x Merry