

O.D.O.T. DISTRICT 2 SURVEY OFFICE (USE ONLY)

PERSONNEL

REFERENCE NO. 24 E

SHEET 27 OF 35

NOTES BARNHEISEL

DATE 6/11/92

ROUTE US 25

H.C. VAN DUSEN

WEATHER SUNNY

COUNTY WOOD

R.C. BARNHEISEL

TEMP. 60°

TOWNSHIP PLAIN

SECTION 24

DWG BY RHOADES PID _____

T 5 N R 10 E

TYPE MONUMENT P.K.NAIL

ON SURFACE - ~~BELOW~~ ON _____

OFFSET \odot PAVEMENT ON _____ LT : RT

22.8' TO RT EDGE PAVEMENT


STATION: 551+16

HORZ.DATUM: _____


GEOID: _____

GRID: NORTHING: _____

EASTING: _____

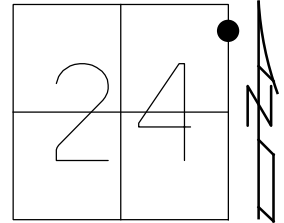

RECORD:
STA. 793+37.09
D.N.F.
6/11/92
SET P.K./WASHER
9/22/92, MB

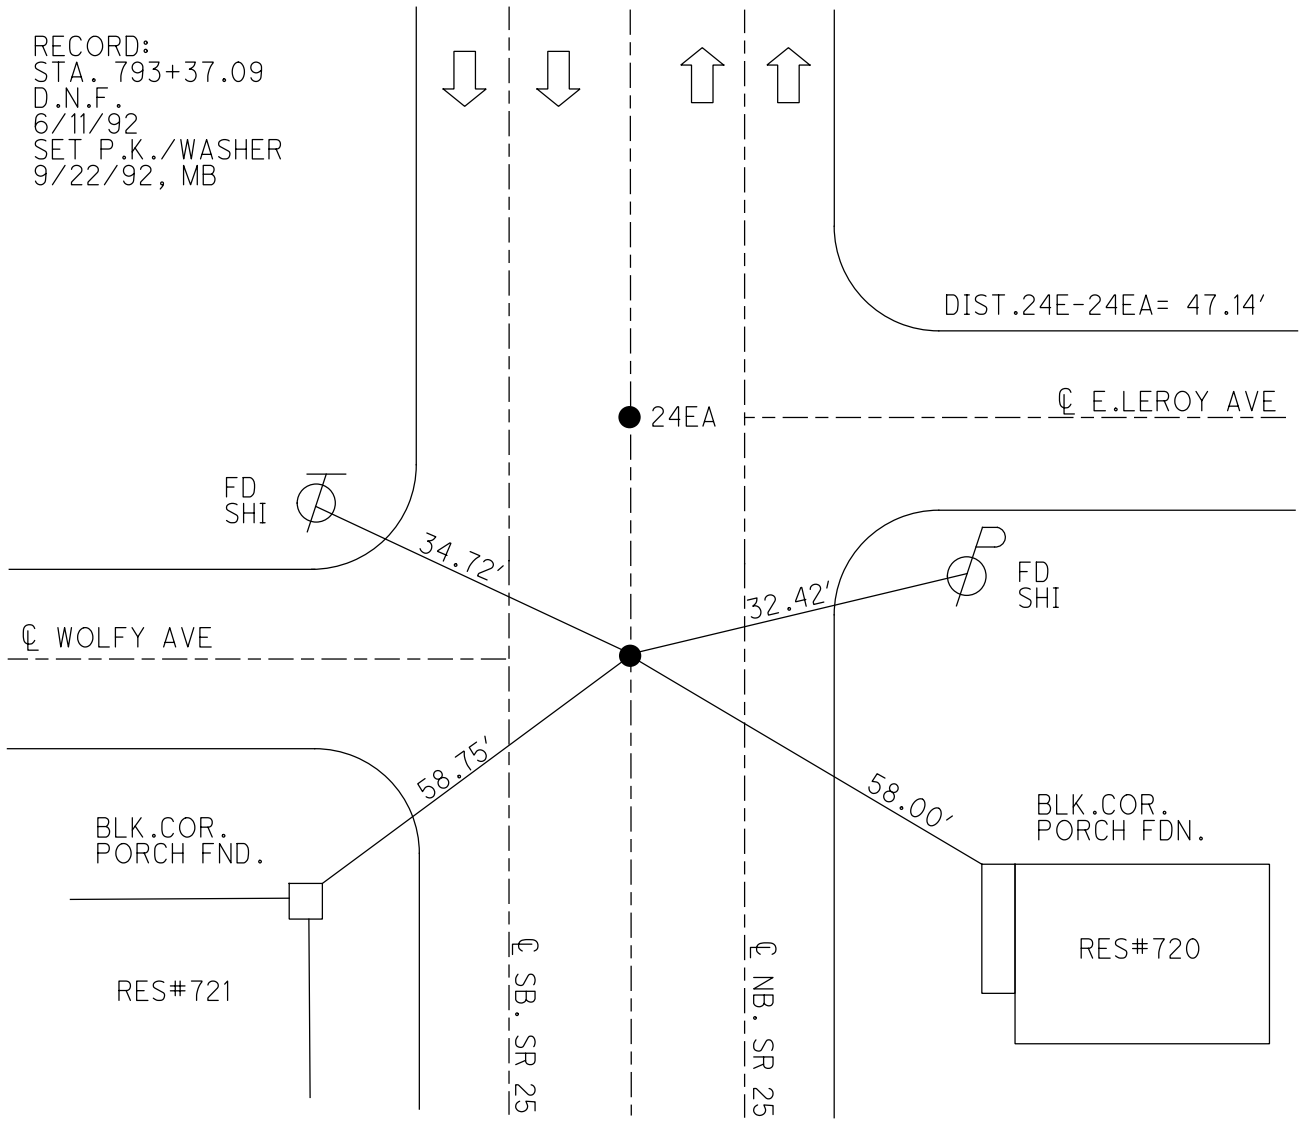

O.D.O.T. DISTRICT 2 SURVEY OFFICE

PERSONNEL

REFERENCE NO. 24-E

SHEET 17 OF 22

NOTES BAENNISEL

H.C. VAN DUSEN

DATE 6-11-92

ROUTE U.S. 25

R.C. BAENNISEL

WEATHER SUNNY

COUNTY Wood


TEMP. +60°

TOWNSHIP Plain

SECTION 24

T 5 N R 10 E


	PT "A"	PT "B"
TYPE MONUMENT	DESTROYED	P.K.
ON SURFACE -	BELOW -	YES
PT - E PAV'T. -	RIGHT BOTH	BOTH
22.5 TO RT LT EDGE PAVEMENT	Curb	
S.L.M.	<u>551416</u>	<u>551463</u>

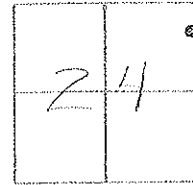

PT "A"
PT "B"

Set P.K.'s + Washers
7-22-92
MB

(RECORD!)
JOB STA: 792131.09

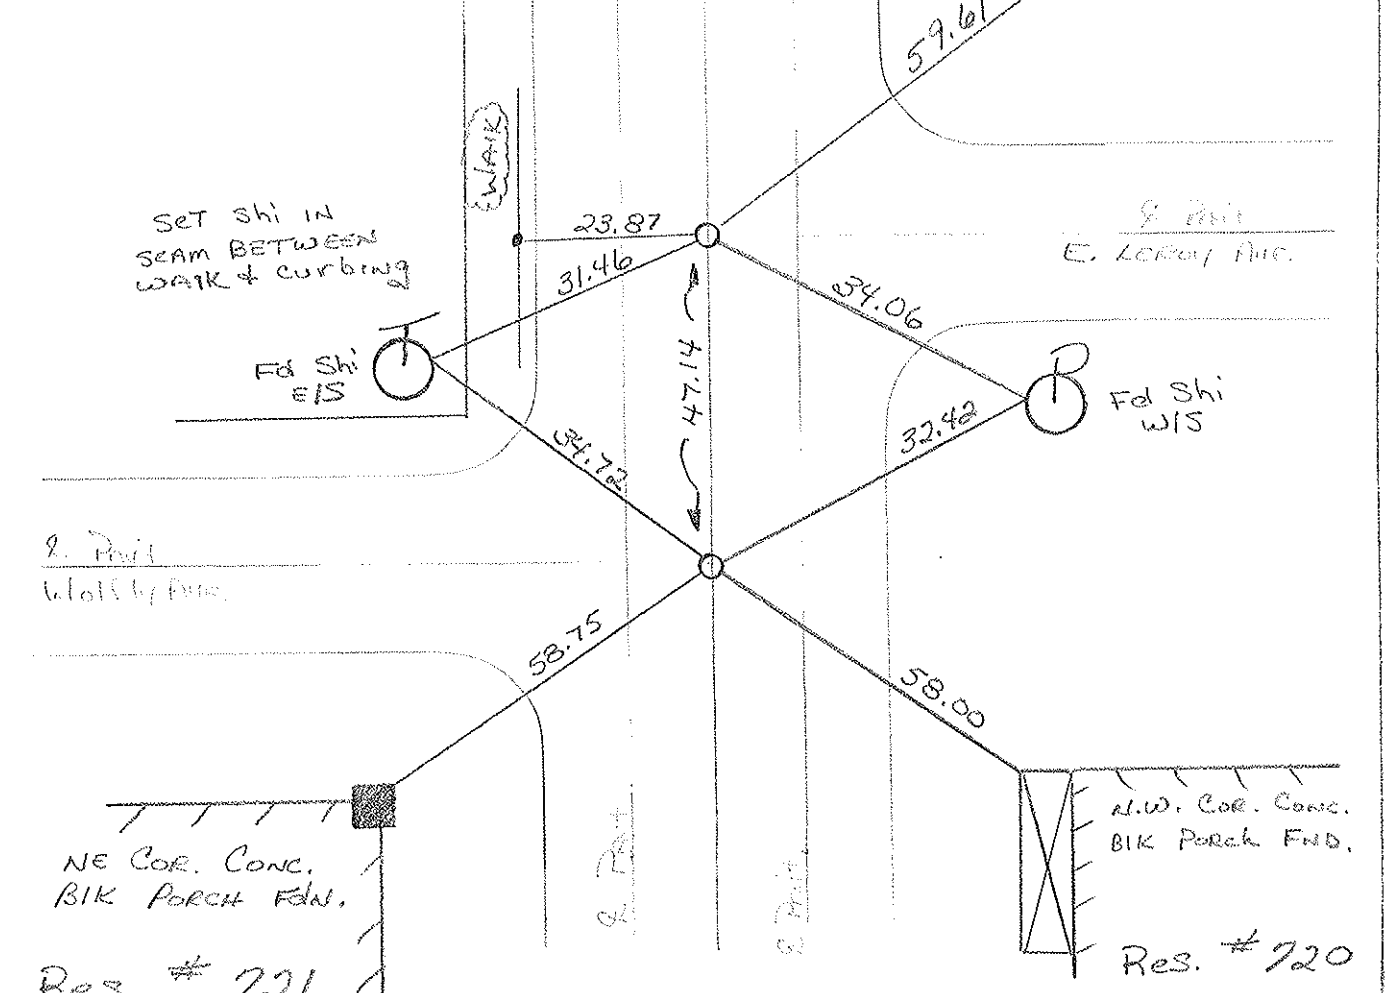

Res. # 721

Res. # 720

ODOT. DISTRICT 2 SURVEY OFFICE

SHEET _____ OF _____

County WOOD ^{U.S.} S.R. 25

Date 4-14-75

Township PLAIN

Weather CLOUDY

Section 24


Temp. 42°

T5N, R10E

Personnel BURNSIDE

SMITH


BOWER

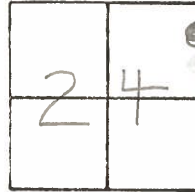

24-E

FD. P.K. NAIL
@ SURFACE
(796+62.96 OLD
S-A.)

SAW CARF IN
FACE SANDSTONE
CURB

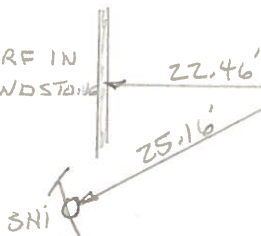

62.89'

68.71'

32.76'


FRAZEE AVE.

S.W. COR. BRICK
PORCH POST
RES. #904

N.W. COR. CONC.
BLK. PORCH FDN.
RES. #824

FD. P.K. NAIL
@ SURFACE
(793+37.09 OLD STA.)

SAW CARF IN
FACE SANDSTONE
CURB

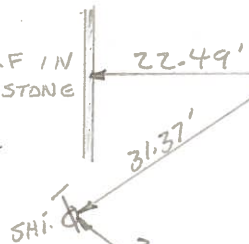

59.69'

34.16'

40.18'

EAST LEROY AVE.

S.W. COR. BRICK
PORCH POST
RES. #802

"+" TOP SANDSTONE
CURB

WOLFLY AVE.

FD. P.K. NAIL
@ SURFACE

N.E. COR. CONC.
BLK. PORCH
FDN.
RES. #721

58.75'

58.00'

N.W. COR. CONC.
BLK. PORCH FDN.
RES. #720

PERSONNEL TITLE PERSONNEL TITLE

COUNTY Wood DATE 4/22/58

S. R. 25 WEATHER

SEC. BG. TEMP.

DESCRIPTION LEFT CENTER LINE RIGHT JOB NO.

72. 817+80.10 W. Corp. line Shiner Note: see sheet # 8E

71. 816+73.10 E. Corp. line P.L. Note: see sheet # 8E

70. 804+79.1 End of conc. pavmt.
 69. 804+50.22 Pce Rd. W. man box Note: see sheet # 8D

#868
 803+70.40 Pce Rd. E. man box Note: see sheet # 8D

#867
 796+62.96 Frazee Ave. 22.47' saw cart top edge face curb
 24.91' Shi. in pole
 36.81' Shi. in pole
 (24-E-1)

#866
 793+37.09 Leroy Ave. 22.48' saw cart in curb @ Pce
 31.28' Shi. in pole
 28.37' Shi. in pole
 (24-E)

#865
 790+11.22 Reed Ave. 25.57' 8" cut in curb Radi.
 29.30' Shi. in pole
 41.15' Shi. in pole
 (24-D-1)

OD.O.T. DISTRICT 2 SURVEY OFFICE

SHEET OF

County WOOD ^{U.S.} S.R. 25

Date 4-14-75

Township PLAIN

Weather CLOUDY

Section 24


Temp. 42°

TEN, RIDE

Personnel BURNSIDE

SMITH

BOWER

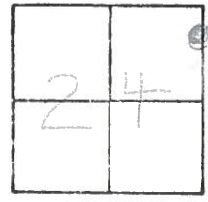

24-E

