

O.D.O.T. DISTRICT 2 SURVEY OFFICE (USE ONLY)

PERSONNEL

REFERENCE NO. 24 EA

SHEET 28 OF 35

NOTES BARNHEISEL

DATE 6/11/92

ROUTE US 25

H.C. VAN DUSEN

WEATHER SUNNY

COUNTY WOOD

R.C. BARNHEISEL

TEMP. 60°

TOWNSHIP PLAIN

SECTION 24

DWG BY RHOADES

PID _____

T 5 N R 10 E

TYPE MONUMENT P.K.NAIL

ON SURFACE - ~~BELOW~~ ON

OFFSET ☉ PAVEMENT ON _____ LT : RT

22.5' TO LT EDGE PAVEMENT


STATION: 551+63

HORZ.DATUM: _____


GEOID: _____

GRID: NORTHING: _____

EASTING: _____

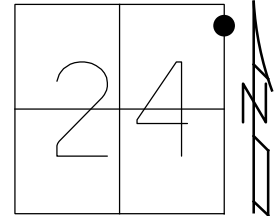

RECORD:
FD P.K.NAIL
6/11/92
SET P.K./WASHER
9/22/92, MB

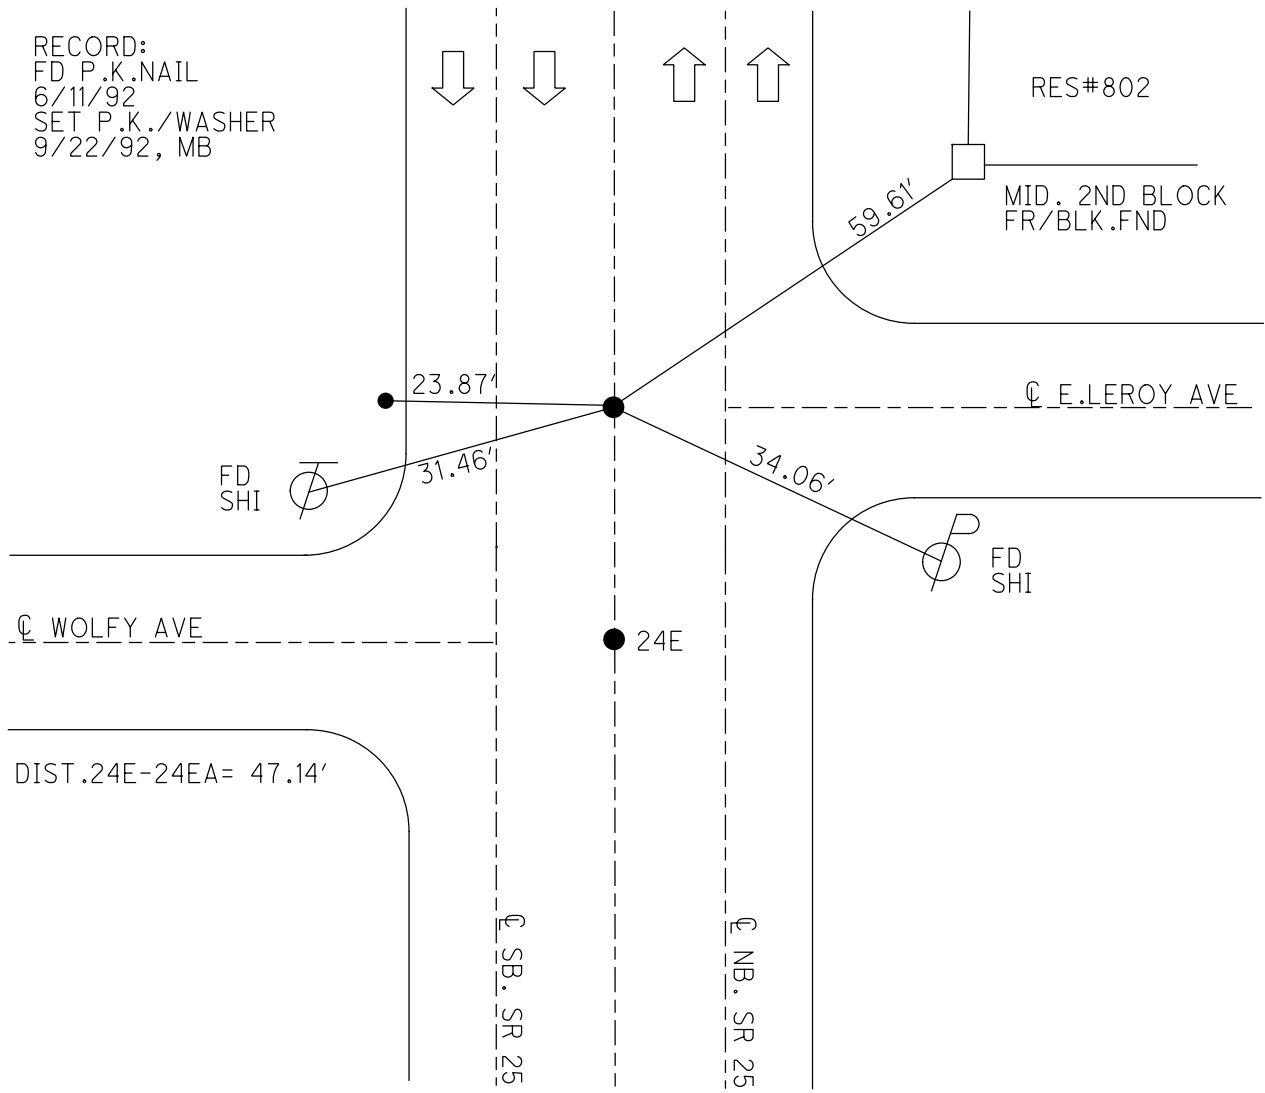

☉ WOLFY AVE

DIST. 24E-24EA = 47.14'

☉ SB. SR 25

☉ NB. SR 25

RES#802

MID. 2ND BLOCK
FR/BLK.FND

☉ E. LEROY AVE

FD
SHI

FD
SHI

24E

O.D.O.T. DISTRICT 2 SURVEY OFFICE

PERSONNEL

REFERENCE NO. 24-E

SHEET 17 OF 22

NOTES BAENNISEL

H.C. VAN DUSEN

DATE 6-11-92

ROUTE U.S. 25

R.C. BAENNISEL

WEATHER SUNNY

COUNTY Wood

TEMP. +60°

TOWNSHIP Plain

SECTION 24

T 5 N R 10 E


PT "A" PT "B"
TYPE MONUMENT DESTROYED P.K.

ON SURFACE - BELOW - yes

RT - E. PAV'T. - RIGHT BOTH BOTH

22.5 TO RT EDGE PAVEMENT Curb

S.L.M. 551416 551463

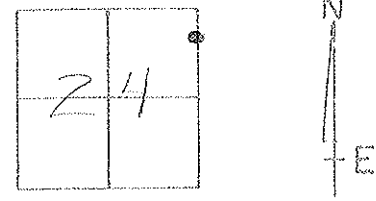

PT "A"
PT "B"

Set P.K.'s + Washers
7-22-92
MB

(RECORD!)
JOB STA: 792131.09

Set Shi IN
SEAM BETWEEN
WALK & curbing

2. Point
W/15 by Pinc.

NE COR. CONC.
BIK PORCH FND.

Res. # 721


Res # 802
MIDDLE OF 2nd BRK
4' FROM BIK FND.

2. Point
E. LEROY AVE.

Fd Shi
W/5

N.W. COR. CONC.
BIK PORCH FND.

Res. # 720

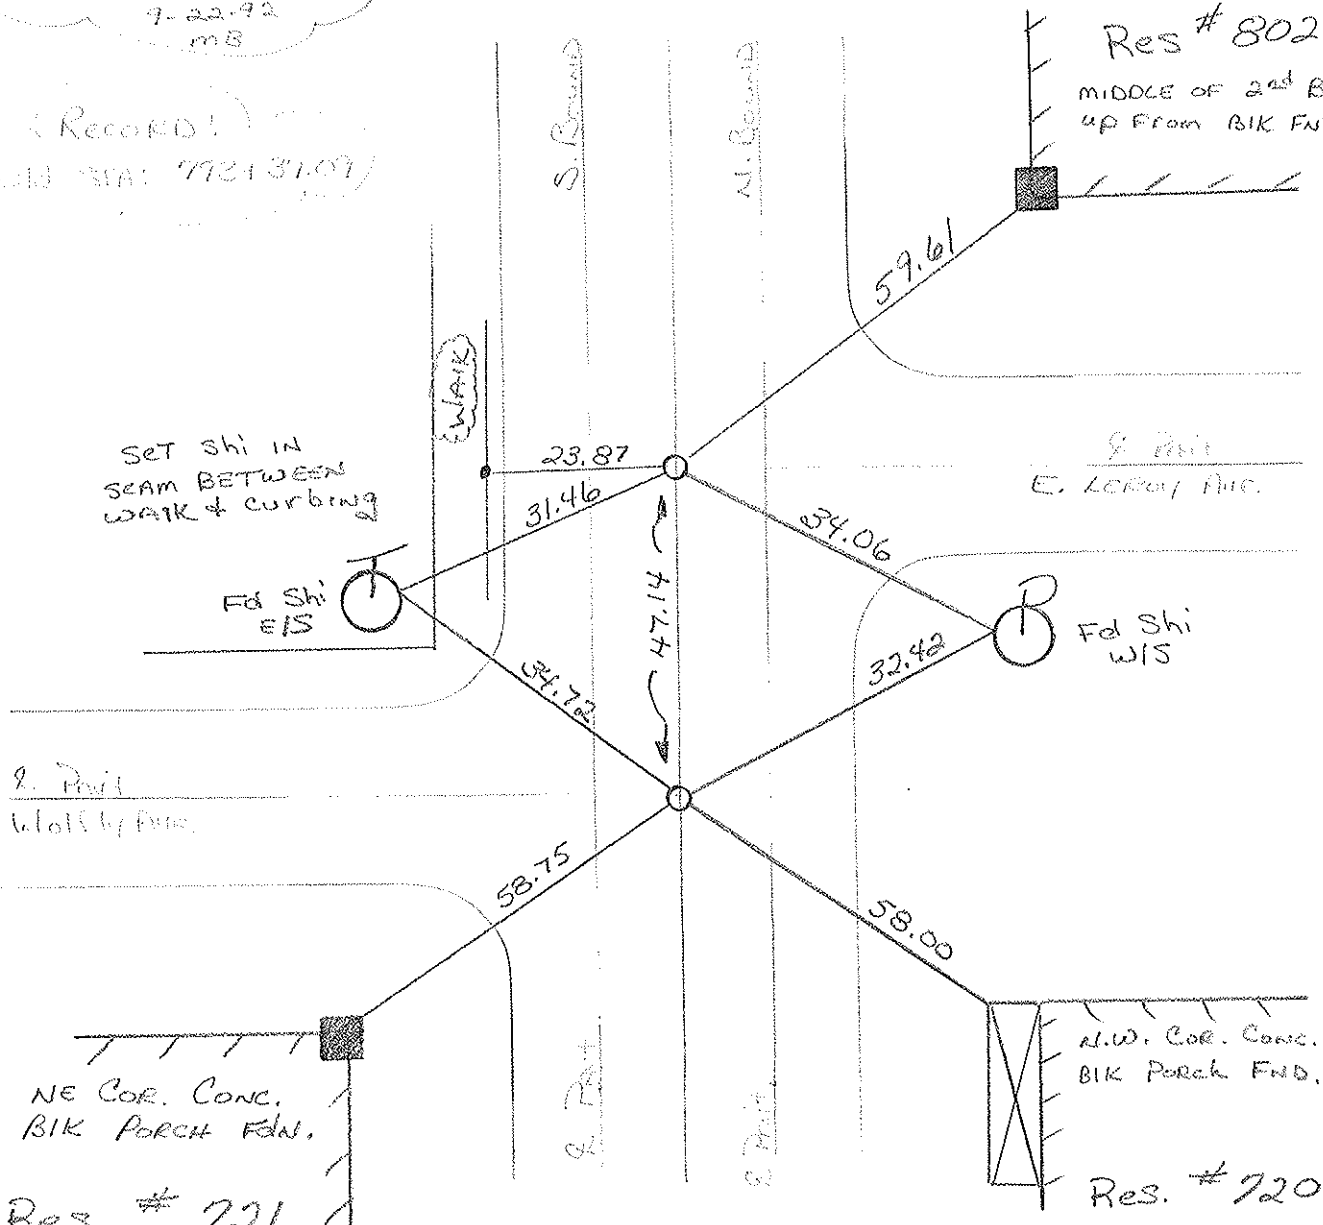

ODOT. DISTRICT 2 SURVEY OFFICE

SHEET _____ OF _____

County WOOD ^{U.S.} S.R. 25

Date 4-14-75

Township PLAIN

Weather CLOUDY

Section 24


Temp. 42°

T5N, R10E


Personnel BURNSIDE

SMITH

BOWER

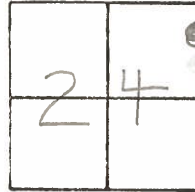

24-E

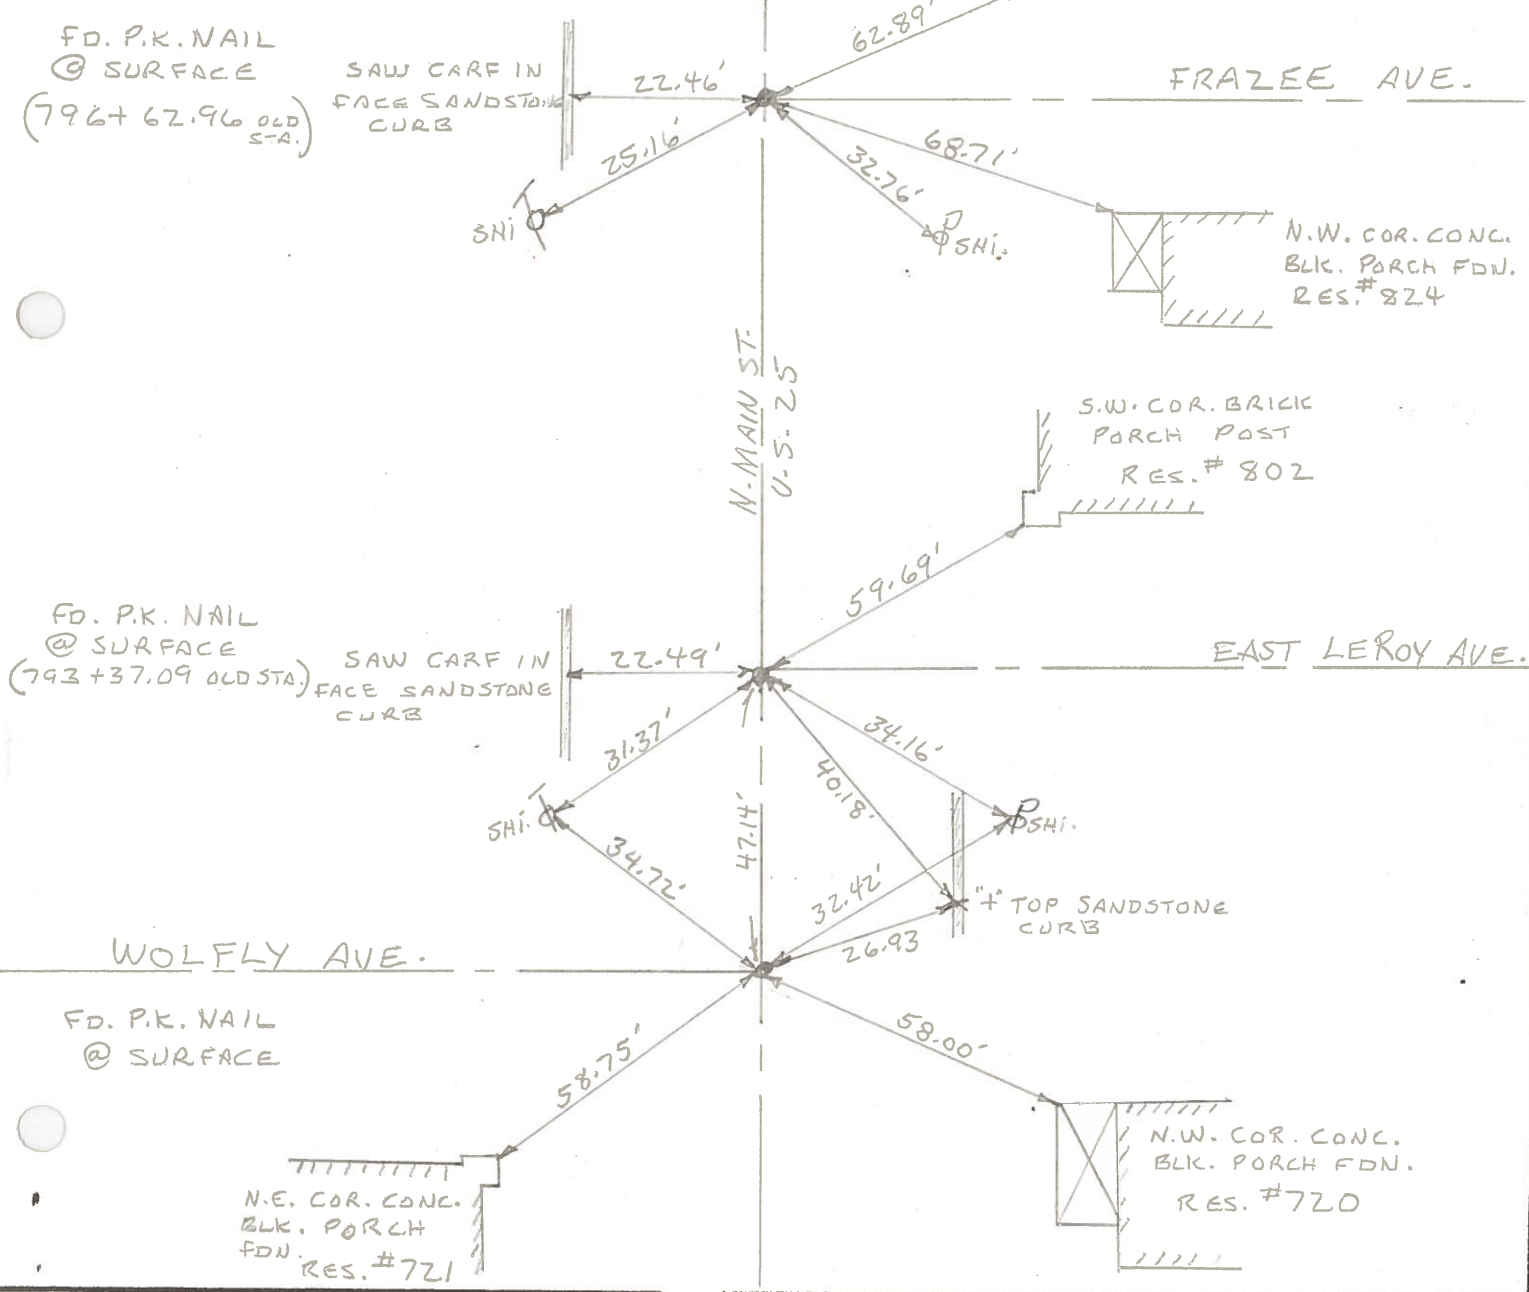

PERSONNEL	TITLE	PERSONNEL	TITLE	COUNTY	DATE
				<u>Wood</u>	<u>4/22/58</u>
				S. R. <u>25</u>	WEATHER
				SEC. <u>B6.</u>	TEMP.

DESCRIPTION	LEFT	CENTER LINE	RIGHT	JOB NO.
12. 817+80.10 W. Corp. line			Shiner Note: see sheet # 8E	
11. 816+73.10 E. Corp. line			P.L. Note: see sheet # 8E	
10. 804+79.1 End of conc. pavmt.				
9. 804+50.22 Pce Rd. W. man box			Note: see sheet # 8D	
#868 803+70.40 Pce Rd. E. man box			Note: see sheet # 8D	
#867 796+62.96 Frazee Ave. Fd. + cut in pavmt.	saw cut top edge face curb Shi. in pole	22.47' 24.91'	36.81' Shi. in pole	(24-E-1)
#866 793+37.09 Leroy Ave. Fd + cut in pavmt.	Saw cut in curb @ Pce Shi. in pole	22.48' 31.28'	28.37' Shi. in pole	(24-E)
#865 790+11.22 Reed Ave. Fd. x-in pavmt.	8" cut in curb Rad. Shi. in pole	25.57' 29.30'	41.15' Shi. in pole	(24-D-1)

OD.O.T. DISTRICT 2 SURVEY OFFICE

SHEET OF

County WOOD ^{U.S.} S.R. 25

Date 4-14-75

Township PLAIN

Weather CLOUDY

Section 24

Temp. 42°

TEN, RIDE

Personnel BURNSIDE

SMITH

BOWER



24-E

