

O.D.O.T. DISTRICT 2 SURVEY OFFICE (USE ONLY)

PERSONNEL

REFERENCE NO. 28

SHEET 34 OF 35

NOTES BARNHISEL

DATE 6/11/92

ROUTE US 25

H.C. VAN DUSEN

WEATHER SUNNY

COUNTY WOOD

R.C. BURNETT

TEMP. 69°

TOWNSHIP PLAIN

DWG BY RHOADES

PID \_\_\_\_\_

SECTION 13

T 5 N R 10 E

TYPE MONUMENT COPPERWELD MON.

~~ON SURFACE~~ - BELOW 2"

OFFSET  $\varnothing$  PAVEMENT 4.3' LT : ~~RT~~

33.8' TO LT EDGE PAVEMENT


STATION: 589+32

HORZ. DATUM: \_\_\_\_\_


GEOID: \_\_\_\_\_

GRID: NORTHING: \_\_\_\_\_

EASTING: \_\_\_\_\_

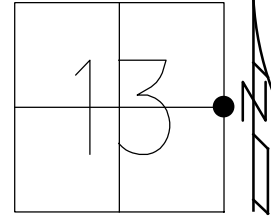

RECORD:  
FD COPPERWELD MON.  
2" DOWN  
6/11/92, MB  
SET P.K./WASHER  
7/14/92, MB

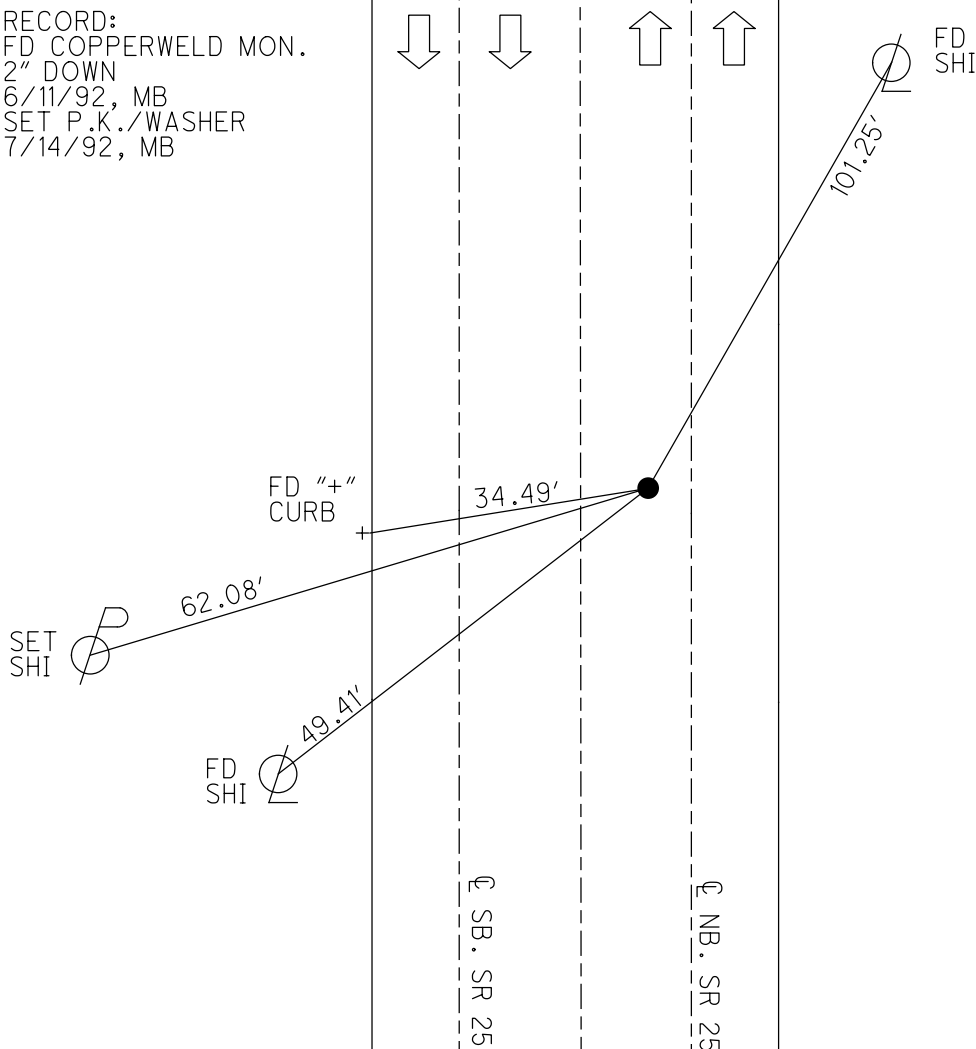

# O.D.O.T. DISTRICT 2 SURVEY OFFICE

PERSONNEL

REFERENCE NO. 28

SHEET 21 OF 22

NOTES CORRECT

H.C. VAN DUSEN

DATE 6-11-92

ROUTE U.S. 25

R.C. BURNETT

WEATHER SUNNY

COUNTY Wood

TEMP. +69°

TOWNSHIP Plain

SECTION 13

T. 5 N R. 10 E


TYPE MONUMENT COPPERWELD MON.

ON SURFACE - BELOW 2"


LEFT - C PAV'T. - RIGHT 4.3 OF E.N.B.L.

33.8 TO LT EDGE PAVEMENT

S.L.M. 589+32

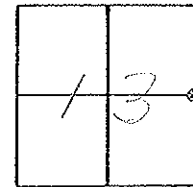

RESET P.K. & WASHER  
 7-14-92  
 M.B.

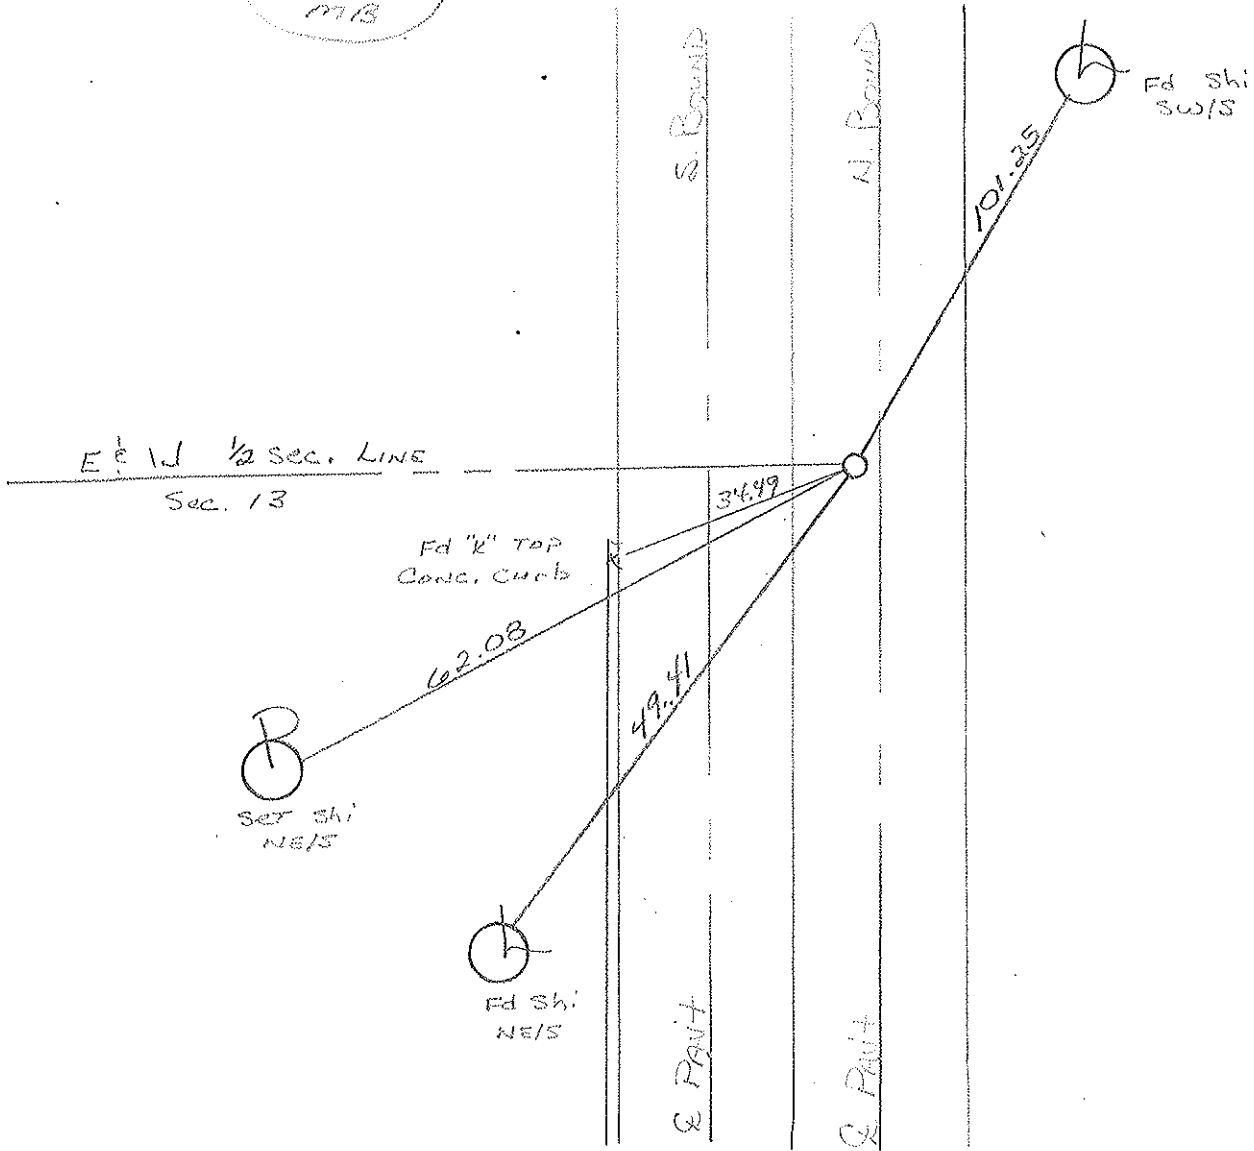

O.D.O.T. DISTRICT 2 SURVEY OFFICE

SHEET \_\_\_\_\_ OF \_\_\_\_\_

County WOOD <sup>U.S.</sup> ~~S.R.~~ 25

Date 2-18-77

Township PLAIN

Weather CLEAR

Section 13

Temp. 33°


T5N, R10E

Personnel BURNSIDE

SMITH

BOWERS

MEAD

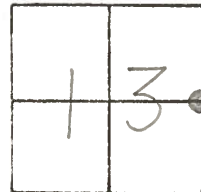

# 28

SHI. 14" PINE

TO BE REMOVED 1977

101.22' SHI.

SHI.

59.16

FD. COPPERWELD MKR. @ SURFACE

E & W 1/2 SEC. LINE  
SEC. 13

49.50'

16'

4" TOP CONC. CURB

49.50'

S. BOUND

4' CONC. MEDIAN

N. BOUND

SEC. 13  
SEC. 18

SHI.