

O.D.O.T. DISTRICT 2 SURVEY OFFICE (USE ONLY)

PERSONNEL _____

REFERENCE NO. 40

SHEET 17 OF 19

NOTES HOMAN

DATE 5/3/09

ROUTE SR 25

H.C. ROUSOS

WEATHER CLEAR

COUNTY WOOD

R.C. HOMAN

TEMP. 70°

TOWNSHIP MIDDLETON

SECTION 30

DWG BY RHOADES

PID 25519

T 6 N R 11 E

TYPE MONUMENT IPIPE

ON SURFACE - ~~BELOW~~ ON

OFFSET Q PAVEMENT 17.7' LT : ~~RT~~

- TO - EDGE PAVEMENT


STATION: 827+80

HORIZ.DATUM: NAD 83

GEOID: NAVD88 2003

GRID: NORTHING: 654861.262

EASTING: 1653009.159

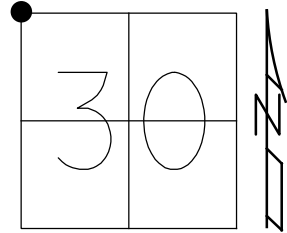

NOTE: NW.COR.SEC.30

Q SR 582

Q SR 582

CUT "+"
CBS



53.11' P

10.92' P

CUT "+"
CBS



Q SB SR 25

Q NB SR 25

RECORD:
SET 1" IPIPE
4/7/03, MB
FD 1" IPIPE
LEANING NORTH
12/4/07
CP2
5/3/09, DCH

O.D.O.T. DISTRICT 2 SURVEY OFFICE

PERSONNEL _____

REFERENCE NO. 40

SHEET 16 OF 18

NOTES HOMAN

DATE 5-3-09

ROUTE US 25

H.C. ROUSOS

WEATHER CLEAR

COUNTY WOOD

R.C. HOMAN

TEMP. 70°

TOWNSHIP MIDDLETON

SECTION 30

T 6 S R 11 E

TYPE MONUMENT 1" IRON PIPE

ON SURFACE - ~~BELOW~~ YES


LEFT - ☉ PAV'T - ~~RIGHT~~ 17.7' LT EB

_____ TO _____ EDGE PAVEMENT


S.L.M. 827+80

GPS Northing: 678735.39

Easting: 1657001.46

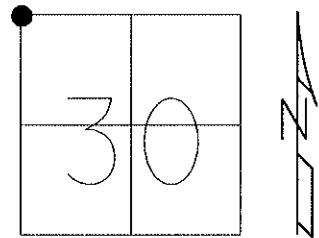

NOTE: FD 1" IRON PIPE
LEANING NORTH. NW.
CORNER OF SECTION 30,
DCH

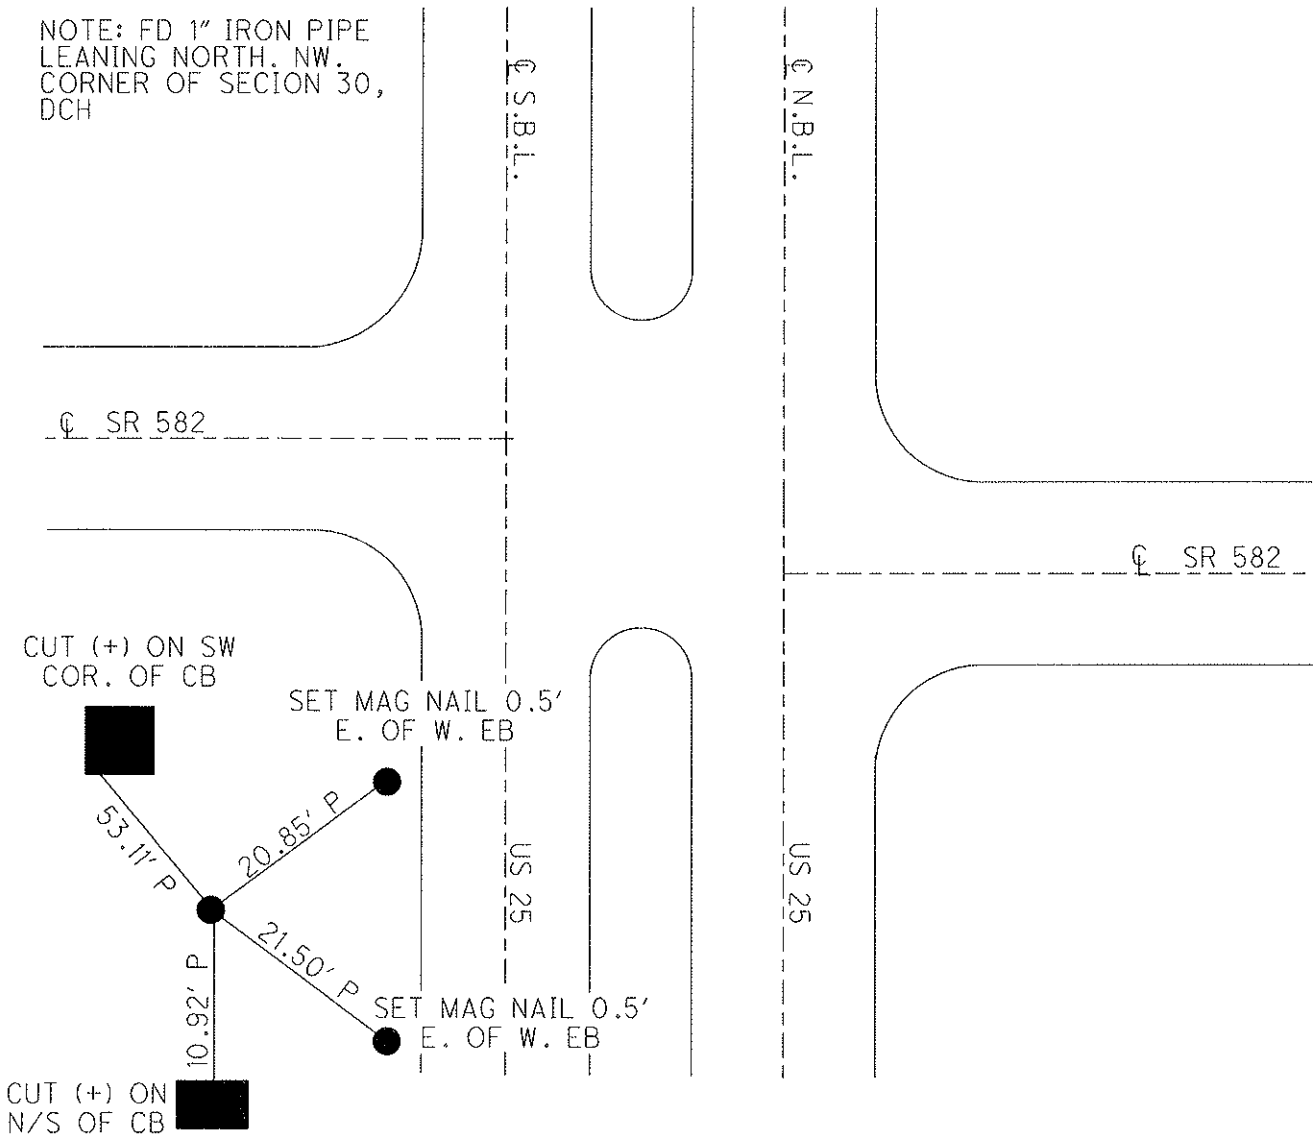

O.D.O.T. DISTRICT 2 SURVEY OFFICE

PERSONNEL

REFERENCE NO. 40

SHEET 1 OF 12

NOTES BARNHISEL

DATE 12-24-03

ROUTE US 25

H.C. CANTERBURY

WEATHER SNOW

COUNTY WOOD

R.C. BARNHISEL

TEMP. +33°

TOWNSHIP MIDDLETON

SECTION 30

T 6 N R 11 E


TYPE MONUMENT 1" IRON PIPE

ON SURFACE - BELOW SURFACE


LEFT - ~~C PAVT~~ RIGHT 17.7' LT. OF W. E.B.

TO EDGE PAVEMENT

S.L.M. _____

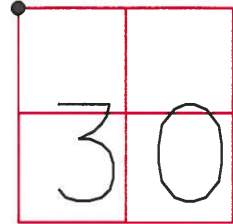

NOTE: FD. 1" IRON PIPE
LEANING NORTH. NW. CORNER
OF SECTION 30

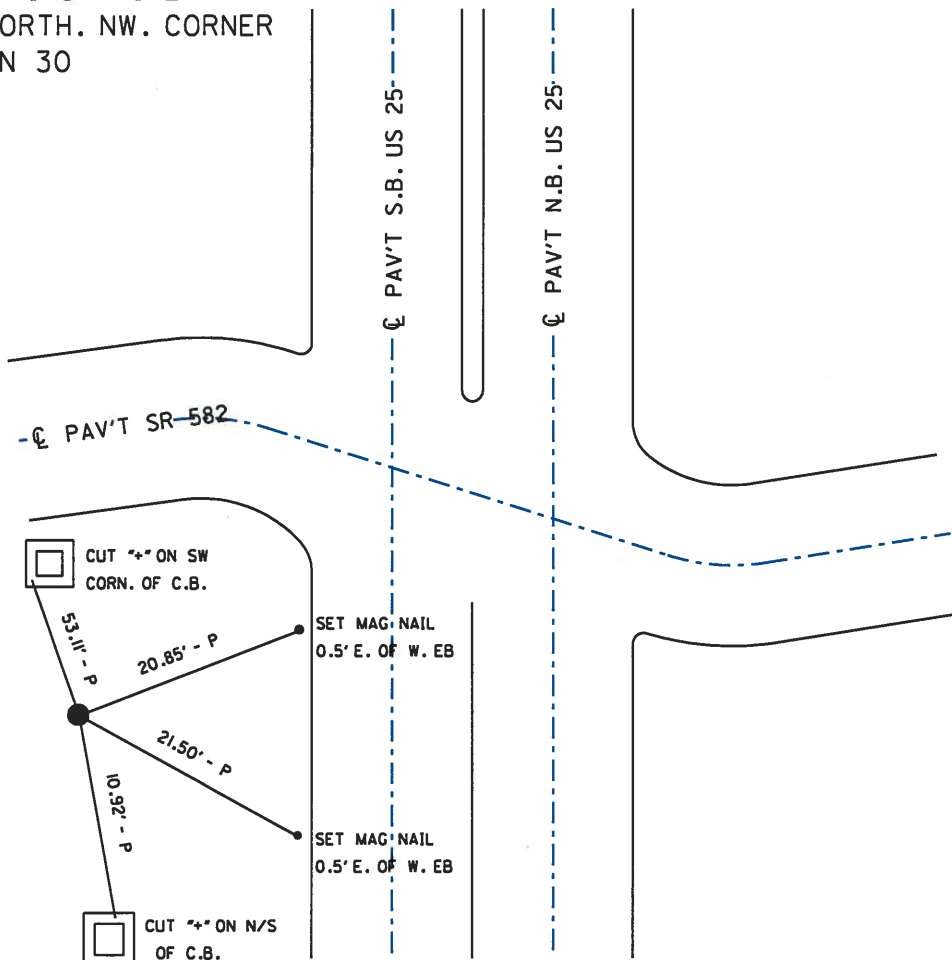

Resurfaced 2003

O.D.O.T. DISTRICT 2 SURVEY OFFICE

PERSONNEL

REFERENCE NO. 40

SHEET OF

NOTES BARNHISEL

DATE 12-24-03

ROUTE US 25

H.C. CANTERBURY

WEATHER SNOW

COUNTY WOOD

R.C. BARNHISEL

TEMP. +33°

TOWNSHIP MIDDLETON

SECTION 30

T 6 N R 11 E


TYPE MONUMENT 1" IRON PIPE

ON SURFACE - ~~BELOW~~ YES


LEFT - ~~C PAV'T~~ - ~~RIGHT~~ 17.7' LT OF W. E.B.

 TO EDGE PAVEMENT

S.L.M.

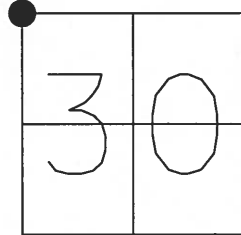

NOTE: FD 1" IRON PIPE
LEANING NORTH. NW. CORNER
OF SECTION 30

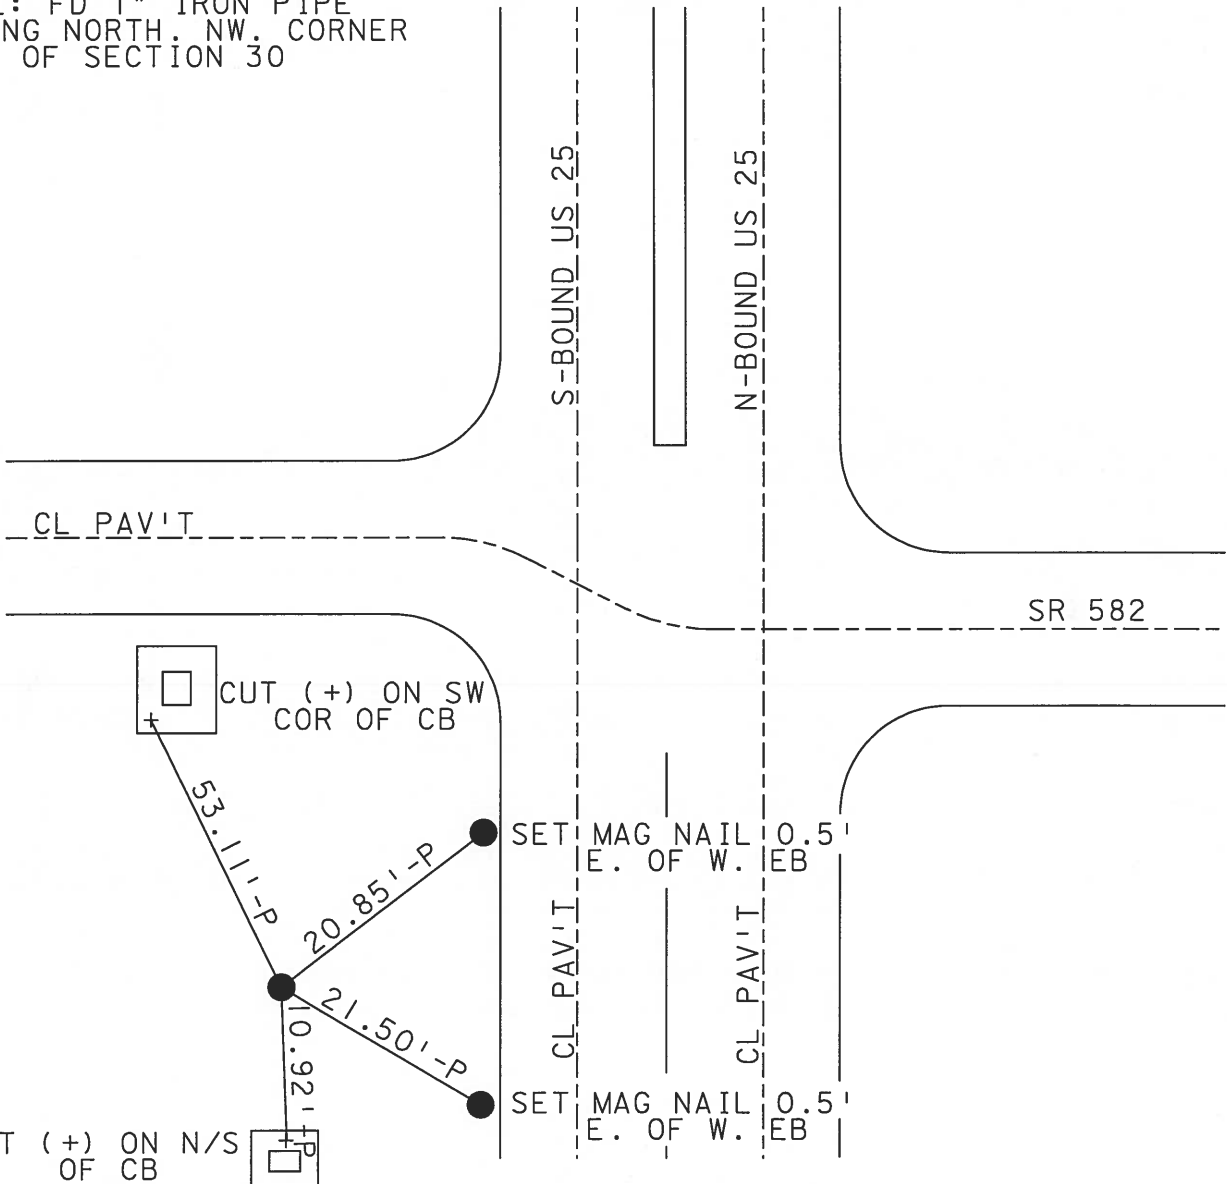

O.D.O.T. DISTRICT 2 SURVEY OFFICE

3 of 12

PERSONNEL

REFERENCE NO. 40^A & 41

SHEET 12 OF 12

NOTES VAN DUSEN

H.C. BARNHISEL

R.C. HEERMUER

SLOVAK

DATE 8-1-94

WEATHER CLEAR

TEMP. +75°

ROUTE U.S. 25

COUNTY WOOD

TOWNSHIP MIDDLETON

SECTION 25

T.6 N. R. 10 E

Pt. "A" Pt. "B"

TYPE MONUMENT Sm. RR. SPK'S

ON SURFACE - ~~BELOW~~ yes

LEFT- & PAV'T. - ~~RIGHT~~ 1.2 N.B.L.

10.0 TO RT EDGE PAVEMENT

S.L.M. 827+76 828+53

NOTE:
PT. 'A' & PT. 'B'
NOT RE-SET.
MB

