


O.D.O.T. DISTRICT 2 SURVEY OFFICE (USE ONLY)

PERSONNEL	REFERENCE NO. <u>44</u>	SHEET <u>4</u> OF <u>19</u>
NOTES <u>LEU</u>	DATE <u>5/28/20</u>	ROUTE <u>SR 25</u>
H.C. <u>O'DONNELL</u>	WEATHER <u>CLOUDY</u>	COUNTY <u>WOOD</u>
R.C. <u>AUBLE</u>	TEMP. <u>74°</u>	TOWNSHIP <u>MIDDLETON</u>
<u>RHOADES</u>		SECTION <u>36</u>
DWG BY <u>RHOADES</u>	PID <u>95722</u>	T <u>6</u> N R <u>11</u> E


TYPE MONUMENT MAG/WASHER
 ON SURFACE - ~~BELOW~~ ON
 OFFSET 4.1' TO LT PAVEMENT 7.4' LT : ~~RT~~
4.1' TO LT EDGE PAVEMENT
 STATION: 912+55.97

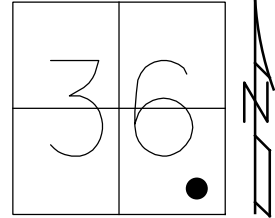

HORZ. DATUM: NAD83 (2011) GEOID: NAVD88 2012A
 GRID: NORTHING: 662125.926 EASTING: 1654310.870

RECORD: P.I.
 STA. 334+04.60
 $\Delta = 0^\circ 15' RT$
 FD BRASS MON
 4" DOWN
 5/14/06, MB
 FD MAG/WASHER
 REF44
 2/27/19, JFO
 SET MAG/WASHER
 10/16/20, JFO

DIST. 43A-44= 182.31'

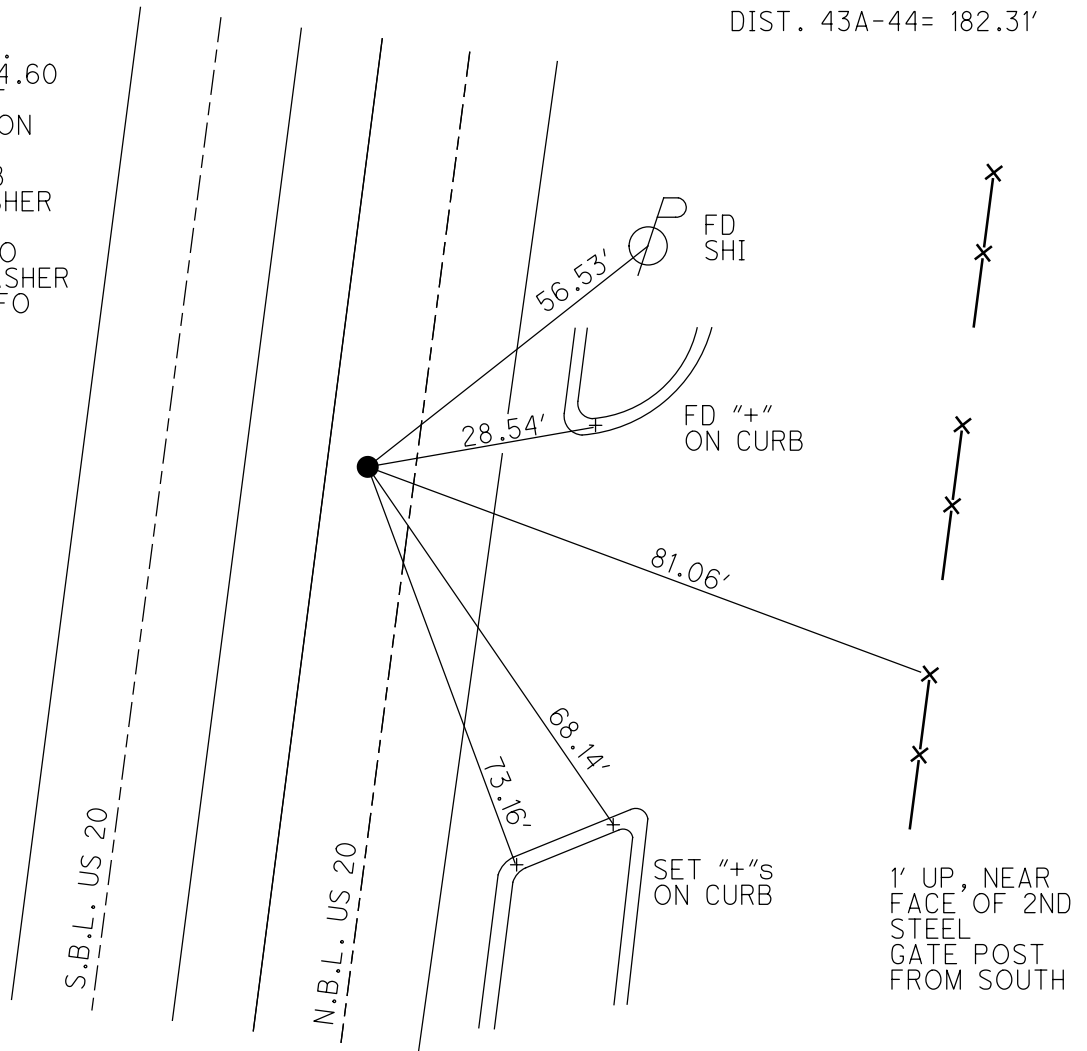

O.D.O.T. DISTRICT 2 SURVEY OFFICE

7 of 12

PERSONNEL

REFERENCE NO. 44

SHEET 4 OF 29

NOTES BARNHISEL

DATE 5/14/06

ROUTE SR #25

H.C. CANTERBURY

WEATHER CLEAR

COUNTY WOOD

R.C. RYALL

TEMP. +60°

TOWNSHIP MIDDLETON

HOMAN

SECTION 36

GLASS

T 6 N R 11 E



TYPE MONUMENT BRASS MON.

~~ON SURFACE~~ - BELOW 4"

LEFT - ~~6 PAVT~~ RIGHT 7'

4.1 TO LT EDGE PAVEMENT

S.L.M. 890+97

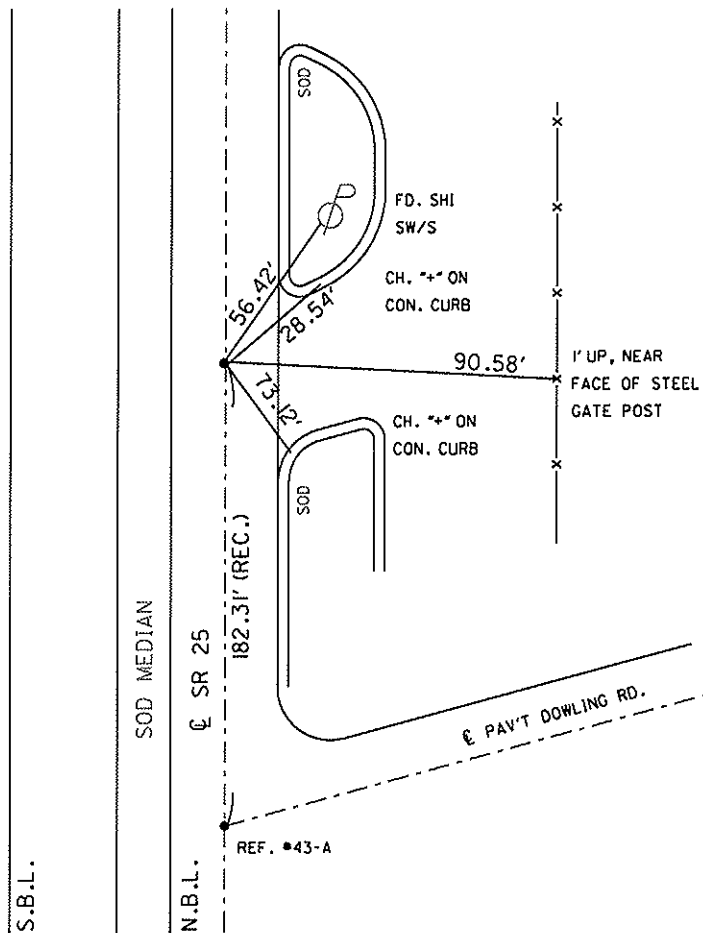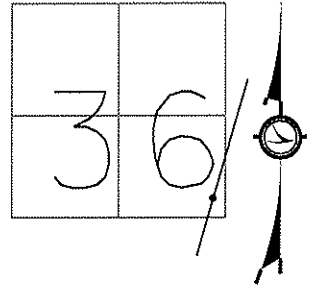

S.B.L.

N.B.L.

REF. #43-A

O.D.O.T. DISTRICT 2 SURVEY OFFICE

PERSONNEL _____

REFERENCE NO. 44

SHEET 4 OF 29

NOTES 1. Stone

H.C. D. Curtis

R.C. J. Householder

DATE 10 April 91

WEATHER Cold

TEMP. 38°

ROUTE SR #25

COUNTY Wood

TOWNSHIP Middleton

SECTION 36

T. _____ R. _____


TYPE MONUMENT Sm. R.R. Spk.

ON SURFACE - BELOW _____


LEFT - & PAV'T. - RIGHT _____

_____ TO _____ EDGE PAVEMENT

S.L.M. 890+97

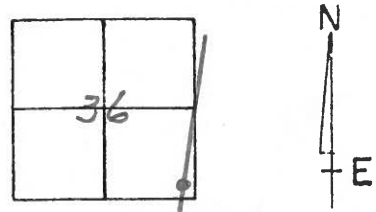

SET SM. R.R. SPK. TO SURFACE
6-14-91
AJC

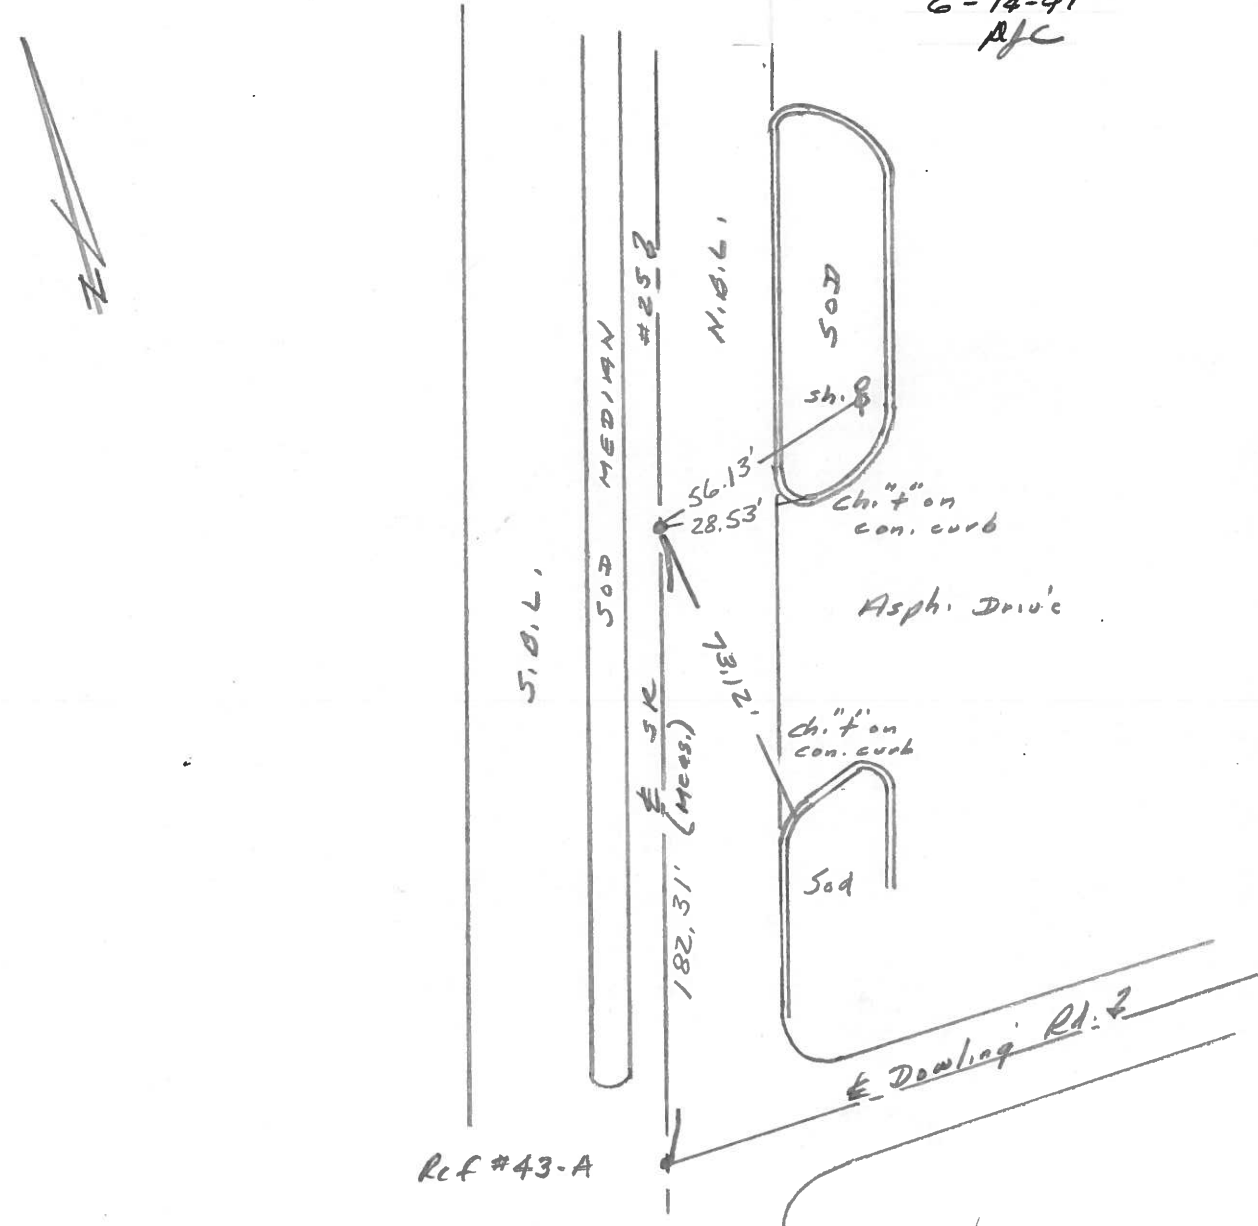

Ref #43-A

County Wood S.R. 25

Date 11-19-81

Township MIDDLETON

Weather cloudy

Section 36

Temp. +45°


T1N, R10E

Personnel Hoffman

Householder

Loehrke

#44

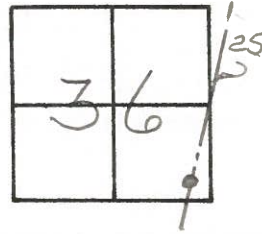

Fd. Brass nail 1 1/4" Below surface
6.7' W. of & PAUT N.B.L.
3.7' E. of W.E.P.

PROJECT sta ± 901+35

STA. 339+04.60 REC.
Δ = 0°-15' RT.

SET SMALL R.R. SPK.
B-5-B3 S.W.H.

