


O.D.O.T. DISTRICT 2 SURVEY OFFICE (USE ONLY)


PERSONNEL \_\_\_\_\_ REFERENCE NO. 50 B SHEET 6 OF 13  
 NOTES RHOADES DATE 3/26/18 ROUTE SR 25  
 H.C. O'DONNELL WEATHER SUNNY COUNTY WOOD  
 R.C. SEAMAN TEMP. 35° TOWNSHIP PERRYSBURG  
 DWG BY RHOADES PID 102808 SECTION 18  
 T 6 N R 11 E

TYPE MONUMENT MAG/WASHER  
 ON SURFACE - ~~BELOW~~ ON  
 OFFSET  $\varnothing$  PAVEMENT ON LT : RT  
- TO - EDGE PAVEMENT  
 STATION: 1066+77

HORIZ.DATUM: NAD83 2011 GEOID: NAVD88 2012A  
 GRID: NORTHING: 678492.418 EASTING: 165963.352

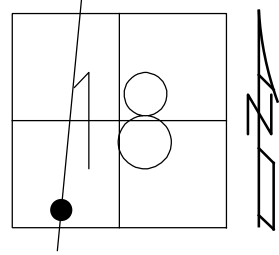

RECORD:  
 FD P.K.NAIL  
 4/10/91, IRS  
 SET P.K.NAIL  
 6/6/91, DJC  
 FD MAG/WASHER  
 REFB50  
 3/26/18, JFO  
 SET MAG/WASHER  
 2/4/19, JFO

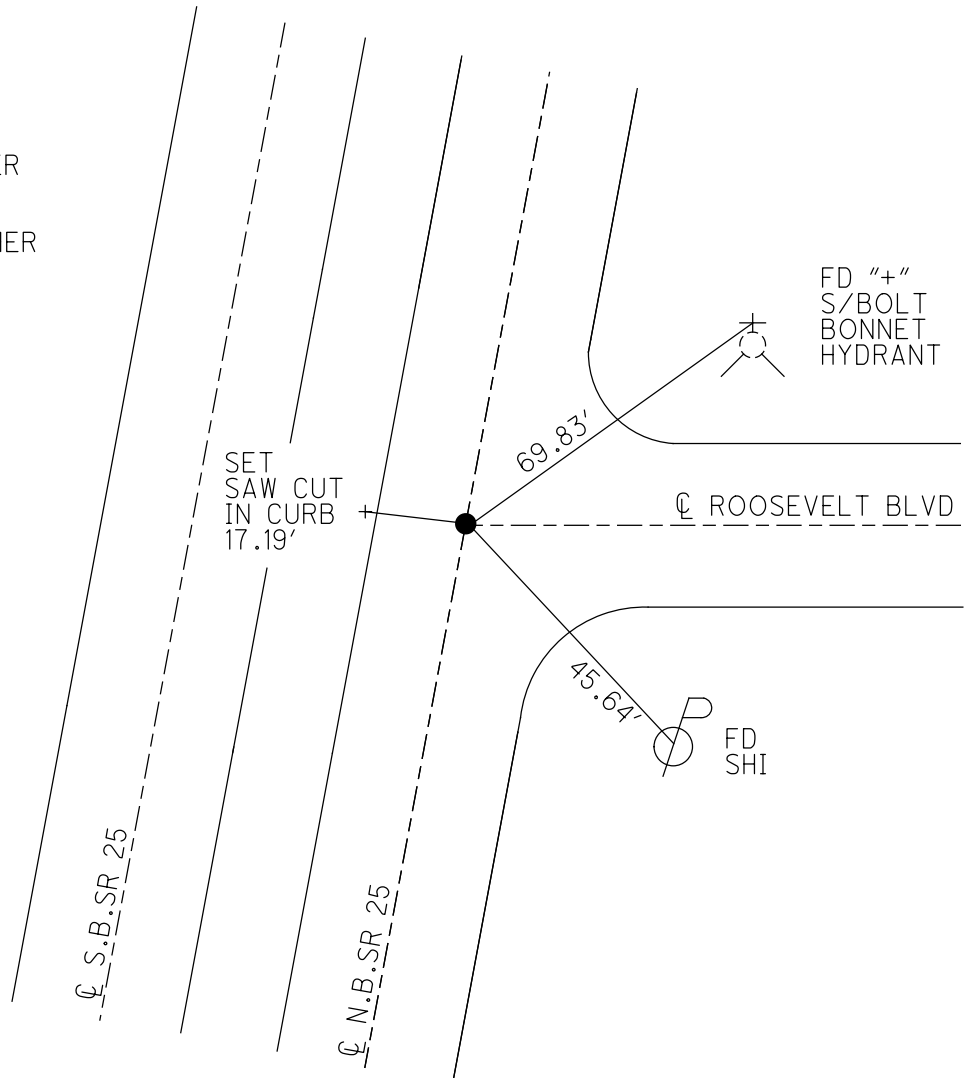

# O.D.O.T. DISTRICT 2 SURVEY OFFICE

PERSONNEL \_\_\_\_\_

REFERENCE NO. 50-8

SHEET 12 OF 29

NOTES 1. Stone

H.C. D. Curtis

R.C. F. Householder

DATE 10 April 1991

WEATHER Cold

TEMP. 360

ROUTE SR# 25

COUNTY Wood

TOWNSHIP Keaysburg

SECTION 18

T \_\_\_\_\_ R \_\_\_\_\_


TYPE MONUMENT PK Nail

ON SURFACE - BELOW Surface


LEFT - & PAW'T. - RIGHT \_\_\_\_\_

\_\_\_\_\_ TO \_\_\_\_\_ EDGE PAVEMENT

S.L.M. 1066477

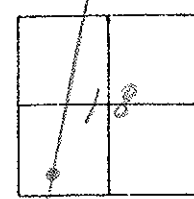

SET P.K. NAIL TO SURFACE  
6-6-91  
A/C

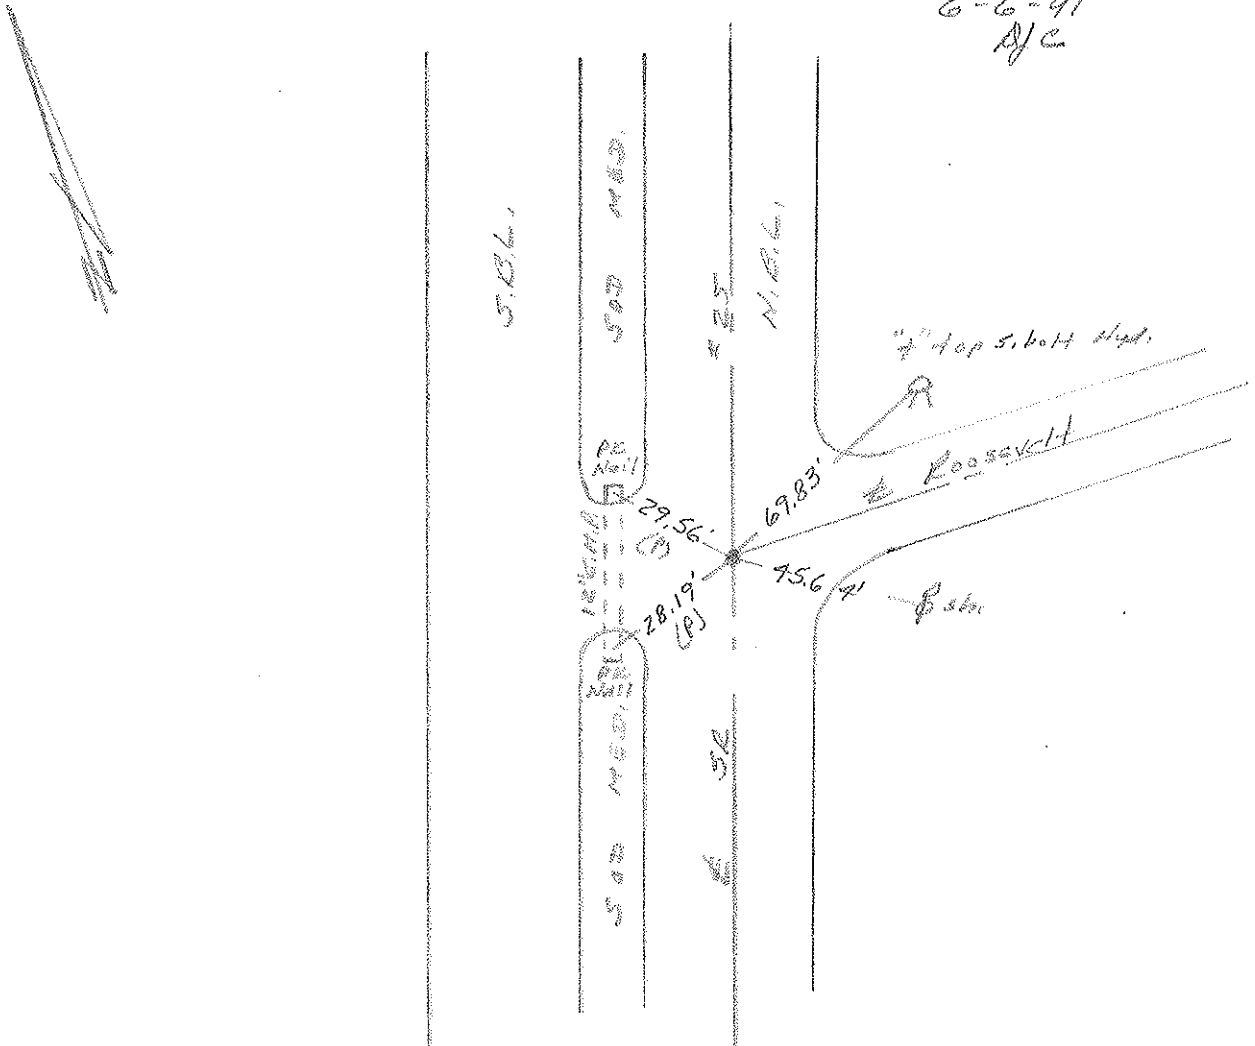

County Wood S.R. 25

Township Perrysburg

Section 18

T1N, R1E


Personnel Hoffman  
Householder  
Loehrke

Date 11-20-81

Weather Rain-Snow

Temp. +35°

50-B

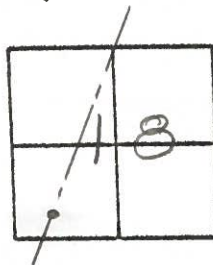

Fd. small nail @ surface  
 @  $\frac{1}{2}$  of both PAUTS.  
 (Set by others)

Project STA. ± 1067+15

SET P.K. NAIL  
 8-5-83 S.W.H.

