


O.D.O.T. DISTRICT 2 SURVEY OFFICE (USE ONLY)


PERSONNEL \_\_\_\_\_ REFERENCE NO. 50 D SHEET 8 OF 13  
 NOTES RHOADES DATE 3/26/18 ROUTE SR 25  
 H.C. O'DONNELL WEATHER SUNNY COUNTY WOOD  
 R.C. SEAMAN TEMP. 35° TOWNSHIP PERRYSBURG  
 \_\_\_\_\_ SECTION 18  
 DWG BY RHOADES PID 102808 T 6 N R 11 E

TYPE MONUMENT MAG/WASHER  
 ON SURFACE - ~~BELOW~~ ON \_\_\_\_\_  
 OFFSET ☉ PAVEMENT ON LT : RT \_\_\_\_\_  
 \_\_\_\_\_ TO \_\_\_\_\_ EDGE PAVEMENT  
 STATION: 1071+85

HORIZ.DATUM: NAD83 2011 GEOID: NAVD88 2012A  
 GRID: NORTHING: 678995.850 EASTING: 1657042.213

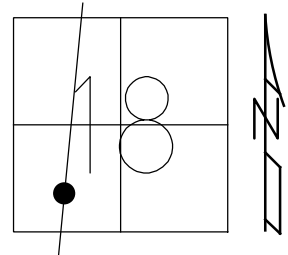


RECORD:  
 SET P.K.NAIL  
 6/6/91, DJC  
 FD P.K.NAIL  
 7/16/07, DCH  
 SET MAG/WASHER  
 11/13/07, SAH  
 FD MAG/WASHER  
 REFD50  
 3/26/18, JFO  
 SET MAG/WASHER  
 2/4/19, JFO

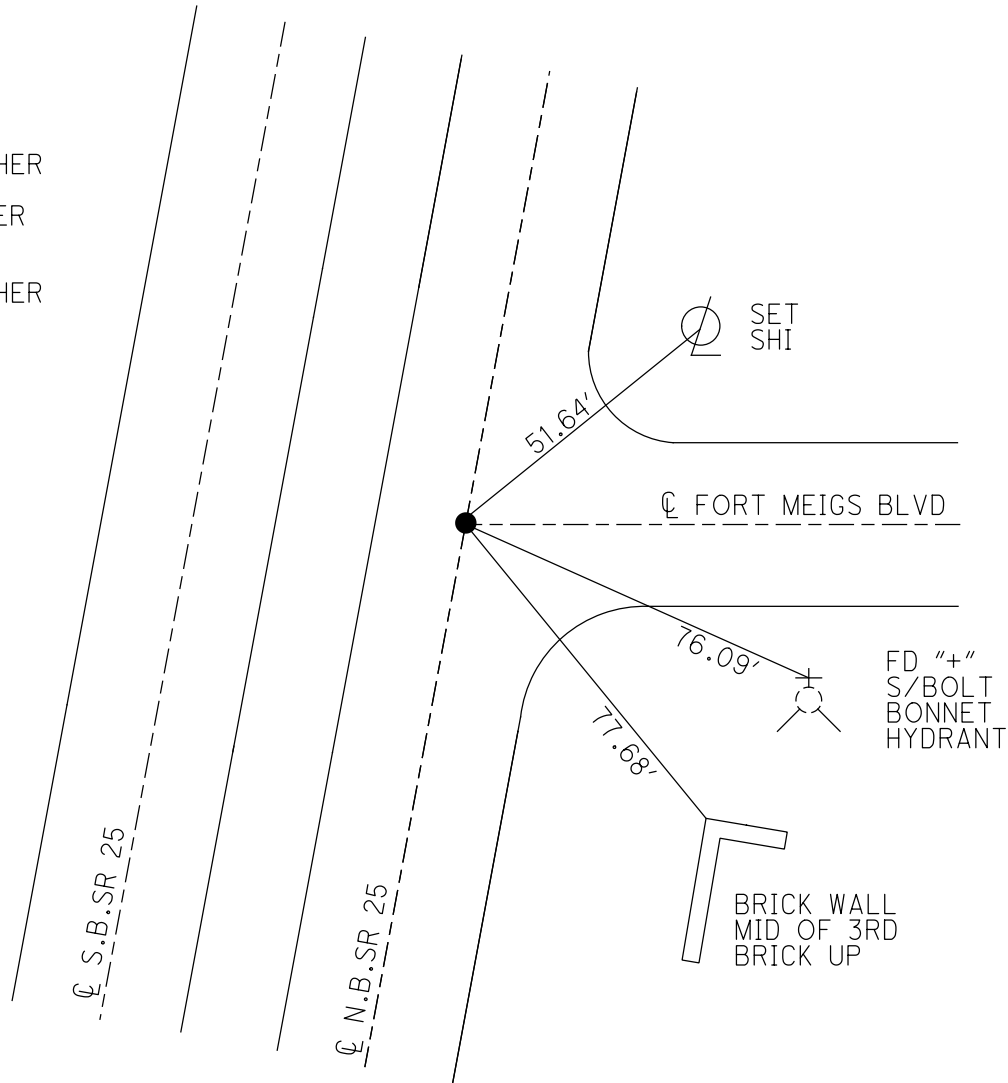


O.D.O.T. DISTRICT 2 SURVEY OFFICE (USE ONLY)

PERSONNEL \_\_\_\_\_ REFERENCE NO. 50 D SHEET 14 OF 29  
 NOTES HOMAN DATE 7/16/07 ROUTE US 25  
 H.C. HOMAN WEATHER CLOUDY COUNTY WOOD  
 R.C. VIETH TEMP. 75° TOWNSHIP PERRYSBURG  
 \_\_\_\_\_ SECTION 18  
 \_\_\_\_\_ T 4 S R 11 E

TYPE MONUMENT P.K.NAIL  
 ON SURFACE - ~~BELOW~~ ON \_\_\_\_\_  
 LEFT - ☉ PAV'T - RIGHT ON \_\_\_\_\_  
 - TO - EDGE PAVEMENT  
 S.L.M. 1071+85  
 GPS NORTHING: 678995.81 EASTING: 1657042.22

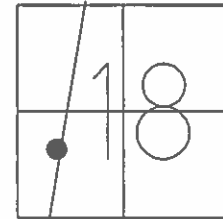

RECORD:  
 SET P.K.NAIL  
 6-06-91  
 SET MAG/WASHER  
 11/13/07, SAH

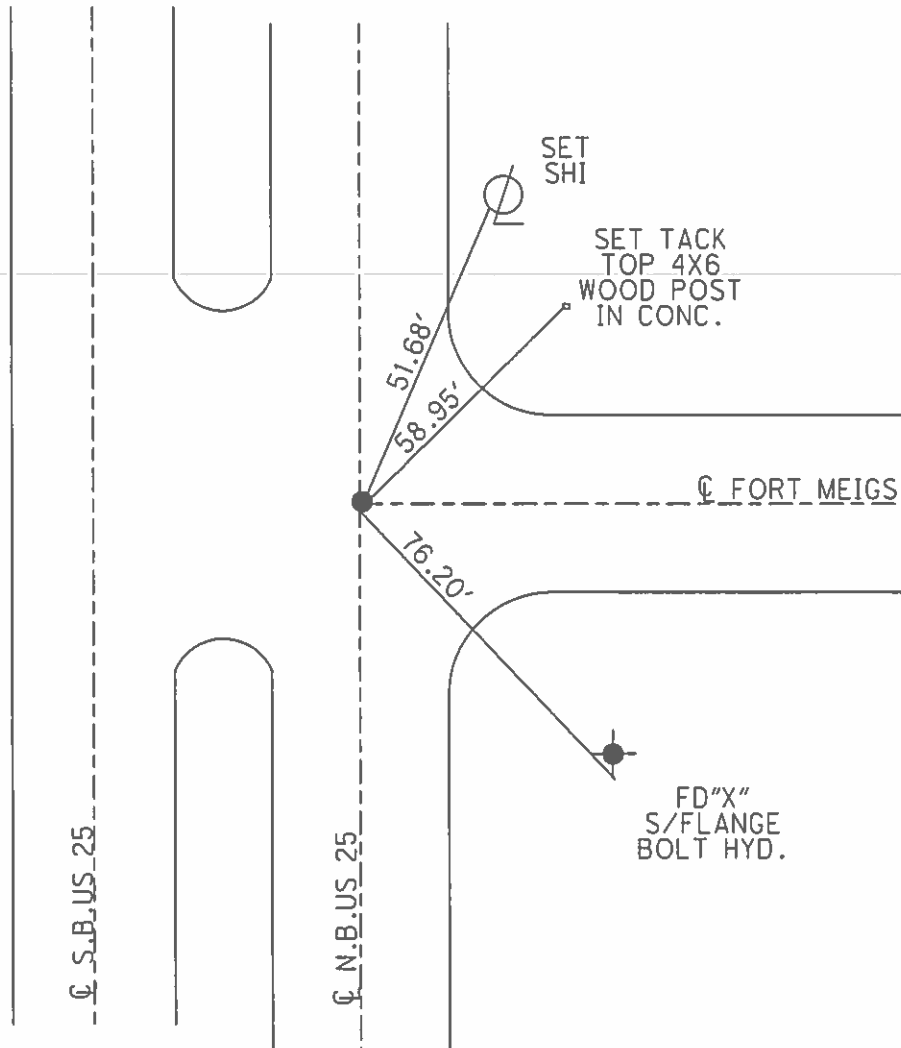

# O.D.O.T. DISTRICT 2 SURVEY OFFICE

PERSONNEL

REFERENCE NO. 50-D

SHEET 14 OF 29

NOTES I. Stone

H.C. D. Curtis

R.C. J. Householder

DATE 10 April 91

WEATHER Cold

TEMP. 38°

ROUTE SR#25

COUNTY Wood

TOWNSHIP Perrysburg

SECTION 18

T.     R.    


TYPE MONUMENT PK Nail

ON SURFACE - BELOW Surface


LEFT - & PAV'T. - RIGHT    

TO     EDGE PAVEMENT

S.L.M. 1071+85

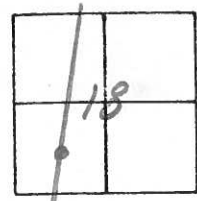

SET P.K. NAIL TO SURFACE  
6-6-91  
DJC

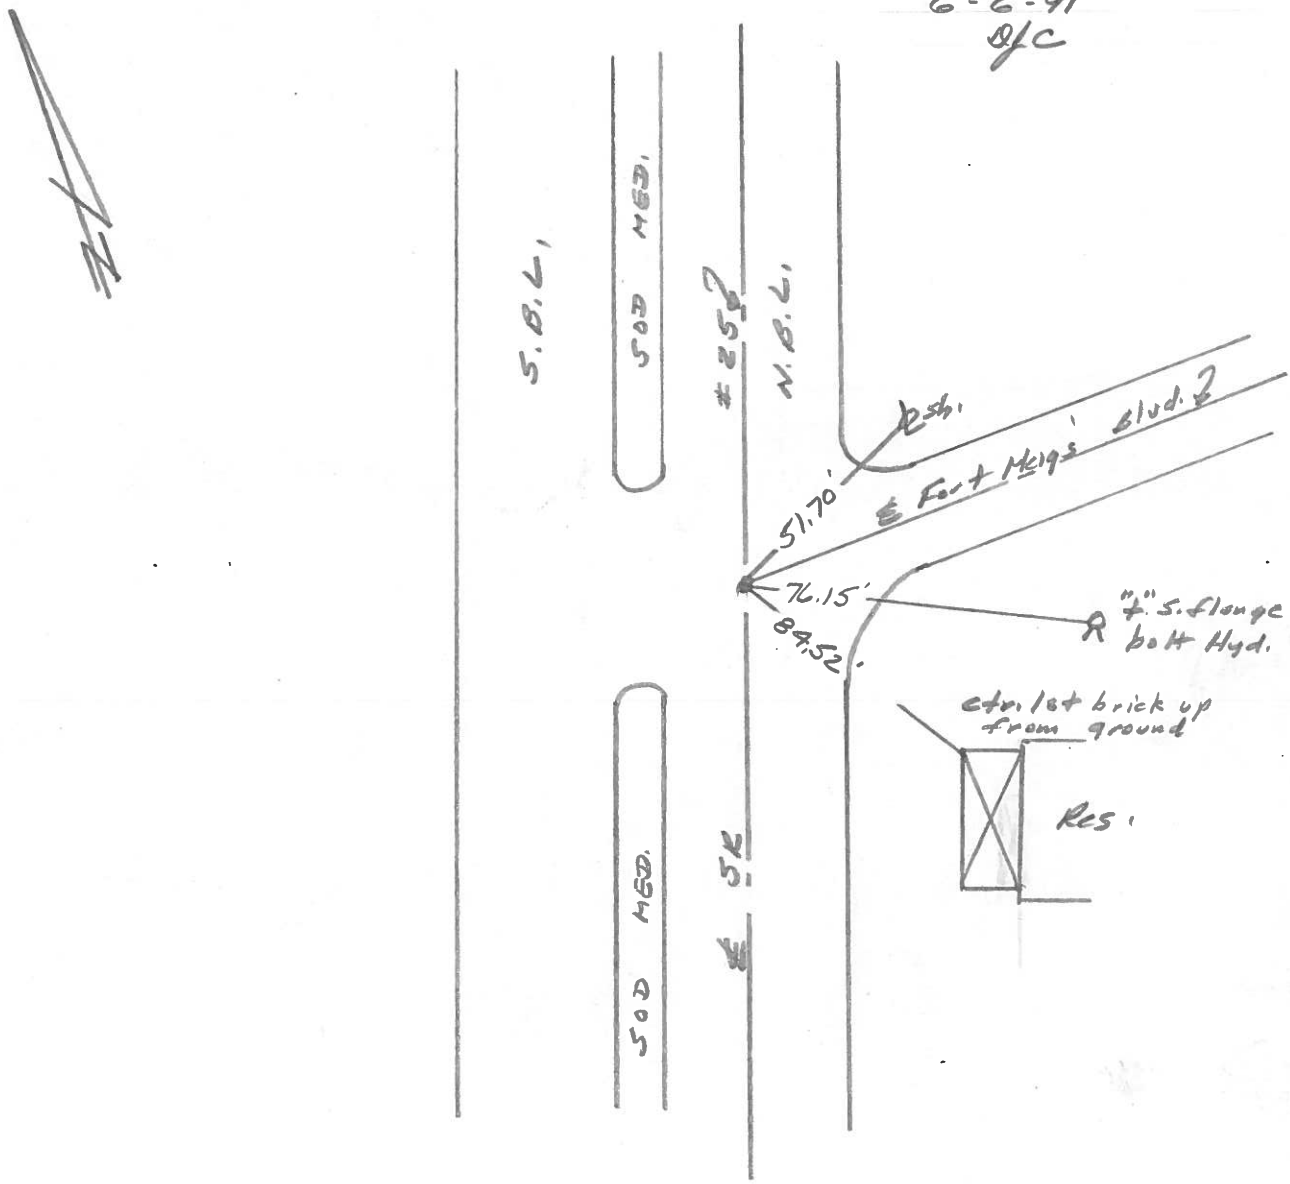

County Wood S.R. 25

Township Perrysburg

Section 18

TZN, R1E

Personnel Hoffman

Householder


Loehrke

Date 11-20-81

Weather RAIN-SNOW

Temp. +35°

50-D

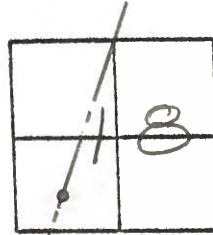

Fd. P.K. @ surface @ E of  
Both PAUTS.  
(set by others)

Project Sta ± 1072 + 24

SET P.K. NAIL  
8-5-83 S.W.H.

