

O.D.O.T. DISTRICT 2 SURVEY OFFICE (USE ONLY)

PERSONNEL

REFERENCE NO. 50 E

SHEET 9 OF 13

NOTES RHOADES DATE 3/26/18
 H.C. O'DONNELL WEATHER SUNNY
 R.C. SEAMAN TEMP. 35°

ROUTE SR 25
 COUNTY WOOD
 TOWNSHIP PERRYSBURG
 SECTION 18
 T 6 N R 11 E

DWG BY RHOADES PID 102808

TYPE MONUMENT MAG/WASHER

ON SURFACE - ~~BELOW~~ ON

OFFSET \varnothing PAVEMENT ON LT : RT

- TO - EDGE PAVEMENT


STATION: 1074+49

HORZ.DATUM: NAD83 2011


GEOID: NAVD88 2012A

GRID: NORTHING: 679255.276

EASTING: 1657082.957

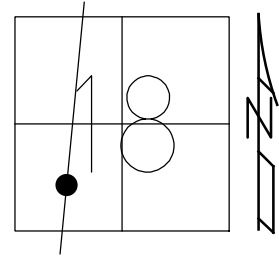


RECORD:
 SET P.K.NAIL
 6/6/91, DJC
 FD P.K.NAIL
 7/16/07, DCH
 SET MAG/WASHER
 11/13/07, SAH
 FD MAG/WASHER
 REFE50
 3/26/18, JFO
 SET MAG/WASHER
 2/4/19, JFO

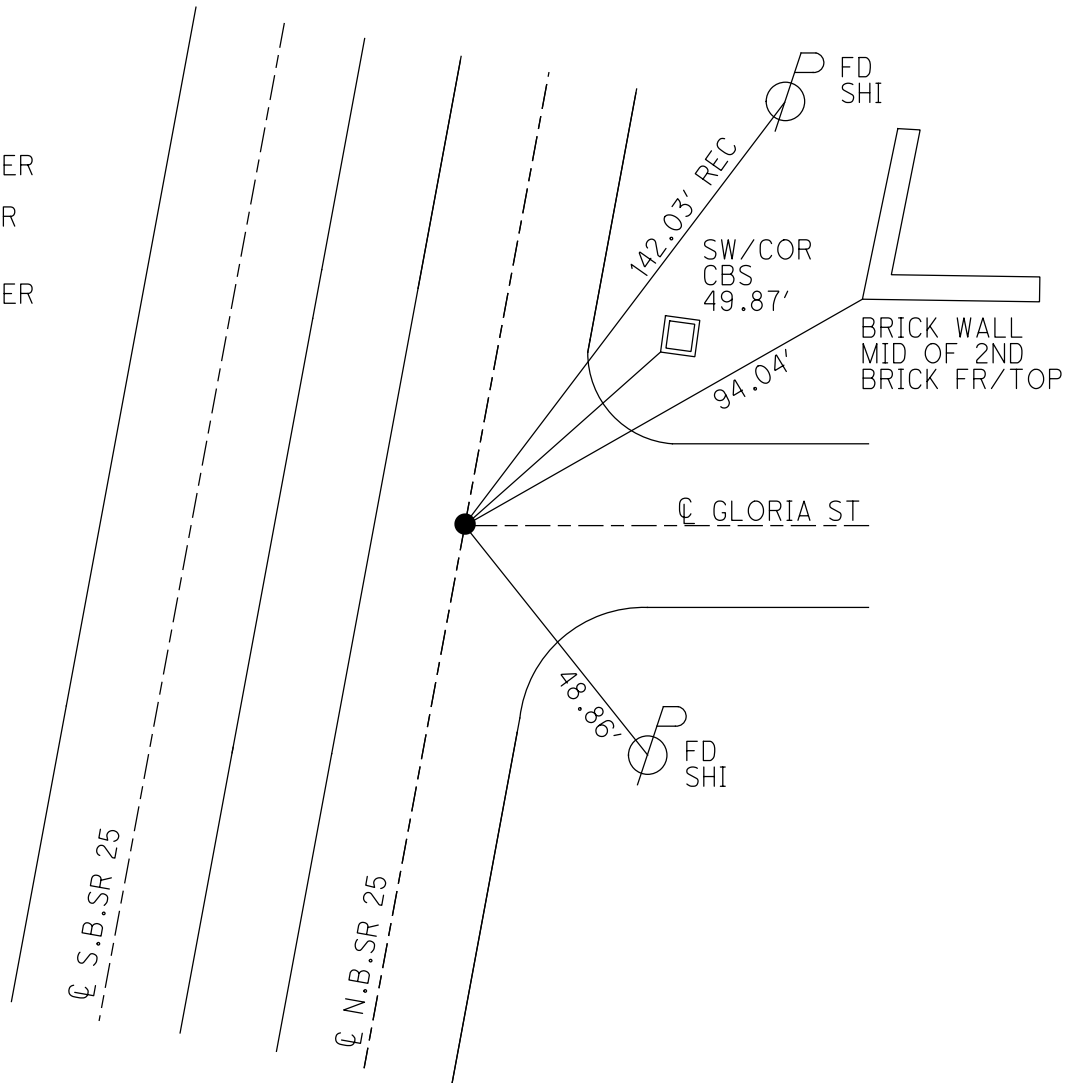


O.D.O.T. DISTRICT 2 SURVEY OFFICE (USE ONLY)

PERSONNEL _____ REFERENCE NO. 50 E SHEET 15 OF 29
 NOTES HOMAN DATE 7/16/07 ROUTE US 25
 H.C. HOMAN WEATHER CLOUDY COUNTY WOOD
 R.C. VIETH TEMP. 75° TOWNSHIP PERRYSBURG
 _____ SECTION 18
 _____ T 4 S R 11 E

TYPE MONUMENT P.K.NAIL
 ON SURFACE - ~~BELOW~~ ON
 LEFT - ☉ PAV'T - RIGHT ON
- TO - EDGE PAVEMENT
 S.L.M. 1074+49
 GPS NORTHING: 679255.29 EASTING: 1657082.92

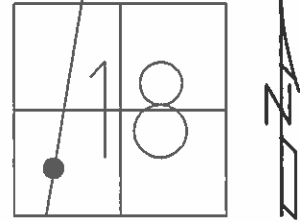

RECORD:
 SET P.K.NAIL
 6-06-91
 SET MAG/WASHER
 11/13/07, SAH

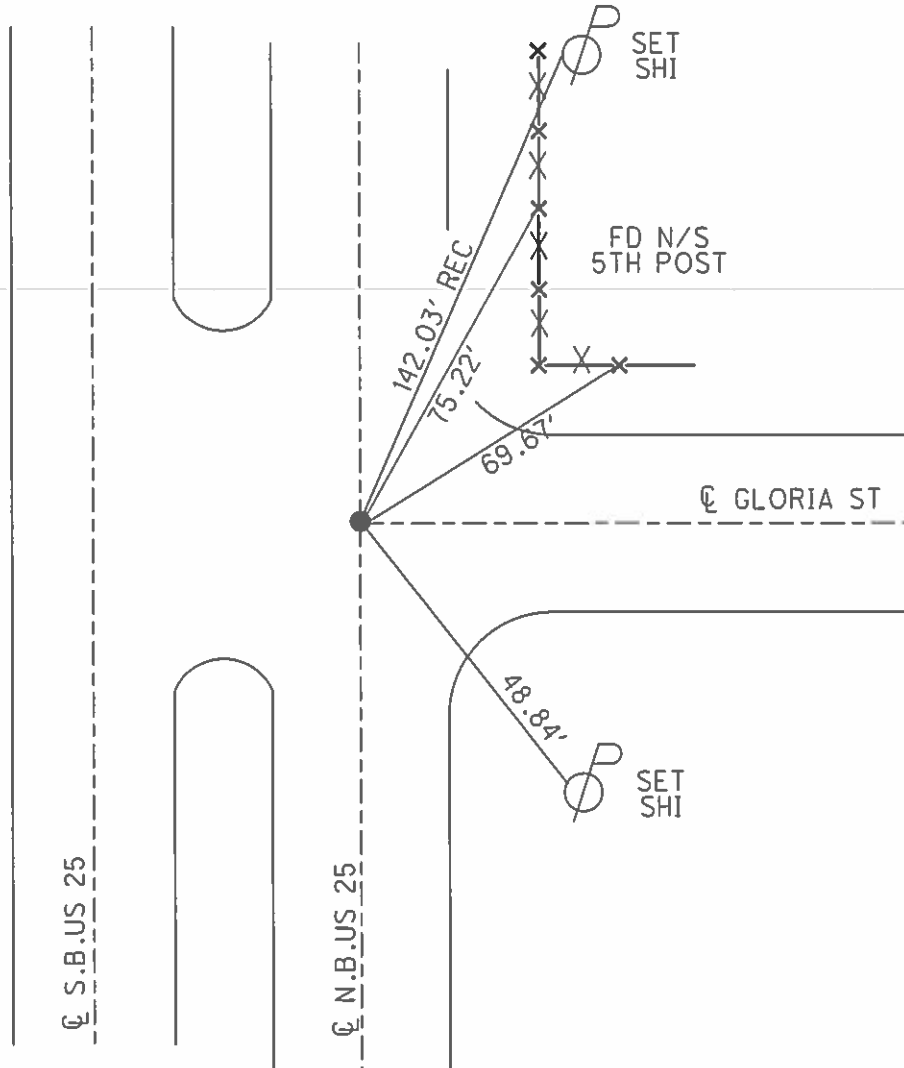

O.D.O.T. DISTRICT 2 SURVEY OFFICE

PERSONNEL

REFERENCE NO. 50-E

SHEET 15 OF 29

NOTES 1. Stone

H.C. D. Curtis

R.C. J. Householder

DATE 11 April 90

WEATHER Cool

TEMP. 44

ROUTE SR #25

COUNTY Wood

TOWNSHIP Perrysburg

SECTION 18

T ___ R ___


TYPE MONUMENT PK Nail

ON SURFACE - BELOW Surface

LEFT - @ PAV'T. - RIGHT

___ TO ___ EDGE PAVEMENT

S.L.M. 1074+49

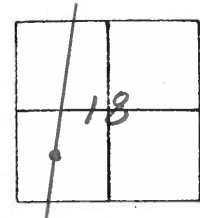

SET P.K. NAIL TO SURFACE
6-6-91
NHC




S.B.L.

MEDIAN

50D

N.B.L.

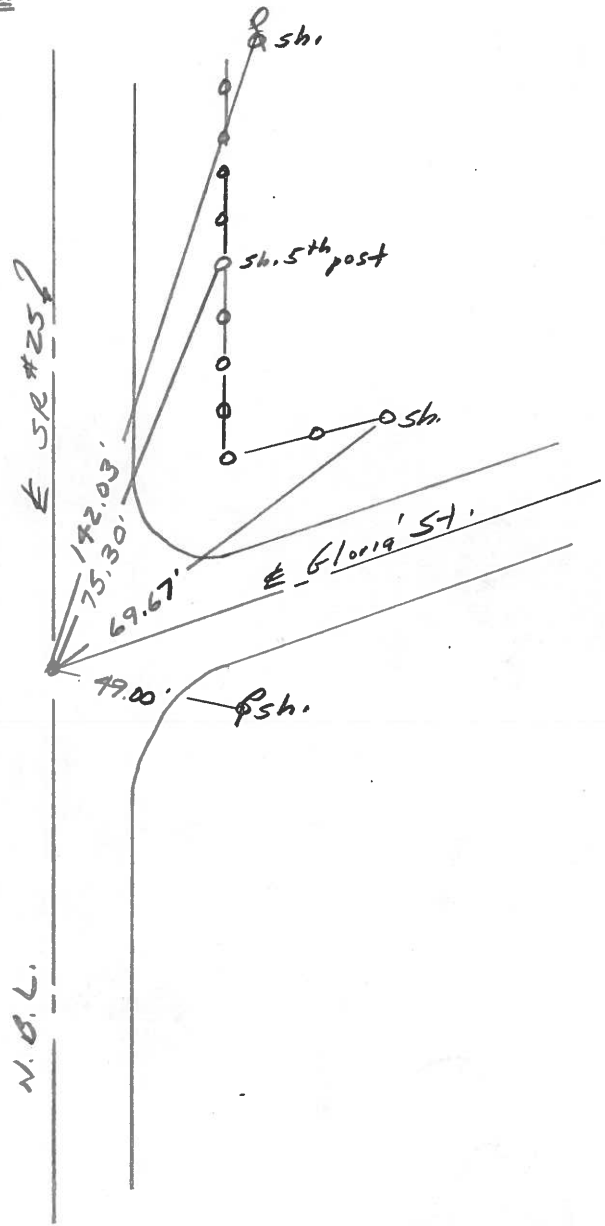

County Wood S.R. 25

Township Perrysburg

Section 18

TZN, RLE

Personnel Hoffman

Householder


Loehrke

Date 11-20-81

Weather RAIN - SNOW

Temp. + 35°

50-E

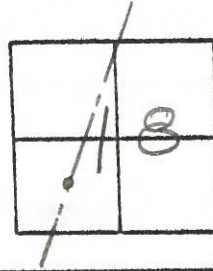

Fd. 2 small Nails @ surface
@ & PAUT N.B.L. S.R. 25

Project Sta ± 1074 + 86
TO PT. "A"

(Set by others)

SET P.K. NAIL @ POINT
"B" ONLY 8-5-83 S.W.H.

