

O.D.O.T. DISTRICT 2 SURVEY OFFICE (USE ONLY)

PERSONNEL _____

REFERENCE NO. 50 F

SHEET 10 OF 13

NOTES STONE DATE 4/11/91
 H.C. CURTIS WEATHER COOL
 R.C. HOUSEHOLDER TEMP. 45°

ROUTE SR 25
 COUNTY WOOD
 TOWNSHIP PERRYSBURG
 SECTION 18
 T 6 N R 11 E

DWG BY RHOADES PID 102808

TYPE MONUMENT P.K.NAIL


ON SURFACE - ~~BELOW~~ ON _____

OFFSET \varnothing PAVEMENT ON LT : RT
 - TO - EDGE PAVEMENT


STATION: 1076+99

HORZ.DATUM: _____ GEOID: _____

GRID: NORTHING: _____ EASTING: _____

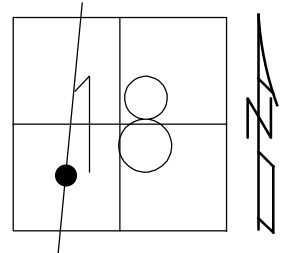

RECORD:
 FD P.K.NAIL
 4/11/91, IRS
 SET P.K.NAIL
 6/6/91, DJC
 D.N.F.
 NO TIES
 3/26/18, JFO

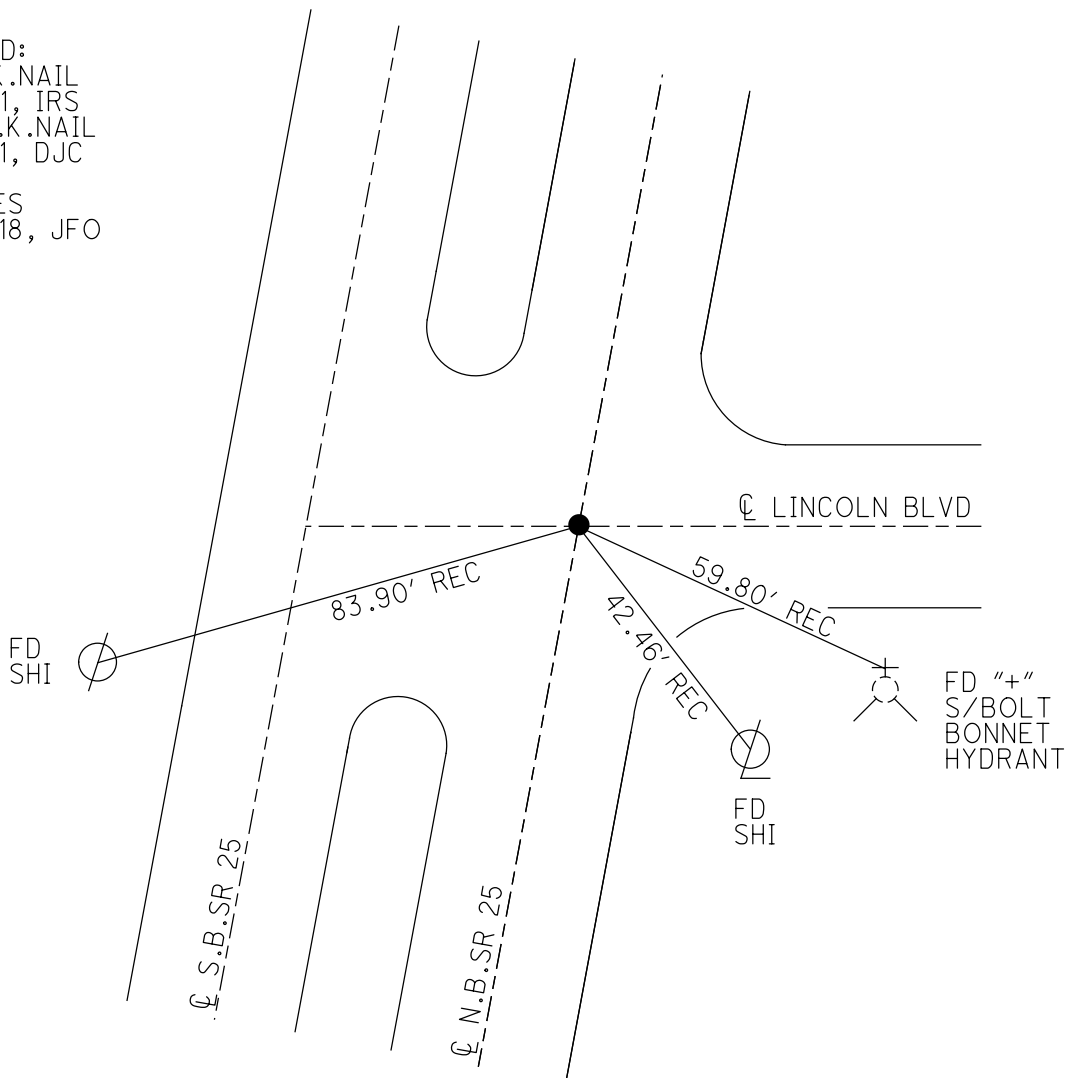

O.D.O.T. DISTRICT 2 SURVEY OFFICE

PERSONNEL

REFERENCE NO. 50-F

SHEET 16 OF 29

NOTES L. Stone

H.C. D. Curtis

R.C. J. Householder

DATE 11 April 91

WEATHER Cool

TEMP. 45°

ROUTE SR # 25

COUNTY Wood

TOWNSHIP Perryopolis

SECTION 18

T. R.


TYPE MONUMENT PK Nail

ON SURFACE - BELOW Surface


LEFT - & PAV'T. - RIGHT

 TO EDGE PAVEMENT

S.L.M. 1076+99

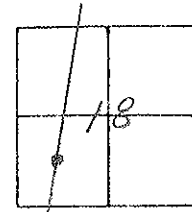

SET P.K. NAIL TO SURFACE
6-6-91
WJC

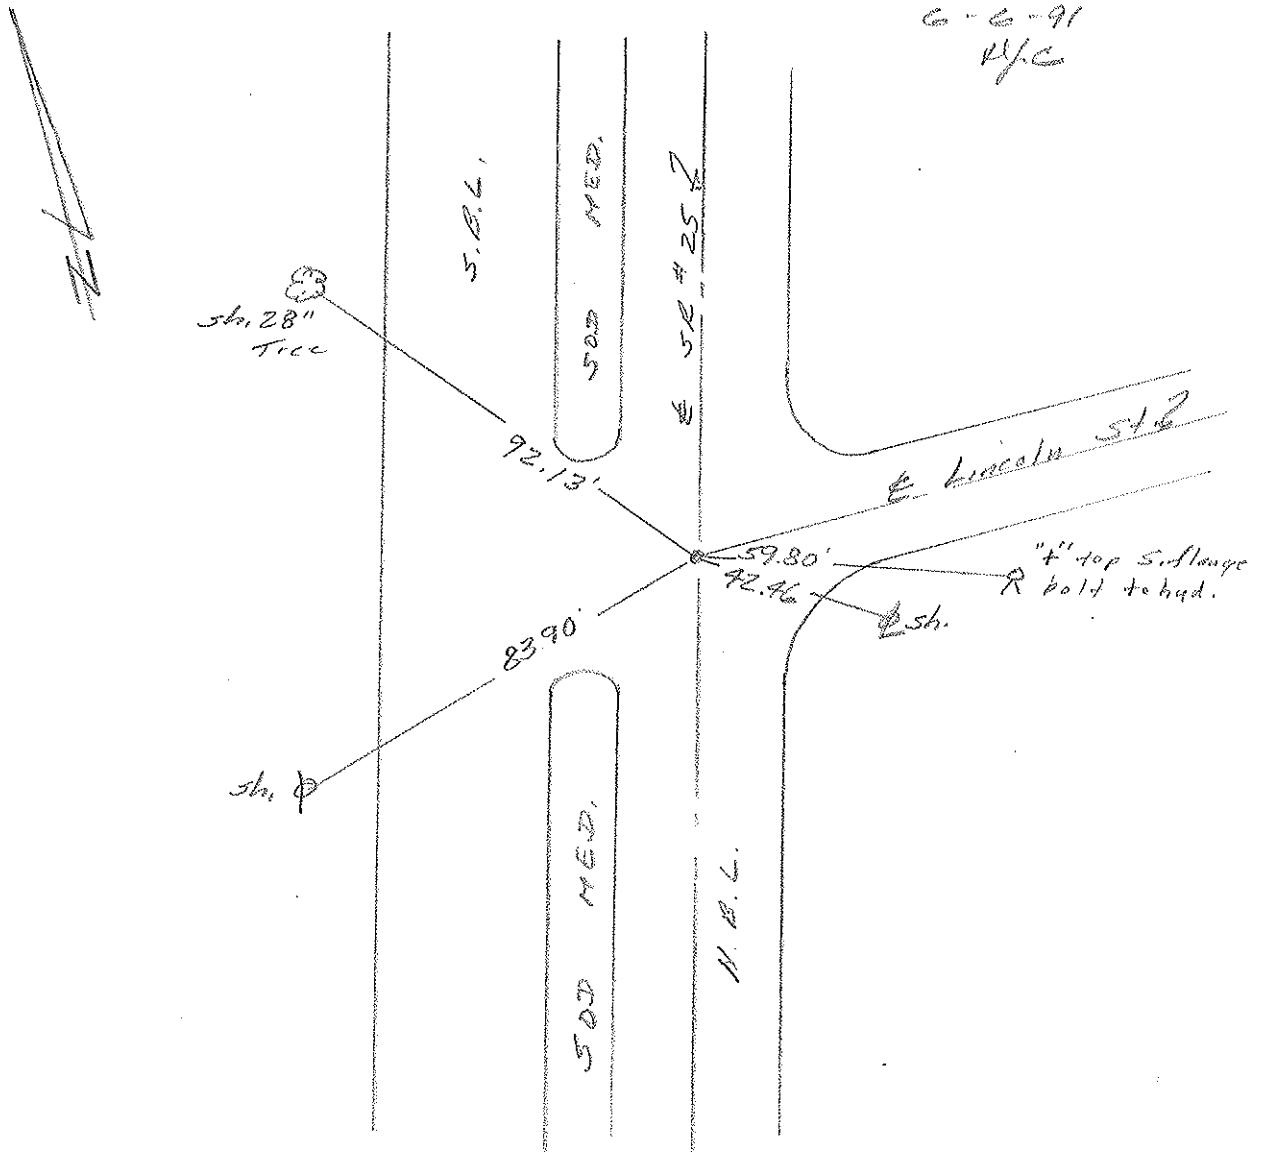

County Wood S.R. 25

Township Perrysburg

Section 18

TZN, R11E

Personnel HOFFMAN

Householder


Loehrke

Date 11-20-81

Weather Rain - Snow

Temp. +35°

50-F

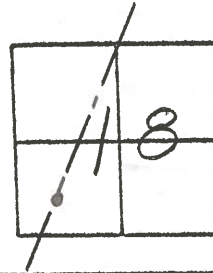

Fd. P.K. @ surface
0.20 E. of Φ PAUT S.R. 25
1.50 S. of Φ PAUT LINCOLN
(Set by others)

Project sta. \pm 1077+36

SET P.K. NAIL
8-5-83 S.W.H.

