

O.D.O.T. DISTRICT 2 SURVEY OFFICE (USE ONLY)

PERSONNEL

REFERENCE NO. 51 A

SHEET 13 OF 13

NOTES STONE

DATE 4/11/91

ROUTE SR 25

H.C. CURTIS

WEATHER COOL

COUNTY WOOD

R.C. HOUSEHOLDER

TEMP. 48°

TOWNSHIP PERRYSBURG

DWG BY RHOADES

PID 102808

SECTION 18

T 6 N R 11 E

TYPE MONUMENT P.K.NAIL

ON SURFACE - BELOW ON

OFFSET \varnothing PAVEMENT ON LT : RT

- TO - EDGE PAVEMENT


STATION: 1087+88

HORZ.DATUM: _____


GEOID: _____

GRID: NORTHING: _____

EASTING: _____

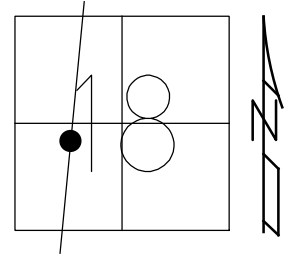

RECORD:
FD P.K.NAIL
4/11/91, IRS
SET P.K.NAIL
6/6/91, DJC
D.N.F.
3/26/18, JFO

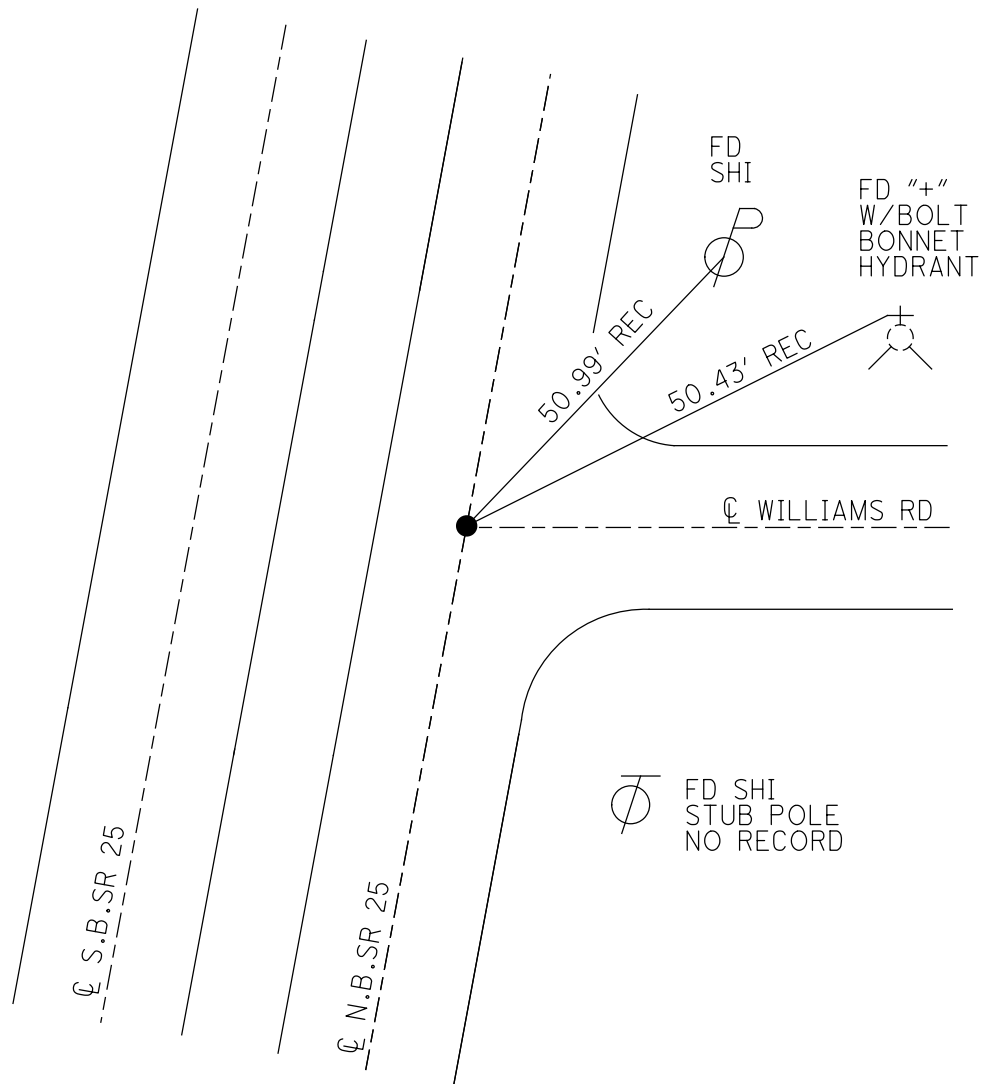

O.D.O.T. DISTRICT 2 SURVEY OFFICE

PERSONNEL

REFERENCE NO. 51-A

SHEET 19 OF 29

NOTES 1. Stone

H.C. D. Curtis

R.C. J. Householder

DATE 11 April 91

WEATHER Cool

TEMP. 48°

ROUTE SR #25

COUNTY Wood

TOWNSHIP Perryburg

SECTION 18

T ___ R ___


TYPE MONUMENT PK Nail

ON SURFACE - BELOW Surface

LEFT - C PAV'T. - RIGHT

TO ___ EDGE PAVEMENT

S.L.M. 1087+88

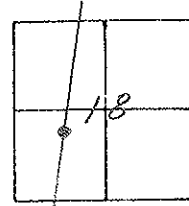


SET P.K. NAIL TO SURFACE
6-6-91
D/C



S.B.L.

500 MER.

#25

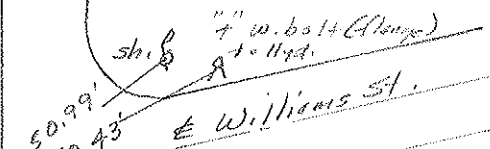

500 MER.

SR

S.B.L.

ODOT. DISTRICT 2 SURVEY OFFICE

SHEET _____ OF _____

County Wood S.R. 25

Township Perrysburg

Section 18

TZN, RILE


Personnel Hoffman
Householder
Loehrke

Date 11-20-81

Weather Rain - Snow

Temp. +35°

51-A

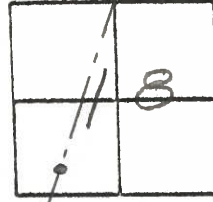

Fd. P.K. @ Surface

Project STA ± 1088+22

@ & Williams
3,65' E. of & PAUT N.B.L. S.R. 25
(set by others)

SET P.K. NAIL
8-5-83 S.W.H.

