

O.D.O.T. DISTRICT 2 SURVEY OFFICE (USE ONLY)

PERSONNEL _____

REFERENCE NO. 51 C

SHEET 2 OF 13

NOTES STONE DATE 4/11/91
 H.C. CURTIS WEATHER COOL
 R.C. HOUSEHOLDER TEMP. 49°

ROUTE SR 25
 COUNTY WOOD
 TOWNSHIP 12 MILE RESERVE
 SECTION 18
 T 4 US R E

DWG BY NIESE PID _____

TYPE MONUMENT P.K. NAIL

ON SURFACE - ~~BELOW~~ ON


OFFSET ☉ PAVEMENT _____ LT : RT

- TO - EDGE PAVEMENT


STATION: 1115+97

HORZ. DATUM: _____ GEOID: _____

GRID: NORTHING: _____ EASTING: _____

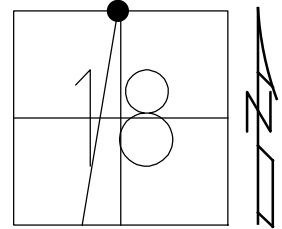

RECORD:
 FD P.K. NAIL
 4/11/91, DFC
 SET P.K. NAIL
 6/6/91, DFC

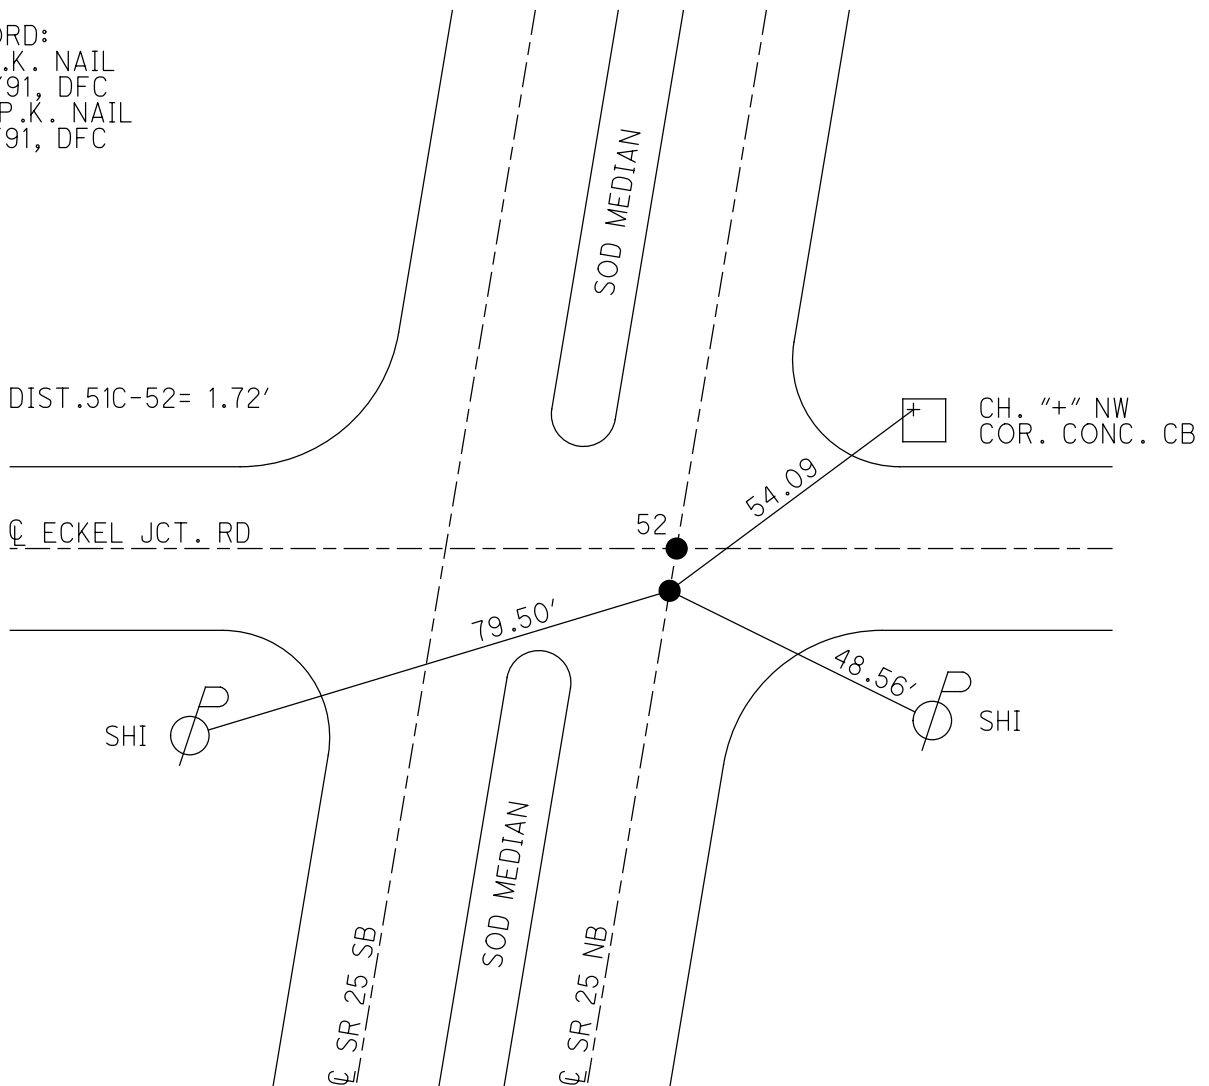

O.D.O.T. DISTRICT 2 SURVEY OFFICE

PERSONNEL _____

REFERENCE NO. 52

SHEET 21 OF 29

NOTES 1. Stone

H.C. D. Curtis

R.C. J. Householder

DATE 11 April 91

WEATHER Cool

TEMP. 49°

ROUTE SR #25

COUNTY Wood

TOWNSHIP Perryburg

SECTION 18

T. _____ R. _____


TYPE MONUMENT PK Nail

ON SURFACE - BELOW Surface


LEFT- & PAV'T. - RIGHT _____

TO _____ EDGE PAVEMENT

S.L.M. 1115497 & 499

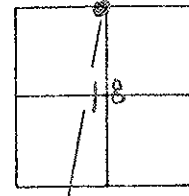

SET P.K. NAILS TO SURFACE
6-6-91
WJC

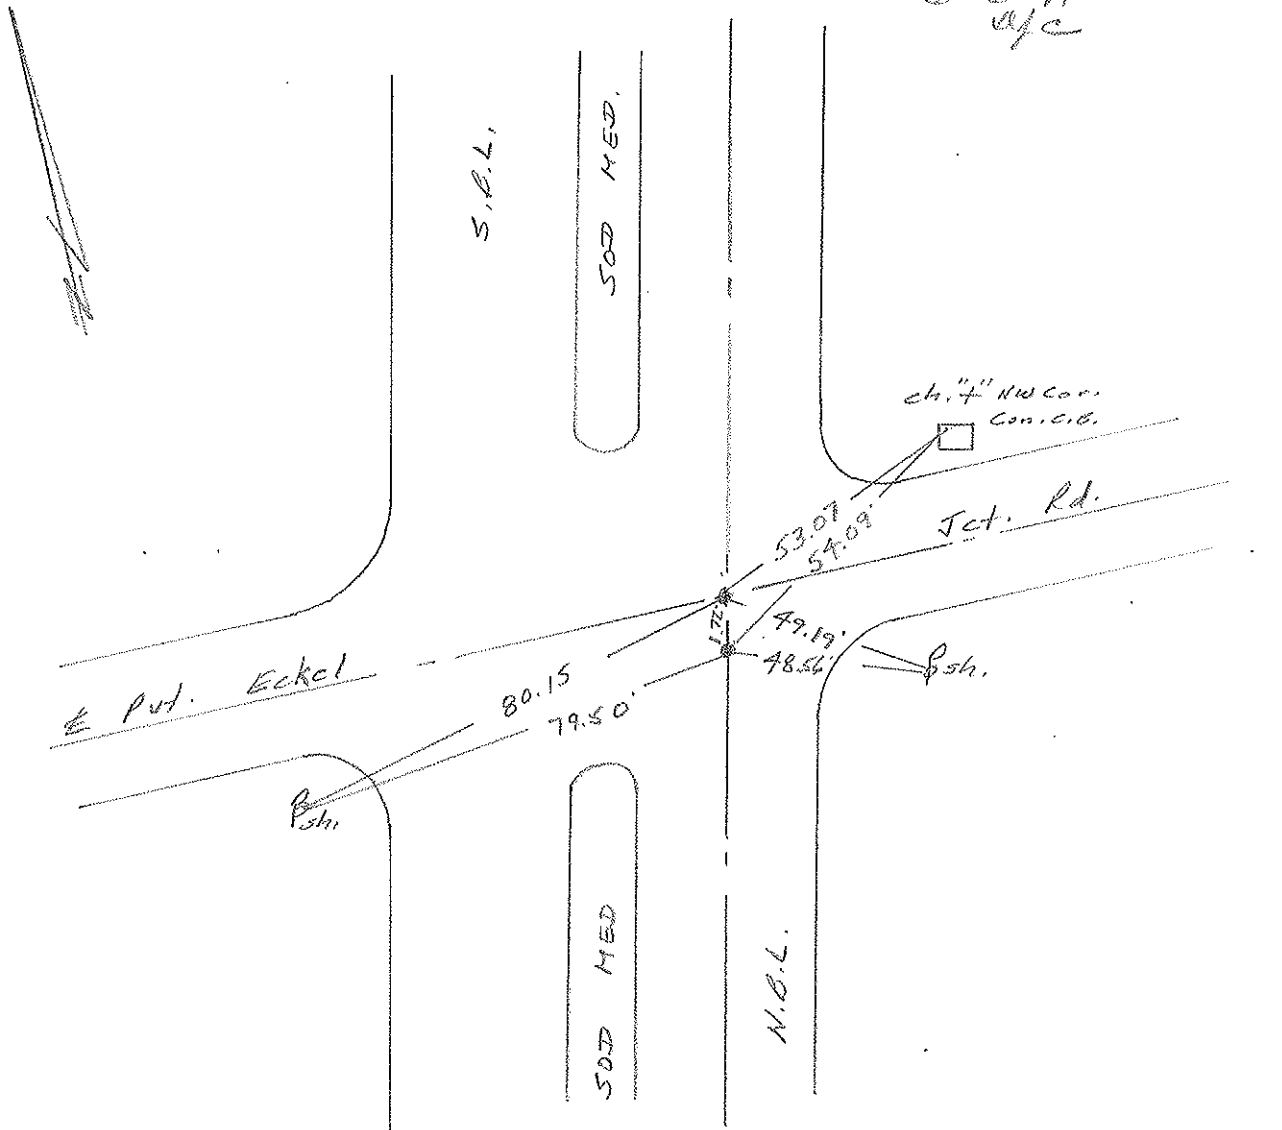

OD.O.T. DISTRICT 2 SURVEY OFFICE

SHEET _____ OF _____

County Wood S.R. 25

Date 11-20-81

Township Perrysburg

Weather cloudy

Section 18

Temp. +35°


TIN, RILE

Personnel HOFFMAN

Householder

Loehrke

52

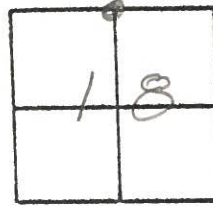


Fd. P.K. @ SURFACE (OVER road?)
0.80 W. of & N.B.L. SR.25
7.0' S. of & PAUT ECKEL Jct. rd.

Project STA ± 1116 + 36

FD. P.K. NAIL @ SURFACE
8-5-83 S.W.H.

Sta. 554 + 08.48

Δ = 0° - 04' Lt. Rec.

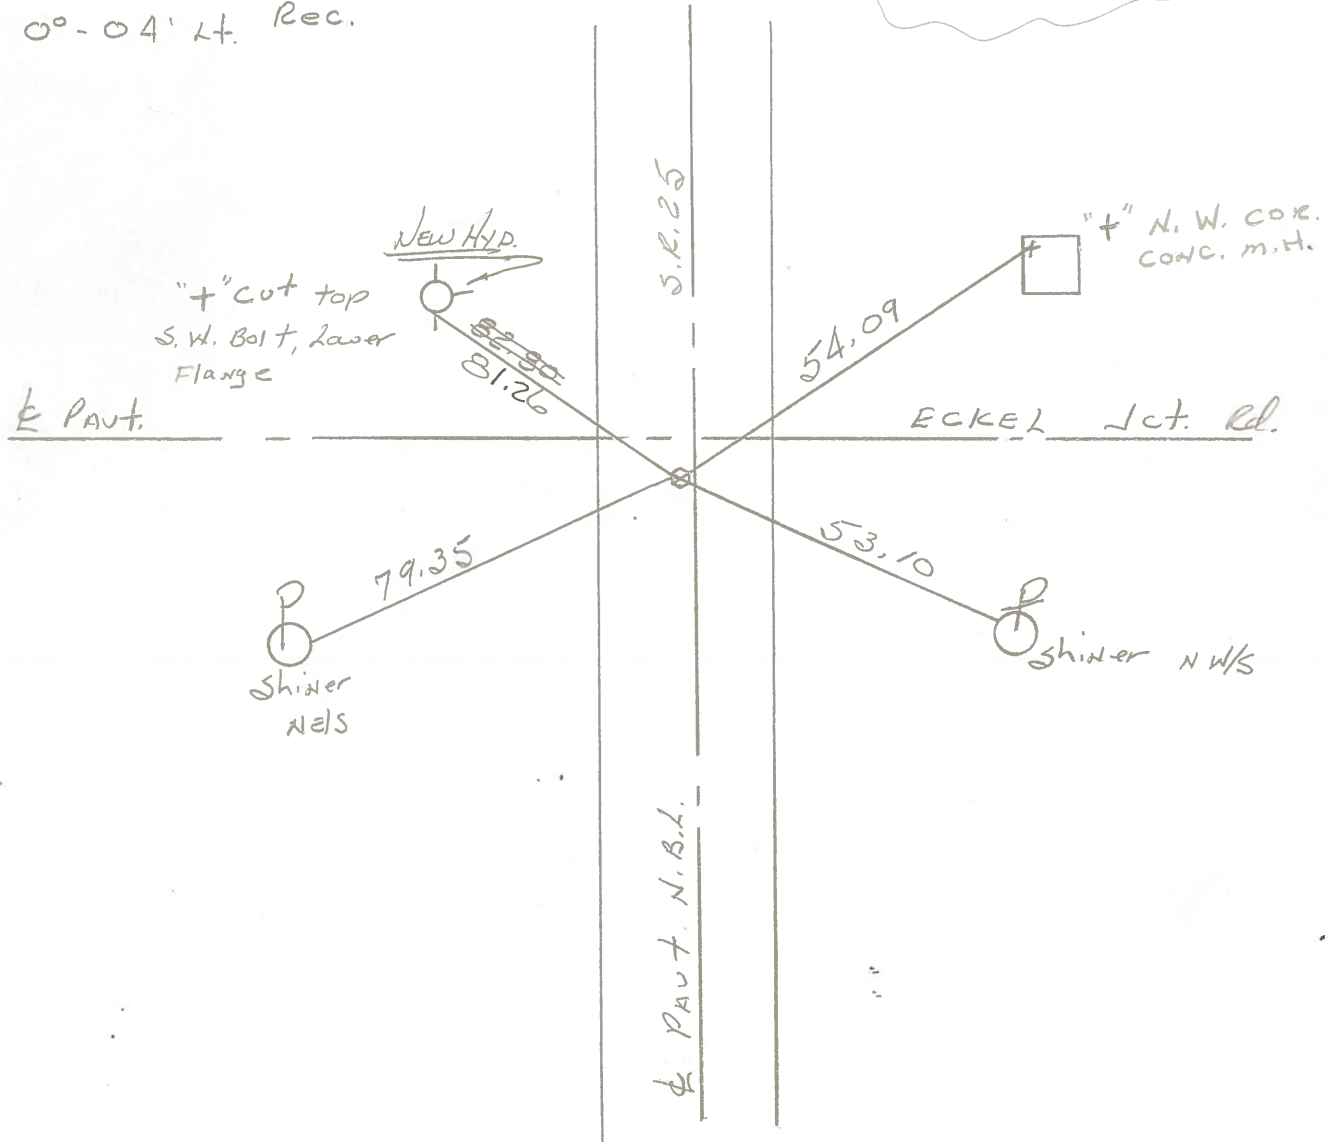

PERSONNEL TITLE PERSONNEL TITLE

COUNTY Wood DATE 3-28-60

S. R. 11.S. #25 WEATHER

SEC. TEMP.

DESCRIPTION Mobora Mon. JOB NO.

LEFT CENTER LINE RIGHT

Sta. 554+08.48

$\Delta = 0^\circ - 04' Lt$

Set new mon

Eckel Jct. Rd.

#282

52

E to "X" on Ring of Bells system M.H. 14.44

S.S.W. to X-on S.E. Cor. top #26 GB. 31.78'

S.E. to shiner in P.P. 27.43'

W.N.W. to shiner in T.P. 68.10'

N.E. To 3" Gas pipe 1' above Gr. 66.45'

N.N.E. to shiner P. Pole 103.64'

Sta. 573+04.06

$\Delta = 0^\circ - 28' Lt$

Set mon.

#283

53

E.S.E. to X-on top Grand Stone Hdwl 73.3'

S.S.E. to shiner in N. Sign upright 77.45'

N.E. to shiner in P.P. 48.68'

S.S.E. to shiner in P. Pole 51.07'

S.E. to "X" on top Hdwl (Center) 61.30'

N.E. to Bolt in Conc. P/L Marker 72.19'

Sta. 581+29.07

$\Delta = ?$

Iron pin

(Did Not Find)
3/28/60

#284

S.E. to X N.W. side well curb 56.76'

N.E. to shiner in 28" Locust 38.89'

N.N.E. to shiner in 24" Hackberry 60.41'

Sta. 581+34.42

$\Delta = 34^\circ - 20' Lt?$

Set mon.

#285

54

~~S.E. to X N.W. side well curb 58.95'~~

~~N.E. to shiner in 28" Locust 35.00'~~

~~N.N.E. to shiner in 24" Hackberry 56.00'~~

S.E. to shiner 14" Maple 44.68'

N.N.E. to shiner 24" Maple 76.10'

N.E. to shiner in 24" Hackberry 55.94'