

O.D.O.T. DISTRICT 2 SURVEY OFFICE (USE ONLY)

PERSONNEL \_\_\_\_\_

REFERENCE NO. 52

SHEET 3 OF 13

NOTES STONE DATE 4/11/91

H.C. CURTIS WEATHER COOL

R.C. HOUSEHOLDER TEMP. 49°

ROUTE SR 25

COUNTY WOOD

TOWNSHIP 12 MILE RESERVE

SECTION 18

T 4 US R E

DWG BY NIESE PID \_\_\_\_\_

TYPE MONUMENT P.K. NAIL

ON SURFACE - ~~BELOW~~ ON


OFFSET Q PAVEMENT \_\_\_\_\_ LT : RT

- TO - EDGE PAVEMENT


STATION: 1115+99

HORZ. DATUM: \_\_\_\_\_ GEOID: \_\_\_\_\_

GRID: NORTHING: \_\_\_\_\_ EASTING: \_\_\_\_\_

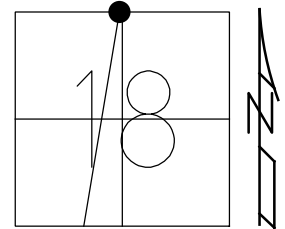

RECORD:  
FD P.K. NAIL  
4/11/91, DFC  
SET P.K. NAIL  
6/6/91, DFC

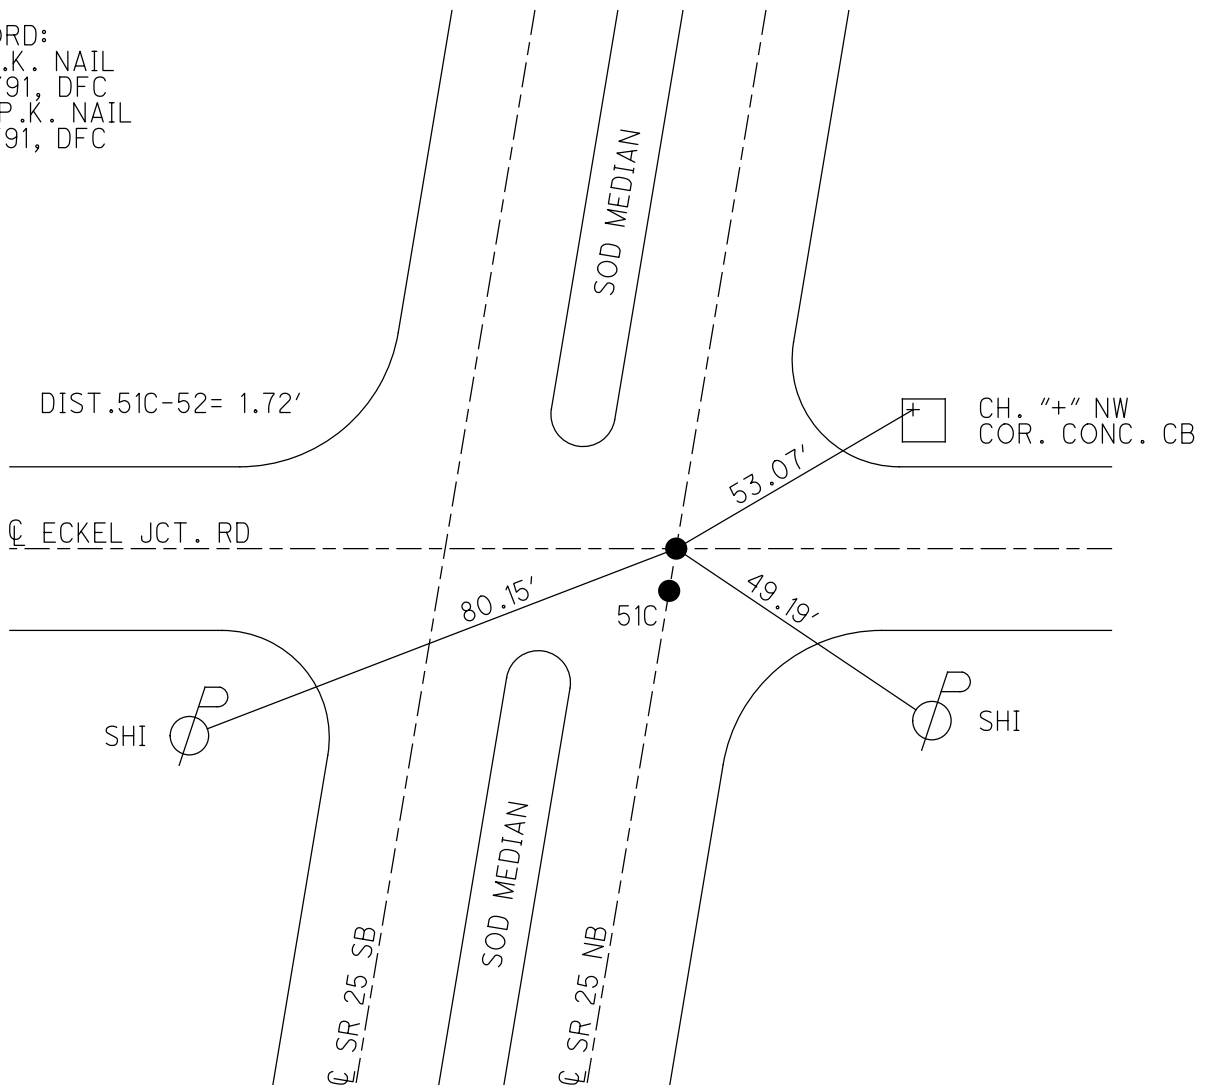

# O.D.O.T. DISTRICT 2 SURVEY OFFICE

PERSONNEL \_\_\_\_\_

REFERENCE NO. 52

SHEET 21 OF 29

NOTES 1. Stone

H.C. D. Curtis

R.C. J. Householder

DATE 11 April 91

WEATHER Cool

TEMP. 49°

ROUTE SR #25

COUNTY Wood

TOWNSHIP Perryburg

SECTION 18

T. \_\_\_\_\_ R. \_\_\_\_\_


TYPE MONUMENT PK Nail

ON SURFACE - BELOW Surface


LEFT- & PAV'T. - RIGHT \_\_\_\_\_

TO \_\_\_\_\_ EDGE PAVEMENT

S.L.M. 1115197 & 499

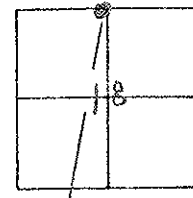

SET P.K. NAILS TO SURFACE  
6-6-91  
WJC

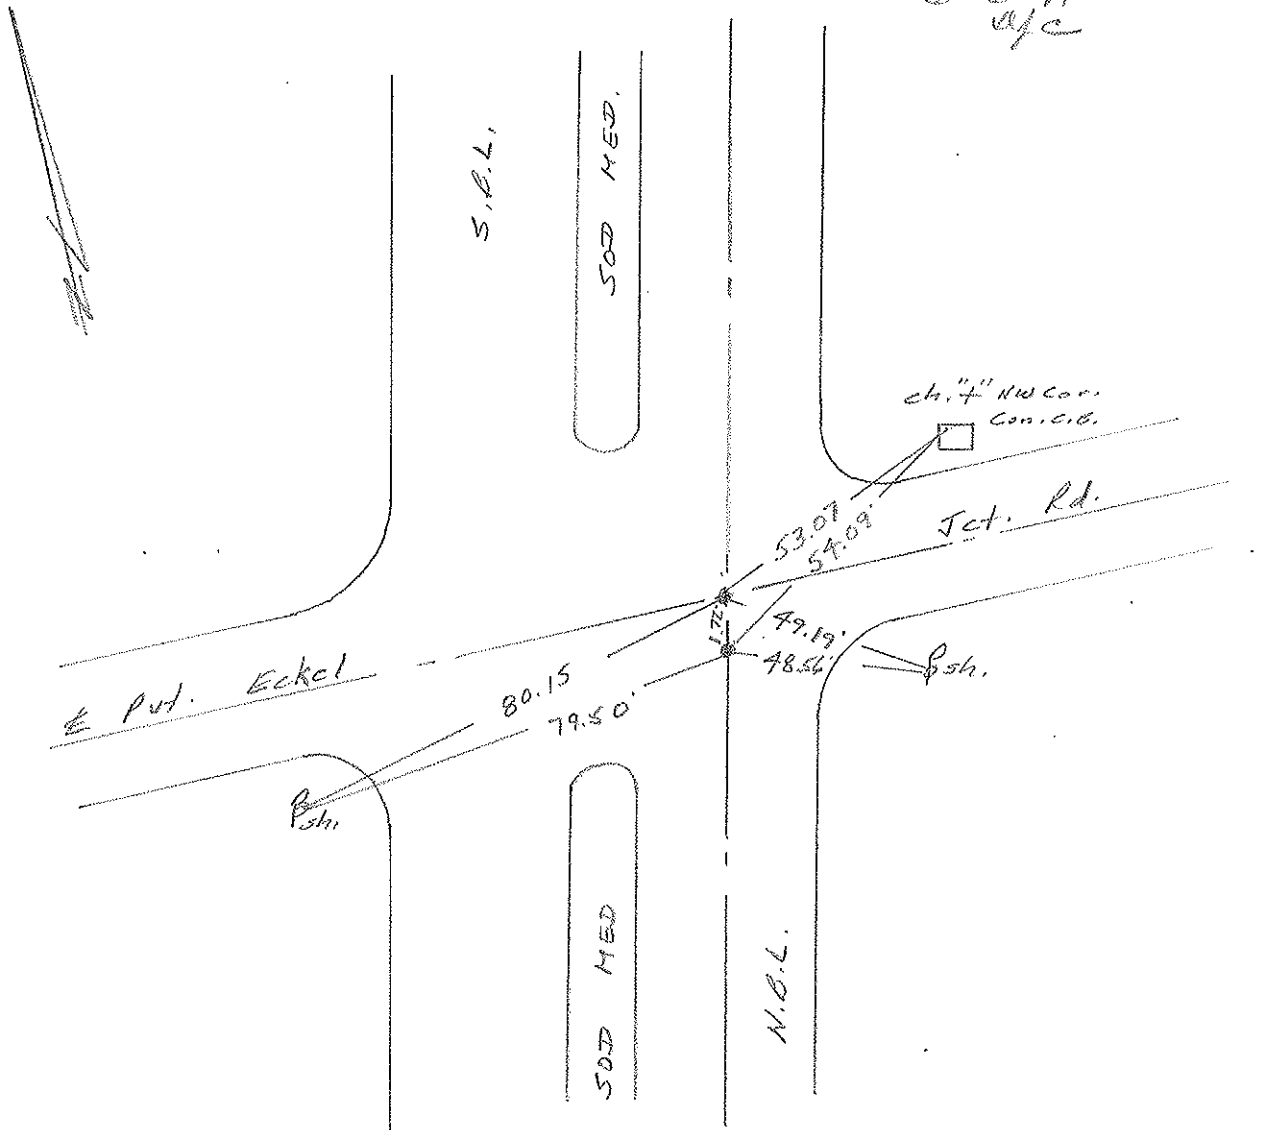

OD.O.T. DISTRICT 2 SURVEY OFFICE

SHEET \_\_\_\_\_ OF \_\_\_\_\_

County Wood S.R. 25

Date 11-20-81

Township Perrysburg

Weather cloudy

Section 18

Temp. +35°


TIN, RILE

Personnel HOFFMAN

Householder

Loehrke

# 52

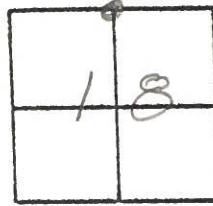


Fd. P.K. @ SURFACE (OVER road?)  
0.80 W. of & N.B.L. SR.25  
7.0' S. of & PAUT ECKEL Jct. rd.

Project STA ± 1116 + 36

FD. P.K. NAIL @ SURFACE  
8-5-83 S.W.H.

Sta. 554 + 08.48  
Δ = 0° - 04' Lt. Rec.

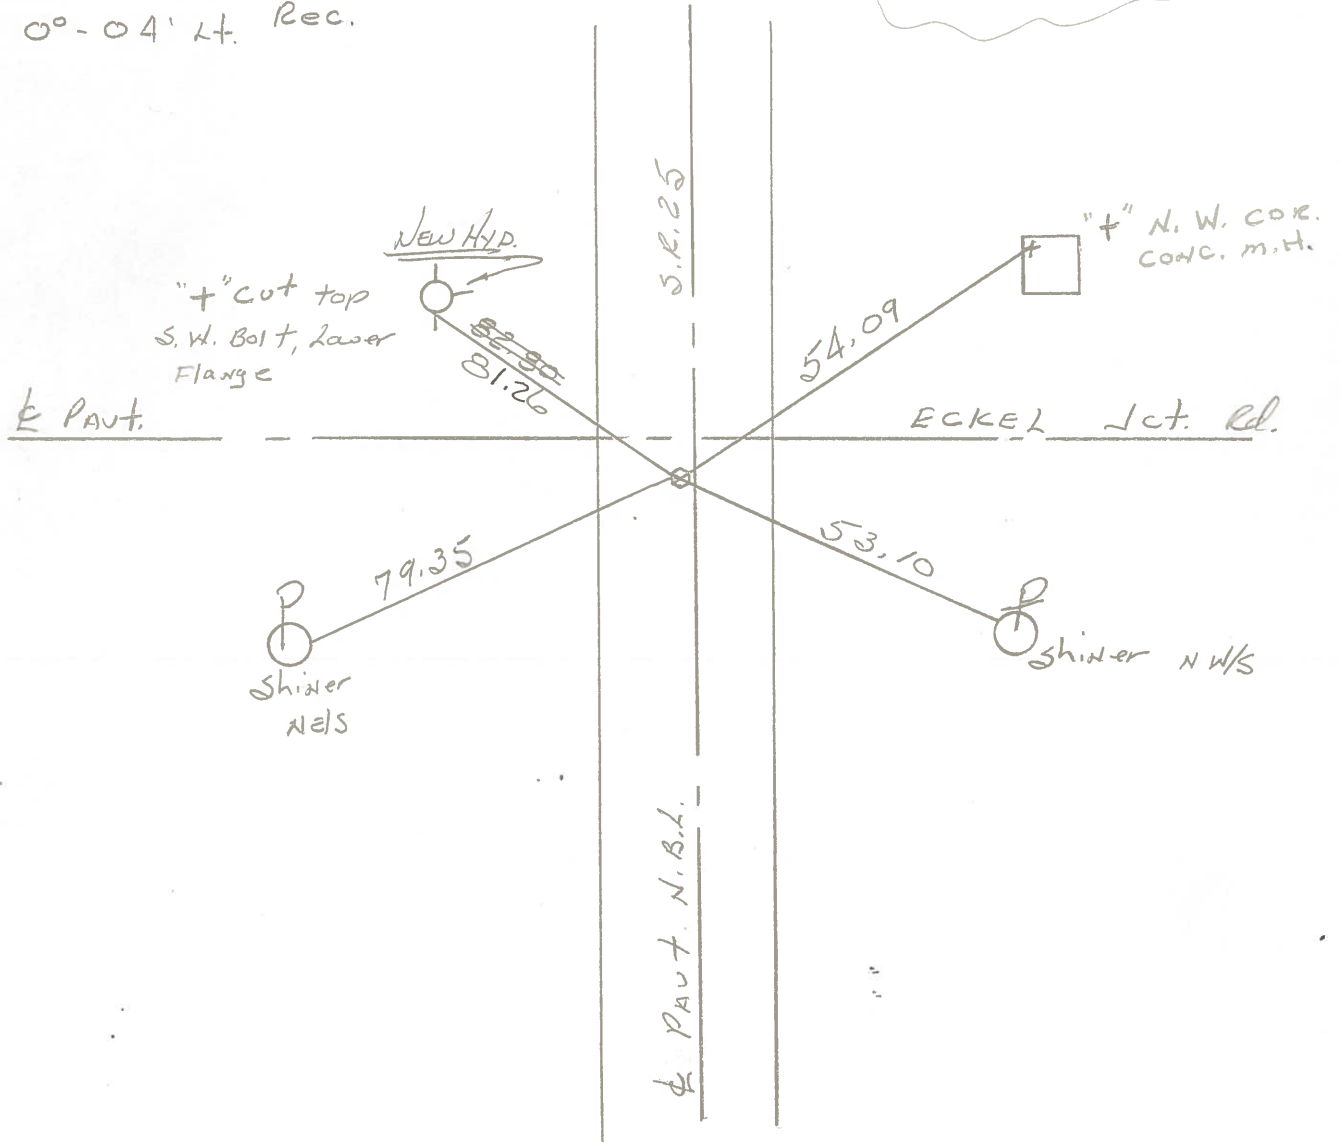

PERSONNEL TITLE PERSONNEL TITLE

COUNTY Wood DATE 3-28-60

S. R. 11.S. #25 WEATHER

SEC. TEMP.

DESCRIPTION Mobora Mon. JOB NO.

LEFT CENTER LINE RIGHT

Sta. 554+08.48

$\Delta = 0^\circ - 04' Lt$

Set new mon

Eckel Jct. Rd.

52

#282

E to "X" on Ring of Bells system M.H. 14.44'  
 S.S.W. to X-on S.E. Cor. top #26 GB. 31.78'  
 S.E. to shiner in P.P. 27.43'  
 W.N.W. to shiner in T.P. 68.10'  
 N.E. To 3" Gas pipe 1' above Gr. 66.45'  
 N.N.E. to shiner P. Pole 103.64'

Sta. 573+04.06

$\Delta = 0^\circ - 28' Lt$

Set mon.

53

#283

E.S.E. to X-on top Grand Stone Hdwl 73.3'  
 S.S.E. to shiner in N. Sign upright 77.45'  
 N.E. to shiner in P.P. 48.68'  
 S.S.E. to shiner in P. Pole 51.07'  
 S.E. to "X" on top Hdwl (Center) 61.30'  
 N.E. to Bolt in Conc. P/L Marker 72.19'

Sta. 581+29.07

$\Delta = ?$

Iron pin

(Did Not Find)  
 3/28/60

#284

S.E. to X N.W. side well curb 56.76'  
 N.E. to shiner in 28" Locust 38.89'  
 N.N.E. to shiner in 24" Hackberry 60.41'

Sta. 581+34.42

$\Delta = 34^\circ - 20' Lt?$

Set mon.

54

#285

~~S.E. to X N.W. side well curb 58.95'~~  
~~N.E. to shiner in 28" Locust 35.00'~~  
~~N.N.E. to shiner in 24" Hackberry 56.00'~~  
 S.E. to shiner 14" Maple 44.68'  
 N.N.E. to shiner 24" Maple 76.10'  
 N.E. to shiner in 24" Hackberry 55.94'