

O.D.O.T. DISTRICT 2 SURVEY OFFICE (USE ONLY)

PERSONNEL _____

REFERENCE NO. 52 A

SHEET 4 OF 13

NOTES STONE

DATE 4/22/91

ROUTE SR 25

H.C. CURTIS

WEATHER CLOUDY

COUNTY WOOD

R.C. HOUSEHOLDER

TEMP. 44°

TOWNSHIP 12 MILE RESERVE

SECTION 7

DWG BY NIESE PID _____

T 4 US R E

TYPE MONUMENT P.K. NAIL

ON SURFACE - ~~BELOW~~ ON


OFFSET ϕ PAVEMENT _____ LT : RT

- TO - EDGE PAVEMENT


STATION: 1129+25

HORZ. DATUM: _____ GEOID: _____

GRID: NORTHING: _____ EASTING: _____

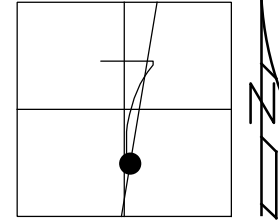

RECORD:
FD P.K. NAIL
4/11/91, DFC
SET P.K. NAIL
6/6/91, DFC

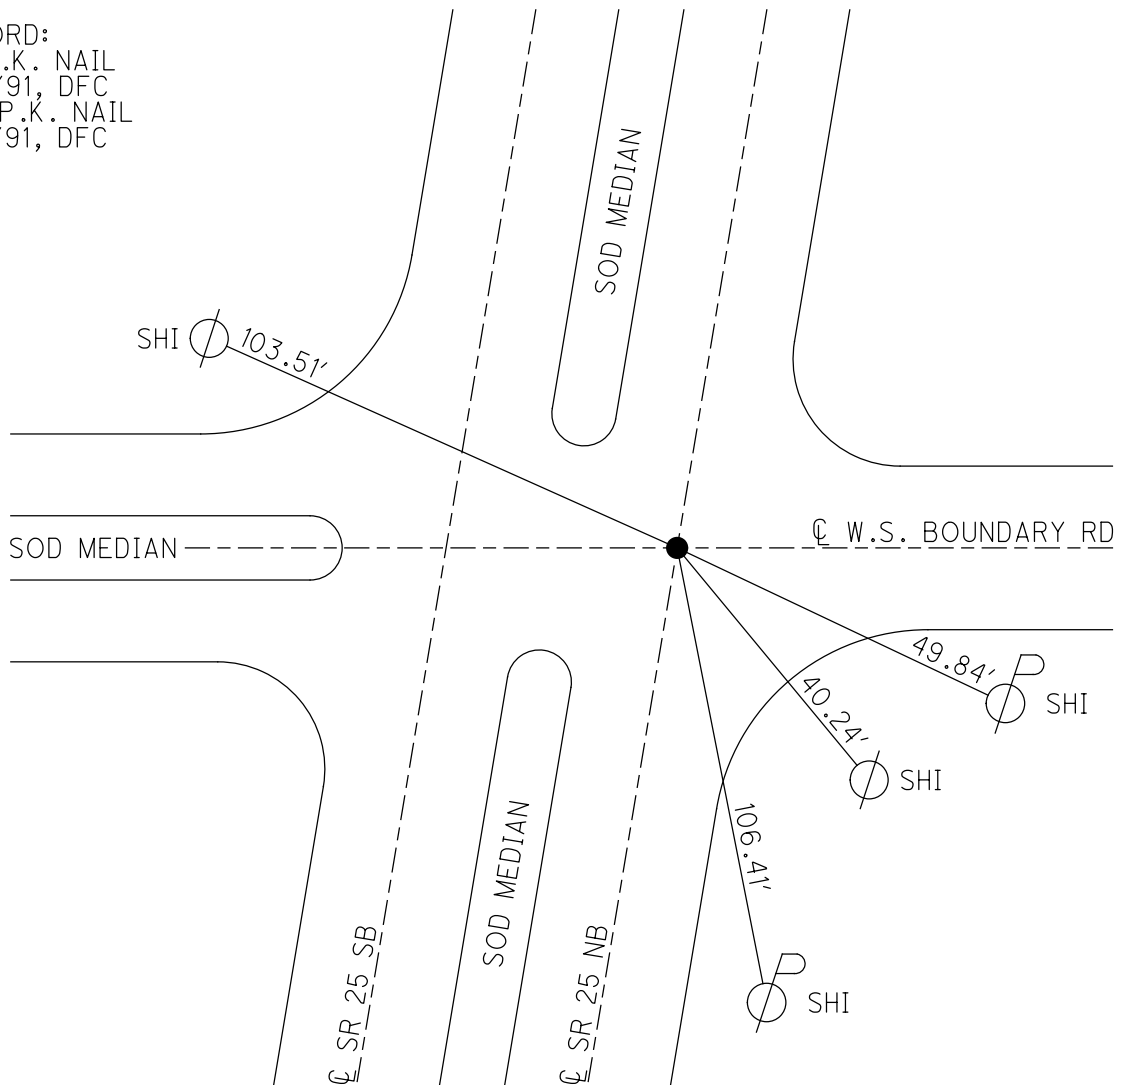

O.D.O.T. DISTRICT 2 SURVEY OFFICE

PERSONNEL

REFERENCE NO. 52-A

SHEET 22 OF 29

NOTES I. Stone

H.C. D. Curtis

R.C. J. Householder

DATE 22 April 91

WEATHER Cloudy

TEMP. 44.0

ROUTE SR# 25

COUNTY Wood

TOWNSHIP Perryburg

SECTION _____

T _____ R _____


TYPE MONUMENT PK Nail

ON SURFACE - BELOW Surface

LEFT - \odot PAV'T. - RIGHT _____

TO _____ EDGE PAVEMENT

S.L.M. 1129+25

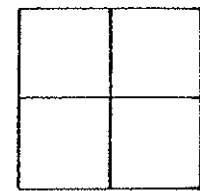

SET P.K. NAIL TO SURFACE
6-6-91
N/C

