


O.D.O.T. DISTRICT 2 SURVEY OFFICE (USE ONLY)


PERSONNEL _____ REFERENCE NO. 54 B SHEET 4 OF 6
 NOTES RHOADES DATE 4/9/14 ROUTE SR 25
 H.C. ROUSOS WEATHER CLEAR COUNTY WOOD
 R.C. HOMAN TEMP. 41° TOWNSHIP PERRYSBURG
GABLE SECTION 7
 T 4 N R 11 E

TYPE MONUMENT SM.R.R.SPIKE
 ON SURFACE - ~~BELOW~~ ON
 LEFT - ☉ PAV'T - RIGHT - _____
 - TO - EDGE PAVEMENT
 S.L.M. 1158+43.20

Grid: Northing: 687565.917 Easting: 1657383.378

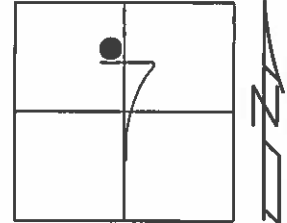

RECORD:
 FD SM.R.R.SPIKE
 4/22/91, I.S.
 SET SM.R.R.SPIKE
 6/6/91, DJC
 SET MAG/WASHER
 GPS, REFB54
 6/19/15, DCH

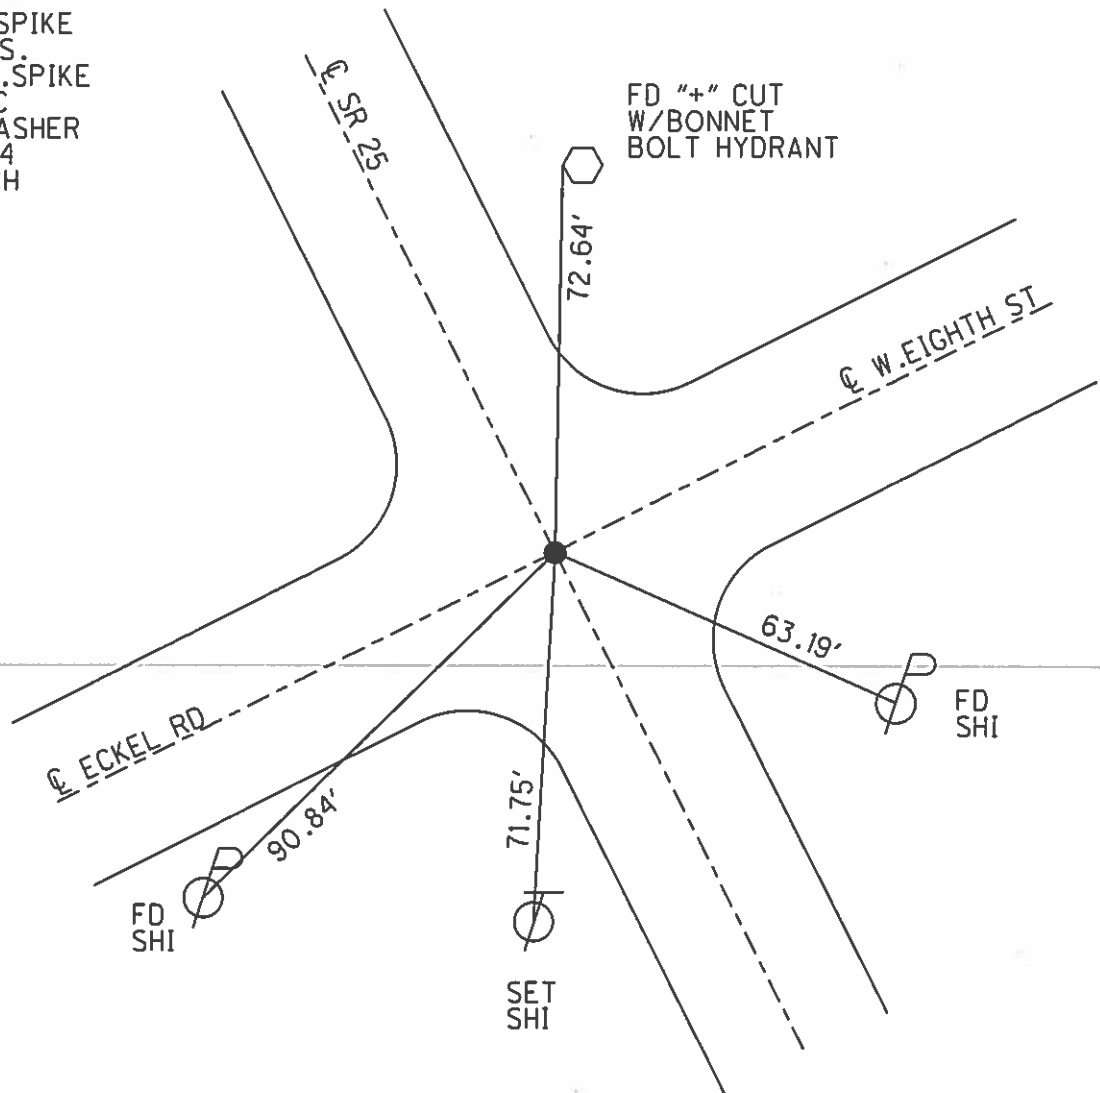

O.D.O.T. DISTRICT 2 SURVEY OFFICE

PERSONNEL _____

REFERENCE NO. 54-18

SHEET 25 OF 29

NOTES 1. Stone

H.C. D. Curtis

R.C. J. Housholder

DATE 22 April 91

WEATHER Cloudy

TEMP. 76°

ROUTE SR#25

COUNTY Wood

TOWNSHIP Pennsboro

SECTION _____

T. _____ R. _____


TYPE MONUMENT 5m RR Spk.

ON SURFACE - BELOW Surface


LEFT- & PAV'T. - RIGHT _____

TO _____ EDGE PAVEMENT

S.L.M. 1161+14

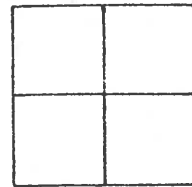


SET SM. R.R. SPK. TO SURFACE
6-6-91
DJC

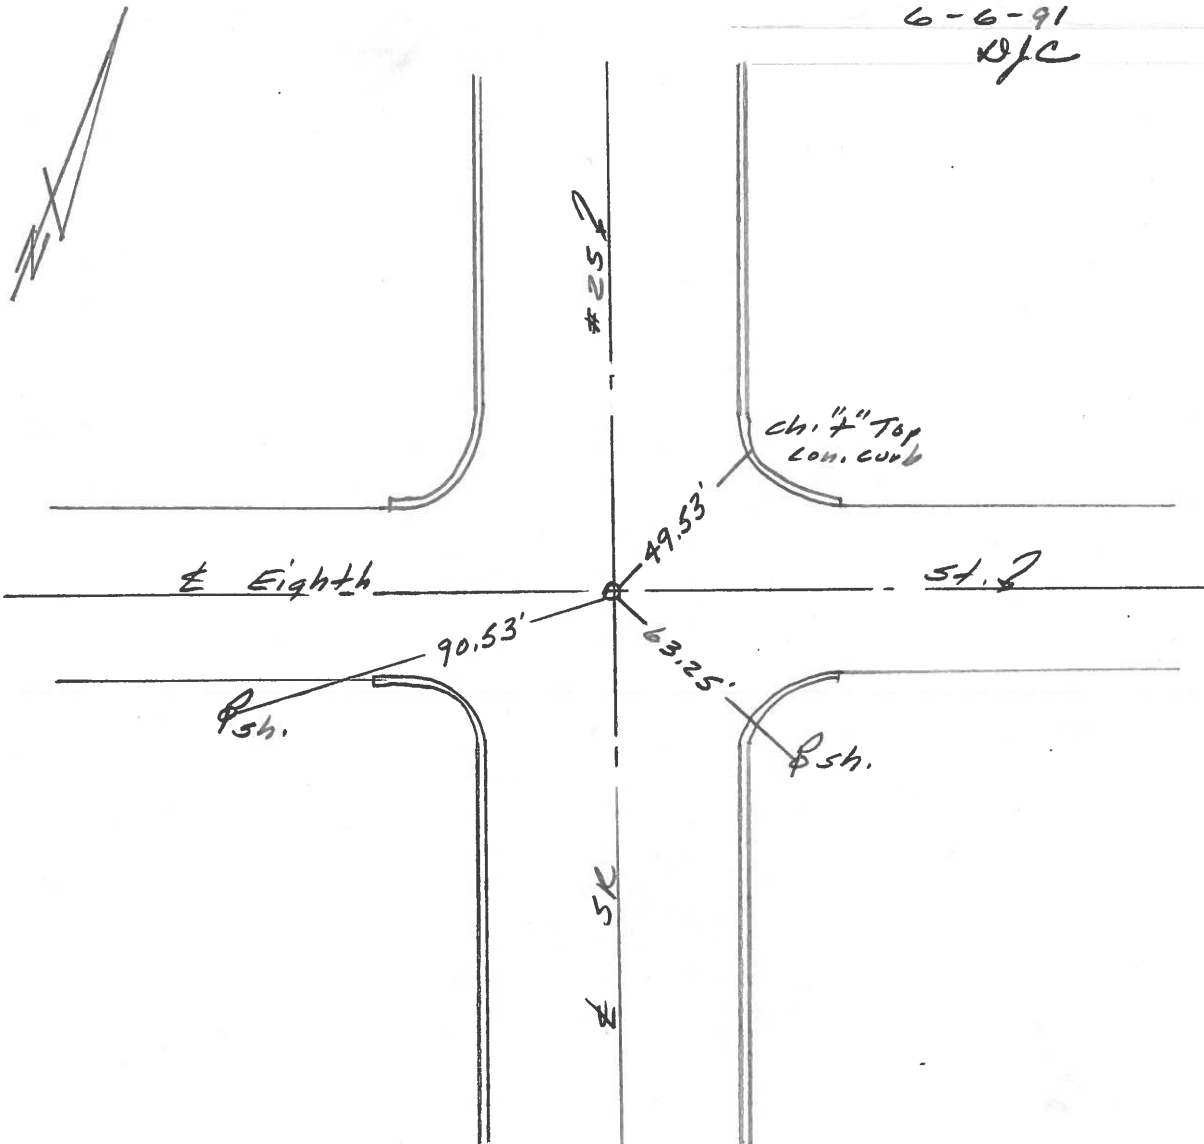

PERSONNEL	TITLE	PERSONNEL	TITLE
<u>Stone</u>			
<u>Michalek</u>			
<u>Denno</u>			
<u>Kurtis</u>			

COUNTY Wood DATE 9 April 73
 S. R. #25 WEATHER Cloudy
 SEC. Perryburg TEMP. 32°

DESCRIPTION References to Central Pointe JOB NO. _____
 LEFT CENTER LINE RIGHT

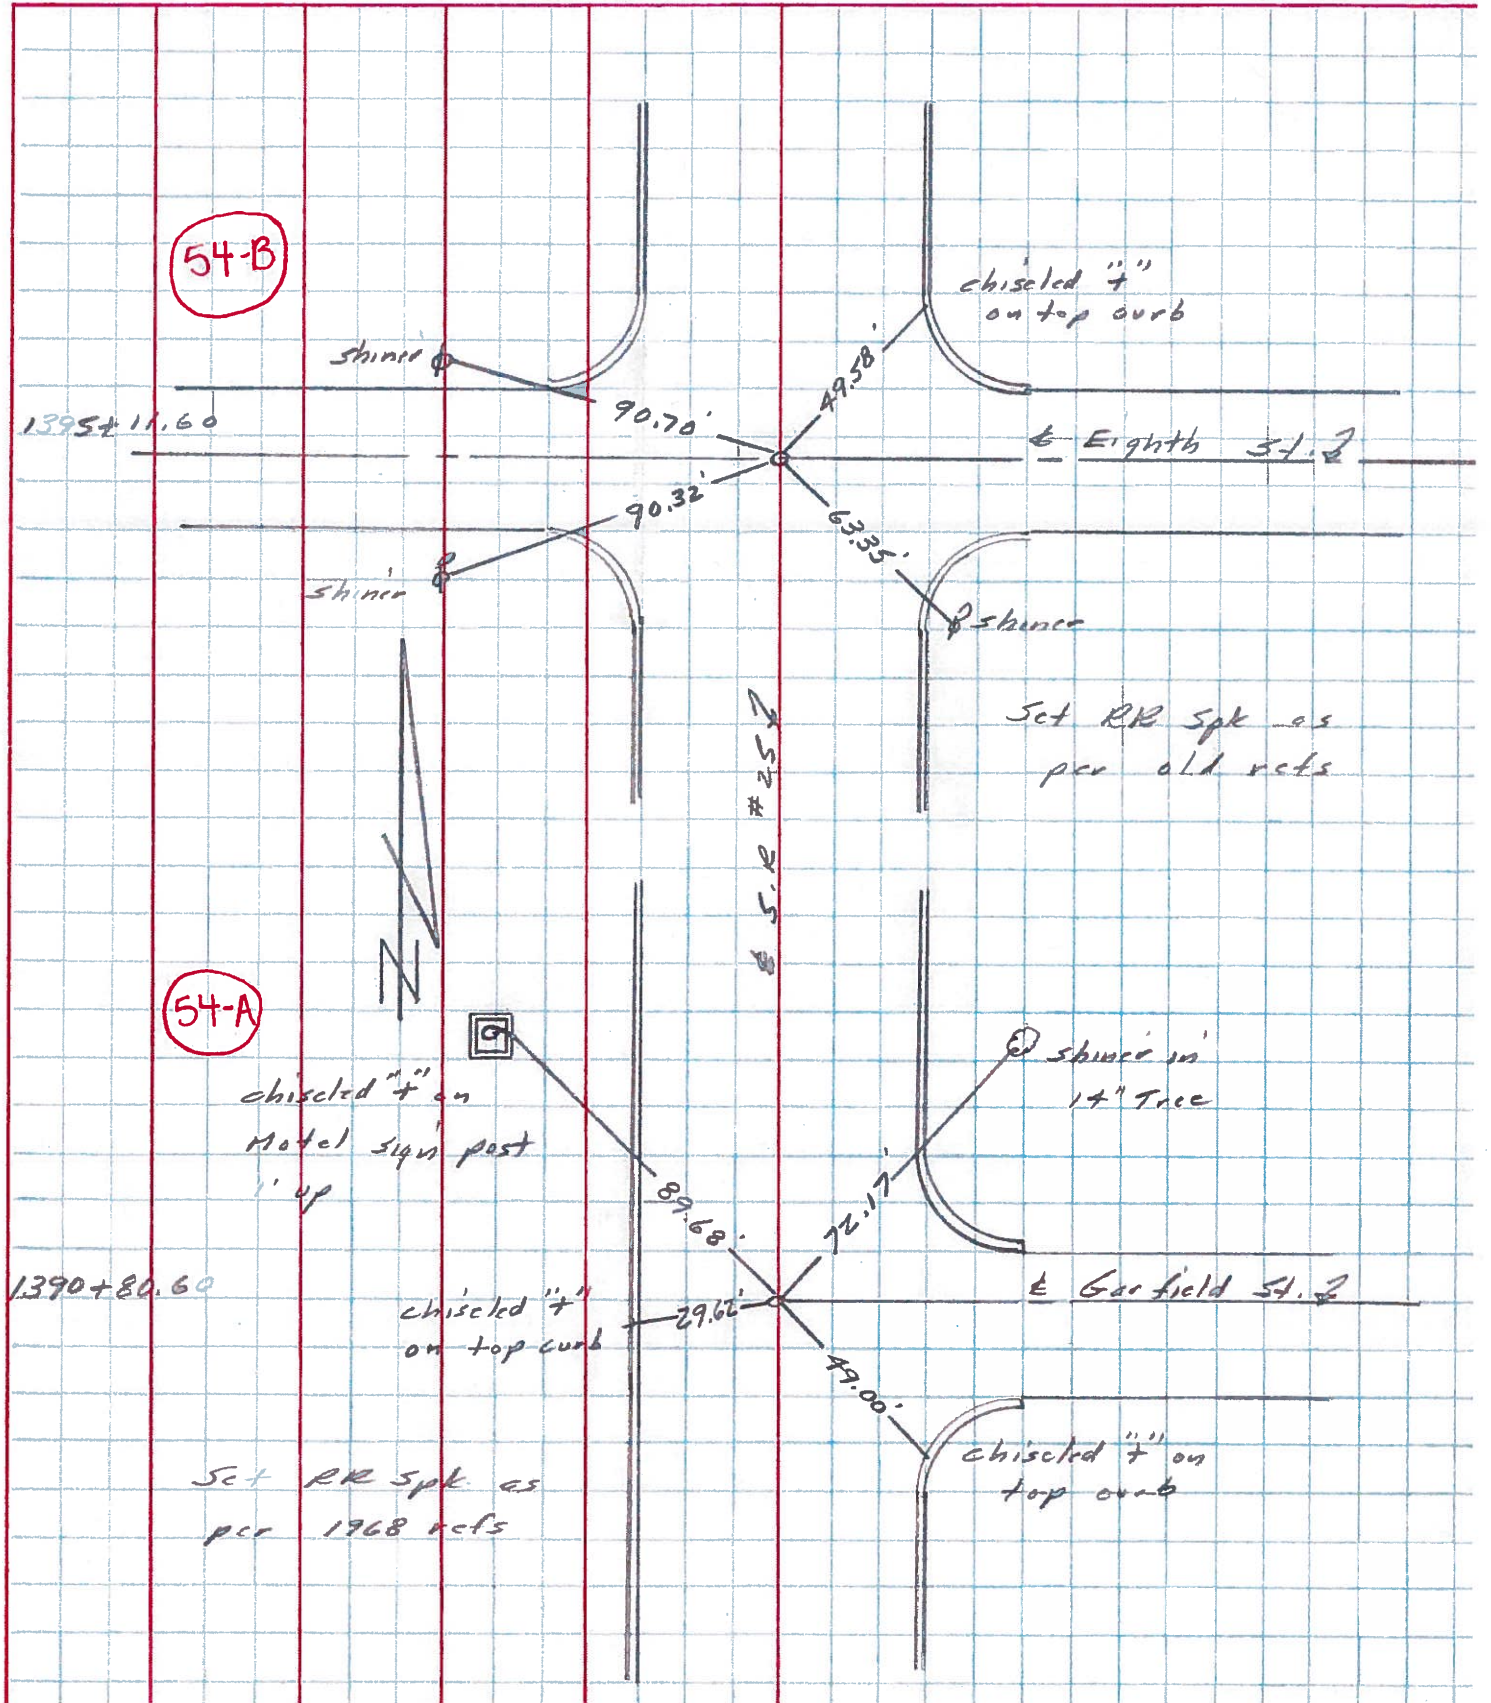

PERSONNEL TITLE PERSONNEL TITLE

Silvester

COUNTY Wood

DATE 6-28-56

S. R. 14.5#25

WEATHER

SEC.

TEMP.

DESCRIPTION

West Boundary St. Perrysburg

JOB NO.


LEFT

CENTER LINE

RIGHT


Sta. 1395+11.60
W. Boundary & 8th
Mon.

54-B #910

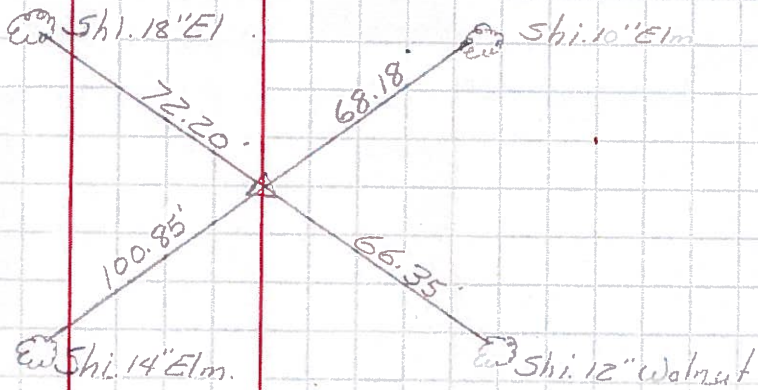

Sta. 1413+12.25 (stone)
W. Boundary & Indiana

54-E #911

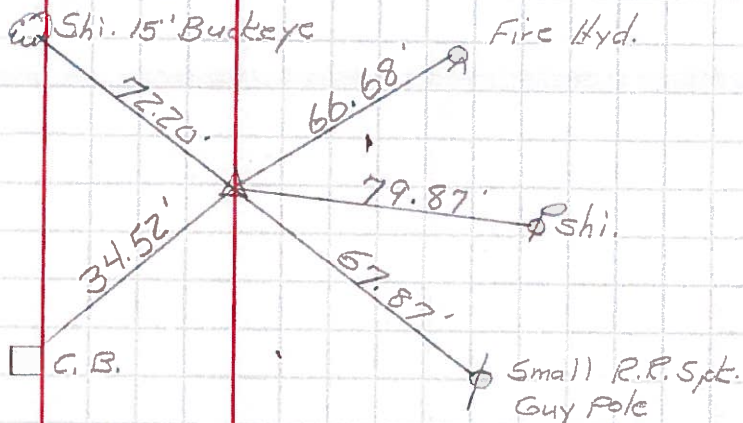

Sta. 1417+92.60
P.O.T.
R.K. nail.

#912

