

O.D.O.T. DISTRICT 2 SURVEY OFFICE (USE ONLY)

PERSONNEL _____

REFERENCE NO. 54 C

SHEET 9 OF 13

NOTES STONE

DATE 4/22/91

ROUTE SR 25

H.C. CURTIS

WEATHER COOL

COUNTY WOOD

R.C. HOUSEHOLDER

TEMP. 47°

TOWNSHIP PERRYSBURG

SECTION 12 MILE RESERVE

DWG BY NIESE PID _____

T 4 US R E

TYPE MONUMENT SM.R.R. SPIKE

ON SURFACE - ~~BELOW~~ ON

OFFSET Q PAVEMENT ON LT : RT

- TO - EDGE PAVEMENT


STATION: 1165+62

HORIZ.DATUM: _____


GEOID: _____

GRID: NORTHING: _____

EASTING: _____

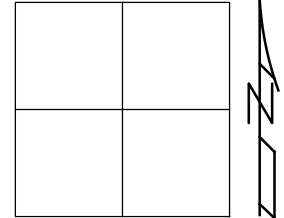

RECORD:
FD SM.R.R. SPIKE
4/22/91, DFC
SET SM.R.R. SPIKE
6/6/91, DFC

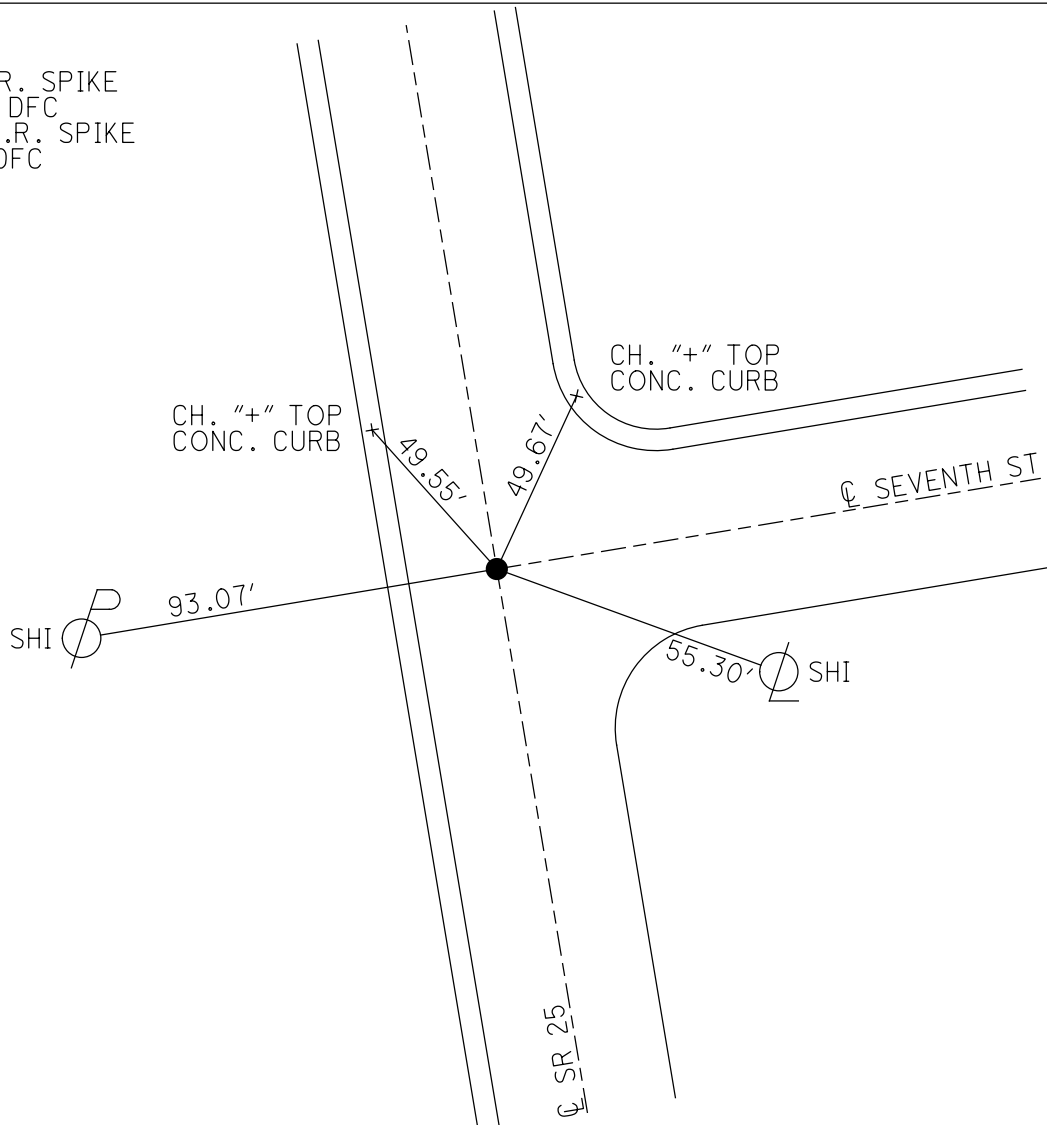

O.D.O.T. DISTRICT 2 SURVEY OFFICE

PERSONNEL _____

REFERENCE NO. 54-6

SHEET 26 OF 29

NOTES L. Stone

H.C. D. Curtis

R.C. J. Hauschalter

DATE 22 April 91

WEATHER Cool

TEMP. 47.0

ROUTE SR #25

COUNTY Wood

TOWNSHIP Perrysburg

SECTION _____

T _____ R _____


TYPE MONUMENT 5m. RR Spike

ON SURFACE - BELOW Surface


LEFT - & PAV'T. - RIGHT _____

TO _____ EDGE PAVEMENT

S.L.M. 1165+62

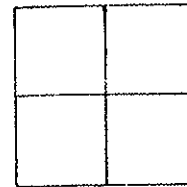

SET 5m. R.R. SPIKE TO SURFACE
6-6-91
RJC

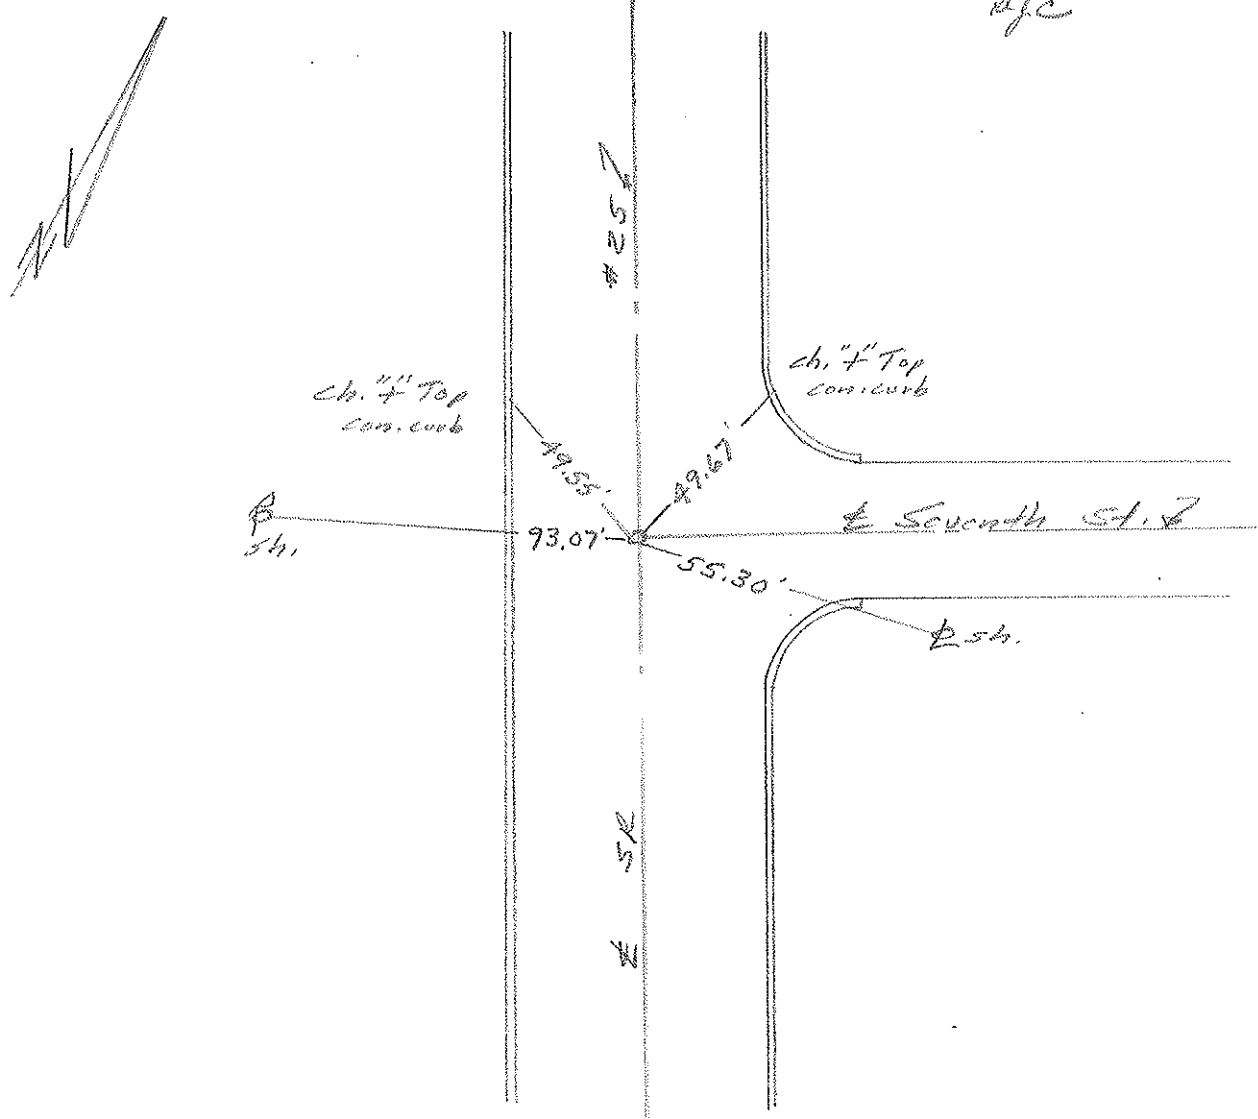

PERSONNEL	TITLE	PERSONNEL	TITLE
<u>Stone</u>			
<u>Michalek</u>			
<u>Deano</u>			
<u>Curtis</u>			

COUNTY Wood DATE 9 April 75
 S. R. #25 WEATHER Cloudy
 SEC. Penns burg TEMP. 33°

DESCRIPTION References to Control Points JOB NO. _____

