

- END ACQUISITION STA. 160+55.12
- RESUME ACQUISITION STA. 158+65.00
- SUSPEND ACQUISITION STA. 114+42.00
- RESUME ACQUISITION STA. 112+78.00
- SUSPEND ACQUISITION STA. 94+51.00
- RESUME ACQUISITION STA. 92+84.00
- SUSPEND ACQUISITION STA. 23+31.00
- BEGIN ACQUISITION STA. 21+29.00

RIGHT OF WAY LEGEND SHEET

WOO-51-0.42/ 1.78 / 2.16 / 3.03

WOOD COUNTY
LAKE TOWNSHIP
SECTIONS 2, 3, 11, 12 & 13
T. 7 N., R. 12 E.

LOCATION MAP

LATITUDE: 41°34'22" LONGITUDE: 83°25'17" WOO-51-0.42 - LOCATION 1
 LATITUDE: 41°35'09" LONGITUDE: 83°26'27" WOO-51-1.78 - LOCATION 2
 LATITUDE: 41°35'23" LONGITUDE: 83°26'46" WOO-51-2.16 - LOCATION 3
 LATITUDE: 41°35'53" LONGITUDE: 83°27'31" WOO-51-3.03 - LOCATION 4



INDEX OF SHEETS:


LEGEND SHEET	1
CENTERLINE PLAT	2-3
PROPERTY MAPS	4-6
SUMMARY OF ADDITIONAL R/W	7-8
R/W DETAIL SHEETS	9-12

CONVENTIONAL SYMBOLS

- Township Line ————
- Section Line ————
- Center Line ————
- Right of Way (Ex) ———— Ex R/W
- Standard Highway Ease.(Ex) ———— Ex SH
- Standard Highway Ease.(Pr) ———— SH
- Channel Easement (Pr) ———— CH
- Utility Easement (Ex) ———— U
- Sewer (Ex) ———— SW
- Guardrail (Ex) ———— (Pr)
- Construction Limits ————
- Edge of Pavement (Ex) ————
- Edge of Pavement (Pr) ————
- Edge of Shoulder (Ex) ————
- Edge of Shoulder (Pr) ————
- Ditch / Creek (Ex) ————
- Ditch / Creek (Pr) ————
- Fence (Ex) ———— x ———— x
- Tree Line (Ex) ————
- Ownership Hook Symbol Z, Example Z
- Property Line Symbol P, Example P
- Break Line Symbol B, Example B
- Tree (Pr) T, Tree (Ex) T, Shrub (Ex) S, Pine (Ex) P
- Tree Removed X, Pine Removed X
- Post (Ex) O, Mailbox (Ex) M, Mailbox (Pr) M
- Fire Hydrant (Ex) F, Water Meter (Ex) W, Water Line Marker W
- Water Valve (Ex) V, Utility Valve Unknown (Ex.) U
- Telephone Pole (Ex) P, Power Pole (Ex) P
- Light Pole (Ex) L
- Rock Channel Protection (Pr) R, Catch Basin (Ex) C

I, Matthew J. Puhl, P. S. have conducted a survey of the existing conditions for the Ohio Department of Transportation in August 2011. The results of that survey are contained herein. The horizontal coordinates expressed herein are based on the Ohio State Plane Coordinates System North Zone on NAD 83 (CORS96) datum. The Project Coordinates (US Survey Feet) are relative to State Plane Grid Coordinates US Survey Feet by a Project Adjustment Factor of 1.0000434288 (Grid to Ground). As a part of this project I have reestablished the locations of the existing property lines and the existing centerline of Right of Way for property takes contained herein. As a part of this project I have established the proposed property lines, calculated the Gross Take, present roadway occupied (PRO), Net Take and Net Residue; as well as prepared the legal descriptions necessary to acquire the parcels as shown herein. As a part of this work I have set right of way monuments at the property corners, property line intersection, points along the right of way and/or angle points on the right of way, Section Corners and other points as shown herein. All of my work contained herein was conducted in accordance with Ohio Administrative Code 4733-37 commonly known as "Minimum Standards for Boundary Surveys in the State of Ohio" unless noted. The words I and my as used herein are to mean either myself or someone working under my direct supervision.

Matthew J. Puhl
Matthew J. Puhl, Ohio License Surveyor #8363

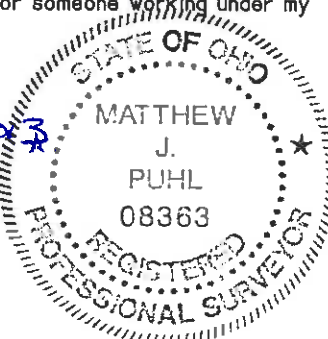

LEGEND:
SH = STANDARD HIGHWAY EASEMENT
CH = CHANNEL EASEMENT

STRUCTURE KEY

- RESIDENTIAL
- COMMERCIAL
- ▨ OUT-BUILDING

NOTES: THE LOCATION OF THE UNDERGROUND UTILITIES SHOWN ON THE PLANS ARE OBTAINED FROM THE OWNER OF THE UTILITIES AS REQUIRED BY SECTION 153.64 O.R.C.

PROJECT DESCRIPTION

IMPROVEMENT OF 0.02 MILES OF S.R. 51 BY REPLACEMENT OF THE EXISTING STRUCTURE OVER CRANE CREEK.
 IMPROVEMENT OF 0.02 MILES OF S.R. 51 BY REPLACEMENT OF THE EXISTING STRUCTURE OVER AYERS CREEK.
 IMPROVEMENT OF 0.02 MILES OF S.R. 51 BY REPLACEMENT OF THE EXISTING STRUCTURE OVER LITTLE CEDAR CREEK.
 IMPROVEMENT OF 0.03 MILES OF S.R. 51 BY REPLACEMENT OF THE EXISTING STRUCTURE OVER DRY CREEK.

THE EXISTING AND PROPOSED RIGHT OF WAY SHALL BE REFERENCED FROM THE CENTERLINE OF RIGHT OF WAY.

PLANS PREPARED BY:

FIRM NAME : NORTHWEST CONSULTANTS, INC.
 PLANS PREPARED BY: JACK EBERT
 FIELD REVIEW BY: MATT PUHL & FRED WEISS (ODOT)

DATE COMPLETED: JANUARY 08, 2013
 OWNERSHIP VERIFIED BY: MATT PUHL
 DATE COMPLETED: JANUARY 03, 2013
 DATE COMPLETED: JANUARY 08, 2013

UTILITY OWNERS	
TYPE	NAME & ADDRESS
POWER	TOLEDO EDISON 6099 ANGOLA RD HOLLAND, OH 43528 419-249-5218
GAS	COLUMBIA GAS OF OHIO, INC. 3222 CENTRAL AVE. TOLEDO, OH 43606 419-539-6066
	BP OIL - CYGNET (WOO-51-1.78/2.16) 12716 TANK FARM ROAD CYGNET, OH 43413 419-655-2966
	SUNOCO PIPE LINE L.P. (WOO-51-1.78/2.16) 525 FRITZTOWN ROAD SINKING SPRINGS, PA 19608 610-670-3291
CABLE	NORTH COAST GAS TRANSMSSION, LLC (WOO-51-3.03) 445 HUTCHINSON AVENUE, SUITE 830 COLUMBUS, OH 43235 614-505-7210
	TIME WARNER CABLE 3760 INTERCHANGE DR. COLUMBUS, OH 43204 614-255-6349
WATER	FRONTIER COMMUNICATIONS OF MICHIGAN 109 RANDOLPH STREET BROOKLYN, MI 49230 419-841-7281
	AT&T - OHIO (WOO-51-1.78/2.16/3.03) 130 N. ERIE ST, ROOM 714 TOLEDO, OH 43624 419-245-7304
	BUCKEYE CABLESYSTEM (WOO-51-3.03) 4818 ANGOLA ROAD TOLEDO, OH 43615 419-724-9820
	NORTHWESTERN WATER & SEWER DIST. P.O. BOX 348 BOWLING GREEN, OH 43402 419-354-9090

FEDERAL PROJECT NO. E110178
 PID NO. 90127
 CALCULATED JAE
 CHECKED MJF
RIGHT OF WAY LEGEND SHEET
 WOO-51-0.42/1.78/2.16/3.03
 1 / 12

WOO-51-0.42/1.78/2.16/3.03

WOOD COUNTY
LAKE TOWNSHIP
SECTIONS 2, 3, 11, 12, 13
T. 7 N., R. 12 E.

THE EXISTING R/W WIDTH AND LOCATION WERE DETERMINED USING
 - EXISTING WOOD COUNTY PLANS S.H.(I.C.H.) 52 DATED 1932
 - RIGHT OF WAY PLANS WOO-51 (1.57-1.75)/WOO-579-0.01 DATED 1967
 - NOBLE'S ADDITION PLAT VOL. 11 PAGE 64 DATED 1957
 - DOUGLAS FARM ADDITION PLAT VOL. 7 PAGE 33 DATED 1907
 - KETCHAM'S CRESCENS FIELDS PLAT VOL. 6 PAGE 66



MONUMENT LEGEND

- ⊕ RAILROAD SPIKE FOUND
- ⊙ P.K. NAIL FOUND
- ⊞ MONUMENT BOX FOUND
- ⊙ M.N.S. MAG NAIL SET

BASIS FOR BEARINGS:

BEARINGS USED HEREIN ARE BASED ON OHIO STATE PLANE COORDINATE SYSTEM, NORTH ZONE NAD83(CORS96)

MONUMENT TABLE					
COMBINED SCALE FACTOR (GROUND TO GRID) = 0.9999565731					
STATION	DIST. FROM E. OF R/W		STATE PLANE GROUND COORDINATES (U.S. FEET)		EXISTING MONUMENTATION
	LEFT	RIGHT	NORTHING (Y)	EASTING (X)	
00+00.00	€		694336.0757	1718112.4030	RAILROAD SPIKE
17+06.74	€		695489.7111	1716854.5880	PK NAIL
23+36.40	€		695915.1195	1716390.3747	MAG NAIL SET
35+93.85	€		696767.4593	1715465.8810	RAILROAD SPIKE
53+86.22	€		697978.5312	1714144.5480	RAILROAD SPIKE
64+84.51	€		698720.3554	1713334.6580	RAILROAD SPIKE
71+92.95	€		699201.0091	1712814.2040	RAILROAD SPIKE
81+00.47	€		699817.3687	1712148.1010	PK NAIL

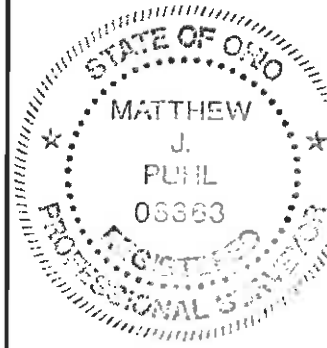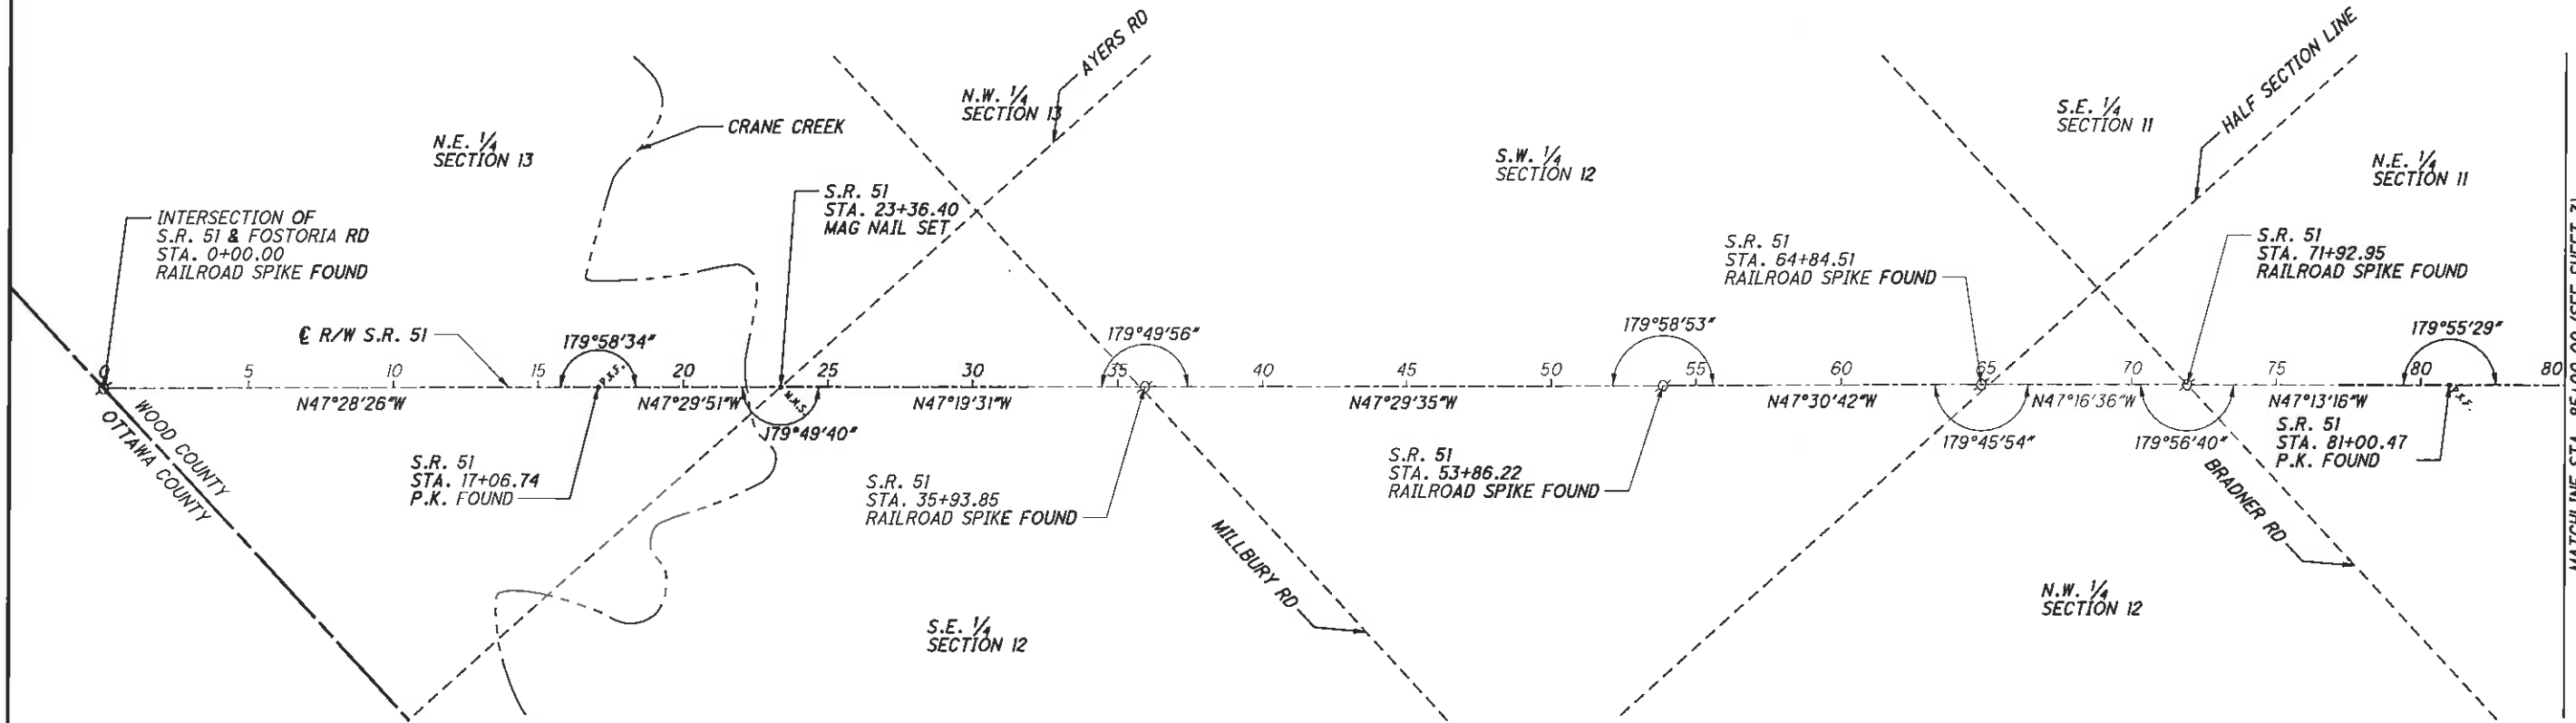

I, Matthew J. Puhl, P. S. have conducted a survey of the existing conditions for the Ohio Department of Transportation in August 2011. The results of that survey are contained herein. The horizontal coordinates expressed herein are based on the Ohio State Plane Coordinates System North Zone on NAD 83 (CORS96) datum. The Project Coordinates (US Survey Feet) are relative to State Plane Grid Coordinates US Survey Feet, by a Project Adjustment Factor of 1.0000434288 (Grid to Ground). As a part of this project I have reestablished the locations of the existing property lines and the existing centerline of Right of Way for property takes contained herein. As a part of this project I have established the proposed property lines, calculated the Gross Take, present roadway occupied (PRO), Net Take and Net Residue; as well as prepared the legal descriptions necessary to acquire the parcels as shown herein. As a part of this work I have set right of way monuments at the property corners, property line intersection, points along the right of way and/or angle points on the right of way, Section Corners and other points as shown herein. All of my work contained herein was conducted in accordance with Ohio Administrative Code 4733-37 commonly known as "Minimum Standards for Boundary Surveys in the State of Ohio" unless noted. The words I and my as used herein are to mean either myself or someone working under my direct supervision.

THE PROPOSED RIGHT OF WAY SHALL BE REFERENCED FROM THE CENTERLINE OF RIGHT OF WAY.

THE PLACING OF MONUMENTS SHALL BE UNDER THE DIRECTION OF A SURVEYOR REGISTERED IN THE STATE OF OHIO. THE CENTERLINE MONUMENT ASSEMBLY BOX(S) WILL BE INSTALLED BY THE HIGHWAY CONTRACTOR AT THE TIME OF CONSTRUCTION. THE IRON PIN WITH CAP MARKING THE ACTUAL CENTERLINE STATION POINT AND ANY REFERENCE MONUMENTS ARE TO BE SET BY THE CONTRACTOR'S SURVEYOR.

CHANGES OR ALTERATIONS TO THE LOCATION OF ANY MONUMENTS SHOWN ON THIS PLAT, REQUIRES PRIOR APPROVAL OF THE DISTRICT REAL ESTATE ADMINISTRATOR OF THE OHIO DEPARTMENT OF TRANSPORTATION. A REVISED CENTERLINE PLAT WITH THE NEW LOCATIONS SHALL BE RECORDED IN THE APPLICABLE COUNTY RECORDS AND THE OHIO DEPARTMENT OF TRANSPORTATION. SPECIFICATIONS FOR CENTERLINE MONUMENTS, REFERENCE MONUMENTS AND RIGHT OF WAY MONUMENTS ARE SHOWN ON STANDARD CONSTRUCTION DRAWING RM-1.1 OF THE OHIO DEPARTMENT OF TRANSPORTATION.

SETTING OF ALL MONUMENTS SHALL BE PERFORMED BY A SURVEYOR REGISTERED IN THE STATE OF OHIO. THE MONUMENT ASSEMBLIES AND REFERENCE MONUMENTS WILL BE INSTALLED BY THE CONTRACTOR AT THE TIME OF CONSTRUCTION. THE IRON PIN AND CAP (WHEN REQUIRED) ARE TO BE INSTALLED BY THE CONTRACTOR'S SURVEYOR.

CHANGES OR ALTERATIONS TO THE LOCATION OF ANY MONUMENTS SHOWN IN THIS TABLE, REQUIRE PRIOR APPROVAL FROM THE DISTRICT REAL ESTATE ADMINISTRATOR OF THE OHIO DEPARTMENT OF TRANSPORTATION. IN THE EVENT THAT CHANGES OR ALTERATIONS ARE APPROVED, A REVISED CENTERLINE PLAT WITH THE NEW LOCATIONS SHALL BE RECORDED IN THE APPLICABLE COUNTY RECORDS AND THE OHIO DEPARTMENT OF TRANSPORTATION. SPECIFICATIONS FOR MONUMENT ASSEMBLIES, REFERENCE MONUMENTS AND RIGHT OF WAY MONUMENTS ARE SHOWN ON STANDARD CONSTRUCTION DRAWING RM-1.1.

RECEIVED 11/20/13
 RECORDED 11/20/13
 PLAT VOL. 23 PAGE 507-508
 Matthew J. Puhl
 WOOD COUNTY RECORDER

Matthew J. Puhl
 Matthew J. Puhl, Ohio License Surveyor #8363
 01-02-2013



300
150
0
HORIZONTAL SCALE IN FEET

R/W DESIGNER JAE
R/W REVIEWER MJJP

PID NO. 90127

CENTERLINE PLAT

WOO-51-0.42/1.78/2.16/3.03

2 / 12



NOTE:

THE EXISTING R/W WIDTH AND LOCATION WERE DETERMINED USING
 - EXISTING WOOD COUNTY PLANS S.H.(I.C.H.) 52 DATED 1932
 - RIGHT OF WAY PLANS WOO-51 (1.57-1.75)/WOO-579-0.01 DATED 1967
 - NOBLE'S ADDITION PLAT VOL. 11 PAGE 64 DATED 1957
 - DOUGLAS FARM ADDITION PLAT VOL. 7 PAGE 33 DATED 1907
 - KETCHAM'S CRESCENT FARMS PLAT VOL. 6 PAGE 66

MONUMENT LEGEND

- ⊕ RAILROAD SPIKE FOUND
- ⊙ P.K. NAIL FOUND
- ⊞ MONUMENT BOX FOUND
- ⊙ M.S. MAG NAIL SET



BASIS FOR BEARINGS:

BEARINGS USED HEREIN ARE BASED ON OHIO STATE PLANE COORDINATE SYSTEM, NORTH ZONE NAD83(CORS96)

WOO-51-0.42/ 1.78 / 2.16 / 3.03

WOOD COUNTY
 LAKE TOWNSHIP
 SECTIONS 2, 3, 11, 12, 13
 T. 7 N., R. 12 E.

MONUMENT TABLE					
COMBINED SCALE FACTOR (GROUND TO GRID) = 0.9999565731					
STATION	DIST. FROM E OF R/W		STATE PLANE GROUND COORDINATES (U.S. FEET)		EXISTING MONUMENTATION
	LEFT	RIGHT	NORTHING (Y)	EASTING (X)	
104+91.48	€		701438.9629	1710391.0180	RAILROAD SPIKE
110+02.97	€		701790.1314	1710019.1280	PK NAIL
123+31.79	€		702693.1752	1709044.3110	PK NAIL
126+25.28	€		702891.3584	1708827.8394	RAILROAD SPIKE
132+24.50	€		703294.4475	1708384.4560	MONUMENT BOX
144+12.99	€		704098.0798	1707508.8476	MAG NAIL SET
170+44.08	€		705880.5432	1705573.5310	MONUMENT BOX

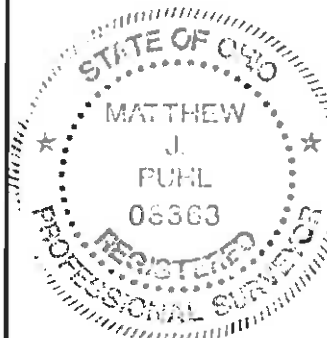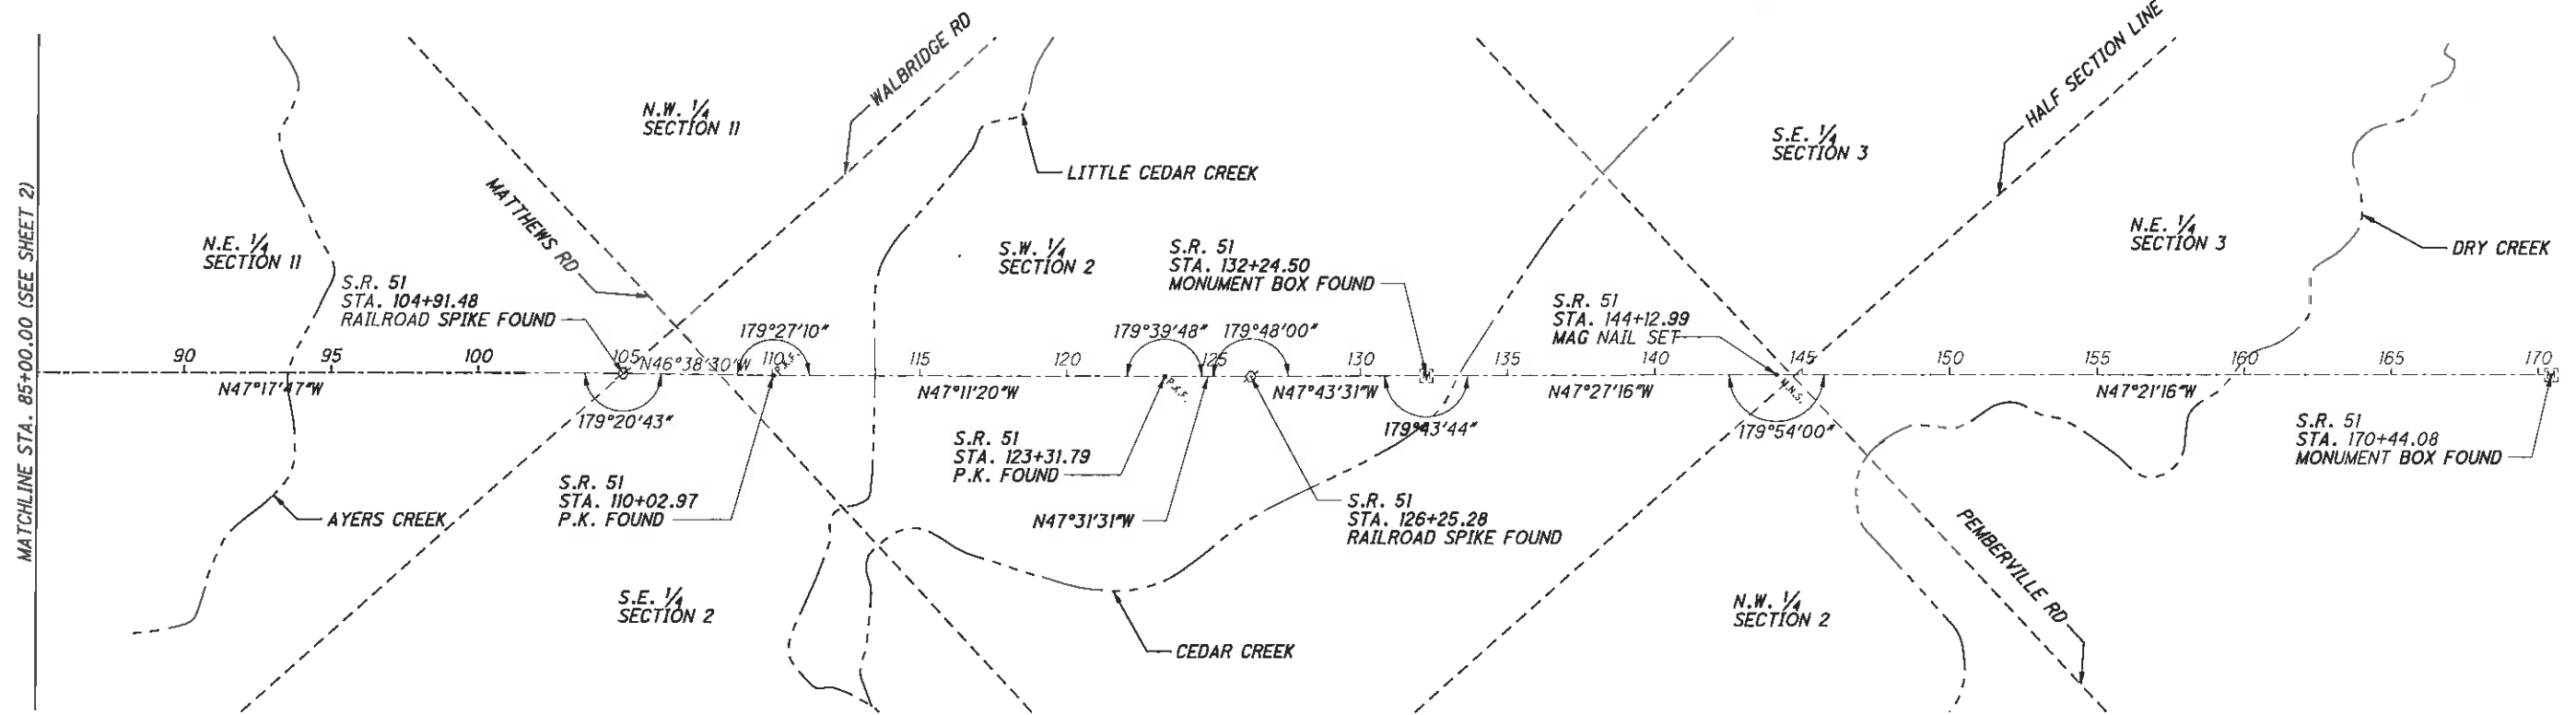

I, Matthew J. Puhl, P. S. have conducted a survey of the existing conditions for the Ohio Department of Transportation in August 2011. The results of that survey are contained herein. The horizontal coordinates expressed herein are based on the Ohio State Plane Coordinates System North Zone on NAD 83 (CORS96) datum. The Project Coordinates (US Survey Feet) are relative to State Plane Grid Coordinates US Survey Feet by a Project Adjustment Factor of 1.0000434288 (Grid to Ground). As a part of this project I have reestablished the locations of the existing property lines and the existing centerline of Right of Way for property takes contained herein. As a part of this project I have established the proposed property lines, calculated the Gross Take, present roadway occupied (PRO), Net Take and Net Residue; as well as prepared the legal descriptions necessary to acquire the parcels as shown herein. As a part of this work I have set right of way monuments at the property corners, property line intersection, points along the right of way and/or angle points on the right of way, Section Corners and other points as shown herein. All of my work contained herein was conducted in accordance with Ohio Administrative Code 4733-37 commonly known as "Minimum Standards for Boundary Surveys in the State of Ohio" unless noted. The words I and my as used herein are to mean either myself or someone working under my direct supervision.

THE PROPOSED RIGHT OF WAY SHALL BE REFERENCED FROM THE CENTERLINE OF RIGHT OF WAY.

THE PLACING OF MONUMENTS SHALL BE UNDER THE DIRECTION OF A SURVEYOR REGISTERED IN THE STATE OF OHIO. THE CENTERLINE MONUMENT ASSEMBLY (BOXES) WILL BE INSTALLED BY THE HIGHWAY CONTRACTOR AT THE TIME OF CONSTRUCTION. THE IRON PIN WITH CAP MARKING THE ACTUAL CENTERLINE STATION POINT AND ANY REFERENCE MONUMENTS ARE TO BE SET BY THE CONTRACTOR'S SURVEYOR.

CHANGES OR ALTERATIONS TO THE LOCATION OF ANY MONUMENTS SHOWN ON THIS PLAT, REQUIRES PRIOR APPROVAL OF THE DISTRICT REAL ESTATE ADMINISTRATOR OF THE OHIO DEPARTMENT OF TRANSPORTATION. A REVISED CENTERLINE PLAT WITH THE NEW LOCATIONS SHALL BE RECORDED IN THE APPLICABLE COUNTY RECORDS AND THE OHIO DEPARTMENT OF TRANSPORTATION. SPECIFICATIONS FOR CENTERLINE MONUMENTS, REFERENCE MONUMENTS AND RIGHT OF WAY MONUMENTS ARE SHOWN ON STANDARD CONSTRUCTION DRAWING RM-1.1 OF THE OHIO DEPARTMENT OF TRANSPORTATION.

2013 00131 01
 JULIE BAUMGARDNER
 WOOD COUNTY RECORDER
 01/02/2013 03:02
 Real Estate 40.00
 Housing Trust Fund 40.00
 DOCUMENT TOTAL 80.00
 Volume: 23 Page: 507-508 PLAT


SETTING OF ALL MONUMENTS SHALL BE PERFORMED BY A SURVEYOR REGISTERED IN THE STATE OF OHIO. THE MONUMENT ASSEMBLIES AND REFERENCE MONUMENTS WILL BE INSTALLED BY THE CONTRACTOR AT THE TIME OF CONSTRUCTION. THE IRON PIN AND CAP (WHEN REQUIRED) ARE TO BE INSTALLED BY THE CONTRACTOR'S SURVEYOR.

CHANGES OR ALTERATIONS TO THE LOCATION OF ANY MONUMENTS SHOWN IN THIS TABLE, REQUIRE PRIOR APPROVAL FROM THE DISTRICT REAL ESTATE ADMINISTRATOR OF THE OHIO DEPARTMENT OF TRANSPORTATION. IN THE EVENT THAT CHANGES OR ALTERATIONS ARE APPROVED, A REVISED CENTERLINE PLAT WITH THE NEW LOCATIONS SHALL BE RECORDED IN THE APPLICABLE COUNTY RECORDS AND THE OHIO DEPARTMENT OF TRANSPORTATION. SPECIFICATIONS FOR MONUMENT ASSEMBLIES, REFERENCE MONUMENTS AND RIGHT OF WAY MONUMENTS ARE SHOWN ON STANDARD CONSTRUCTION DRAWING RM-1.1.

RECEIVED 1/2/2013
 RECORDED 1/2/2013
 PLAT VOL. 23 PAGE 507-508
 Julie Baumgardner
 WOOD COUNTY RECORDER

Matthew J. Puhl
 Matthew J. Puhl, Ohio License Surveyor #8363

HORIZONTAL SCALE IN FEET
 300
 150
 0
 R/W DESIGNER JAE
 R/W REVIEWER MAJP
 PID NO. 90127
 CENTERLINE PLAT
 WOO-51-0.42/ 1.78 / 2.16 / 3.03
 3 / 12

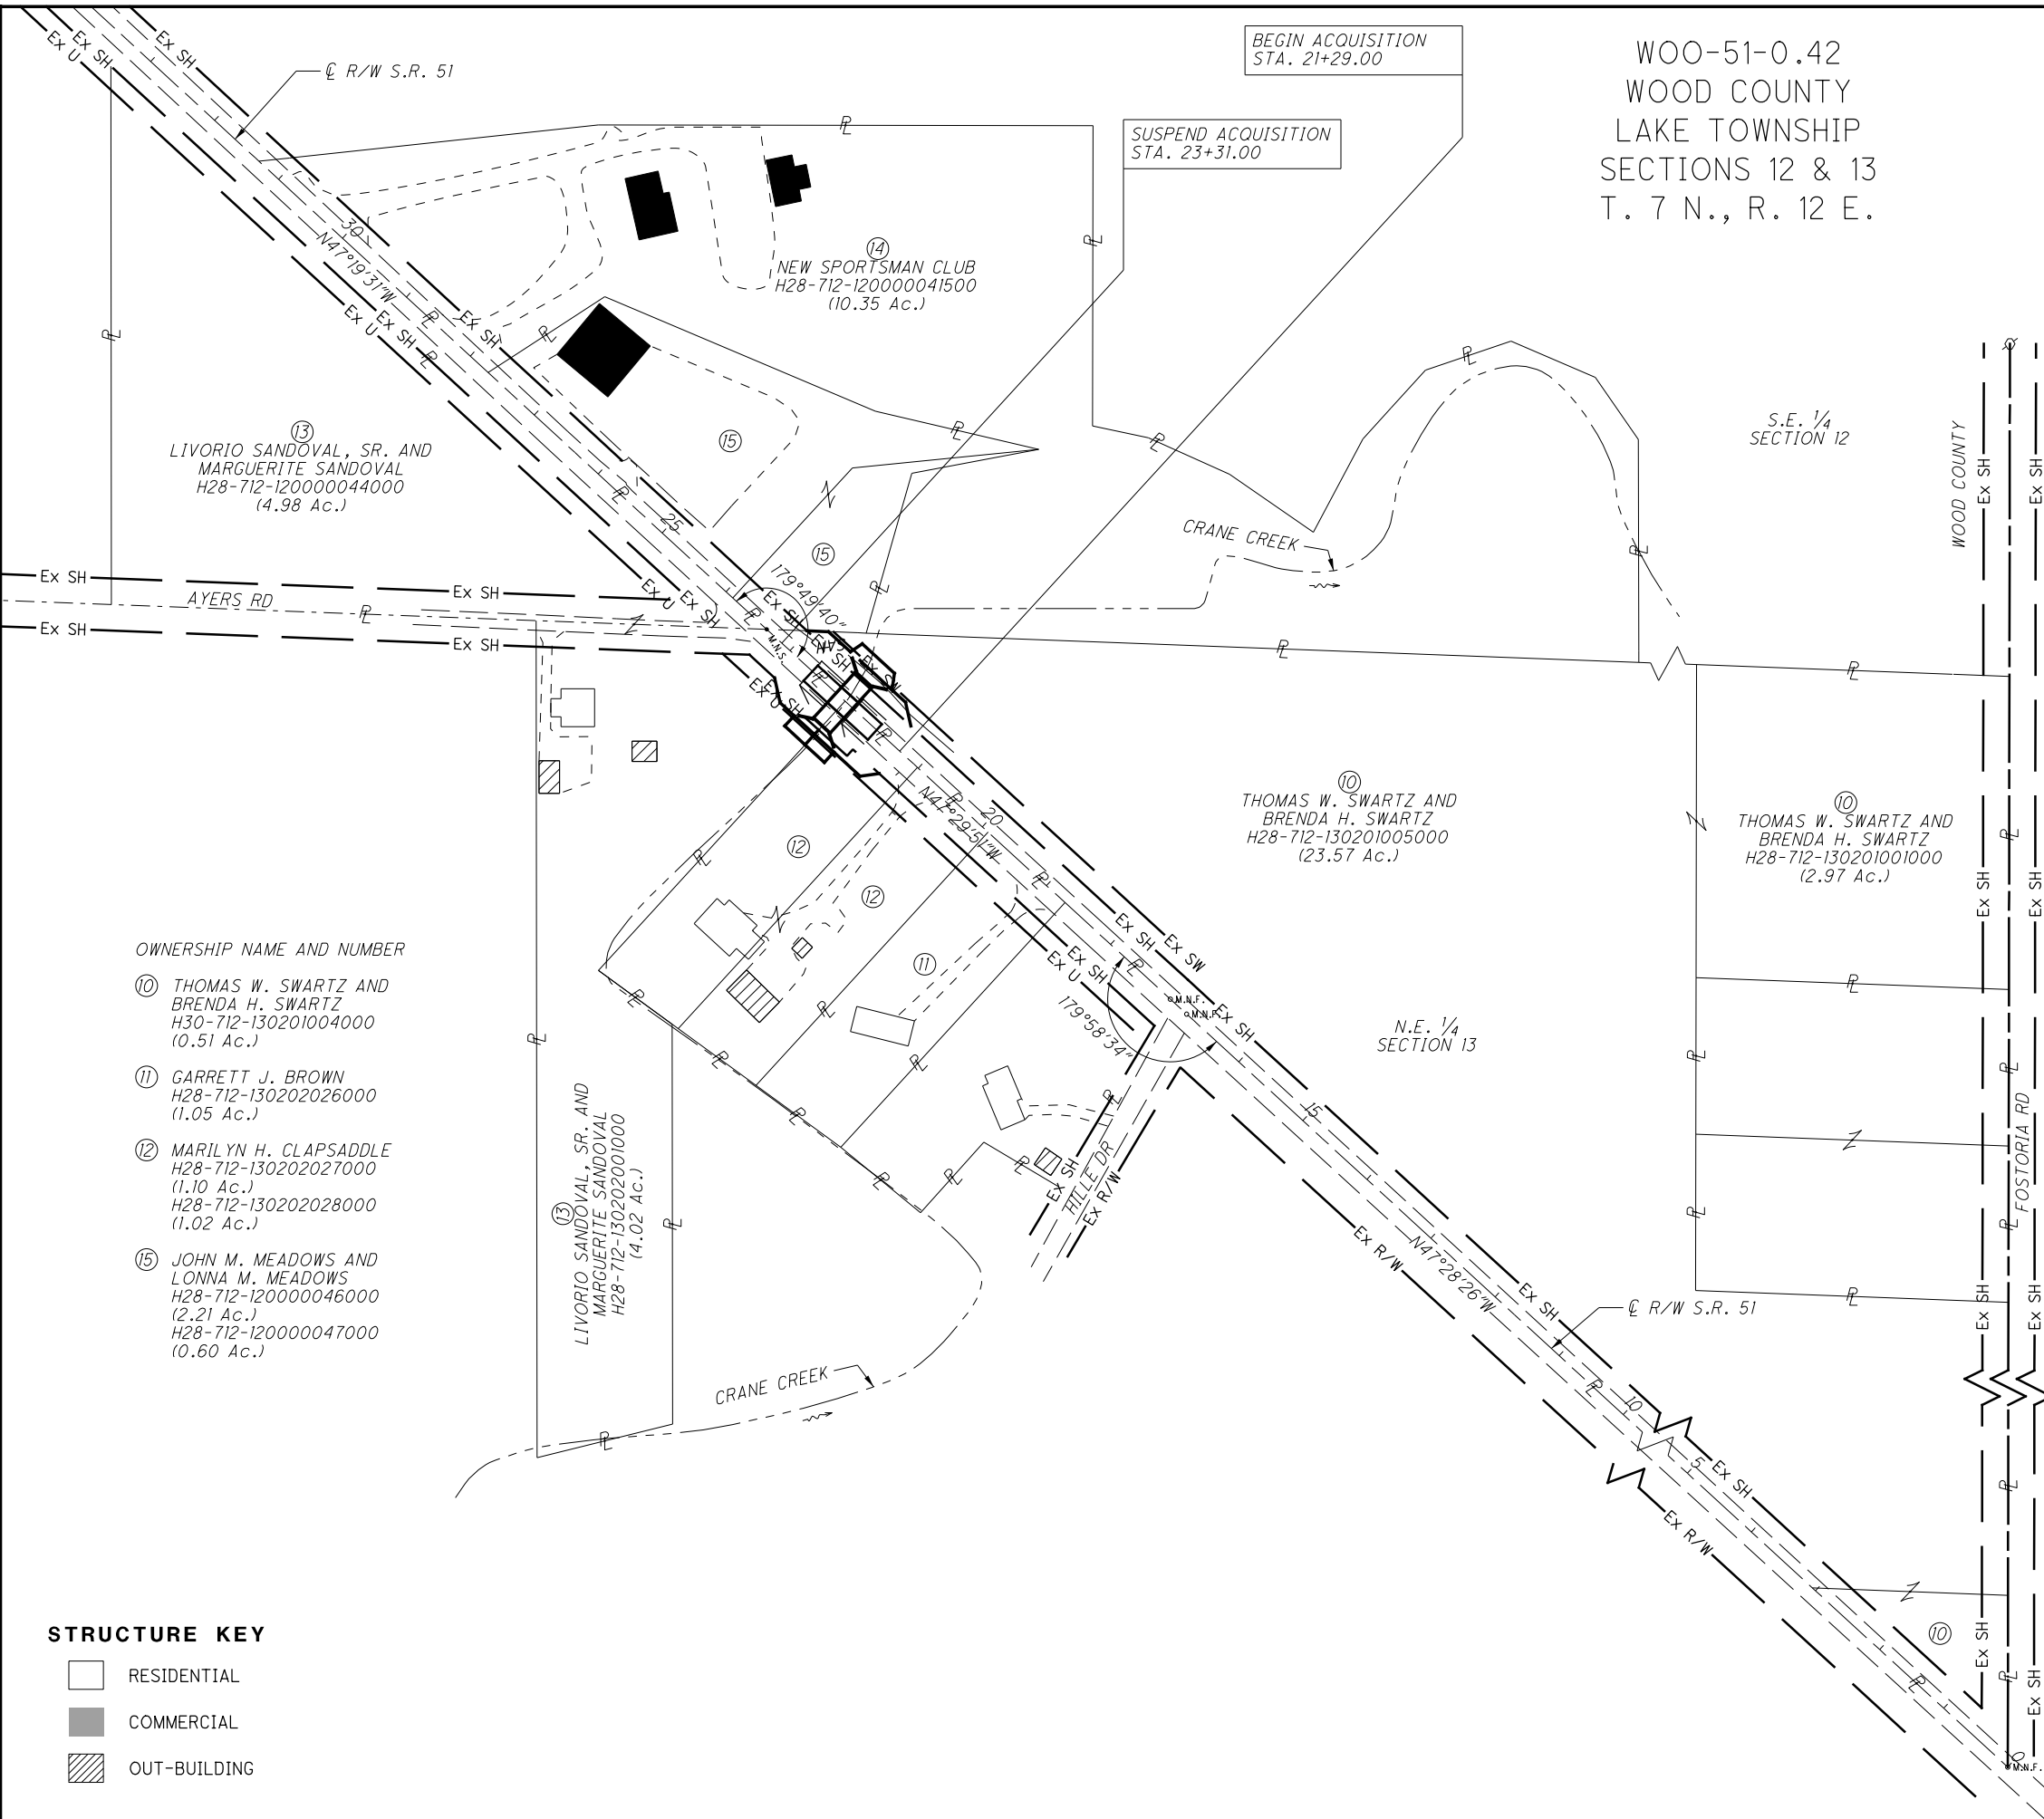

WOO-51-0.42
WOOD COUNTY
LAKE TOWNSHIP
SECTIONS 12 & 13
T. 7 N., R. 12 E.

OWNERSHIP NAME AND NUMBER


- ⑩ THOMAS W. SWARTZ AND BRENDA H. SWARTZ
H30-712-130201004000
(0.51 Ac.)
- ⑪ GARRETT J. BROWN
H28-712-130202026000
(1.05 Ac.)
- ⑫ MARILYN H. CLAPSADDLE
H28-712-130202027000
(1.10 Ac.)
H28-712-130202028000
(1.02 Ac.)
- ⑬ LIVORIO SANDOVAL, SR. AND MARGUERITE SANDOVAL
H28-712-130202010000
(4.02 Ac.)
- ⑮ JOHN M. MEADOWS AND LONNA M. MEADOWS
H28-712-120000046000
(2.21 Ac.)
H28-712-120000047000
(0.60 Ac.)

STRUCTURE KEY

- RESIDENTIAL
- COMMERCIAL
- OUT-BUILDING

REV. BY	DATE	DESCRIPTION

DATE COMPLETED JANUARY 08, 2013



0 100 200
50
HORIZONTAL
SCALE IN FEET


PID NO. **90127**

R/W DESIGNER: JAE
R/W REVIEWER: MJP


PROPERTY MAP

WOO-51-0.42 / 1.78 / 2.16 / 3.03

4 / 12

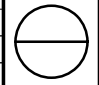


WOO-51-1.78 & WOO-51-2.16
 WOOD COUNTY
 LAKE TOWNSHIP
 SECTIONS 2 & 11
 T. 7 N., R. 12 E.

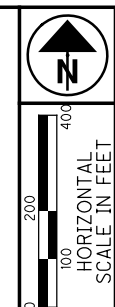

PID NO. **90127**
 R/W DESIGNER: JAE
 R/W REVIEWER: MJP

PROPERTY MAP

WOO-51-0.42 / 1.78 / 2.16 / 3.03
 5 / 12

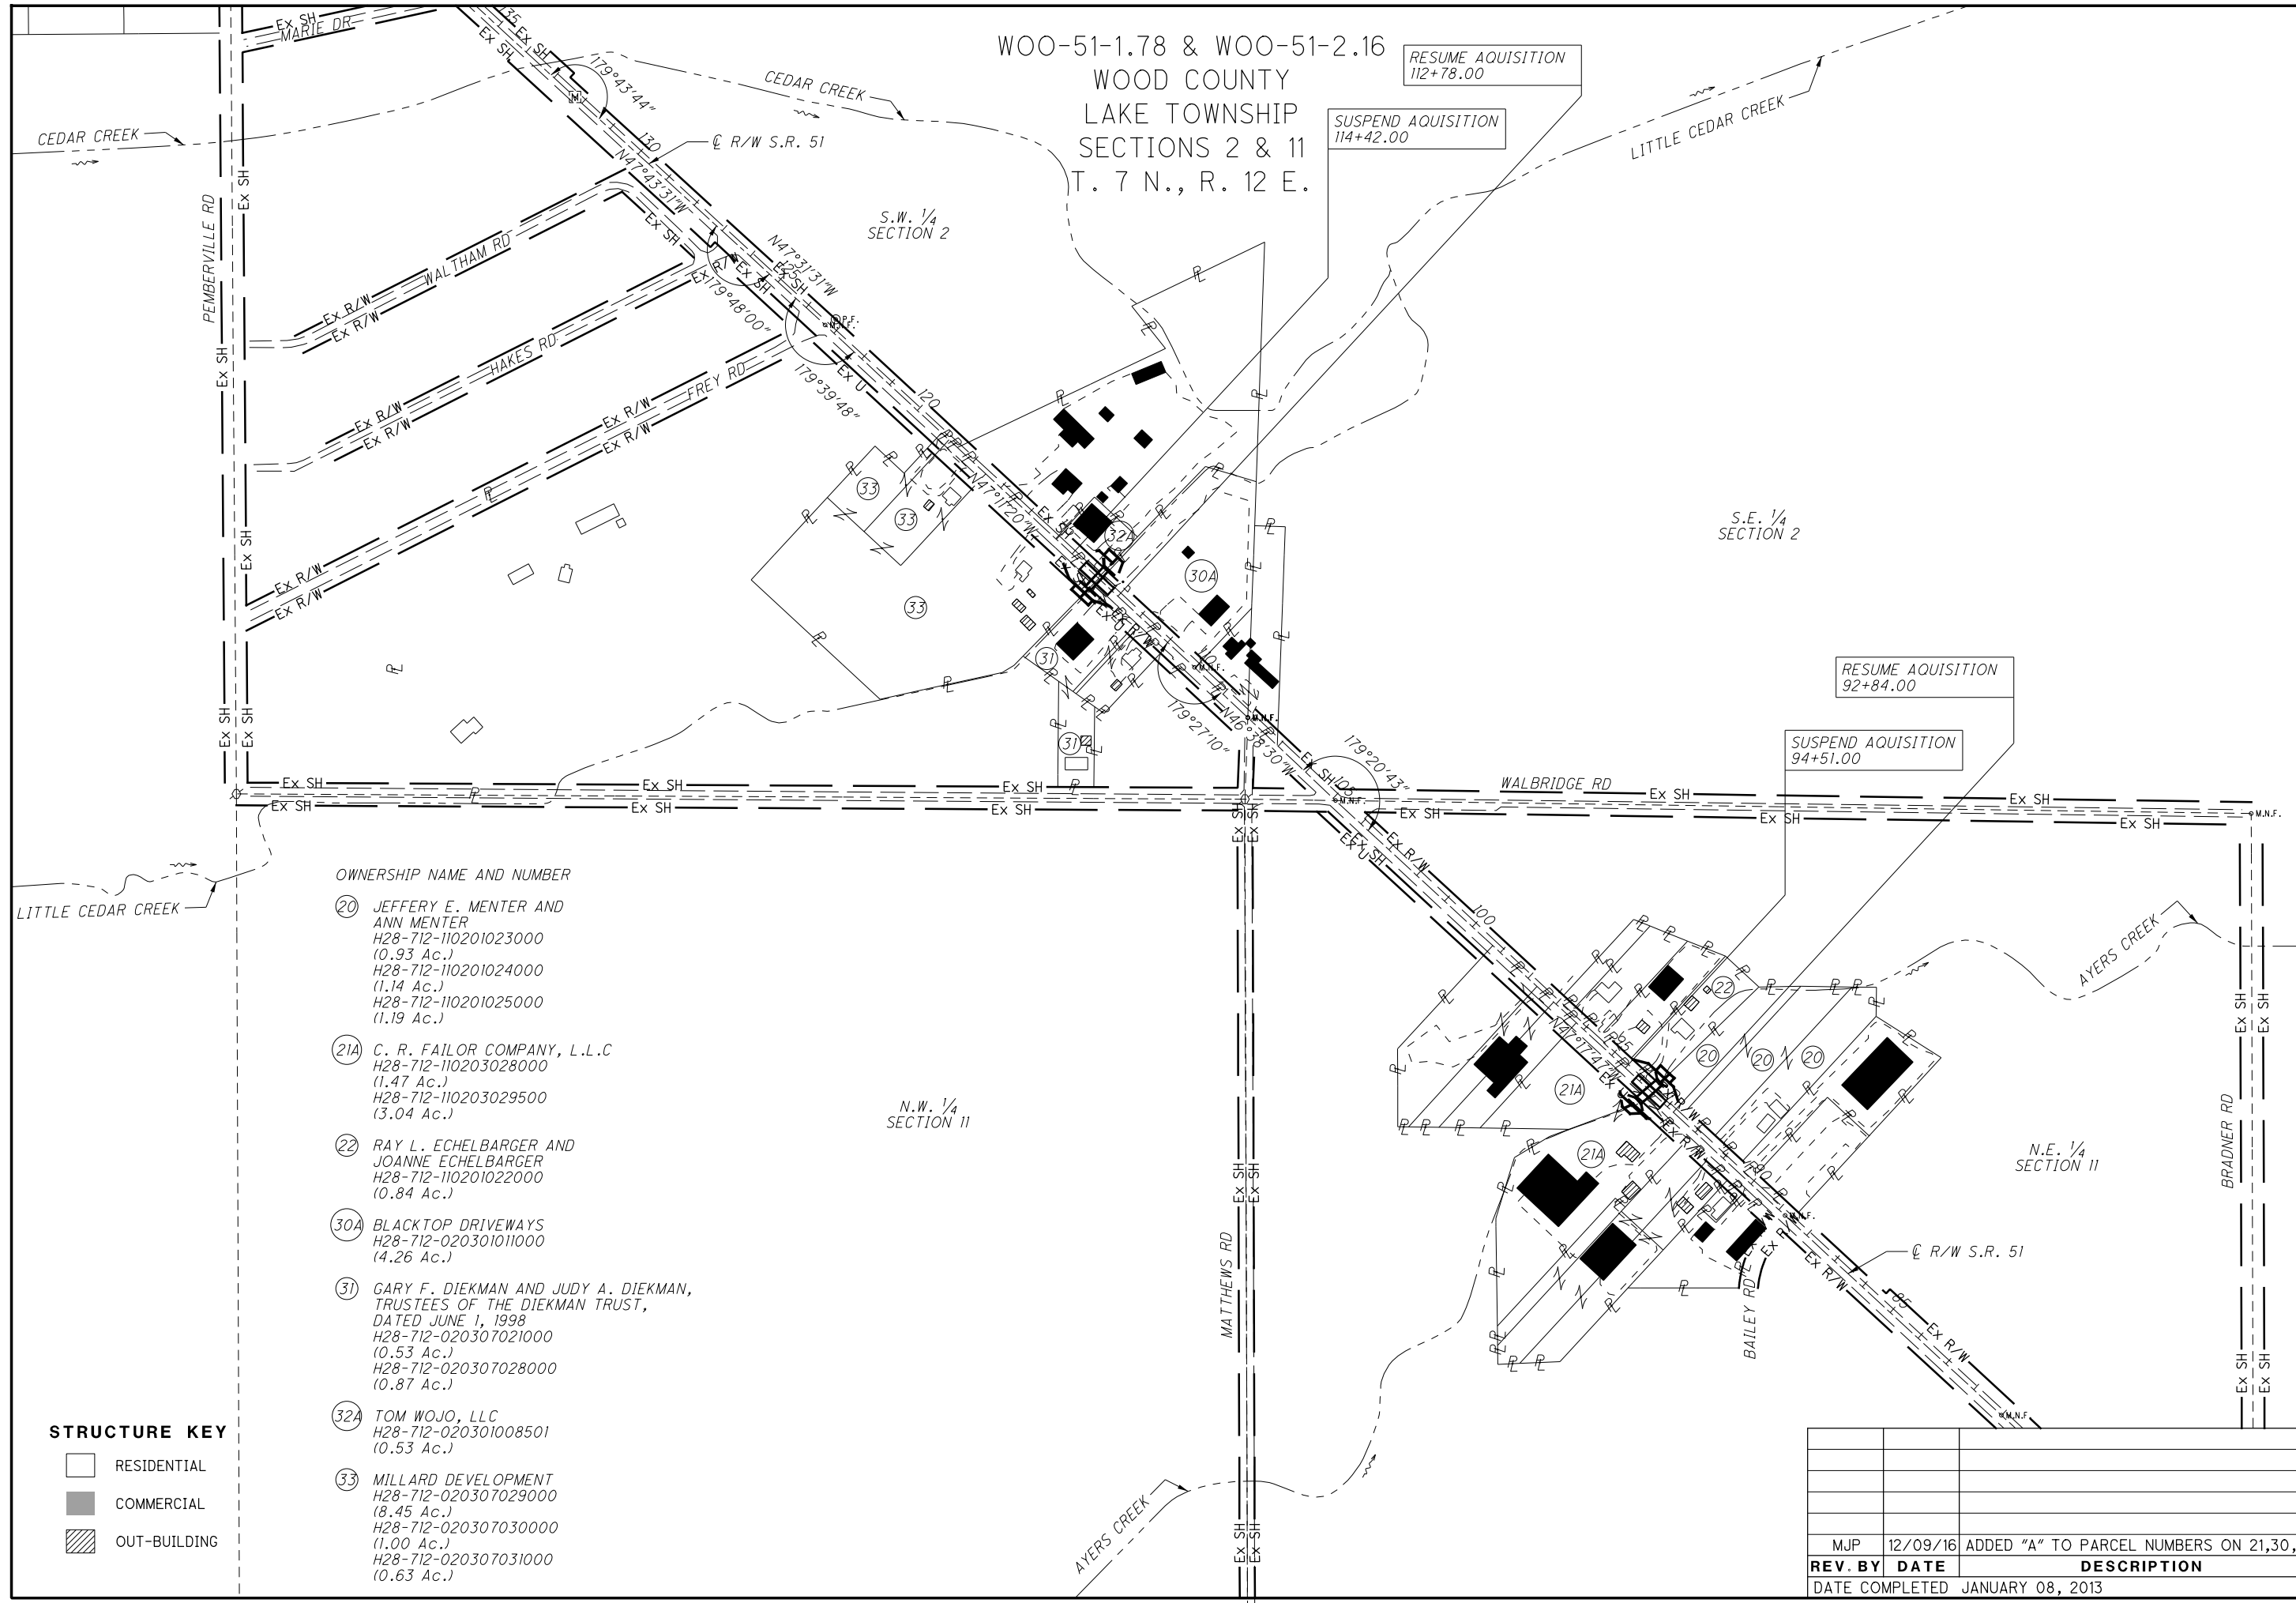

- OWNERSHIP NAME AND NUMBER**
- 20 JEFFERY E. MENTER AND ANN MENTER
 H28-712-110201023000 (0.93 Ac.)
 H28-712-110201024000 (1.14 Ac.)
 H28-712-110201025000 (1.19 Ac.)
 - 21A C. R. FAILOR COMPANY, L.L.C.
 H28-712-110203028000 (1.47 Ac.)
 H28-712-110203029500 (3.04 Ac.)
 - 22 RAY L. ECHELBARGER AND JOANNE ECHELBARGER
 H28-712-110201022000 (0.84 Ac.)
 - 30A BLACKTOP DRIVEWAYS
 H28-712-020301011000 (4.26 Ac.)
 - 31 GARY F. DIEKMAN AND JUDY A. DIEKMAN, TRUSTEES OF THE DIEKMAN TRUST, DATED JUNE 1, 1998
 H28-712-020307021000 (0.53 Ac.)
 H28-712-020307028000 (0.87 Ac.)
 - 32A TOM WOJO, LLC
 H28-712-020301008501 (0.53 Ac.)
 - 33 MILLARD DEVELOPMENT
 H28-712-020307029000 (8.45 Ac.)
 H28-712-020307030000 (1.00 Ac.)
 H28-712-020307031000 (0.63 Ac.)

STRUCTURE KEY

- RESIDENTIAL
- COMMERCIAL
- OUT-BUILDING

REV. BY	DATE	DESCRIPTION
MJP	12/09/16	ADDED "A" TO PARCEL NUMBERS ON 21,30,32
DATE COMPLETED JANUARY 08, 2013		

66
73

OWNERSHIP NAME AND NUMBER

④0 HLL LTD.
 H28-712-030204006000
 (2.10 Ac.)
 H28-712-030204007000
 (2.15 Ac.)
 H28-712-030204008000
 (2.45 Ac.)
 H28-712-030204009000
 (2.85 Ac.)
 H28-712-030204010000
 (3.15 Ac.)

④1 WRAY K. WHITE AS THE TRUSTEE OF THE
 WRAY K. WHITE REVOCABLE LIVING TRUST
 DATED JANUARY 2, 2001 AND FLOY L. WHITE
 AS THE TRUSTEE OF THE FLOY L. WHITE
 REVOCABLE LIVING TRUST
 DATED JANUARY 2, 2001
 H28-712-030201009000
 (1.23 Ac.)
 H28-712-030201010000
 (0.08 Ac.)

④2 TIMOTHY J. COON AND
 BRENDA S. COON
 H28-712-030201007000
 (4.00 Ac.)
 H28-712-030201008000
 (0.50 Ac.)

W00-51-3.03
 WOOD COUNTY
 LAKE TOWNSHIP
 SECTION 3
 T. 7 N., R. 12 E.

RESUME AQUISITION
 STA. 158+65.00

END AQUISITION
 STA. 160+55.12



PID NO. **90127**
 R/W DESIGNER: JAE
 R/W REVIEWER: MJP

PROPERTY MAP


W00-51-0.42 / 1.78 / 2.16 / 3.03
 6 / 12

STRUCTURE KEY

- RESIDENTIAL
- COMMERCIAL
- OUT-BUILDING

REV. BY	DATE	DESCRIPTION

DATE COMPLETED JANUARY 08, 2013

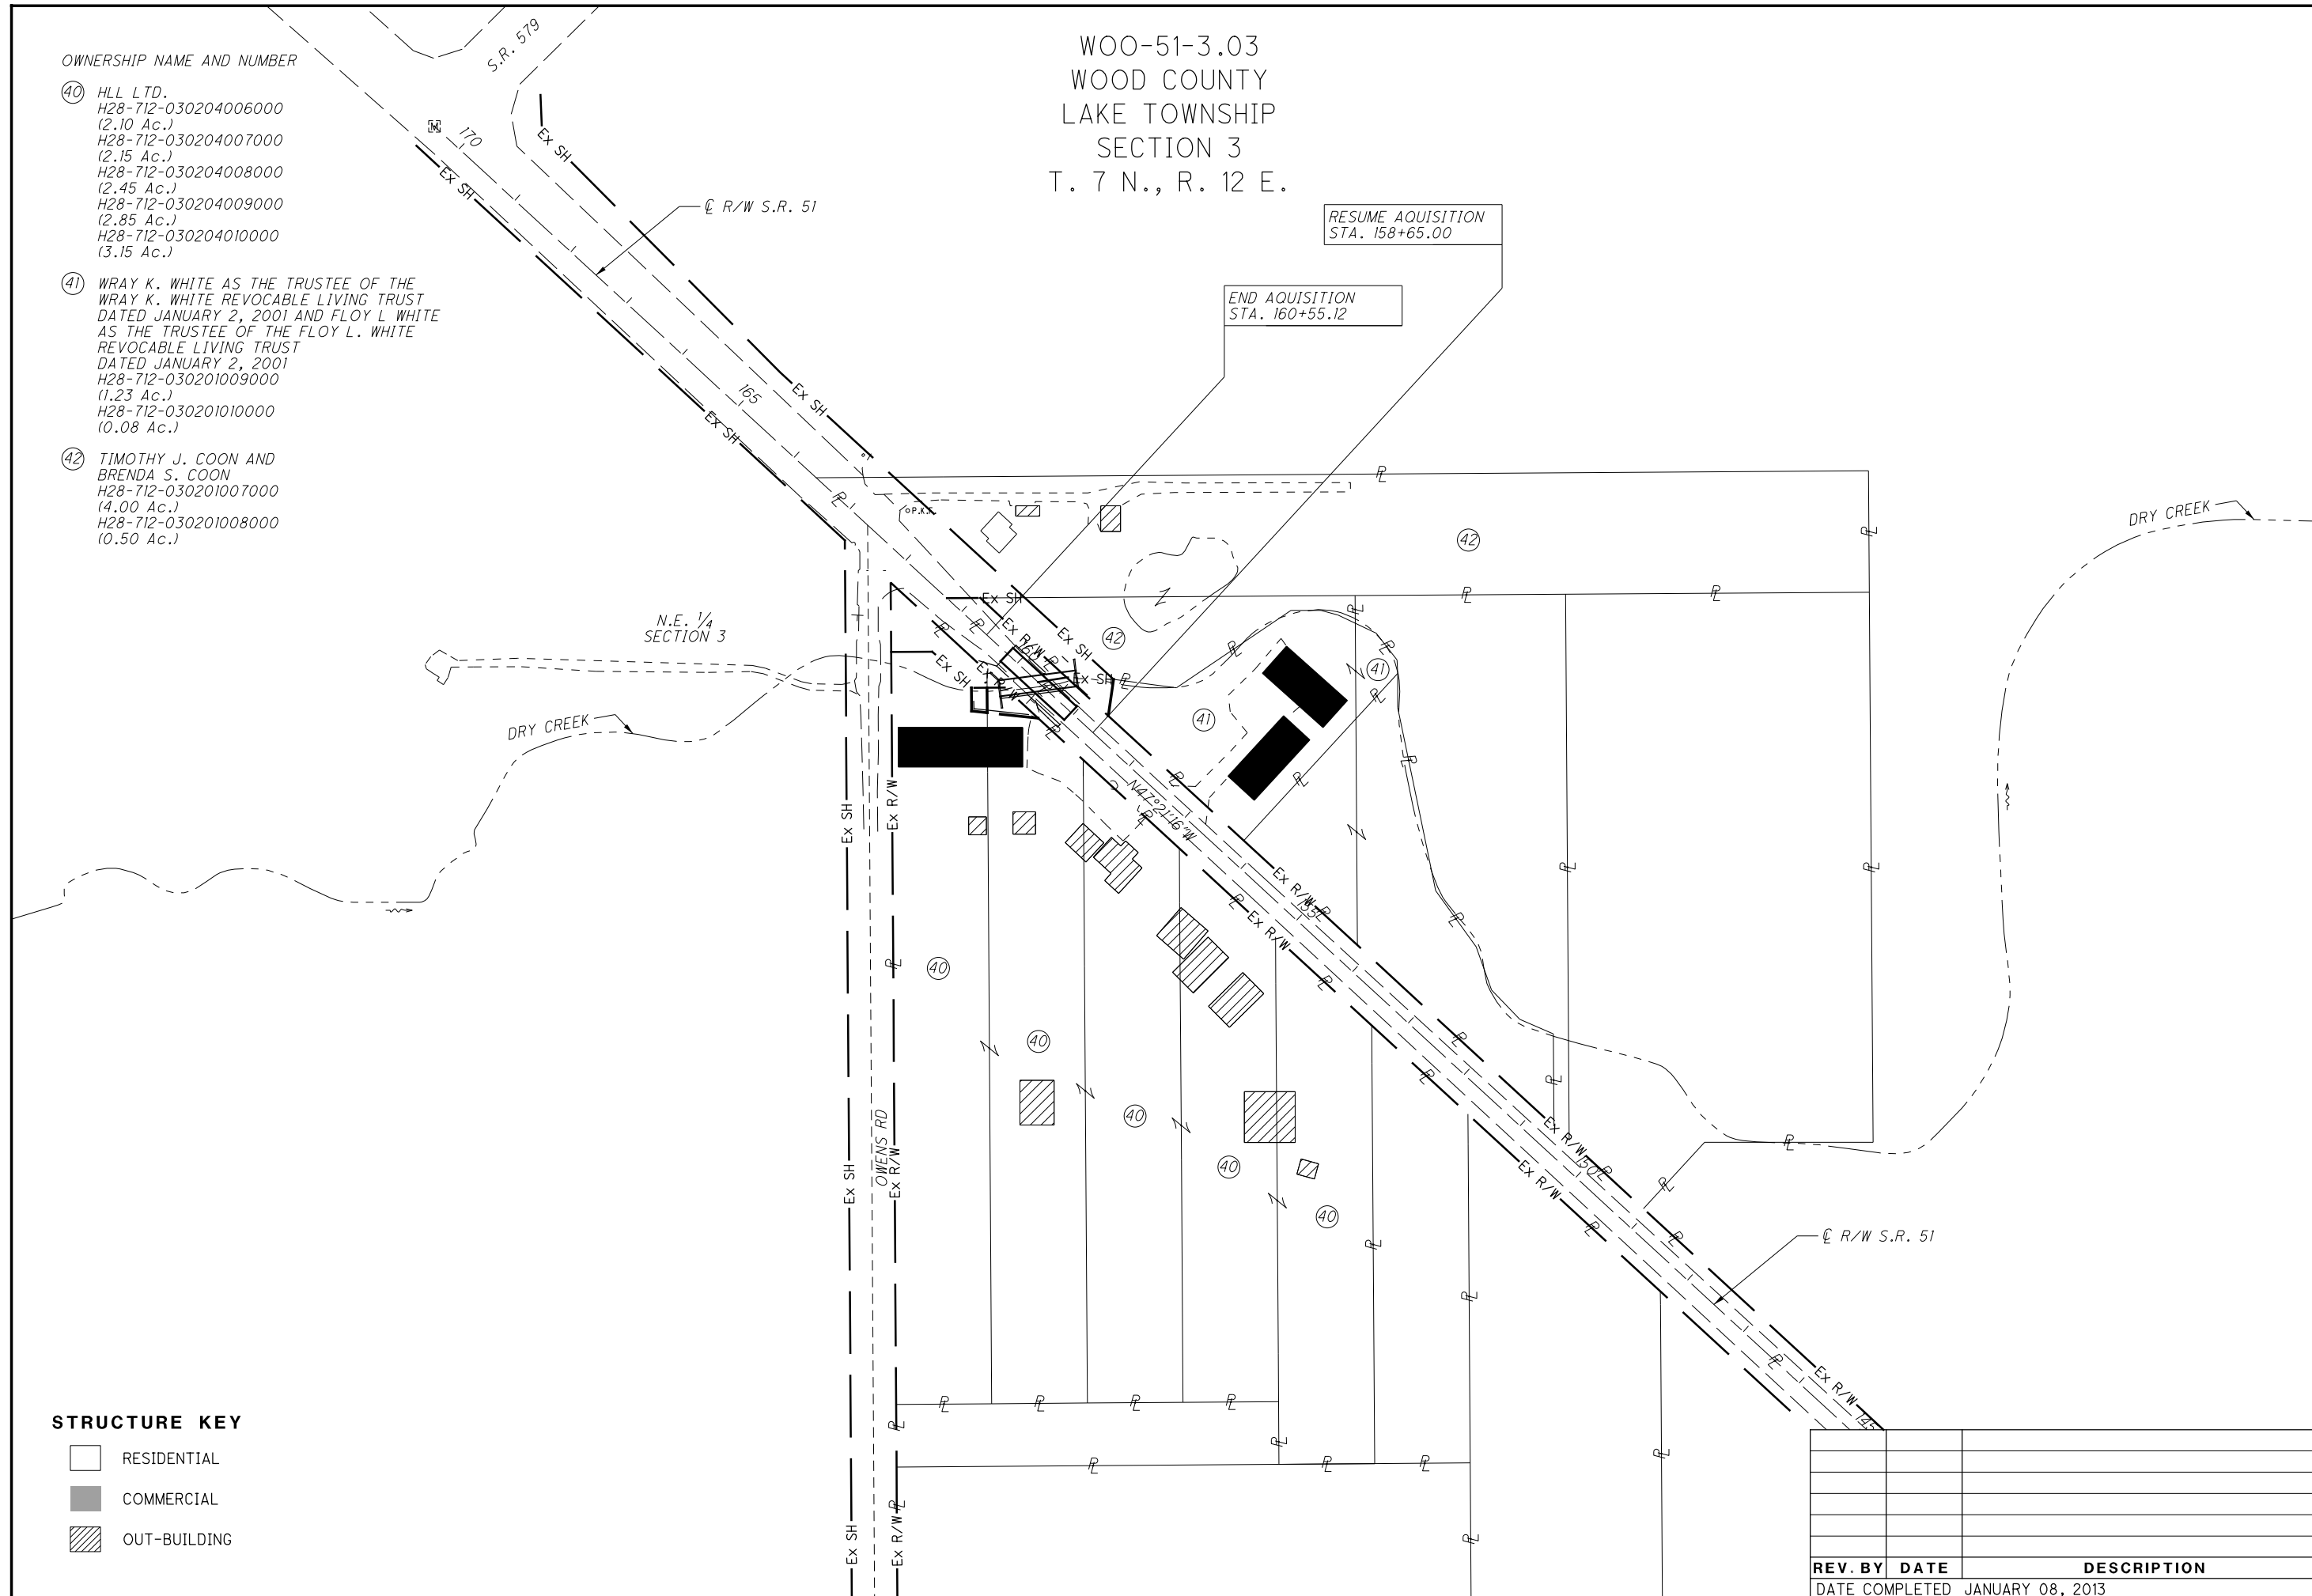

TOTAL NUMBER OF

6 OWNERSHIPS 0 TOTAL TAKES
 14 PARCELS 0 OWNERSHIPS W/ STRUCTURES INVOLVED

GROSS TAKE - PRO IN TAKE = NET TAKE
 RECORD AREA - TOTAL PRO - NET TAKE = NET RESIDUE

ALL AREAS IN ACRES

PARCEL NO.	OWNER	SHEET NO.	OWNERS BOOK	RECORD PAGE	AUDITOR'S PARCEL	RECORD AREA	TOTAL P.R.O.	GROSS TAKE	P.R.O. IN TAKE	NET TAKE	STRUC-TURE	NET RESIDUE		TYPE FUND	REMARKS	AS ACQUIRED	
												LEFT	RIGHT			BOOK	PAGE
1-9	NOT USED																
	WOO-51-0.42																
10-SH	THOMAS W. SWARTZ AND	9	689	281	H28-712-130201005000	23.57	2.097	0.176	0.124	0.052			21.421	STATE		OR 3273	313
10-CH	BRENDA H. SWARTZ	9					0.000	0.021	0.000	0.021						OR 3273	313
					H30-712-130201004000	0.510	0.287						0.223		NO TAKE		
					H28-712-130201001000	2.970	0.248						2.722		NO TAKE		
	TOTAL					27.050	2.632						24.366				
11	GARRETT J. BROWN	9	OR 2960	950	H28-712-130202026000	1.050	0.096								NO TAKE		
12-SH	MARILYN H. CLAPSADDLE	9	OR 2523	1072	H28-712-130202028000	1.020	0.101	0.099	0.079	0.020		0.899				OR 3279	628
12-CH		9	OR 2523	1072	H28-712-130202027000	1.100	0.089	0.011	0.000	0.011					NO TAKE	OR 3279	628
	TOTAL					2.120	0.190						1.910				
13-SH	LIVORIO SANDOVAL, SR. AND	9	OR 2510	594	H28-712-130202001000	4.020	0.285	0.088	0.075	0.013		3.722				OR 3275	507
13-CH	MARGUERITE SANDOVAL	9	OR 3067	352	H28-712-120000044000	4.980	0.471	0.012	0.000	0.012					NO TAKE	OR 3275	507
	TOTAL					9.000	0.756						8.231				
14	NEW SPORTSMAN CLUB	9	732	289	H28-712-120000041500	10.350	0.240								NO TAKE		
15	JOHN M. MEADOWS AND	9	687	963	H28-712-120000047000	0.600	0.049						0.551		NO TAKE		
	LONNA M. MEADOWS	9	687	963	H28-712-120000046000	2.210	0.261						1.949				
						2.810	0.310						2.500				
16-19	NOT USED																
	WOO-51-1.78																
20-SH	JEFFERY E. MENTER AND	10	OR 2688	678	H28-712-110201023000	0.928	0.000	0.023	0.000	0.023			0.905			OR 3283	139
20-CH	ANN MENTER	10	OR 2688	678	H28-712-110201024000	1.136	0.000	0.007	0.000	0.007					NO TAKE	OR 3283	139
		10	OR 2688	633	H28-712-110201025000	1.194	0.000						1.136		NO TAKE		
	TOTAL					3.258	0.000						3.235				
21A-SH	C. R. FAILOR COMPANY, L.L.C	10	OR 2729	423	H28-712-110203029500	3.040	0.032	0.038	0.032	0.006		3.002			149 SQ FT OVERLAP EXISTING CHANNEL EASEMENT	OR 3504	776
21A-CH							0.000	0.013	0.006	0.007					CH-PRO IN TAKE REFERS TO EXISTING CH EASMENT	OR 3504	776
21A-SH1		10	OR 2751	51	H28-712-110203028000	1.470	0.250	0.105	0.100	0.005		1.215			217 SQ FT OVERLAP EXISTING CHANNEL EASEMENT	OR 3504	776
21A-CHI							0.000	0.010	0.008	0.002					CH-PRO IN TAKE REFERS TO EXISTING CH EASMENT	OR 3504	776
	TOTAL					4.510	0.282						4.217				
22-SH	RAY L. ECHELBARGER AND	10	630	445	H28-712-110201022000	0.840	0.000	0.035	0.000	0.035			0.805			OR 3277	99
22-CH	JOANNE ECHELBARGER						0.000	0.013	0.000	0.013				STATE		OR 3277	99

FEDERAL PROJECT NO. E110178
 PID NO. 90127
 STATE JOB NO. 427119
 R/W DESIGNER JAE
 R/W REVIEWER MJP
 SUMMARY OF ADDITIONAL RIGHT OF WAY
 WOO-51-0.42 / 1.78 / 2.16 / 3.03
 7 / 12

OR = OFFICIAL RECORD
 LEGEND:
 SH = STANDARD HIGHWAY EASEMENT
 CH = CHANNEL EASEMENT

GRANTEE:
 ALL RIGHT OF WAY ACQUISITION IN THE NAME OF
 THE STATE OF OHIO DEPARTMENT OF TRANSPORTATION
 UNLESS OTHERWISE SHOWN.

REV. BY	DATE	DESCRIPTION
MJP	12/09/16	ADDED "A" TO PARCEL NUMBERS ON 21
MJP	09/30/16	CHANGED BY ADDING AREA TO 21SH, 21CH, 21SH1 & 21CHI TO ACCOMODATE AS-BUILT LOCATION
FIELD REVIEW BY Matt Puhl & Fred Weiss DATE: 01/08/2013		
OWNERSHIP VERIFIED BY Matt Puhl DATE: 01/03/2013		
DATE COMPLETED JANUARY 08, 2013		

TOTAL NUMBER OF

6 OWNERSHIPS 0 TOTAL TAKES
11 PARCELS 0 OWNERSHIPS W/ STRUCTURES INVOLVED

GROSS TAKE - PRO IN TAKE = NET TAKE
RECORD AREA - TOTAL PRO - NET TAKE = NET RESIDUE

ALL AREAS IN ACRES

PARCEL NO.	OWNER	SHEET NO.	OWNERS BOOK	RECORD PAGE	AUDITOR'S PARCEL	RECORD AREA	TOTAL P.R.O.	GROSS TAKE	P.R.O. IN TAKE	NET TAKE	STRUC-TURE	NET RESIDUE		TYPE FUND	REMARKS	AS ACQUIRED	
												LEFT	RIGHT			BOOK	PAGE
23-29	NOT USED																
	WOO-51-2.16																
30-SH	BLACKTOP DRIVEWAYS	11	747	765	H28-712-020301011000	4.260	0.190	0.067	0.045	0.022			4.048	STATE		OR 3280	426
30A-CH							0.000	0.014	0.008	0.006					CH-PRO IN TAKE REFERS TO EXISTING CH EASMENT	OR 3513	104
31-SH	GARY F. DIEKMAN AND JUDY A. DIEKMAN,	11	741	439	H28-712-020307028000	0.871	0.000	0.021	0.000	0.021			0.850			OR 3286	381
31-CH	TRUSTEES OF THE DIEKMAN TRUST, DATED JUNE 1, 1998	11	741	437	H28-712-020307021000	0.534	0.000	0.011	0.000	0.011					NO TAKE	OR 3286	381
	TOTAL					1.405	0.000						1.384				
32A-SH	TOM WOJO, LLC	11	OR 2739	7	H28-712-020301008501	0.530	0.134	0.079	0.074	0.005			0.391		148 SQ FT OVERLAP EXISTING CHANNEL EASEMENT	OR 3510	857
32A-CH							0.000	0.014	0.005	0.009					CH-PRO IN TAKE REFERS TO EXISTING CH EASMENT	OR 3510	857
33-SH	MILLARD DEVELOPMENT	11	748	550	H28-712-020307029000	8.450	0.326	0.106	0.075	0.031			8.093			OR 3293	1062
33-CH		11	748	550	H28-712-020307030000	1.000	0.000	0.012	0.000	0.012			0.891		NO TAKE	OR 3293	1062
		11	748	550	H28-712-020307031000	0.630	0.022						0.608		NO TAKE		
	TOTAL					10.080	0.454						9.592				
34-39	NOT USED																
	WOO-51-3.03																
40-SH	HLL LTD.	12	725	724	H28-712-030204009000	2.850	0.006	0.042	0.006	0.036			2.808			OR 3356	581
40-CH		12	725	724	H28-712-030204010000	3.150	0.146	0.015	0.000	0.015			3.004		NET TAKE IS FOR CHANNEL EASEMENT AND NOT USED TO CALCULATE NET RESIDUE	OR 3356	581
		12	725	708	H28-712-030204006000	2.100	0.000						2.100		NO TAKE		
		12	725	724	H28-712-030204007000	2.150	0.000						2.150		NO TAKE		
		12	725	724	H28-712-030204008000	2.450	0.000						2.450		NO TAKE		
	TOTAL					12.700	0.152						12.512				
41-SH	WRAY K. WHITE AS THE TRUSTEE OF THE WRAY K. WHITE REVOCABLE LIVING TRUST DATED JANUARY 2, 2001 AND FLOY L WHITE AS THE TRUSTEE OF THE FLOY L. WHITE REVOCABLE LIVING TRUST DATED JANUARY 2, 2001	12	OR 2184	202	H28-712-030201009000	1.230	0.000	0.034	0.000	0.034			1.196			OR 3300	438
		12	OR 2184	202	H28-712-030201010000	0.080	0.000						0.080		NO TAKE		
						1.310	0.000						1.276	STATE			
42	TIMOTHY J. COON AND BRENDA S. COON	12	736	782	H28-712-030201007000	4.000	0.377								NO TAKE		
42		12	736	782	H28-712-030201008000	0.500	0.253								NO TAKE		

OR = OFFICIAL RECORD

LEGEND:
SH = STANDARD HIGHWAY EASEMENT
CH = CHANNEL EASEMENT

GRANTEE:
ALL RIGHT OF WAY ACQUISITION IN THE NAME OF
THE STATE OF OHIO DEPARTMENT OF TRANSPORTATION
UNLESS OTHERWISE SHOWN.

REV. BY	DATE	DESCRIPTION
MJP	12/09/16	ADDED "A" TO PARCEL NUMBERS ON 30 & 32
MJP	09/30/16	CHANGED BY ADDING AREA TO 30CH, 32SH & 32CH TO ACCOMODATE AS-BUILT LOCATION
FIELD REVIEW BY Matt Puhl & Fred Weiss DATE: 01/08/2013		
OWNERSHIP VERIFIED BY Matt Puhl DATE: 01-03-2013		
DATE COMPLETED JANUARY 08, 2013		

FEDERAL PROJECT NO. E110178
 PID NO. 90127
 STATE JOB NO. 427119
 R/W DESIGNER JAE
 R/W REVIEWER MJP
SUMMARY OF ADDITIONAL RIGHT OF WAY
 WOO-51-0.42 / 1.78 / 2.16 / 3.03
 8 / 12
 69
 73

WOO-51-0.42
 WOOD COUNTY
 LAKE TOWNSHIP
 SE 1/4 SECTION 12 & NE 1/4 SECTION 13
 T. 7 N., R. 12 E.




PID NO.
90127

R/W DESIGNER
 JAE
 R/W REVIEWER
 MJP

RIGHT OF WAY PLAN
STA. 19+40 TO STA. 24+90

WOO-51-0.42 / 1.78 / 2.16 / 3.03

9 / 12

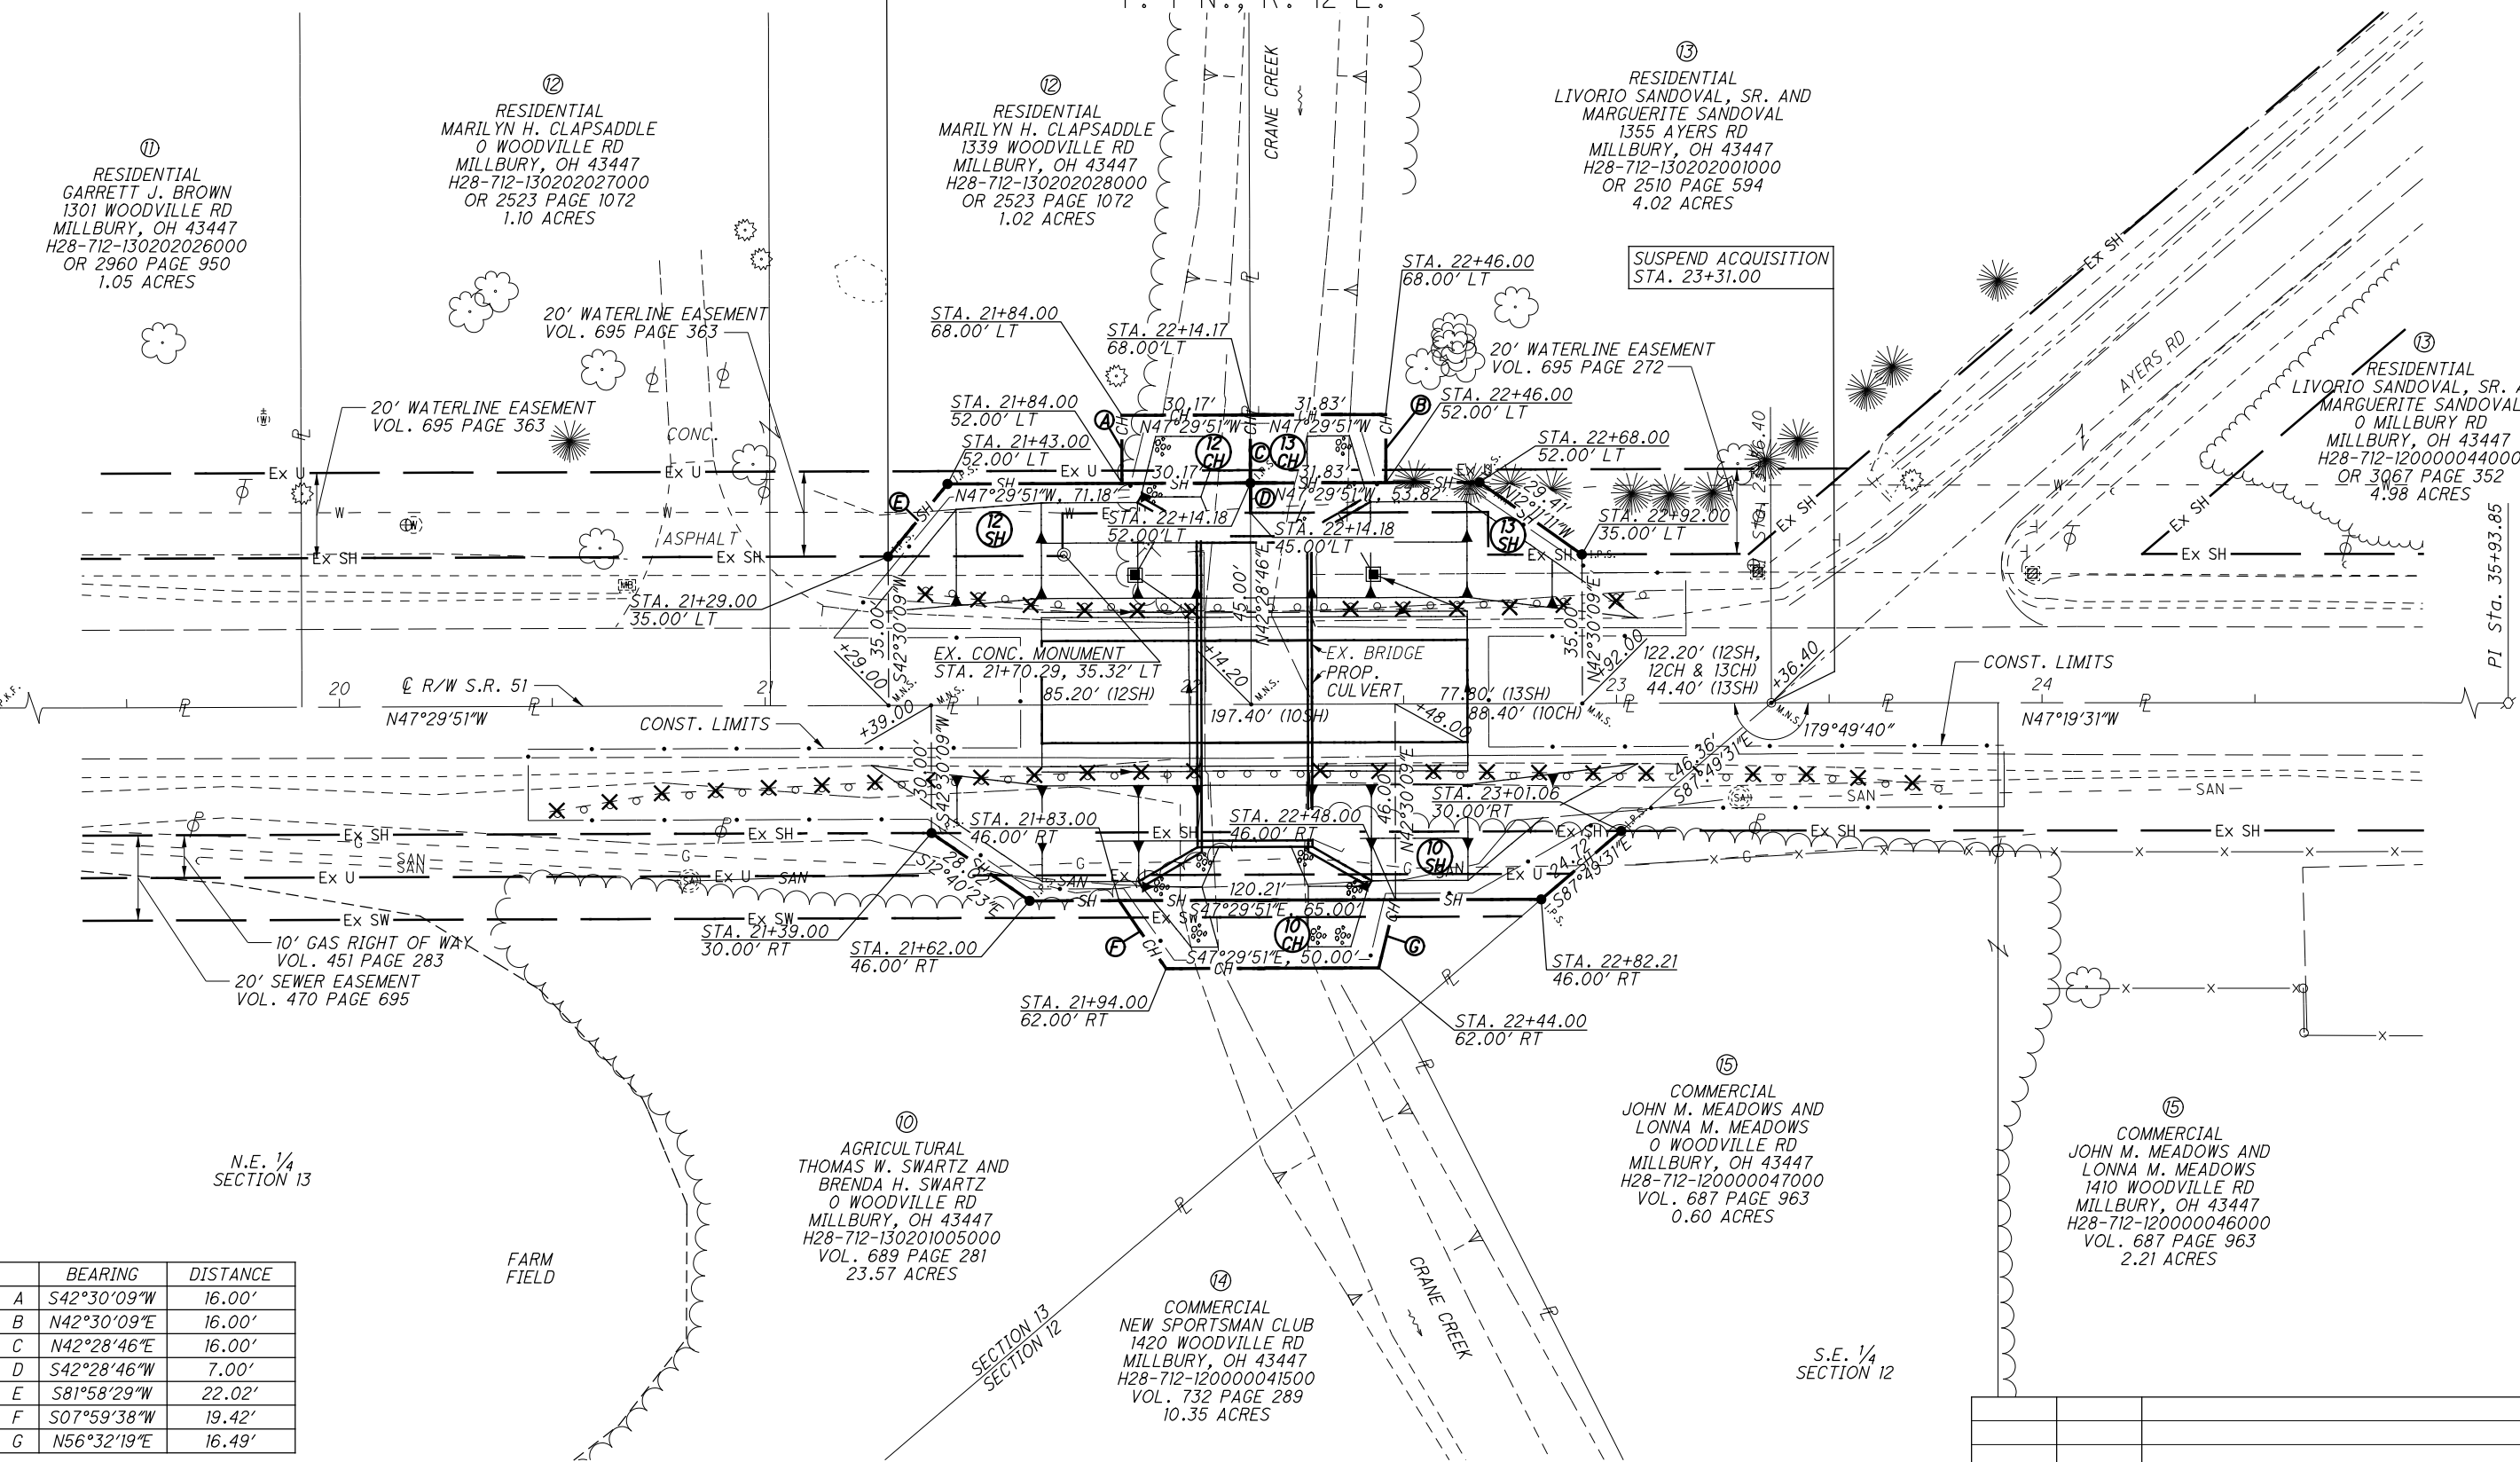

	BEARING	DISTANCE
A	S42°30'09"W	16.00'
B	N42°30'09"E	16.00'
C	N42°28'46"E	16.00'
D	S42°28'46"W	7.00'
E	S81°58'29"W	22.02'
F	S07°59'38"W	19.42'
G	N56°32'19"E	16.49'


REV. BY	DATE	DESCRIPTION

DATE COMPLETED JANUARY 08, 2013

WOO-51-1.78
WOOD COUNTY
LAKE TOWNSHIP
N.E. 1/4 SECTION 11
T. 7 N., R. 12 E.

PARCEL NO.	TAKE	AREA OF OVERLAP		
		EX CHANNEL EASEMENT	EX STANDARD HIGHWAY EASEMENT	EX UTILITY EASEMENT
21SH	1661	149	1382	385
21SHI	4554	217	4337	381
21CH	551	264		
21CHI	454	331		

NOTE: ALL AREAS IN SQUARE FEET

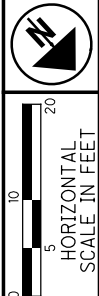

PID NO. 90127


R/W DESIGNER JAE
R/W REVIEWER MJP

RIGHT OF WAY PLAN
STA. 92+23 TO STA. 94+98

WOO-51-0.42 / 1.78 / 2.16 / 3.03

10 / 12

71
73

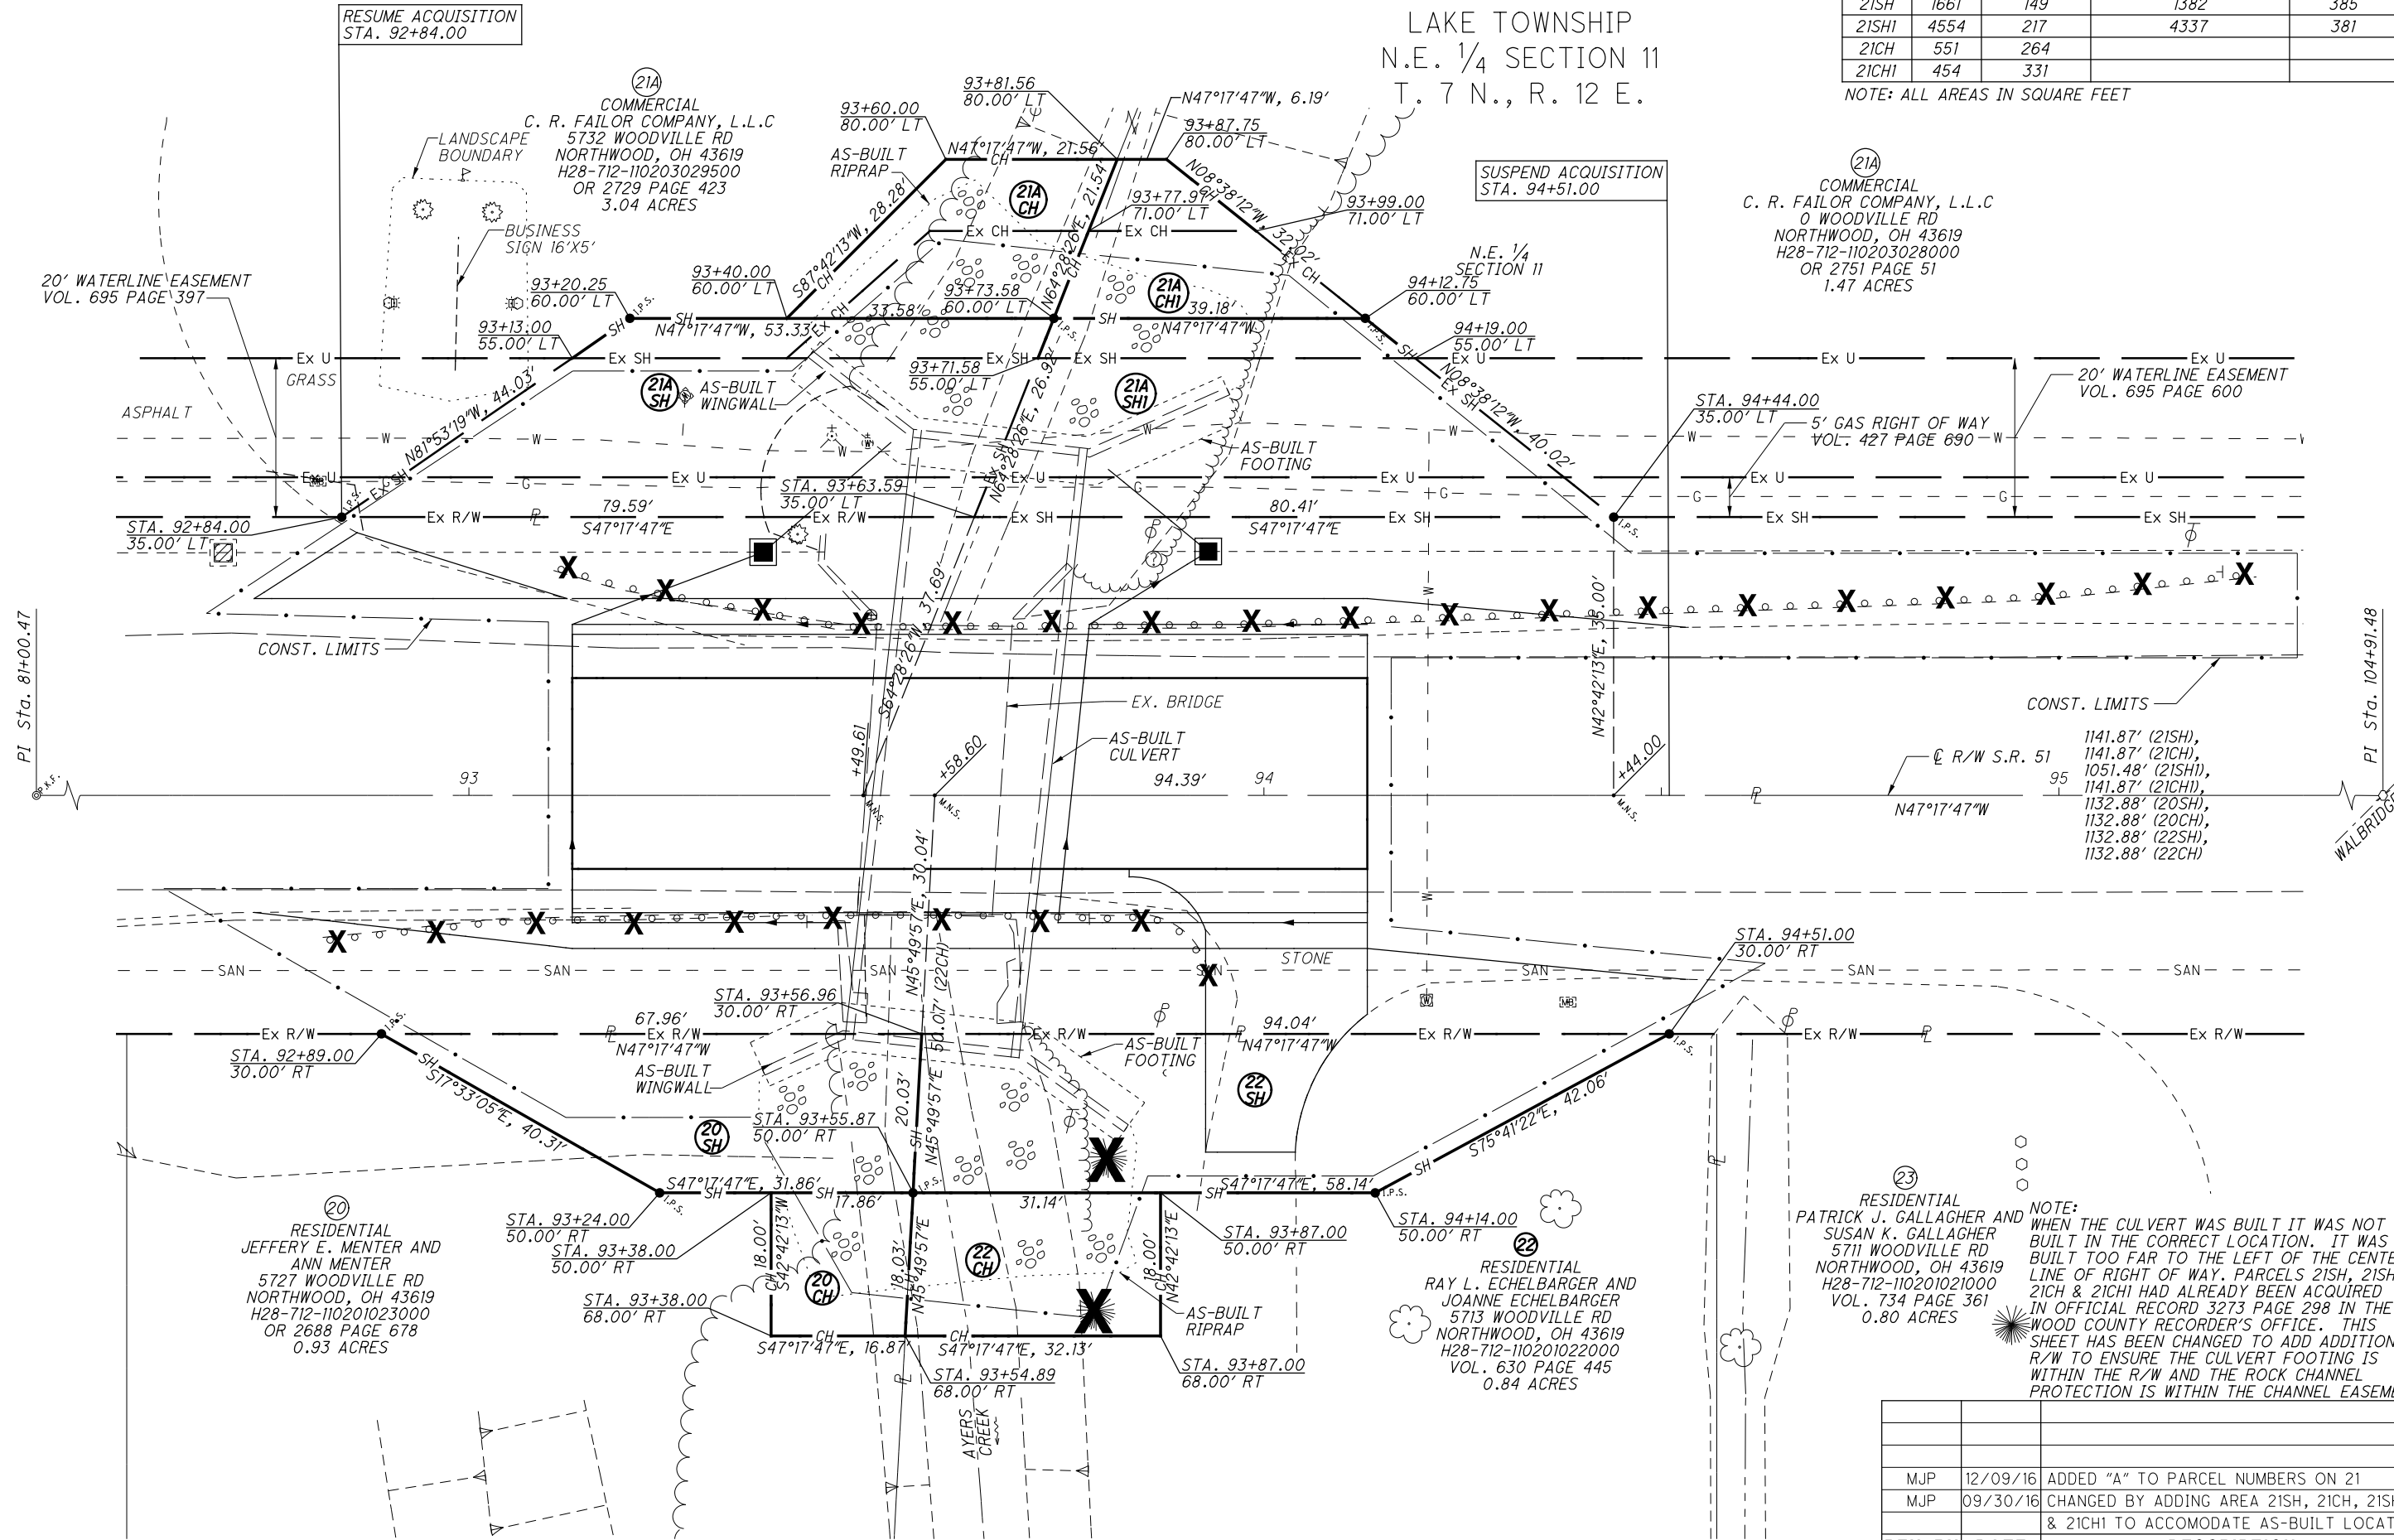

RESUME ACQUISITION
STA. 92+84.00

SUSPEND ACQUISITION
STA. 94+51.00

21A
COMMERCIAL
C. R. FAILOR COMPANY, L.L.C
0 WOODVILLE RD
NORTHWOOD, OH 43619
H28-712-110203028000
OR 2751 PAGE 51
1.47 ACRES

20
RESIDENTIAL
JEFFERY E. MENTER AND
ANN MENTER
5727 WOODVILLE RD
NORTHWOOD, OH 43619
H28-712-110201023000
OR 2688 PAGE 678
0.93 ACRES

22
RESIDENTIAL
RAY L. ECHELBARGER AND
JOANNE ECHELBARGER
5713 WOODVILLE RD
NORTHWOOD, OH 43619
H28-712-110201022000
VOL. 630 PAGE 445
0.84 ACRES

23
RESIDENTIAL
PATRICK J. GALLAGHER AND
SUSAN K. GALLAGHER
5711 WOODVILLE RD
NORTHWOOD, OH 43619
H28-712-110201021000
VOL. 734 PAGE 361
0.80 ACRES

NOTE:
WHEN THE CULVERT WAS BUILT IT WAS NOT
BUILT IN THE CORRECT LOCATION. IT WAS
BUILT TOO FAR TO THE LEFT OF THE CENTER-
LINE OF RIGHT OF WAY. PARCELS 21SH, 21SHI
& 21CHI HAD ALREADY BEEN ACQUIRED
IN OFFICIAL RECORD 3273 PAGE 298 IN THE
WOOD COUNTY RECORDER'S OFFICE. THIS
SHEET HAS BEEN CHANGED TO ADD ADDITIONAL
R/W TO ENSURE THE CULVERT FOOTING IS
WITHIN THE R/W AND THE ROCK CHANNEL
PROTECTION IS WITHIN THE CHANNEL EASEMENT

REV. BY	DATE	DESCRIPTION
MJP	12/09/16	ADDED "A" TO PARCEL NUMBERS ON 21
MJP	09/30/16	CHANGED BY ADDING AREA 21SH, 21SHI & 21CHI TO ACCOMODATE AS-BUILT LOCATION
		DATE COMPLETED JANUARY 08, 2013

WOO-51-2.16
WOOD COUNTY
LAKE TOWNSHIP
S.W. 1/4 SECTION 2
T. 7 N., R. 12 E.

S.W. 1/4
SECTION 2

NOTE:
WHEN THE CULVERT WAS BUILT IT WAS NOT
BUILT IN THE CORRECT LOCATION. IT WAS
BUILT TOO FAR TO THE RIGHT OF THE CENTER-
LINE OF RIGHT OF WAY. PARCEL 30CH HAD
ALREADY BEEN ACQUIRED IN OFFICIAL RECORD
3280 PAGE 298 AND PARCELS 32SH & 32CH
HAD ALREADY BEEN ACQUIRED IN OFFICIAL
RECORD 3289 PAGE 948 IN THE WOOD COUNTY
RECORDER'S OFFICE. THIS SHEET HAS BEEN
CHANGED TO ADD ADDITIONAL R/W TO ENSURE
THE CULVERT FOOTING IS WITHIN THE R/W
AND THE ROCK CHANNEL PROTECTION IS
WITHIN THE CHANNEL EASEMENT




31
COMMERCIAL
GARY F. DIEKMAN AND
JUDY A. DIEKMAN, TRUSTEES
OF THE DIEKMAN TRUST,
DATED JUNE 1, 1998
5526 WOODVILLE RD
NORTHWOOD, OH 43619
H28-712-020307028000
VOL. 741 PAGE 439
0.87 ACRES

33
RESIDENTIAL
MILLARD DEVELOPMENT
5434 WOODVILLE RD
NORTHWOOD, OH 43619
H28-712-020307029000
VOL. 748 PAGE 550
8.450 ACRES

RESUME ACQUISITION
STA. 112+78.00

SUSPEND ACQUISITION
STA. 114+42.00

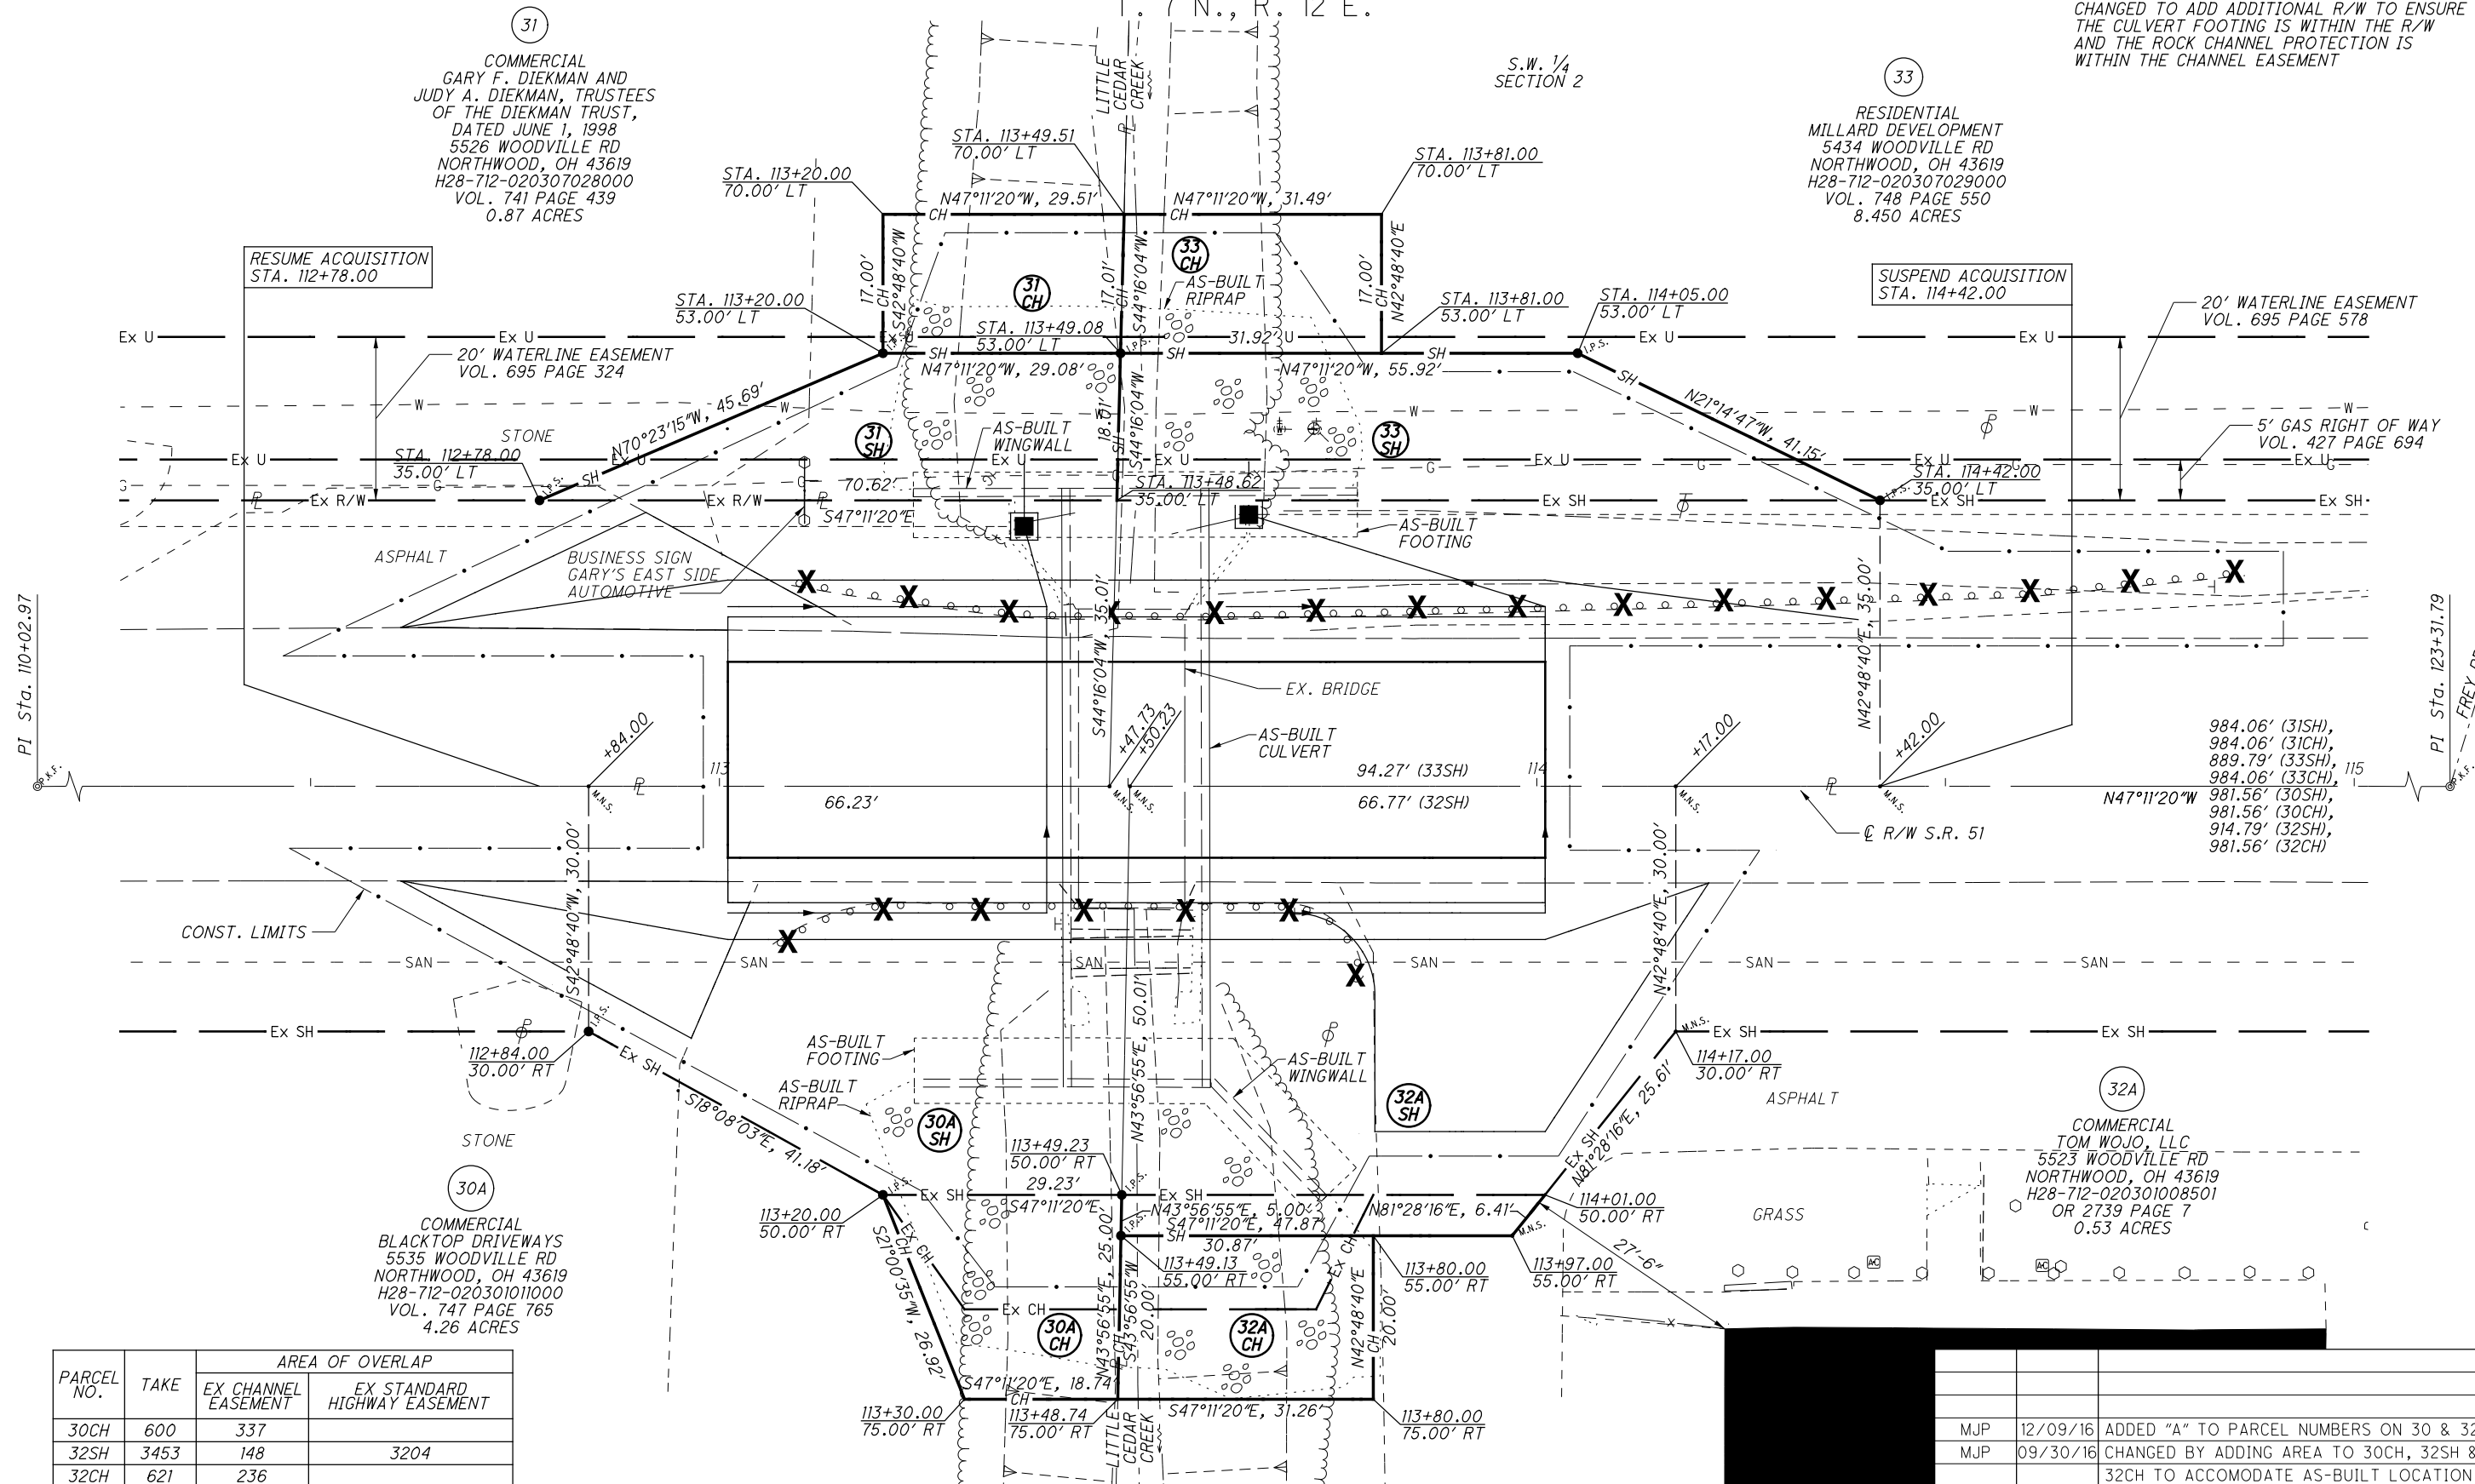

984.06' (31SH),
984.06' (31CH),
889.79' (33SH),
984.06' (33CH),
981.56' (30SH),
981.56' (30CH),
914.79' (32SH),
981.56' (32CH)

30A
COMMERCIAL
BLACKTOP DRIVEWAYS
5535 WOODVILLE RD
NORTHWOOD, OH 43619
H28-712-020301011000
VOL. 747 PAGE 765
4.26 ACRES

32A
COMMERCIAL
TOM WOJO, LLC
5523 WOODVILLE RD
NORTHWOOD, OH 43619
H28-712-020301008501
OR 2739 PAGE 7
0.53 ACRES

PARCEL NO.	TAKE	AREA OF OVERLAP	
		EX CHANNEL EASEMENT	EX STANDARD HIGHWAY EASEMENT
30CH	600	337	
32SH	3453	148	3204
32CH	621	236	

NOTE: ALL AREAS IN SQUARE FEET

PID NO.
90127

R/W DESIGNER
JAE

R/W REVIEWER
MJP

RIGHT OF WAY PLAN
STA. 112+26 TO STA. 115+02

WOO-51-0.42 / 1.78 / 2.16 / 3.03

REV. BY	DATE	DESCRIPTION
MJP	12/09/16	ADDED "A" TO PARCEL NUMBERS ON 30 & 32
MJP	09/30/16	CHANGED BY ADDING AREA TO 30CH, 32SH & 32CH TO ACCOMODATE AS-BUILT LOCATION
		DATE COMPLETED JANUARY 08, 2013

11 / 12

72

73

WOO-51-3.03
WOOD COUNTY
LAKE TOWNSHIP
N.E. 1/4 SECTION 3
T. 7 N., R. 12 E.




PID NO.
90127

R/W DESIGNER
JAE
R/W REVIEWER
MJP

RIGHT OF WAY PLAN
STA. 156+91 TO STA. 162+42

WOO-51-0.42 / 1.78 / 2.16 / 3.03

12 / 12

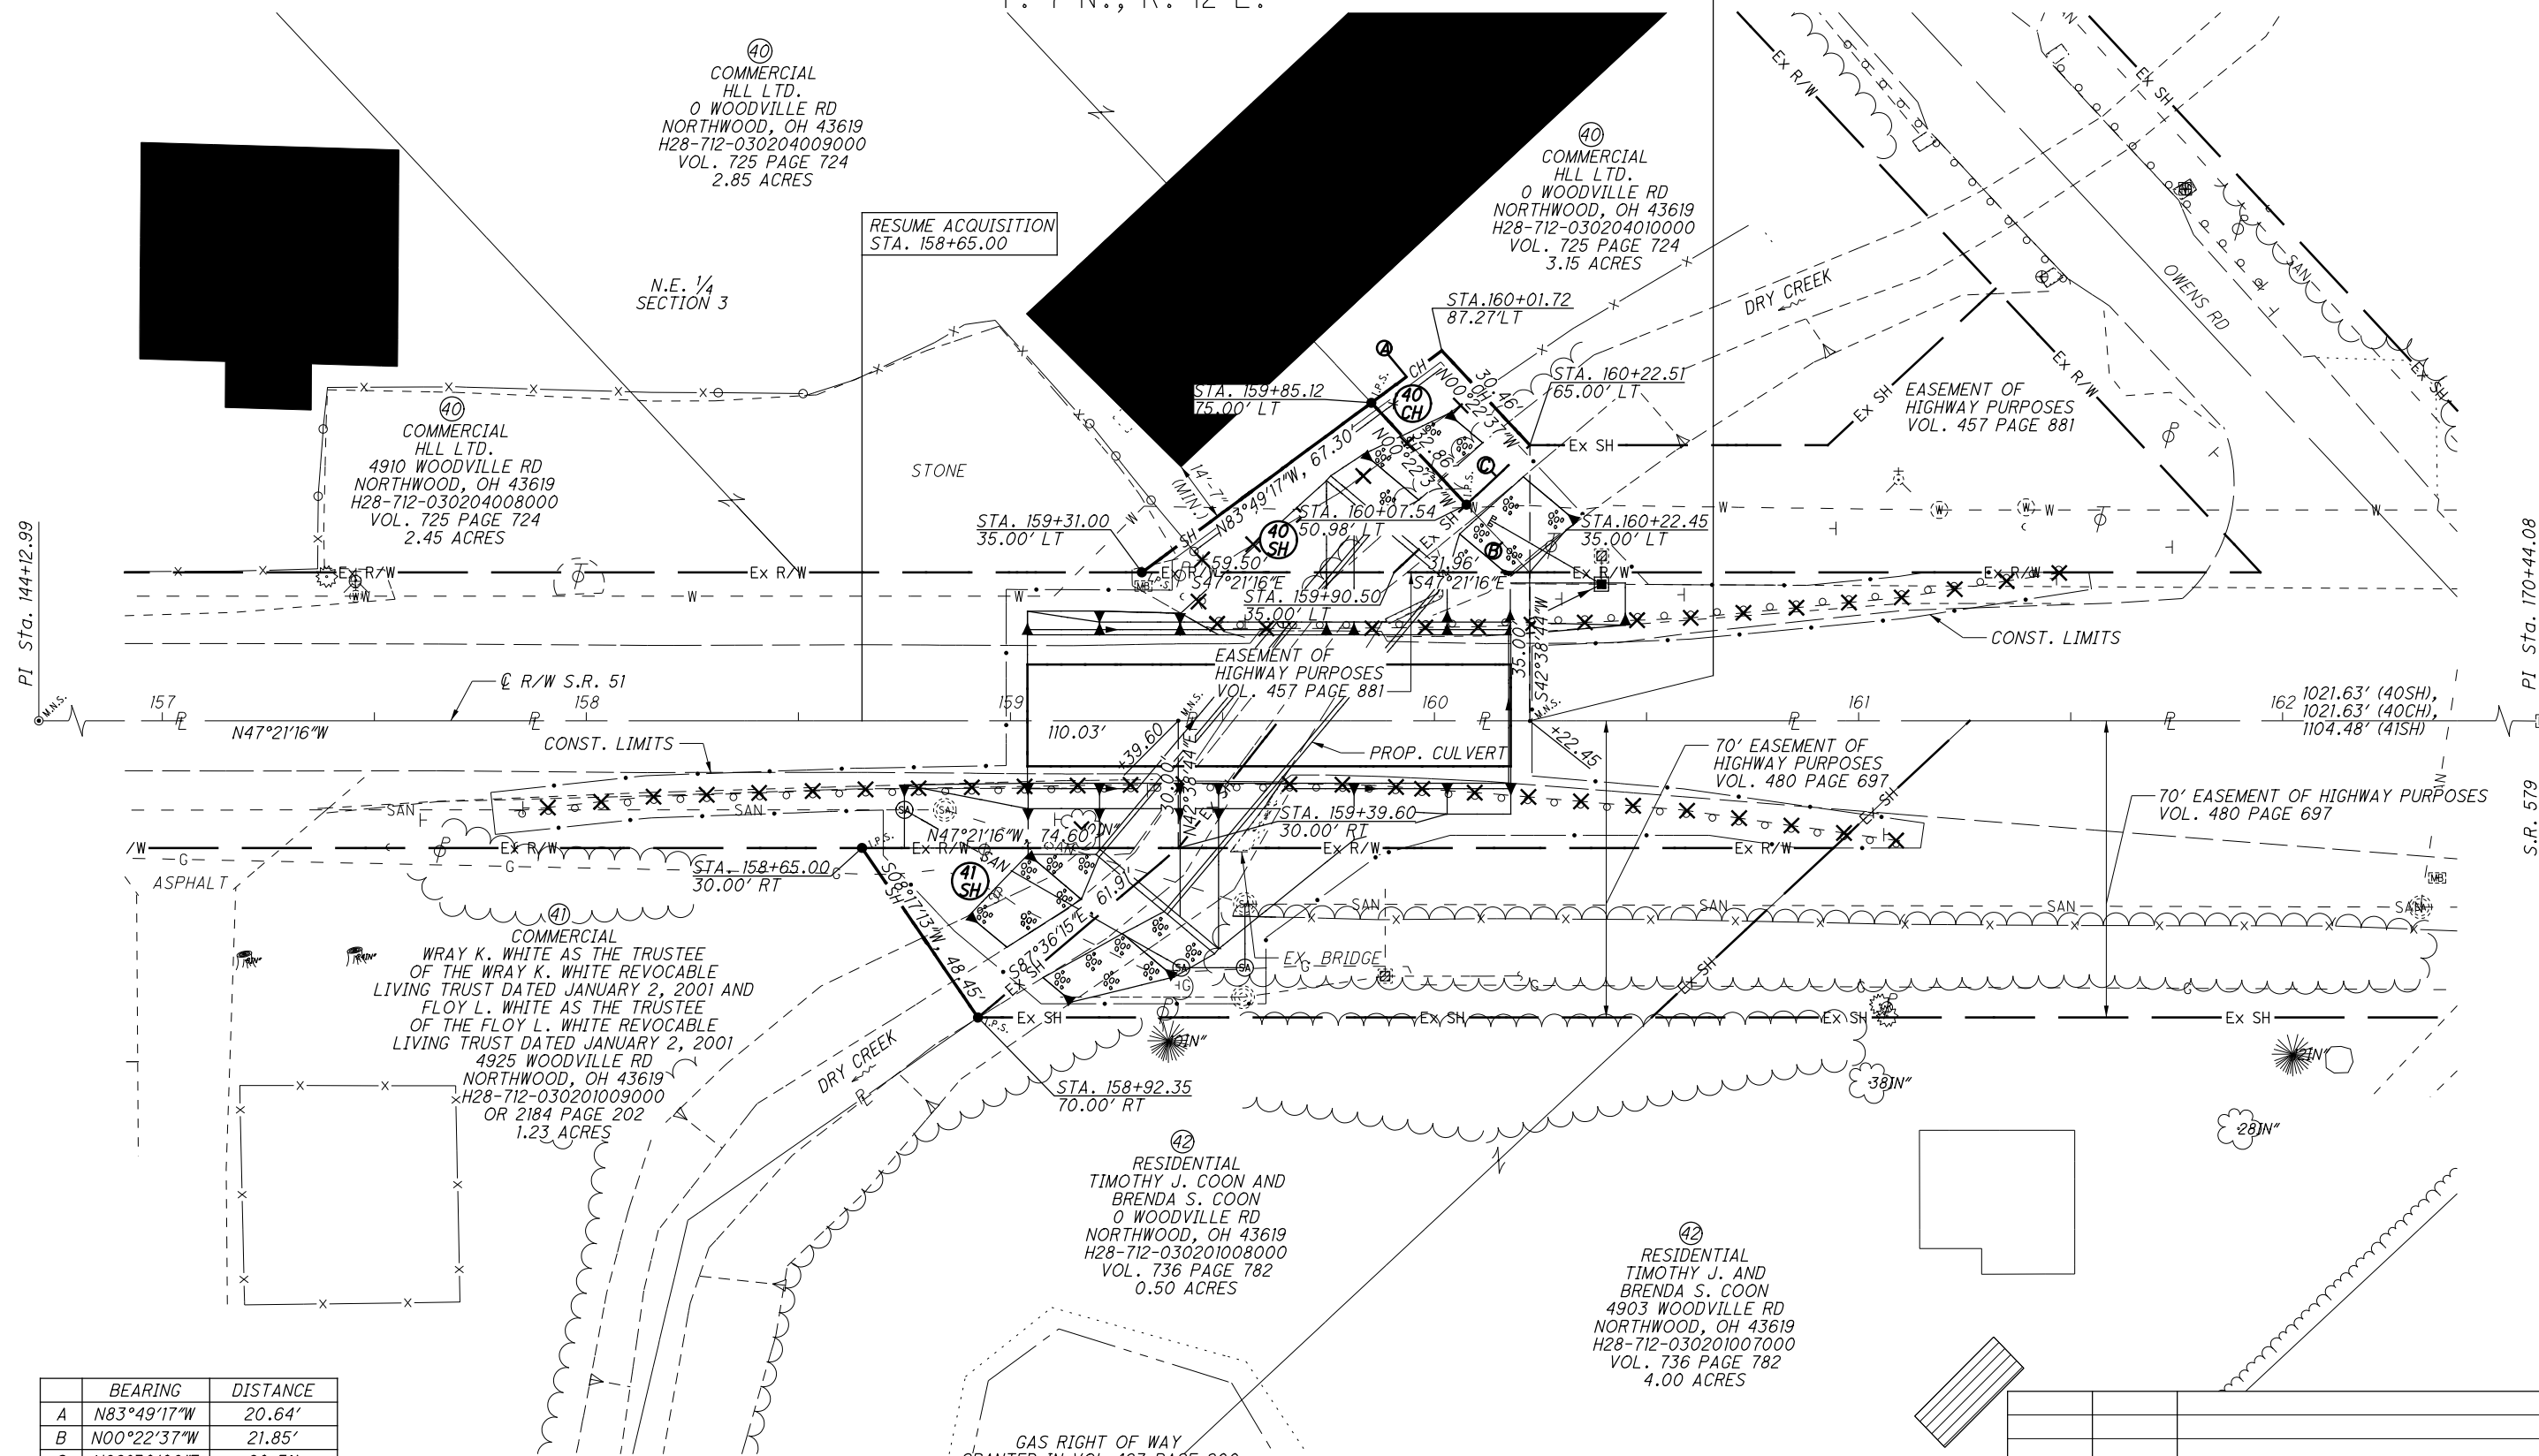

40
COMMERCIAL
HLL LTD.
4910 WOODVILLE RD
NORTHWOOD, OH 43619
H28-712-030204008000
VOL. 725 PAGE 724
2.45 ACRES

40
COMMERCIAL
HLL LTD.
0 WOODVILLE RD
NORTHWOOD, OH 43619
H28-712-030204009000
VOL. 725 PAGE 724
2.85 ACRES

40
COMMERCIAL
HLL LTD.
0 WOODVILLE RD
NORTHWOOD, OH 43619
H28-712-030204010000
VOL. 725 PAGE 724
3.15 ACRES

41
COMMERCIAL
WRAY K. WHITE AS THE TRUSTEE
OF THE WRAY K. WHITE REVOCABLE
LIVING TRUST DATED JANUARY 2, 2001 AND
FLOY L. WHITE AS THE TRUSTEE
OF THE FLOY L. WHITE REVOCABLE
LIVING TRUST DATED JANUARY 2, 2001
4925 WOODVILLE RD
NORTHWOOD, OH 43619
H28-712-030201009000
OR 2184 PAGE 202
1.23 ACRES

42
RESIDENTIAL
TIMOTHY J. COON AND
BRENDA S. COON
0 WOODVILLE RD
NORTHWOOD, OH 43619
H28-712-030201008000
VOL. 736 PAGE 782
0.50 ACRES

42
RESIDENTIAL
TIMOTHY J. AND
BRENDA S. COON
4903 WOODVILLE RD
NORTHWOOD, OH 43619
H28-712-030201007000
VOL. 736 PAGE 782
4.00 ACRES

GAS RIGHT OF WAY
GRANTED IN VOL 493 PAGE 900
OF THE WOOD COUNTY REDCORDER'S OFFICE
DESCRIBED "AS CLOSE AS PRACTICAL TO THE
NORTHERLY SIDE OF THE NORTH PROPOSED
R/W LINE OF STATE ROUTE #51" FOR PARCELS
41 AND 42

BEARING	DISTANCE
A N83°49'17"W	20.64'
B N00°22'37"W	21.85'
C N89°30'08"E	20.51'

REV. BY	DATE	DESCRIPTION

DATE COMPLETED JANUARY 08, 2013