


O.D.O.T. DISTRICT 2 SURVEY OFFICE (USE ONLY)


PERSONNEL _____ REFERENCE NO. 23 D SHEET 5 OF 30
 NOTES RHOADES DATE 4/20/16 ROUTE SR 51
 H.C. O'DONNELL WEATHER CLEAR COUNTY WOOD
 R.C. RHOADES TEMP. 50° TOWNSHIP LAKE
 _____ SECTION 12
 _____ T 7 N R 12 E

TYPE MONUMENT P.K.SHANK
 ON SURFACE - ~~BELOW~~ ON _____
~~LEFT~~ - Q PAV'T - RIGHT 2.5'
9.4' TO RT EDGE PAVEMENT
 S.L.M. 38+46

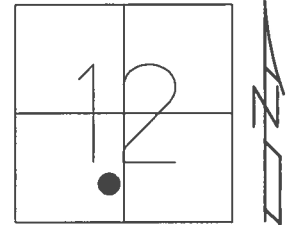

GRID: NORTHING: 696904.231 EASTING: 1715209.633

RECORD: 1971
 STA. 188+47.18
 FD SM.R.R.SPIKE
 5/20/02, MB
 SET P.K./WASHER
 8/13/02, MB
 FD P.K.SHANK
 REFD23
 4/20/16, JFO
 SET MAG/WASHER
 NEWREFD23
 8/14/17, JFO

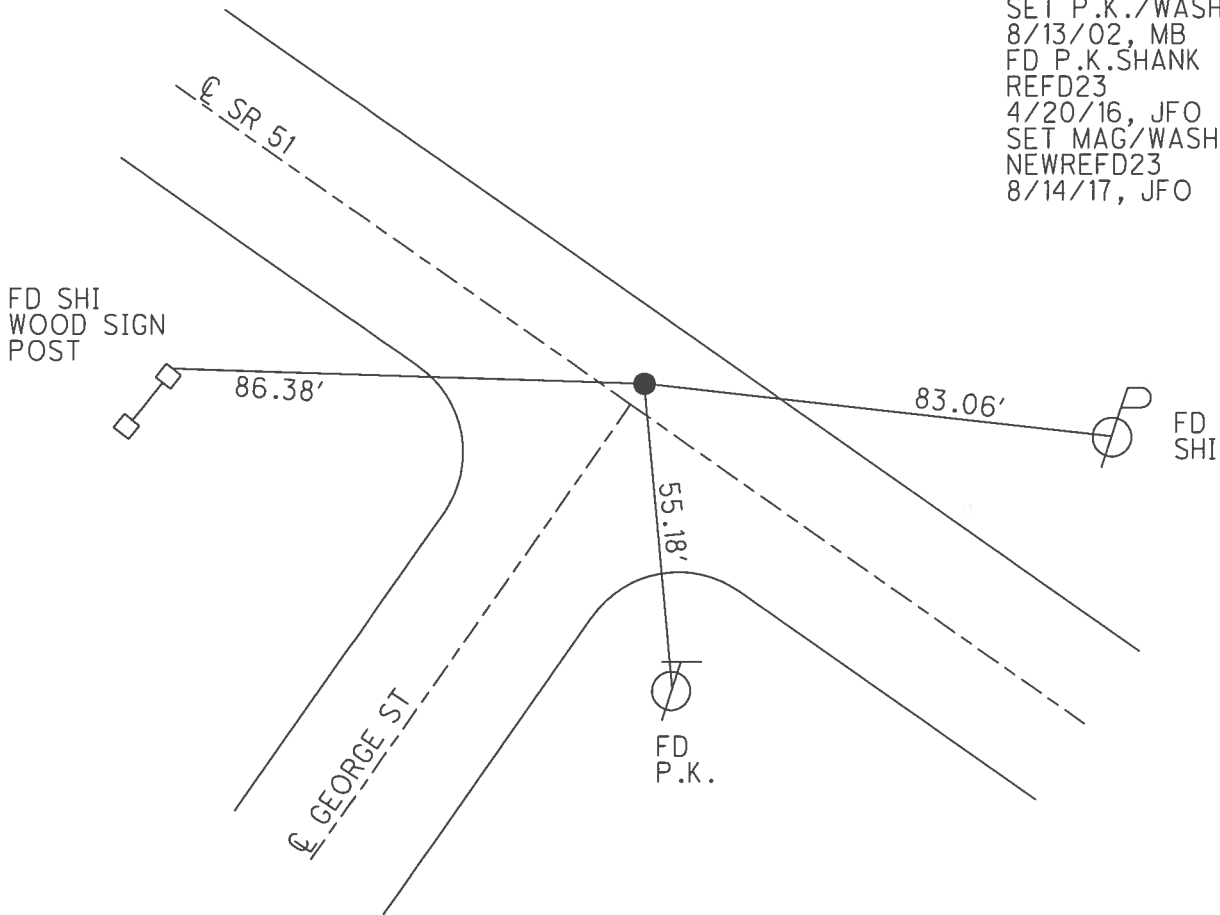

O.D.O.T. DISTRICT 2 SURVEY OFFICE

PERSONNEL

REFERENCE NO. 23-D

SHEET 4 OF 23

NOTES M. Barnhiser
 H.C. M. Canterbury
 R.C. C. Brumbaugh

DATE 5-20-02
 WEATHER Cloudy-Cold
 TEMP. +50


ROUTE S.R. 51
 COUNTY Wood
 TOWNSHIP Lake
 SECTION 12
 T 7 N R 12 E

TYPE MONUMENT Sm RR Spike
 ON SURFACE - ~~BELOW~~ On
~~LEFT~~ - RIGHT 2.5'
9.4' TO Rt EDGE PAVEMENT
 S.L.M. 38+46



Records: 1971 #22
 1887 47.18

Reset PK/Washer
 8-13-02
 M.B. / S.H.

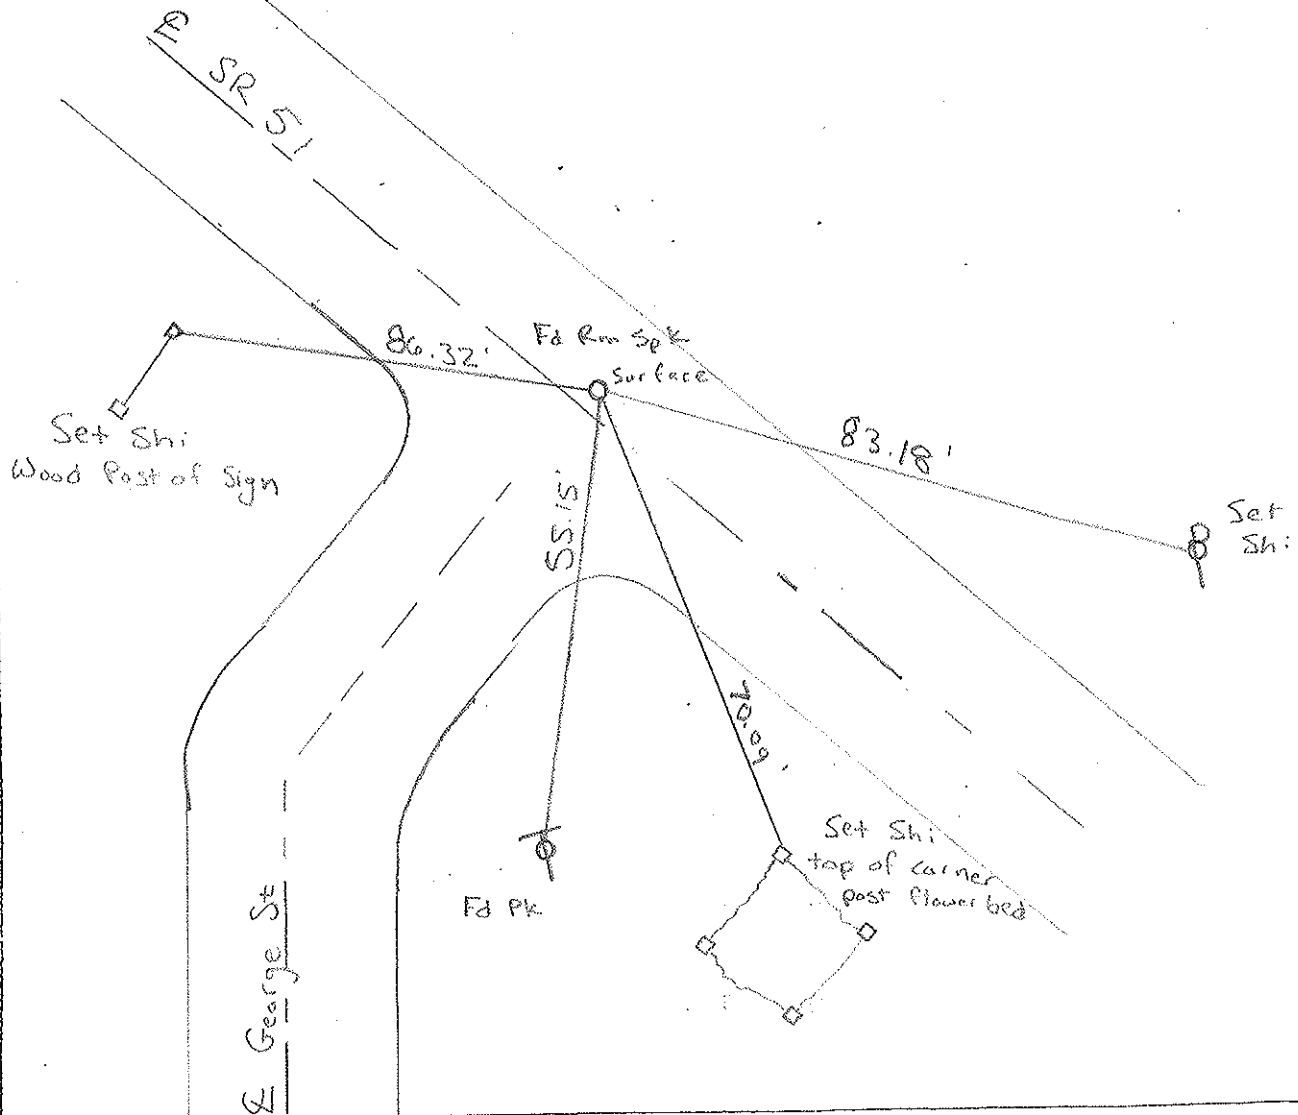

5-20-02


PERSONNEL TITLE PERSONNEL TITLE
W. Denno _____
D. Curtis _____
J. Teal _____

COUNTY Wood DATE Mar. 3, 1971

S. R. 51 WEATHER cloudy-cold

SEC. _____ TEMP. 25° ± +50

DESCRIPTION References To Control Points - S.R. 51 (Woodville Rd) JOB NO. 02837 (0)

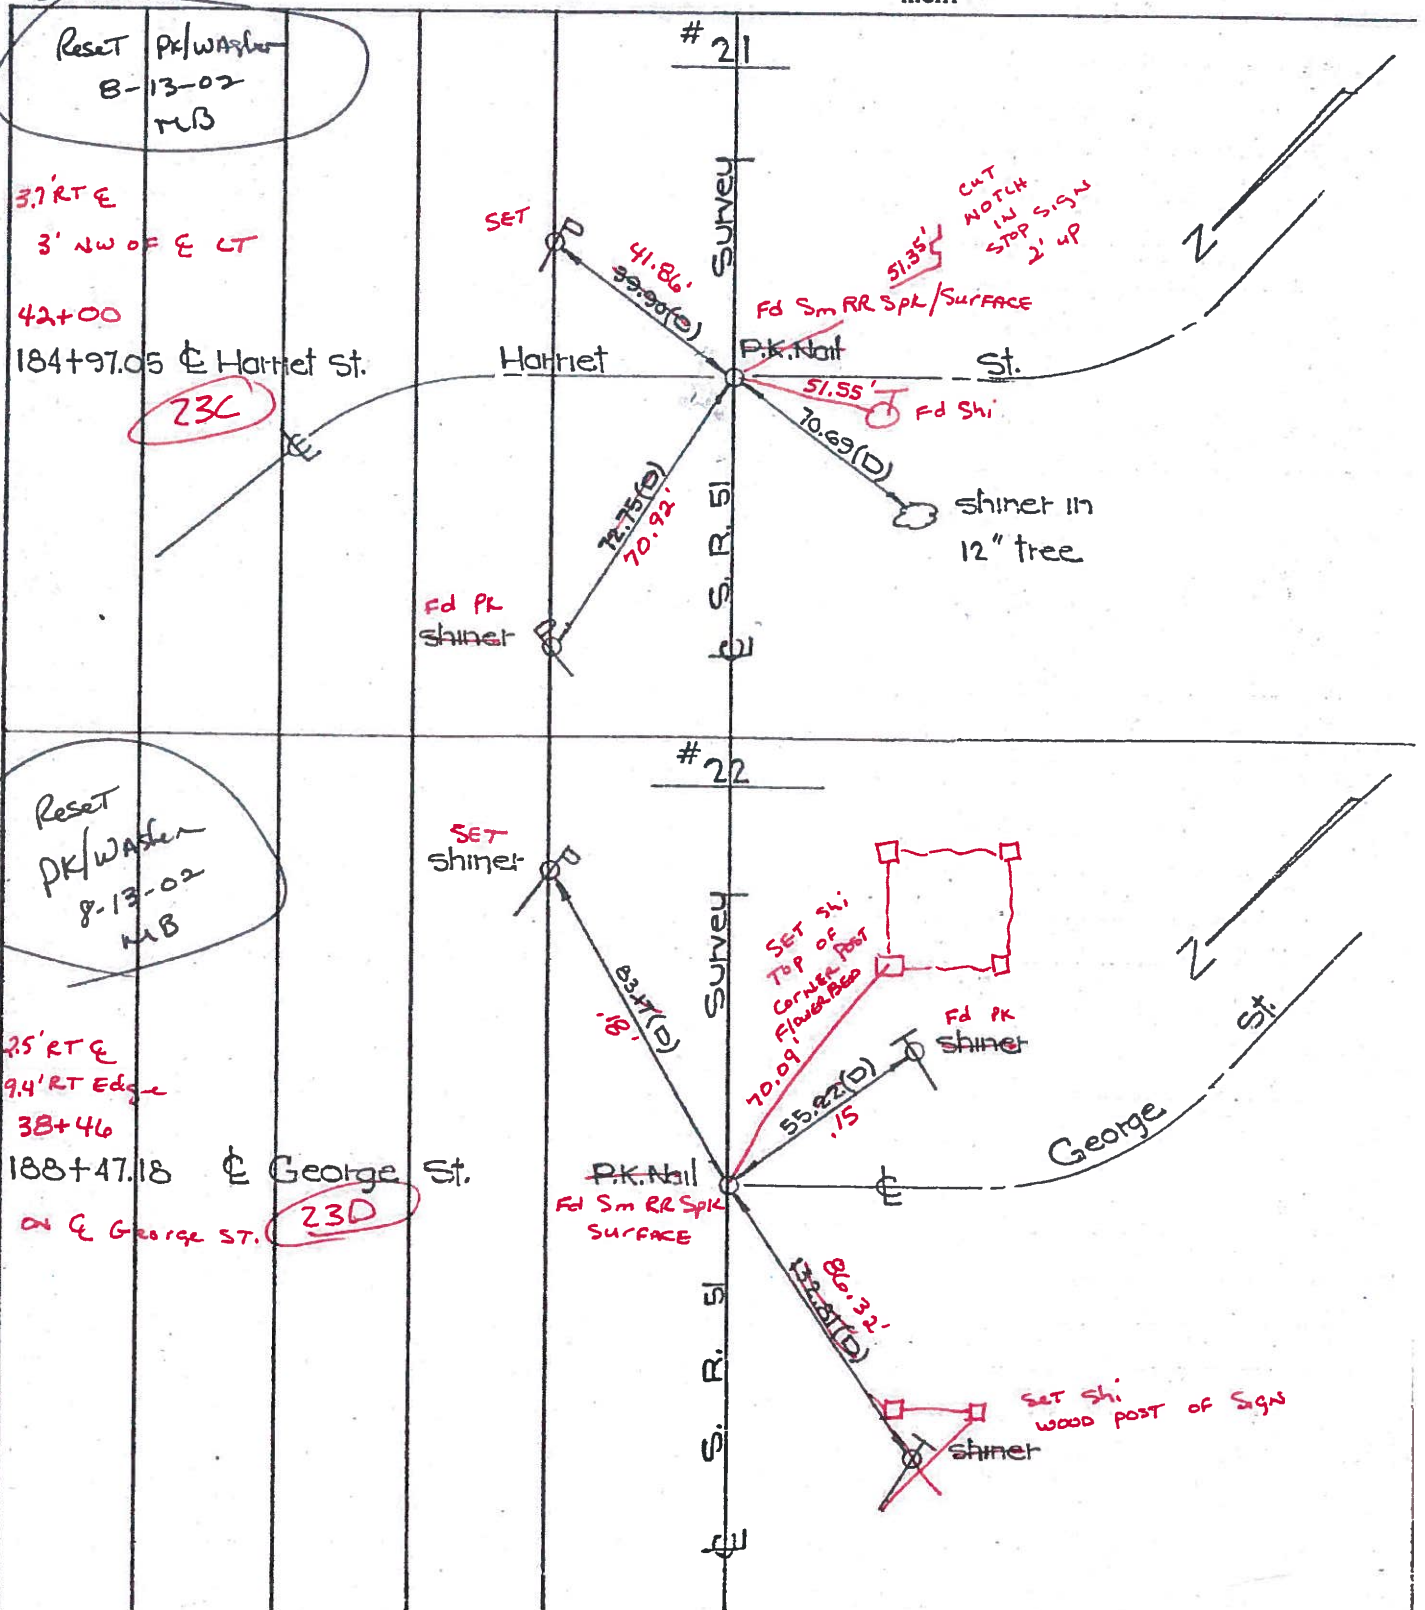

O.D.O.T. DISTRICT 2 SURVEY OFFICE

PERSONNEL

REFERENCE NO. 23-D

SHEET 19 OF

NOTES 1. Stone,

H.C. D. Curtis

R.C. J. Householder

R. Michalak

DATE 26 Feb. 86

WEATHER Cloudy

TEMP. 23°

ROUTE SR#51

COUNTY Wood

TOWNSHIP Lake

SECTION 12

T 7 N R 12 E


TYPE MONUMENT RR Spk.

ON SURFACE - BELOW Surface


LEFT - & PAW'T. - RIGHT

 TO EDGE PAVEMENT

S.L.M. 232+32

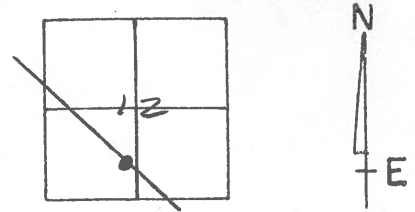

Set Small Spk. 10/18/88 IRS

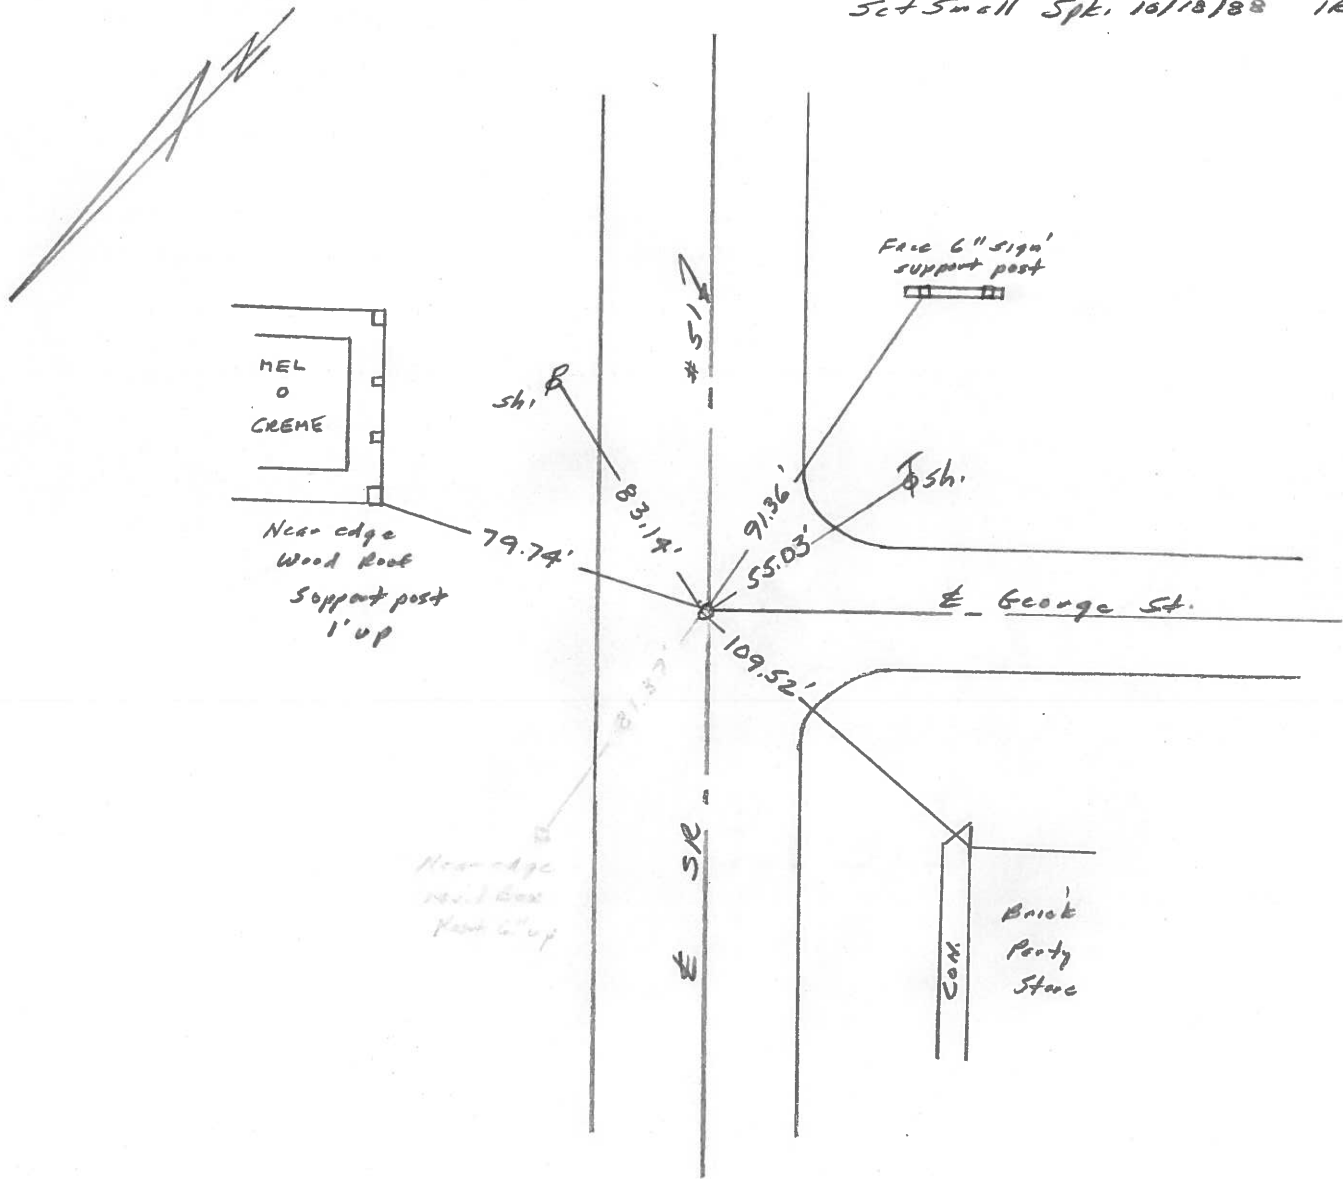

O.D.O.T. DISTRICT 2 SURVEY OFFICE

Sht. ¹³ 19 of 23
S.R. 51

County WOOD

Date 6-9-78

Township _____



Weather CLEAR

Section _____


Temp. +72°

T N, R E

Personnel BURNSIDE
SMITH
BOWERS
KNAPE
MEAD

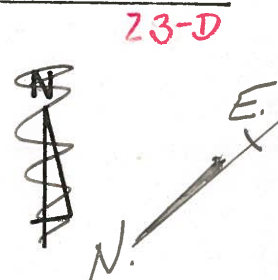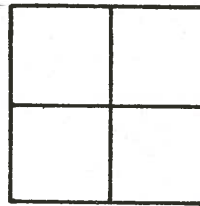

23-D

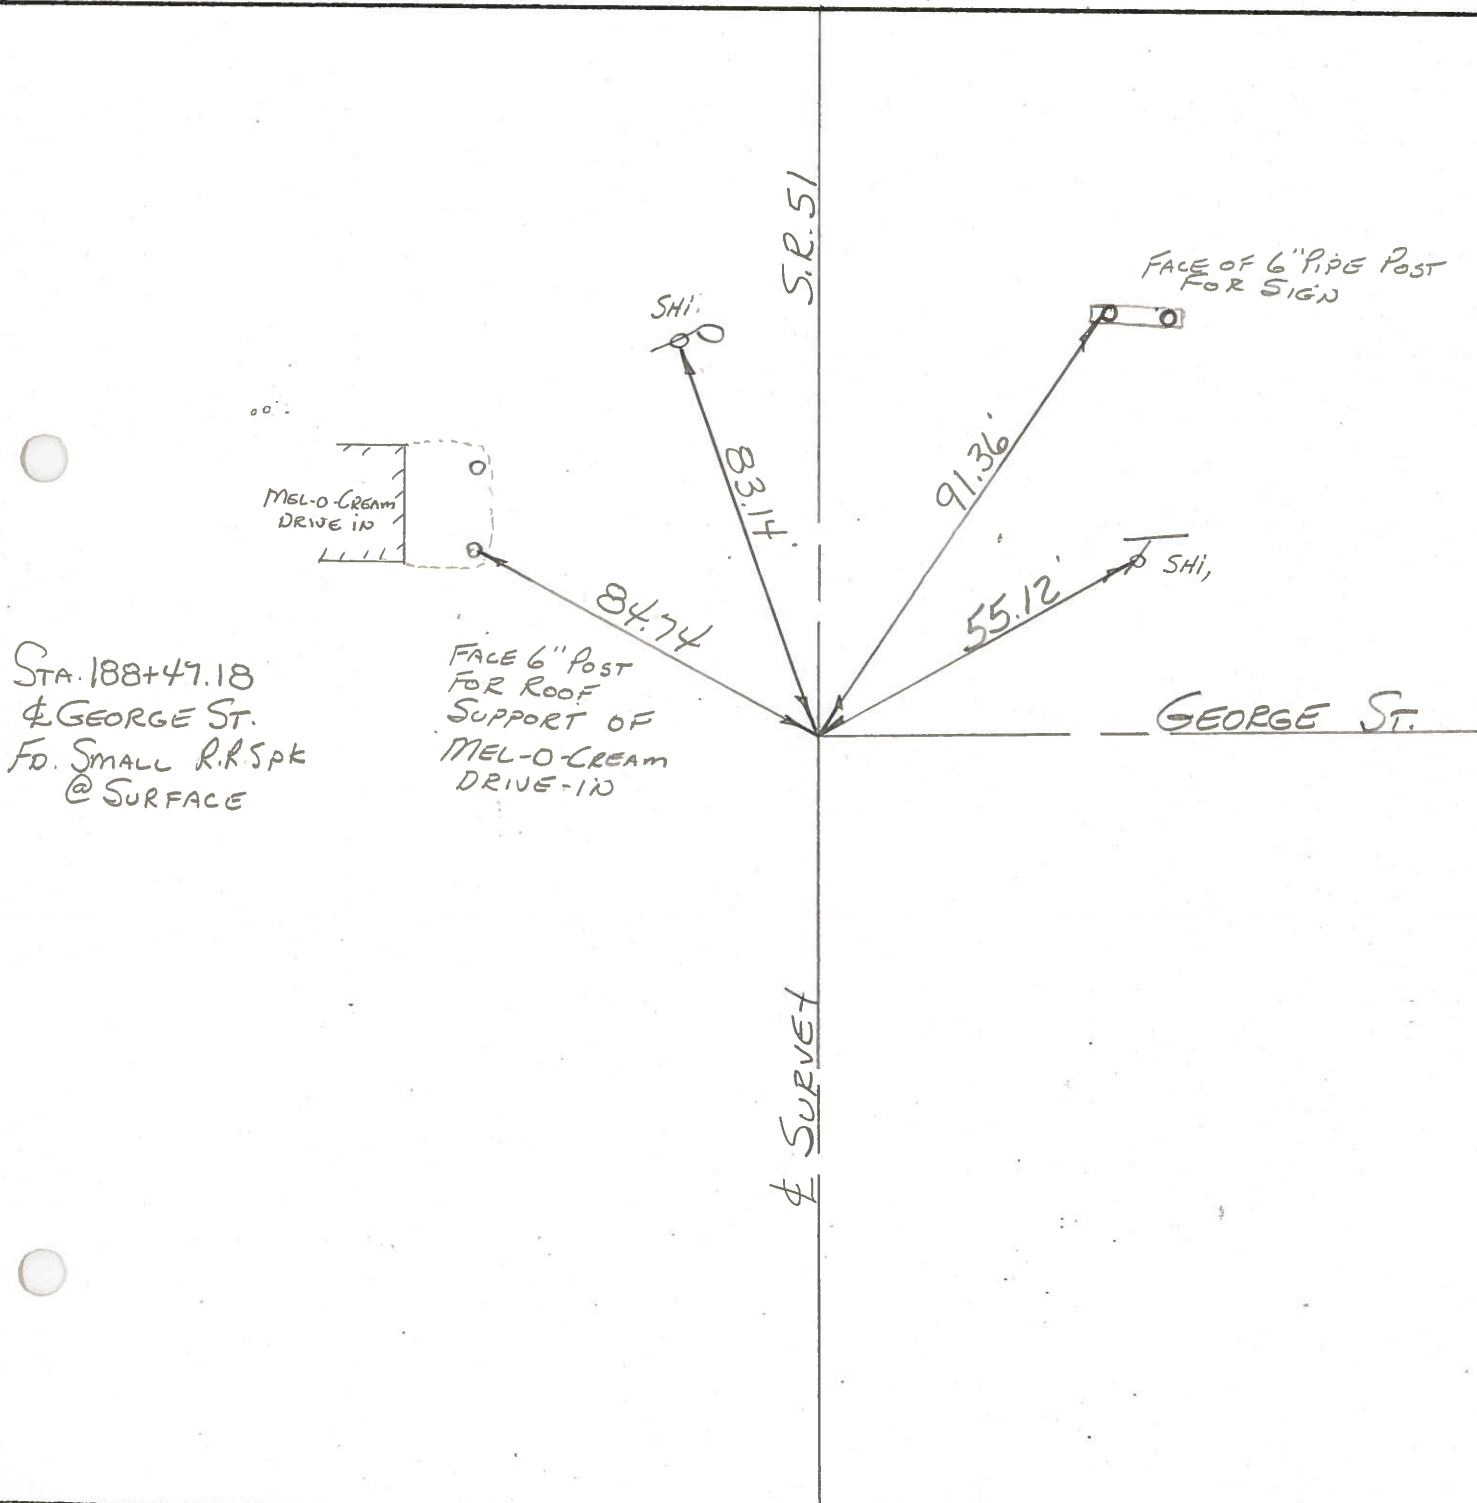

PERSONNEL _____ TITLE _____ PERSONNEL _____ TITLE _____
 COUNTY Wood DATE 9-13-61
 S. R. #12051 WEATHER _____
 SEC. _____ TEMP. _____

DESCRIPTION _____ LEFT _____ CENTER LINE _____ RIGHT _____ JOB NO. _____

