


O.D.O.T. DISTRICT 2 SURVEY OFFICE (USE ONLY)


PERSONNEL _____ REFERENCE NO. 23 SHEET 9 OF 30

NOTES RHOADES DATE 8/14/17 ROUTE SR 51
H.C. O'DONNELL WEATHER CLEAR COUNTY WOOD
R.C. RHOADES TEMP. 70° TOWNSHIP LAKE
SECTION 12
T 7 N R 12 E

TYPE MONUMENT MAG/WASHER
ON SURFACE - ~~BELOW~~ ON
~~LEFT~~ - CL PAV'T - RIGHT 2.7'
15.5' TO LT EDGE PAVEMENT
S.L.M. 50+48
GRID: NORTHING: 697715.035 EASTING: 1714324.764

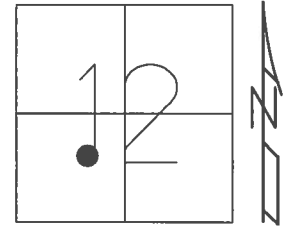

RECORD: 1971
STA. 176+47
FD SM.R.R.SPIKE
5/22/02, MB
SET P.K./WASHER
8/13/02, MB
FD HOLE W/TIES
REF23
4/19/16, JFO
SET MAG/WASHER
NEWREF23
8/14/17, JFO

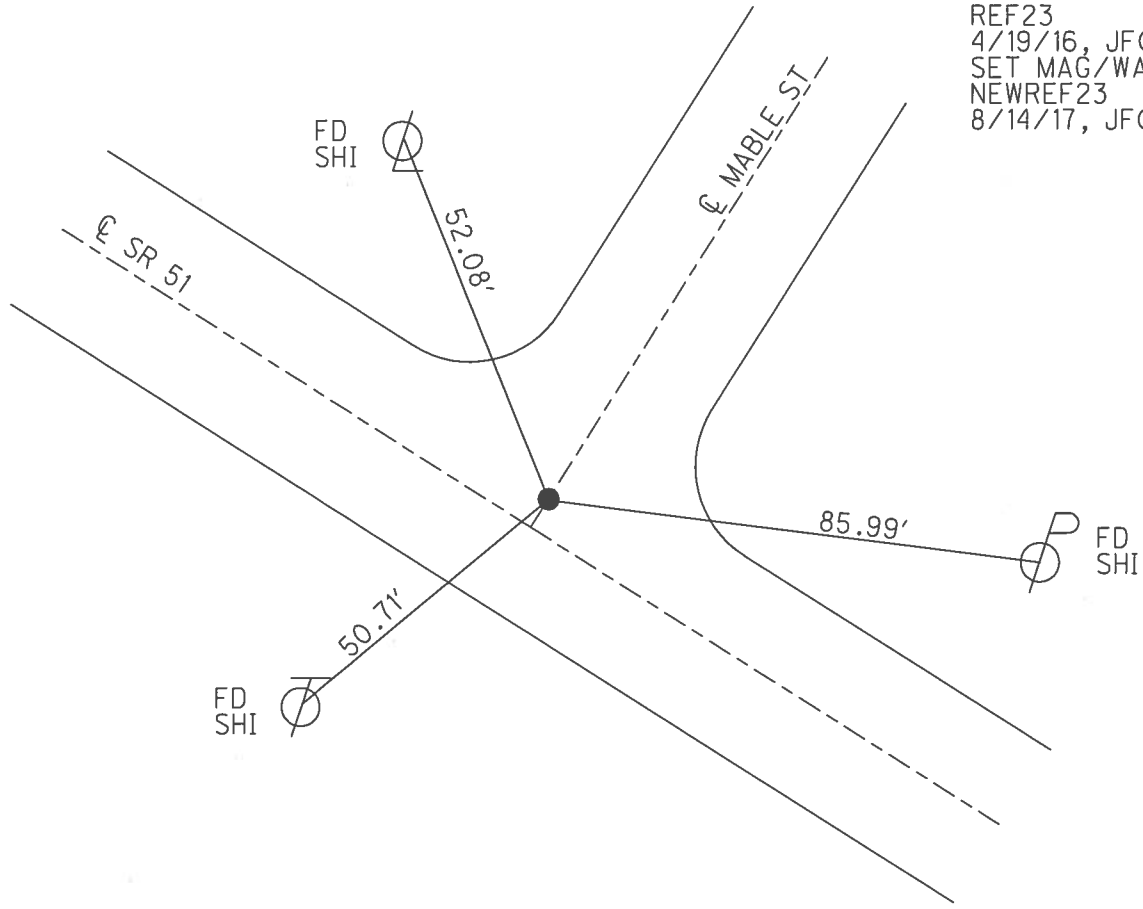

O.D.O.T. DISTRICT 2 SURVEY OFFICE

PERSONNEL _____

REFERENCE NO. 23

SHEET 8 OF 23

NOTES M. BARNHISEL

H.C. M. CANTERBURY

R.C. C. SR. BAUGH

DATE 5-22-02

WEATHER SUNNY

TEMP. +48°

ROUTE SR. 51

COUNTY WOOD

TOWNSHIP LAKE

SECTION _____

T 7 N R 12 E


TYPE MONUMENT SM. R.R. SPIKE

ON SURFACE - BELOW ON

LEFT - € PAV'T. - RIGHT 2.7'


15.5' TO LT EDGE PAVEMENT

S.L.M. 50148

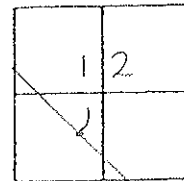

Records: 1911 # 18
176 + 47.00

Set P.K./washer
8-13-02
MB

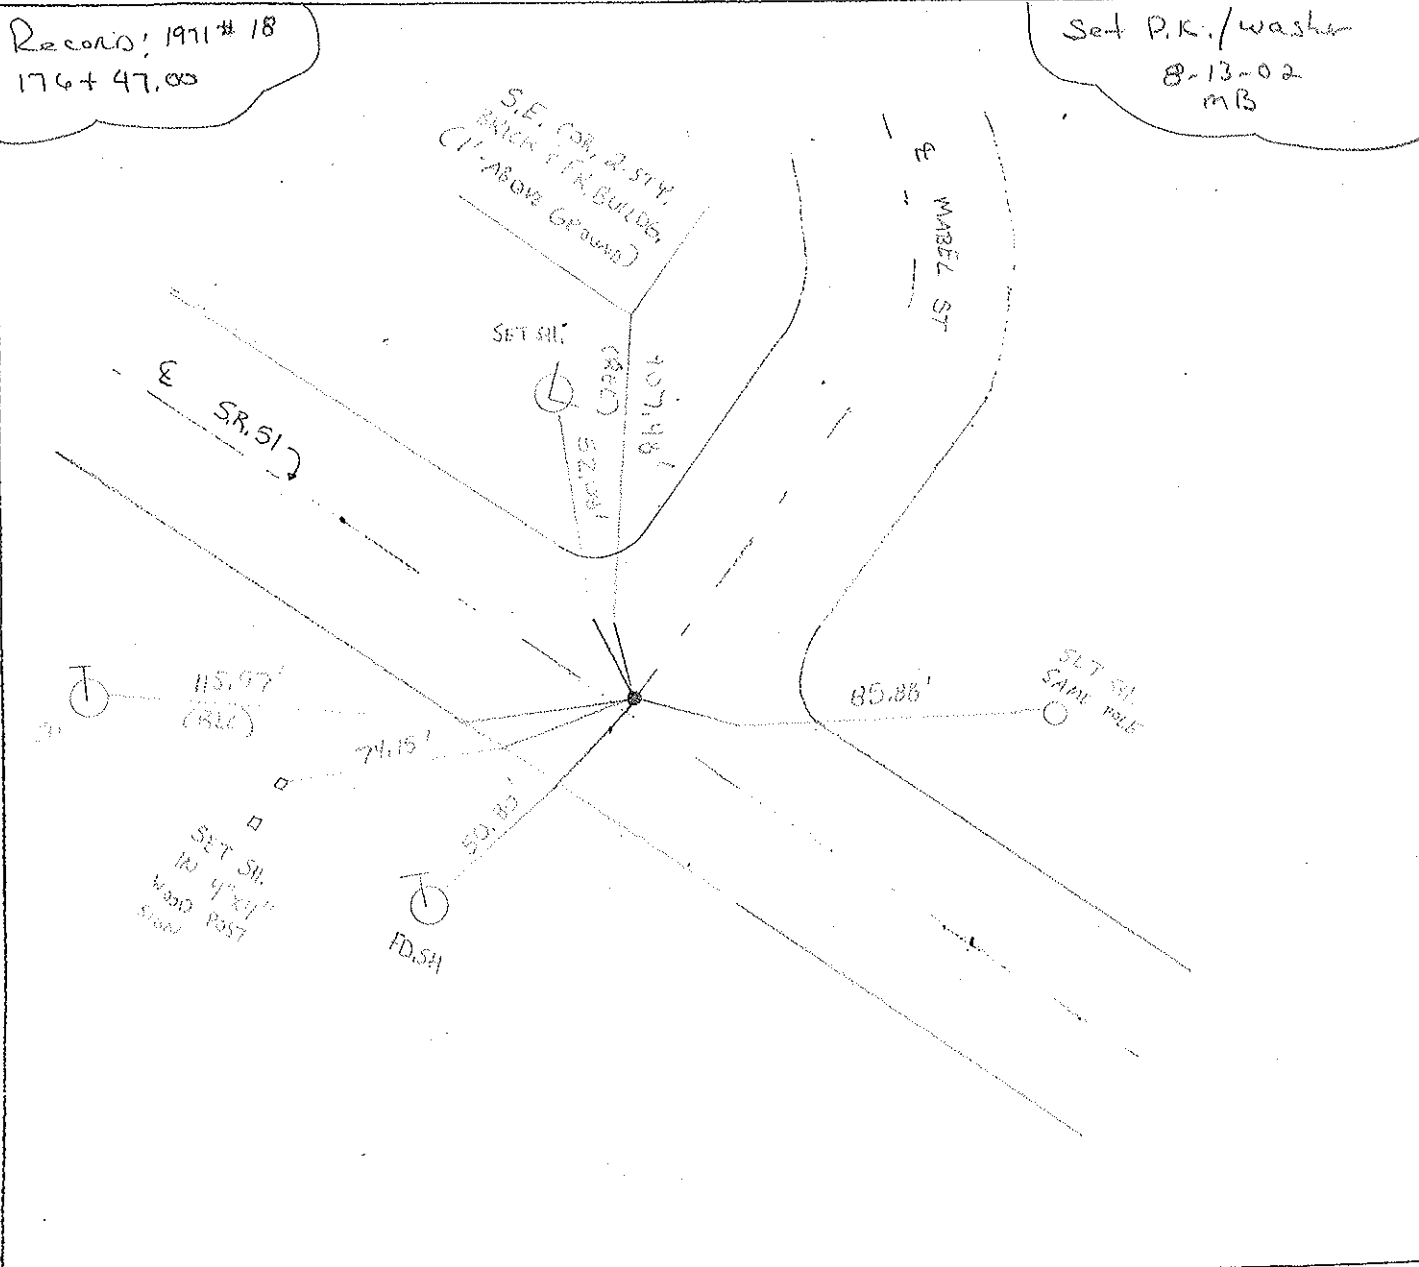

O.D.O.T. DISTRICT 2 SURVEY OFFICE

PERSONNEL

REFERENCE NO. 23


SHEET 15 OF

NOTES 1. Stone
 H.C. J. Curtis
 R.C. J. Hauschalter
R. Michalak


DATE 26 Feb. 86
 WEATHER Cloudy
 TEMP. 20°

ROUTE SR#51
 COUNTY Wood
 TOWNSHIP Lake
 SECTION 12
T 7 N R 12 E

TYPE MONUMENT RR Spk.
 ON SURFACE - BELOW Surface
 LEFT - PAV'T. - RIGHT
 TO EDGE PAVEMENT
 S.L.M. 220+39

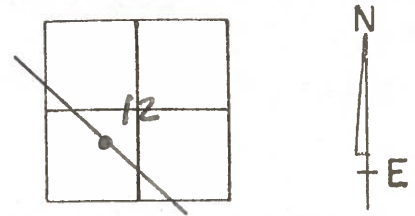

Set Small Spk. 10/12/88 res

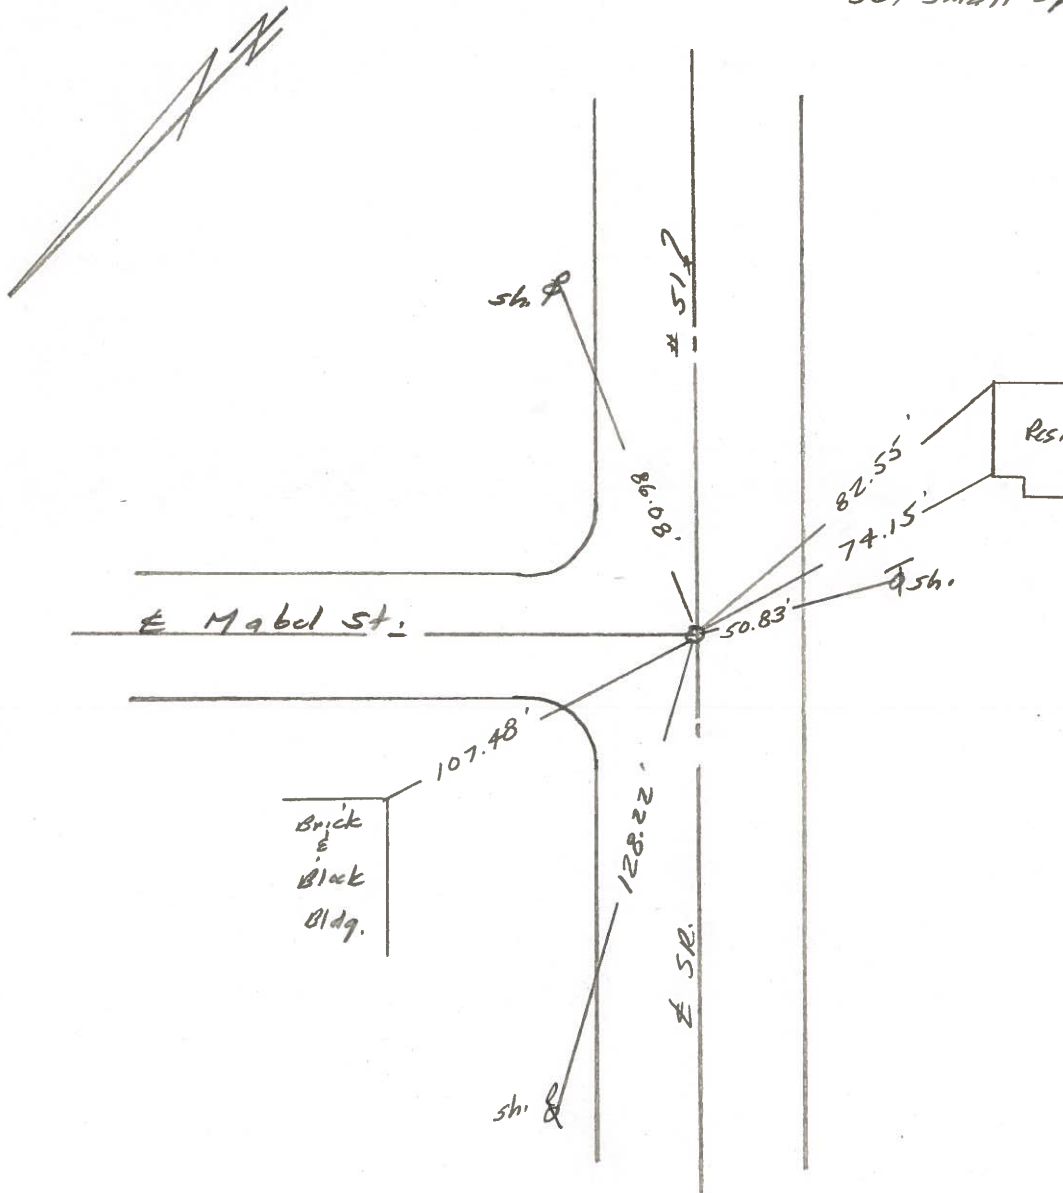

Q.D.O.T. DISTRICT 2 SURVEY OFFICE

Sht. 15 of 23
S.R. 51

County WOOD

Date 6-9-78

Township _____



Weather CLEAR

Section _____


Temp. +70°

T N, R E

Personnel BURNSIDE
SMITH
BOWERS
KNAPPE
MEAD

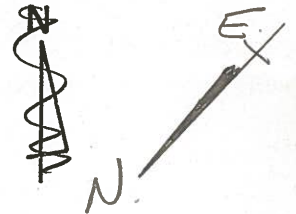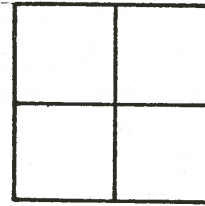


23

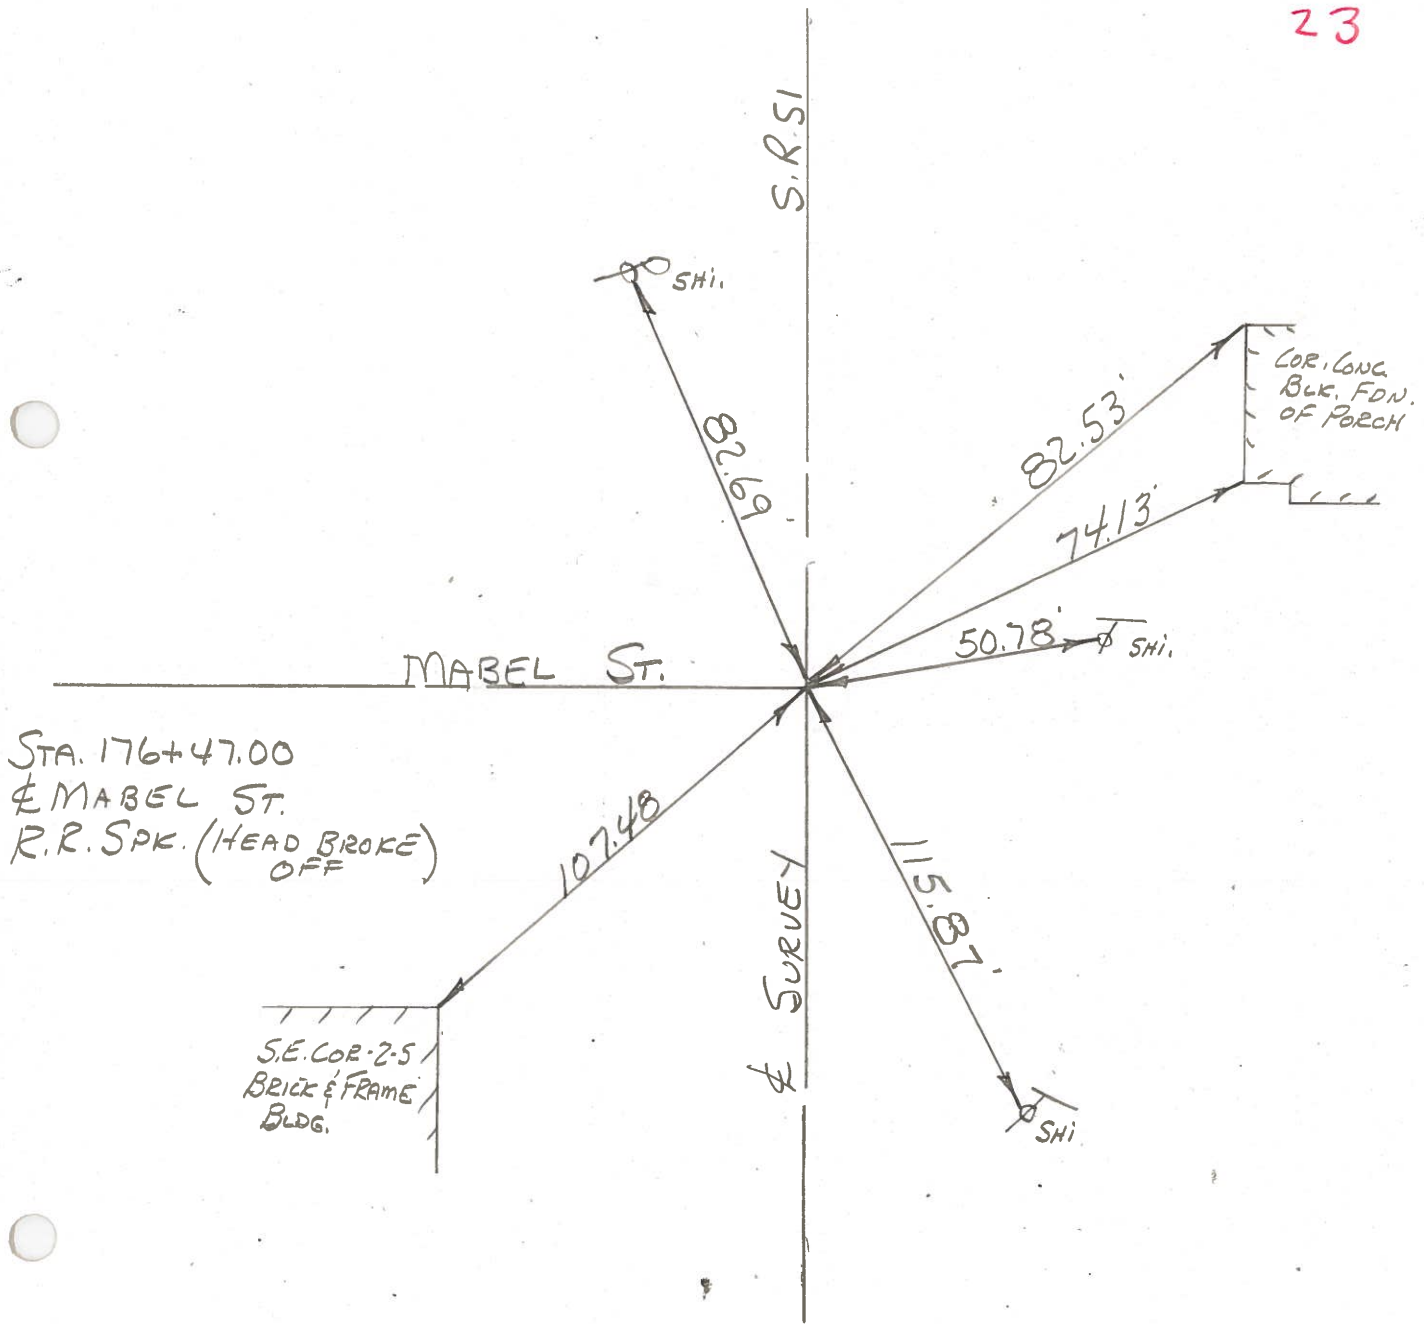

PERSONNEL	TITLE	PERSONNEL	TITLE	COUNTY	DATE
W. Denno				Wood	Mar. 3, 1971
D. Curtis				S. R.	51
J. Teal				WEATHER	Cloudy-cold
				SEC.	TEMP. 25°±

DESCRIPTION: References To Control Points-S.R. 51 (Woodville Rd) JOB NO. 02837 (0)

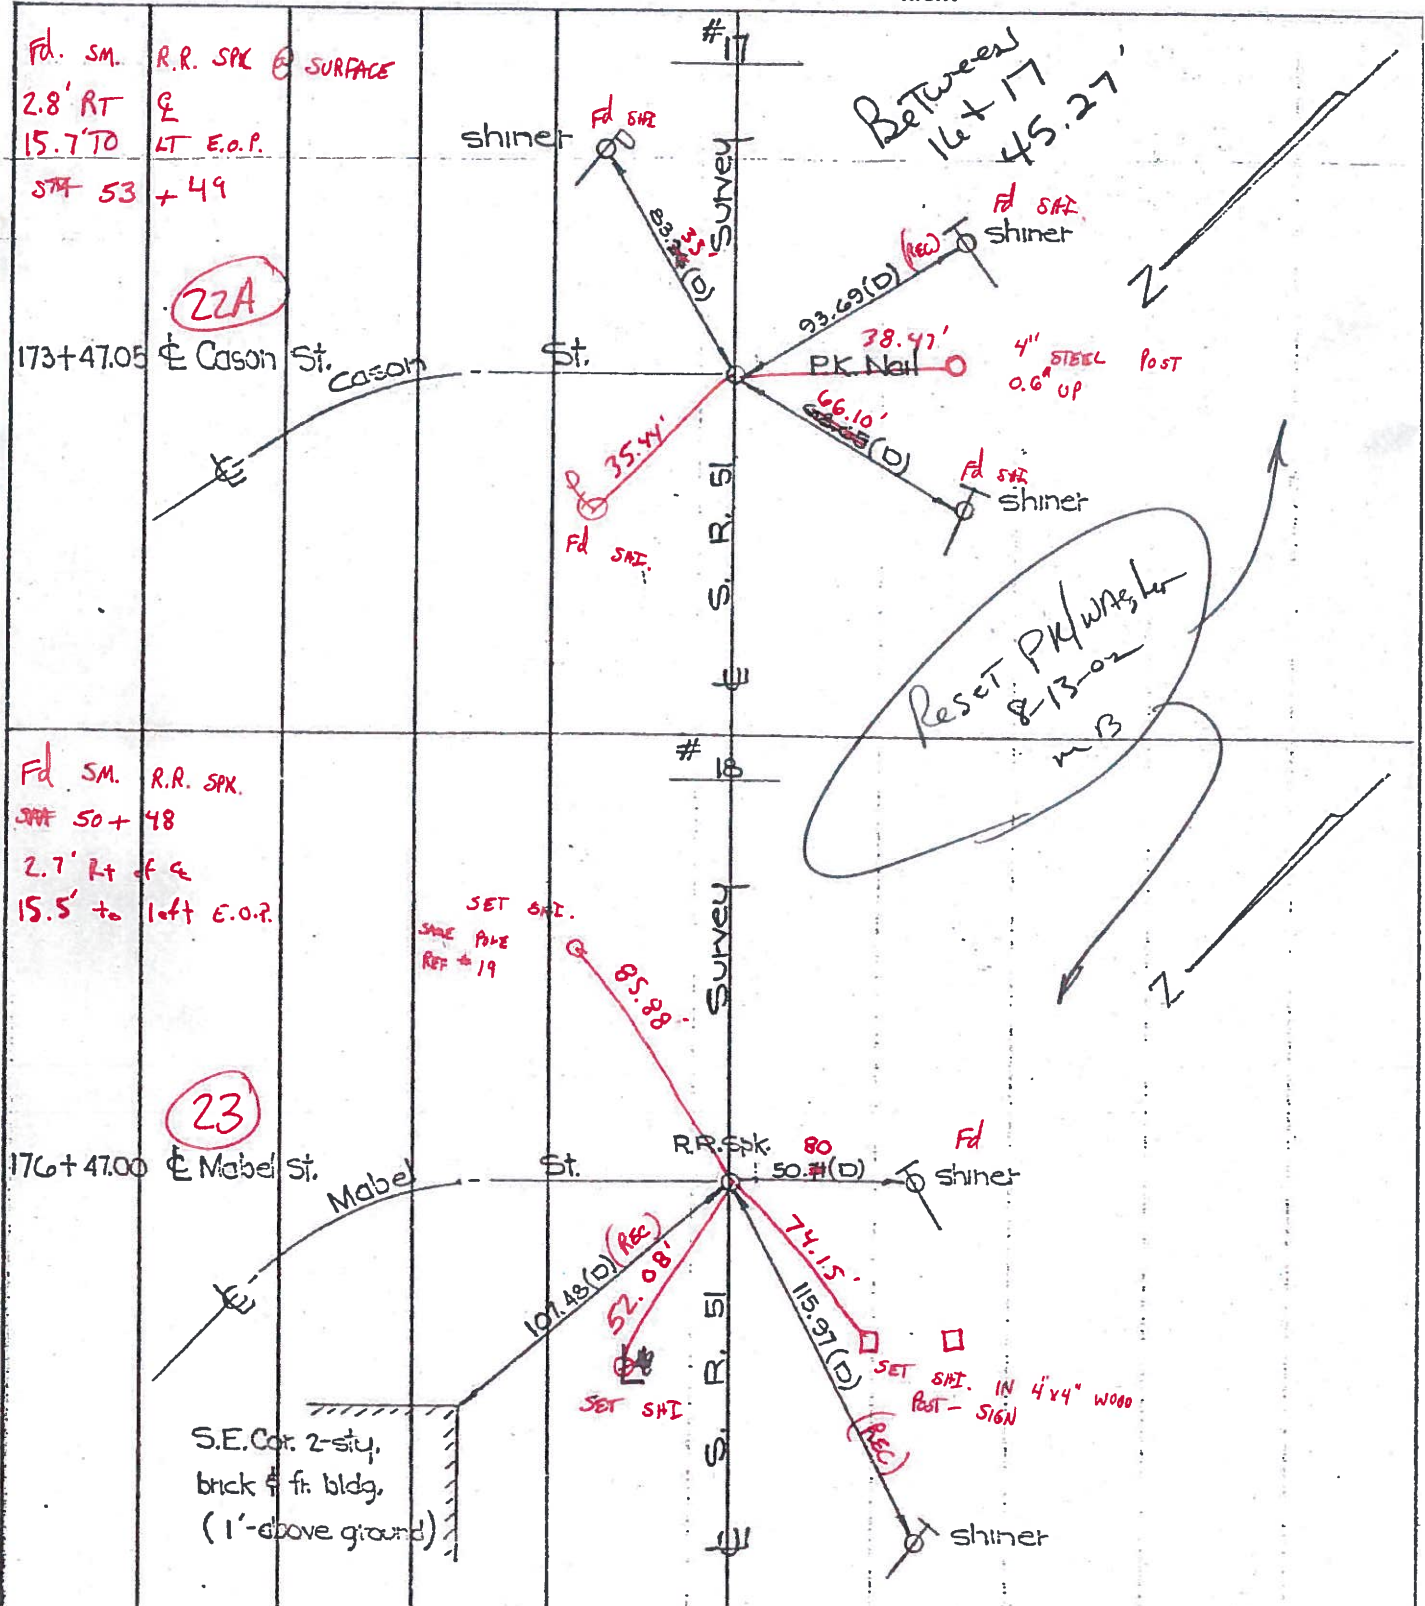

PERSONNEL TITLE PERSONNEL TITLE

COUNTY Wood

DATE 9-12-61

S. R. #120 51

WEATHER

SEC.

TEMP.

DESCRIPTION

LEFT

CENTER LINE

RIGHT

JOB NO.

