


PERSONNEL	TITLE	PERSONNEL	TITLE	COUNTY	<u>WOOD</u>	DATE	<u>JUNE 25, 1977</u>
<u>W DENNO</u>		<u>D. STEVENS</u>		S. R.	<u>51</u>	WEATHER	<u>SUNNY - WARP</u>
<u>D. CURTIS</u>		<u>R. BRANNAN</u>		SEC.		TEMP.	<u>85 °</u>
<u>P. NEUSER</u>							


DESCRIPTION WITNESS TIES TO BRIDGE Woo-51-0210 JOB NO. 02837 (0)

LEFT CENTER LINE RIGHT

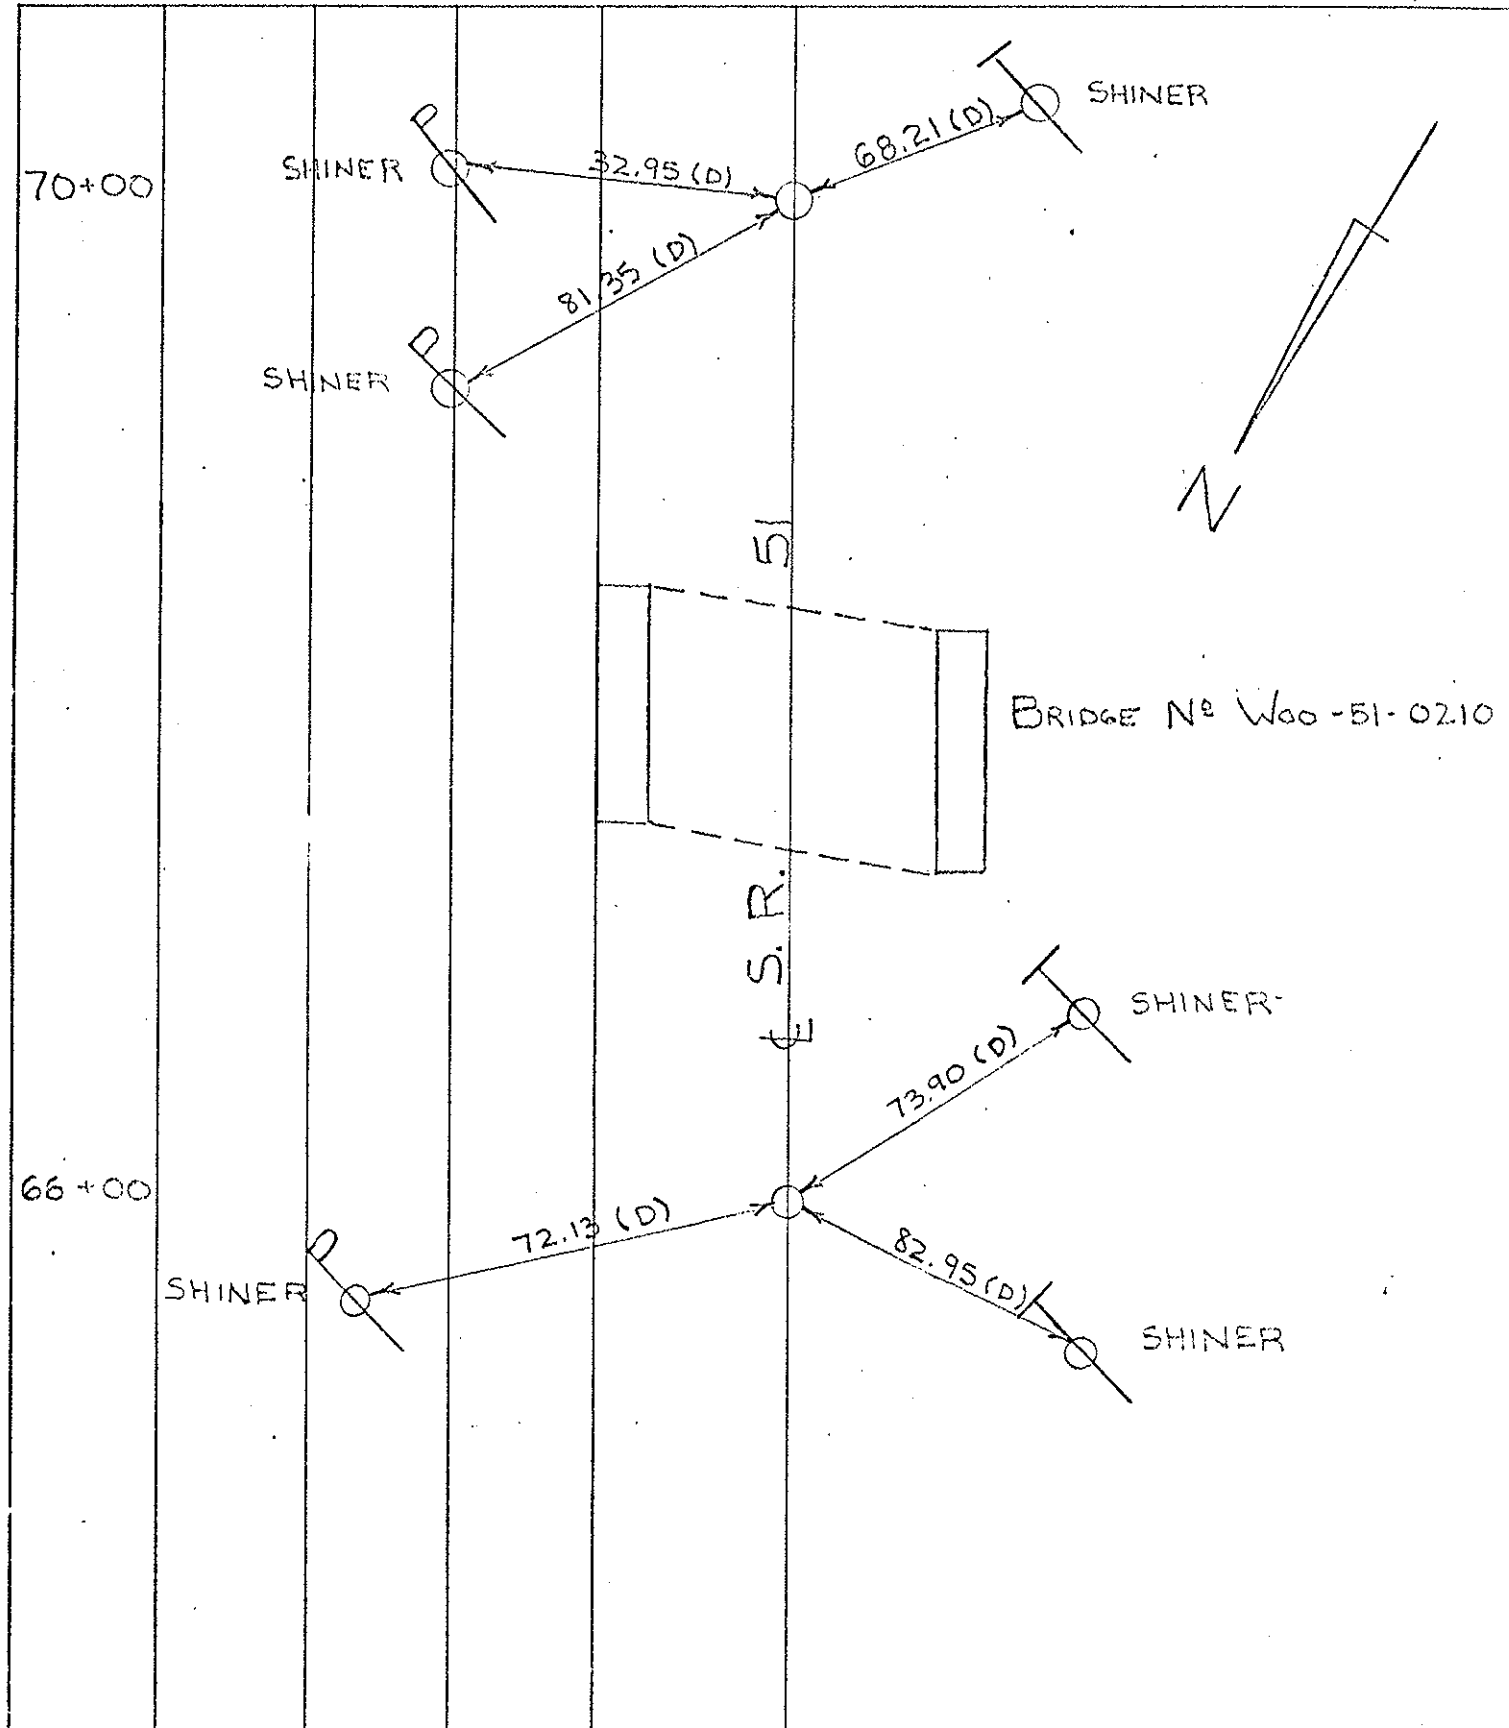


PERSONNEL	TITLE	PERSONNEL	TITLE	COUNTY	DATE	WEATHER	TEMP
W. DENNO		D. STEVENS		WOOD	JUNE 25, 1971	SUNNY-WARM	85±
D. CURTIS		R. BRANNAN		S. R. 51			
P. HANCOCK							

DESCRIPTION: WITNESS TIES TO BRIDGE WOO-51-259
 JOB NO. 02.837 (0)

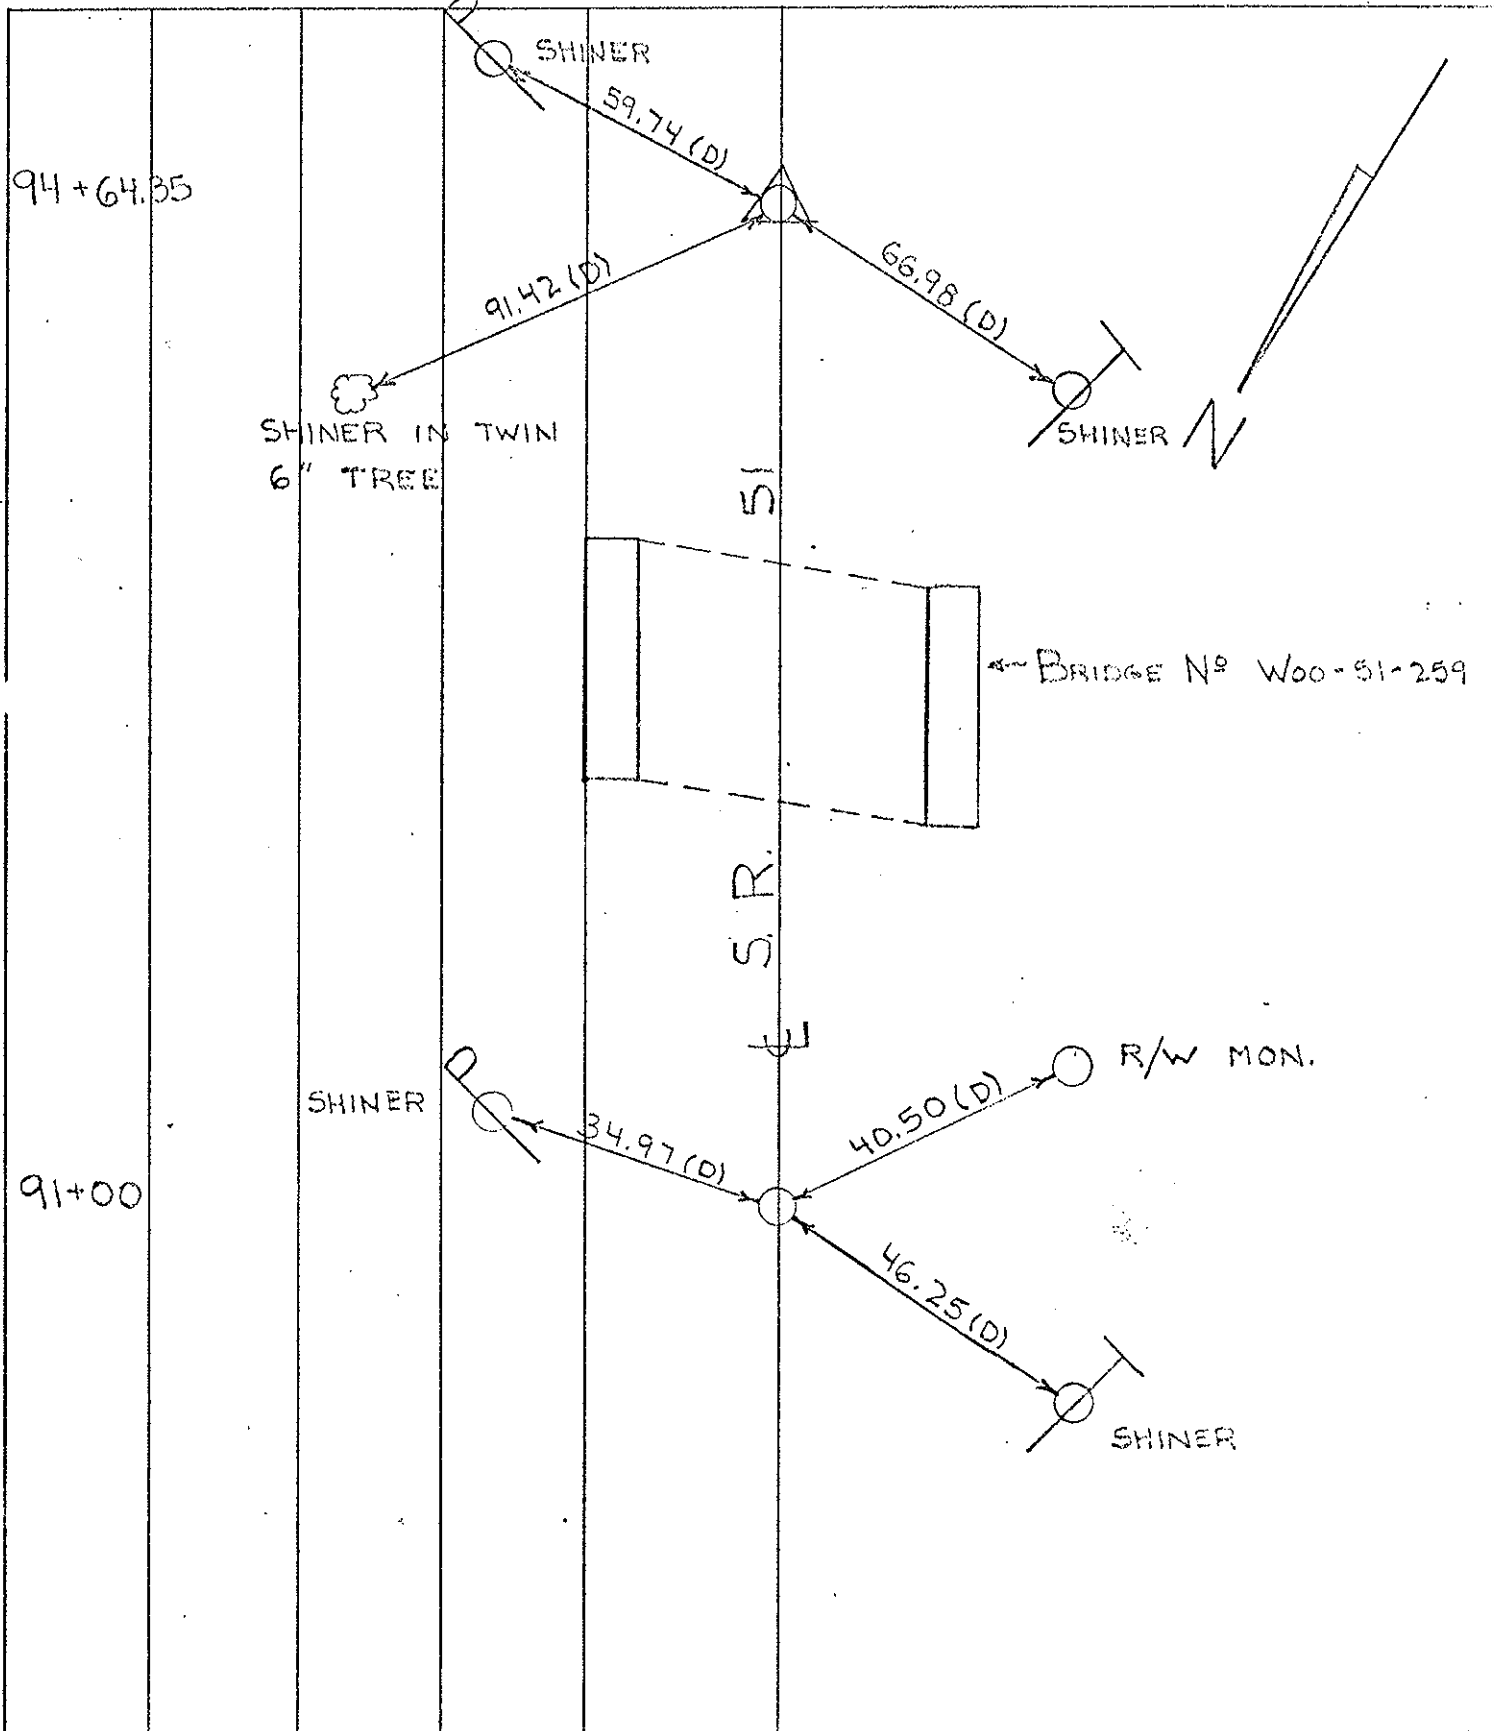

PERSONNEL	TITLE	PERSONNEL	TITLE	COUNTY	WOOD	DATE	JUNE 25, 1971
W. DENNO		D. STEVENS		S. R.	51	WEATHER	SUNNY - WARM
D. CURTIS		R. BRANNAN		SEC.		TEMP.	85 ±
P. NEUSER							

DESCRIPTION WITNESS TIES TO BRIDGE WOO-51-0335 JOB NO. 02837(0)
 LEFT CENTER LINE RIGHT

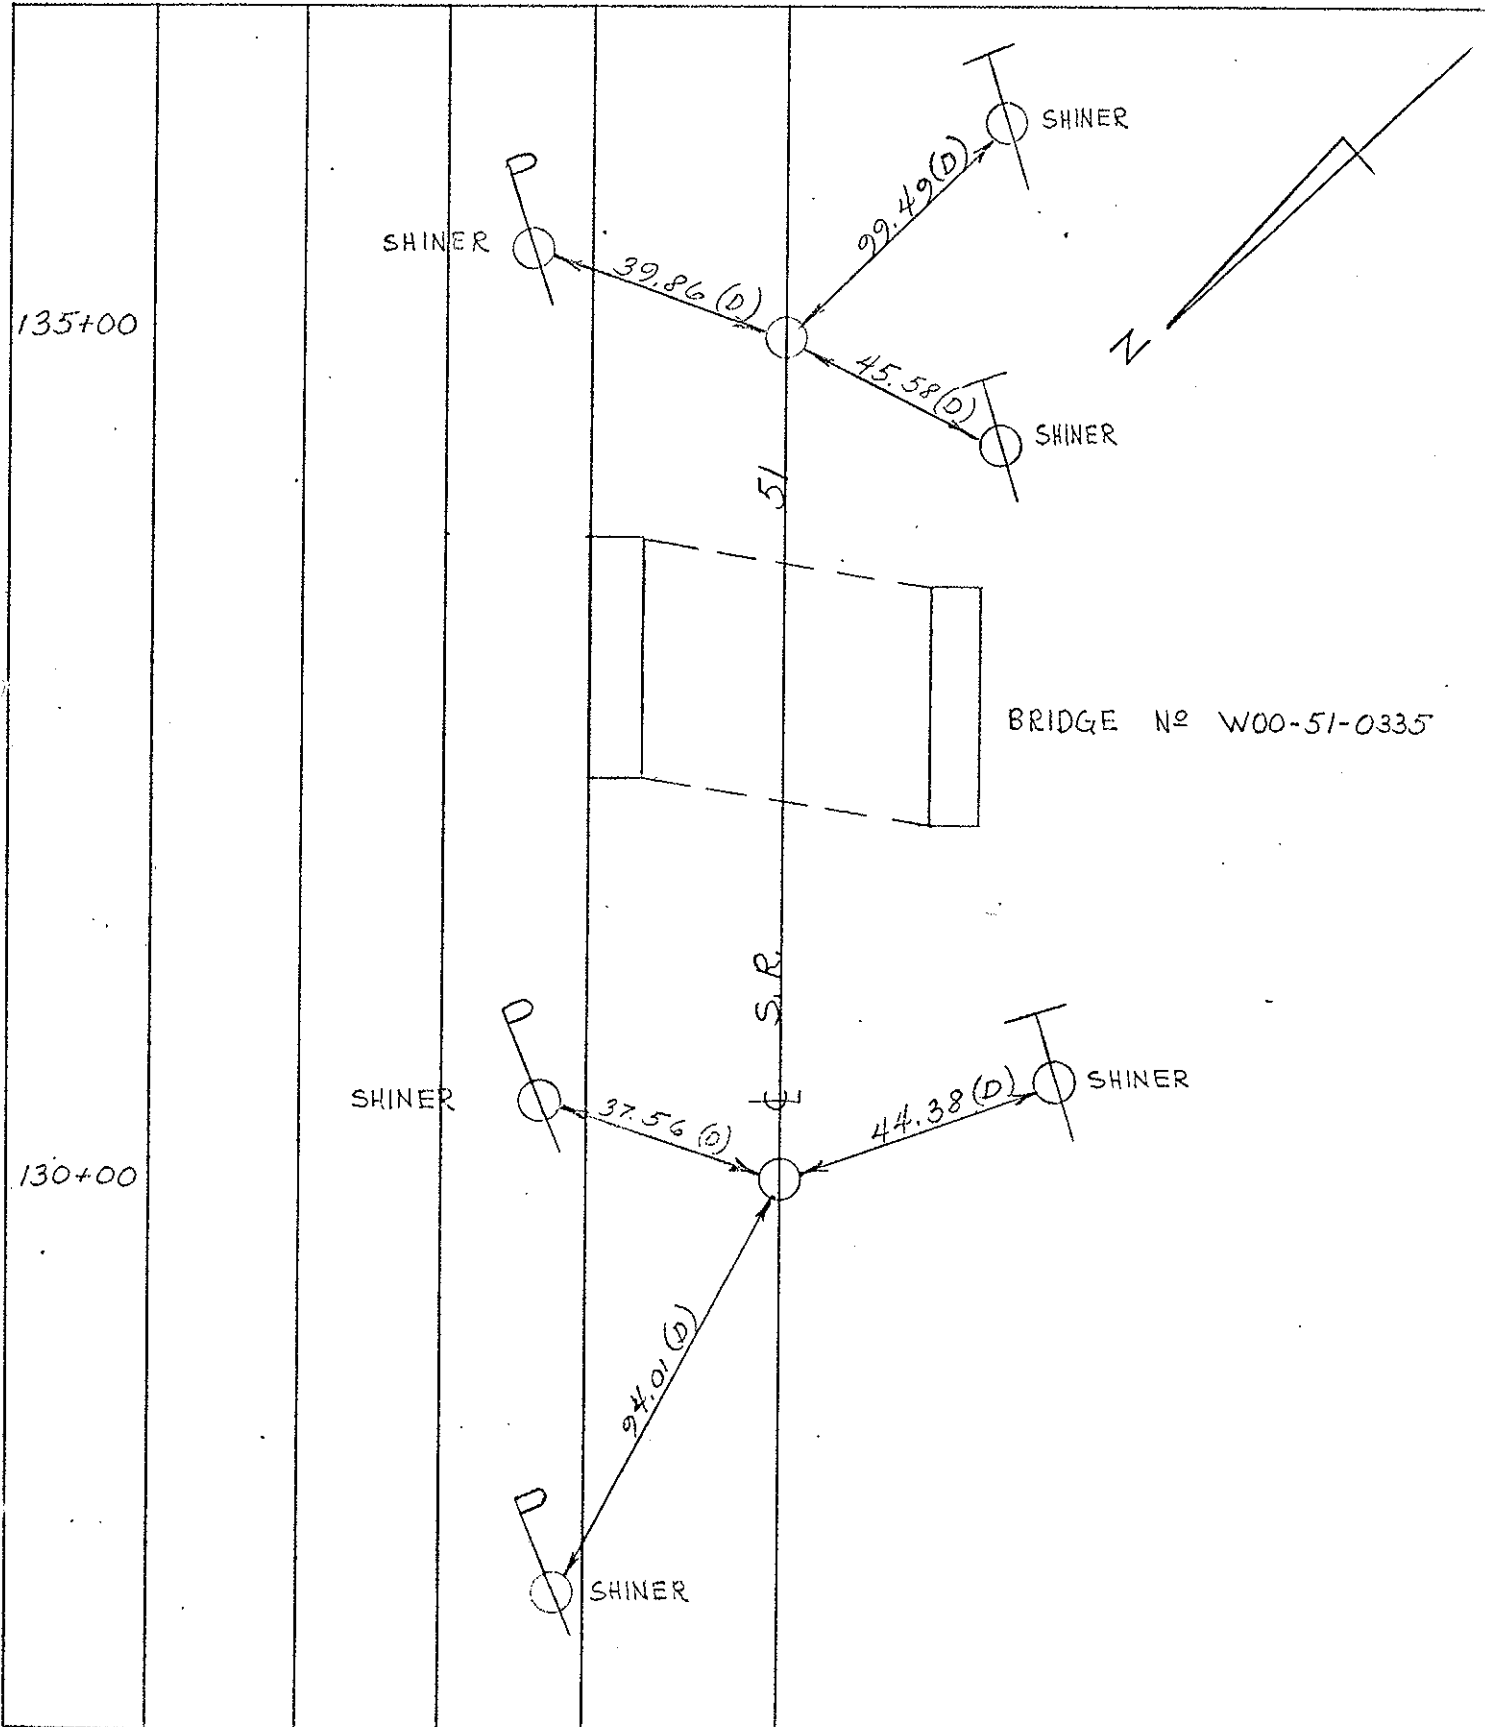


PERSONNEL	TITLE	PERSONNEL	TITLE
W. DENNO		D. STEVENS	
D. CURTIS		R. BRANNAN	
P. NEUSER			

COUNTY WOOD DATE JUNE 25, 1971

S. R. 51 WEATHER SUNNY-WARM

SEC. TEMP 85±

DESCRIPTION WITNESS TIES TO BRIDGE W00-51-0470 JOB NO. 02837(0)

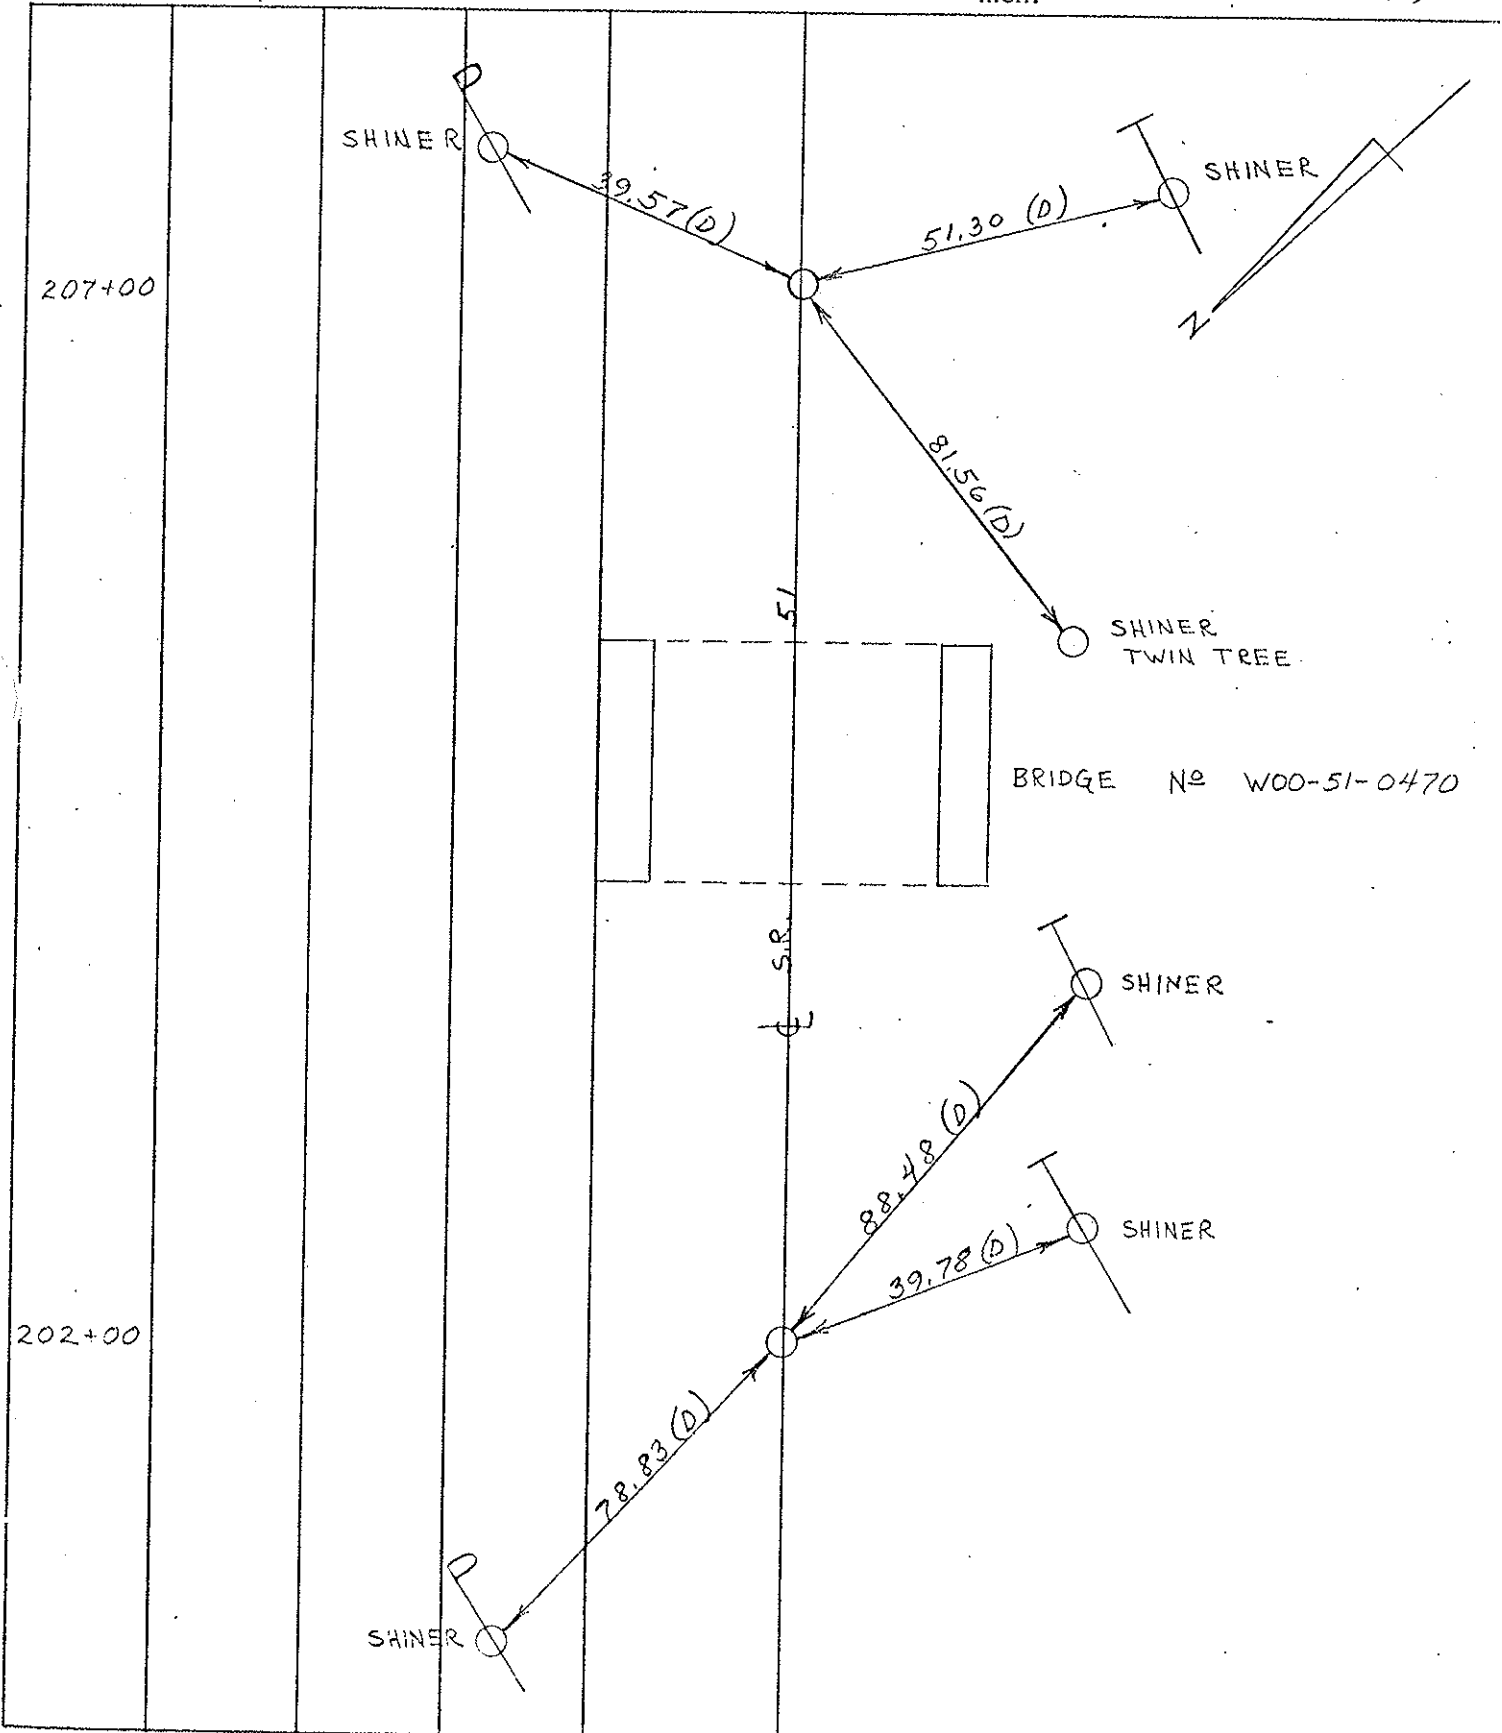

PERSONNEL	TITLE	PERSONNEL	TITLE
W. Deppo			
D. Curtis			
J. Lee			

COUNTY Wood DATE Mar 3, 1971
 S. R. 51 WEATHER Cloudy-cold
 SEC. _____ TEMP 25°±

DESCRIPTION References To Control Points - S.R. 51 (Woodville Rd) JOB NO. 02837 (0)

