


O.D.O.T. DISTRICT 2 SURVEY OFFICE (USE ONLY)


PERSONNEL _____ REFERENCE NO. 16 C SHEET 22 OF 30

NOTES RHOADES DATE 4/20/16 ROUTE SR 51
 H.C. O'DONNELL WEATHER SUNNY COUNTY WOOD
 R.C. RHOADES TEMP. 58° TOWNSHIP LAKE
 _____ SECTION 2
 _____ T 7 N R 12 E

TYPE MONUMENT MAG/WASHER
 ON SURFACE - ~~BELOW~~ ON
~~LEFT~~ - CL PAV'T - RIGHT 2.3'
9.5' TO RT EDGE PAVEMENT
 S.L.M. 126+57
 GRID: NORTHING: 702875.654 EASTING: 1708737.680

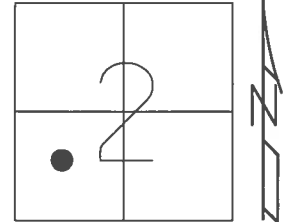

RECORD: 1971
 STA. 100+41.53
 BRIDGE PROJECT
 STA. 138+44.41
 FD P.K.NAIL
 5/22/02, MB
 SET P.K./WASHER
 8/14/02, MB
 FD MAG/WASHER
 REFCD16
 4/20/16, JFO
 SET MAG/WASHER
 NEWREFCD16
 8/16/17, JFO

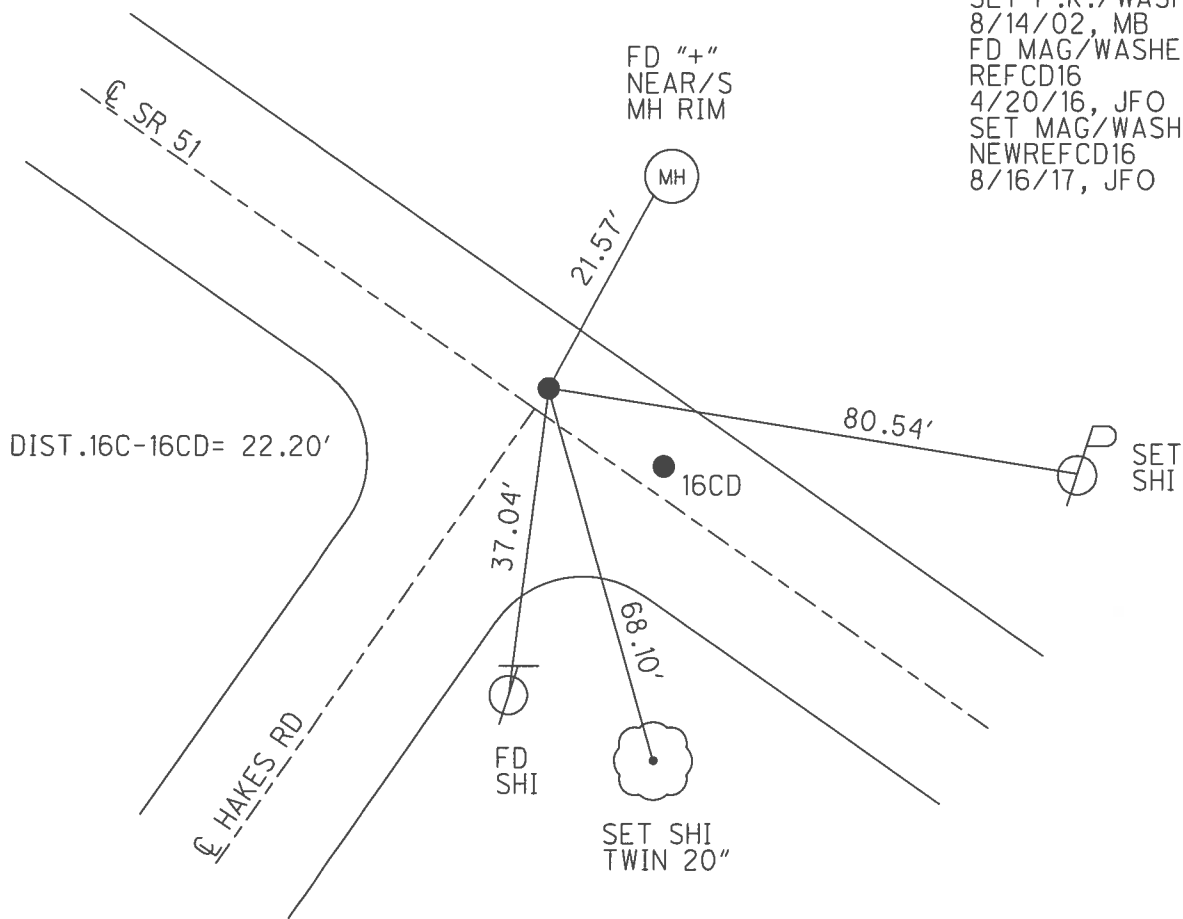

O.D.O.T. DISTRICT 2 SURVEY OFFICE

PERSONNEL

REFERENCE NO. 16-C

SHEET 19 OF 23

NOTES M. BARNHISEL

H.C. M. CANTERBURY

DATE 5-22-02

ROUTE SR. 51

R.C. C. BRUMBAUGH

WEATHER SUNNY

COUNTY WOOD

FLAG B. ABALINSKI

TEMP. +48°

TOWNSHIP LAKE

SECTION 2

T 7 N R 12 E

(A) (HAKE'S RD) (B) (SR 51)


TYPE MONUMENT R.B. SPIKE / PK NAIL

ON SURFACE - BELOW ON (BOTH)

LEFT - PAV'T. - RIGHT 2.3' (BOTH)


9.5' TO RT. EDGE PAVEMENT (BOTH)

S.L.M. (A) 126+57 (B) 126+35

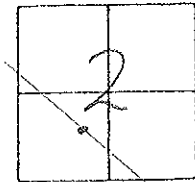

Records: 1971 # 6 & #7
 Pt. "A" sta. 100+41.53
 Pt. "B" sta. 100+63.65, Δ = 00°-12'-00" Rt.

SET PK/WASHER
 8-14-02
 M.B.C.
 JKA

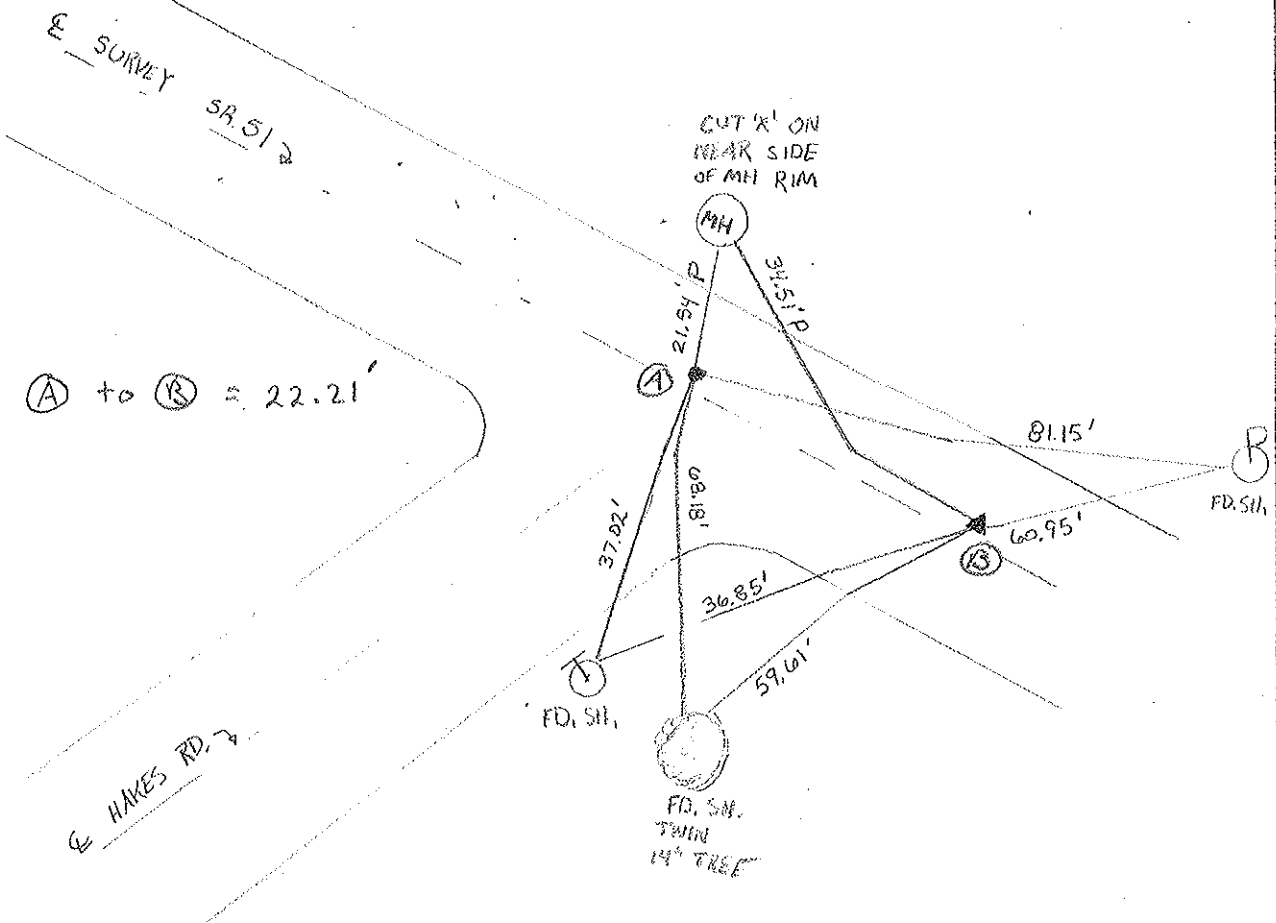

(A) to (B) = 22.21'

BRIDGE PROJECT: sta 144+21.77


5-22-01

PERSONNEL	TITLE	PERSONNEL	TITLE
W. Denno			
D. Curtis	MB III	CB-RC	
J. Teal	MC - 14C	Bm - P	

COUNTY Wood DATE Mar 1, 1971
 S. R. 51 WEATHER Sunny cloudy-cool
 SEC. _____ TEMP. 35° ± +48

DESCRIPTION References To Control Points - S.R. 51 (Woodville Rd) JOB NO. 02837 (C)

LEFT CENTER LINE RIGHT

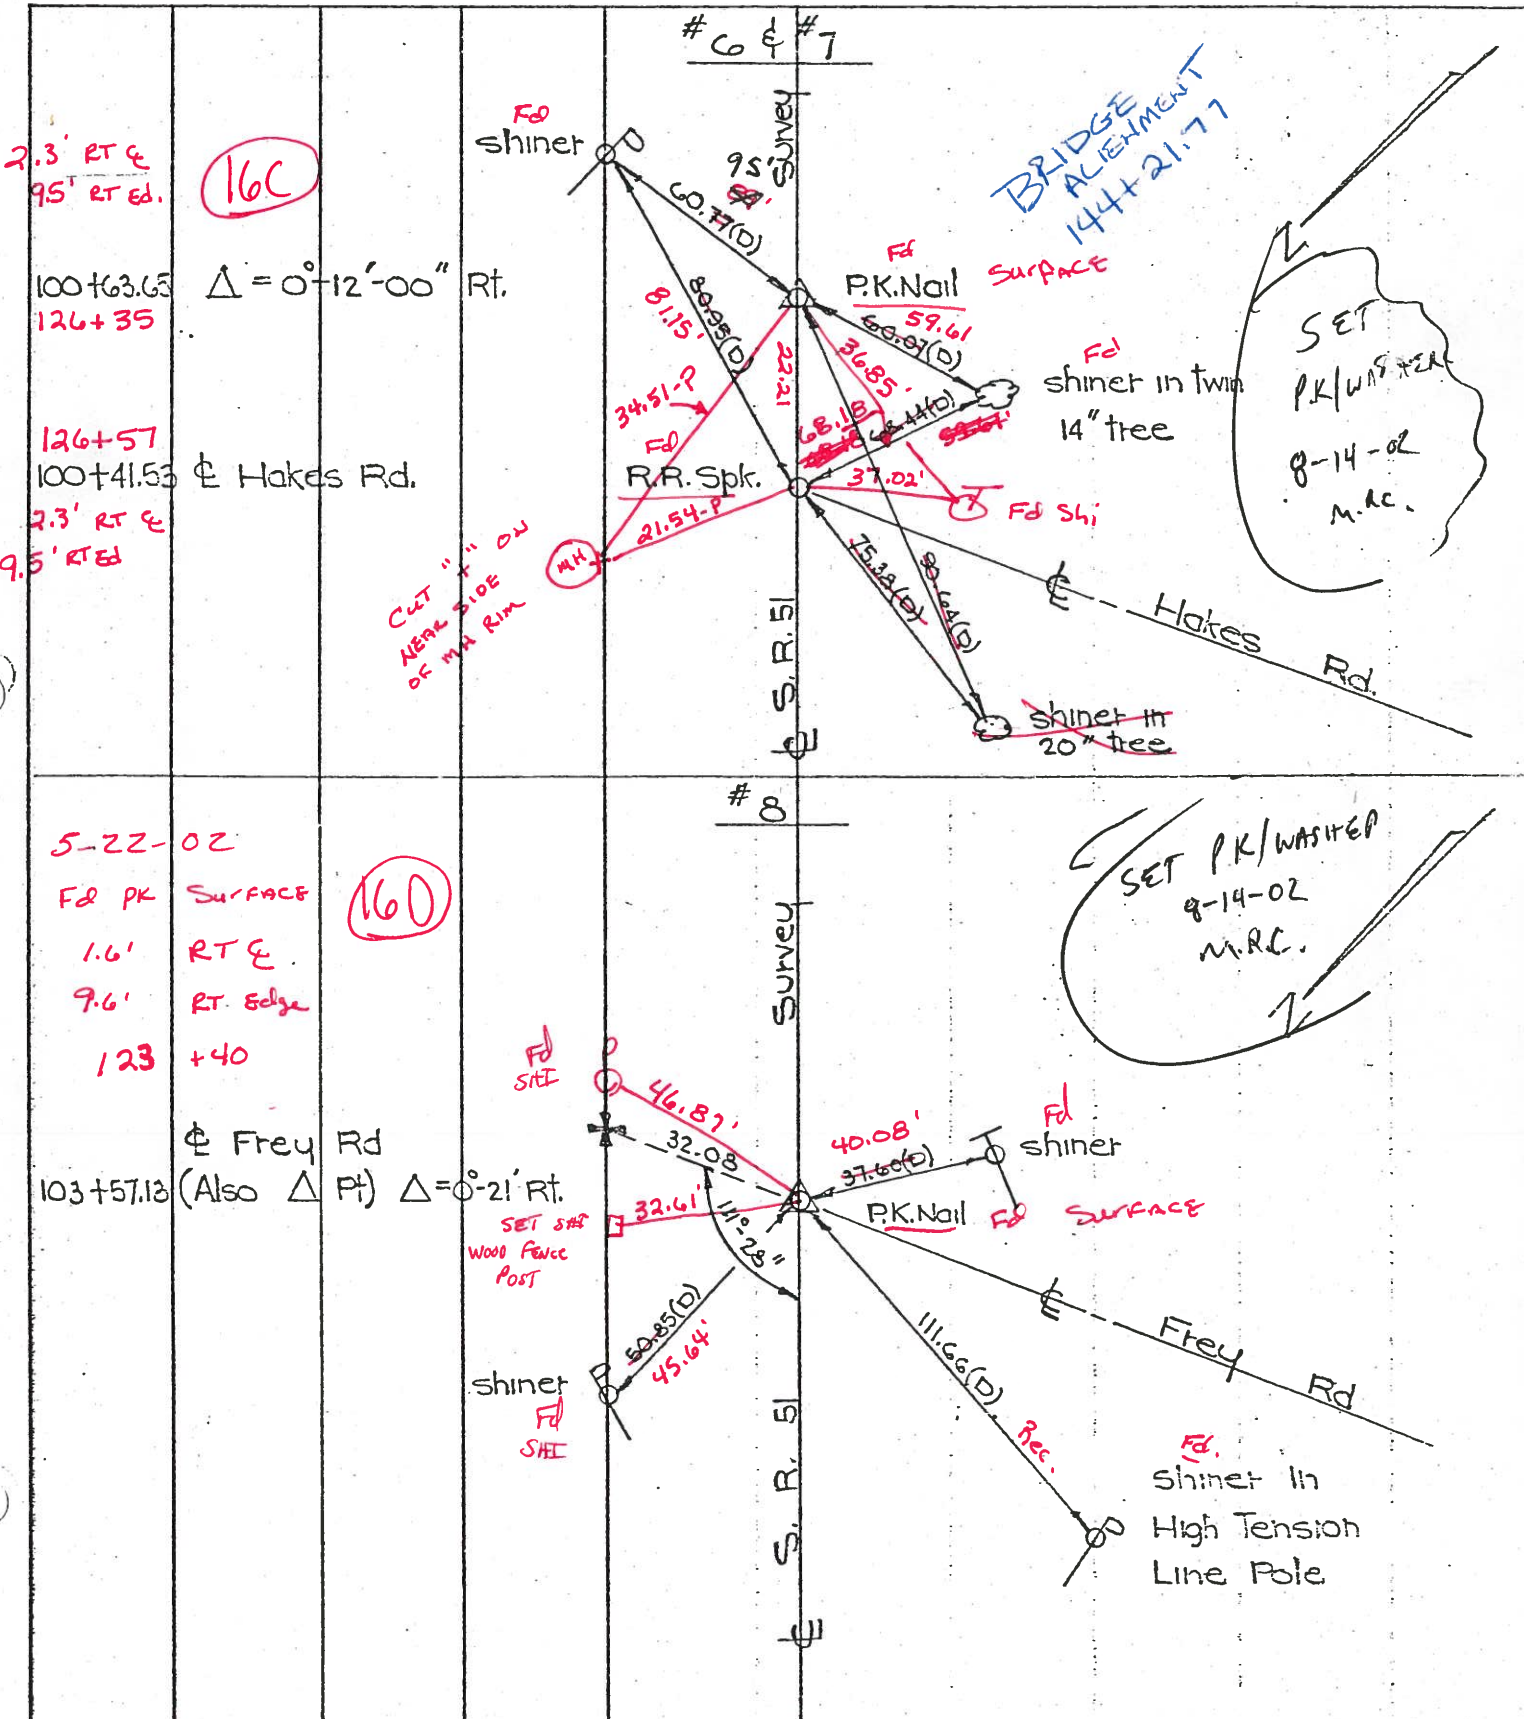

O.D.O.T. DISTRICT 2 SURVEY OFFICE

PERSONNEL

REFERENCE NO. 16-C


SHEET 5 OF

NOTES 1. Stone
 H.C. D. Curtis
 R.C. J. Householder
R. Michalok


DATE 25 Feb. 86
 WEATHER Cool
 TEMP. 26°

ROUTE SR#51
 COUNTY Wood
 TOWNSHIP Loke
 SECTION 2
T 7 N R 12 E

TYPE MONUMENT A = Spk. B = PK Nail
 ON SURFACE - BELOW Surface
 LEFT - <math>\text{C}</math> PAW'T. - RIGHT
 TO EDGE PAVEMENT
 S.L.M. A = 144125 B = 144147

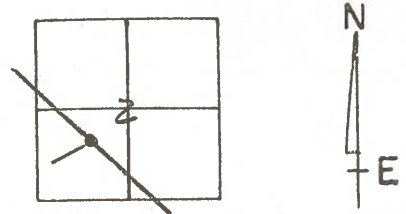

A = Set Small Spk. 10/12/88 IRS
B = Set PK Nail 10/12/88 IRS

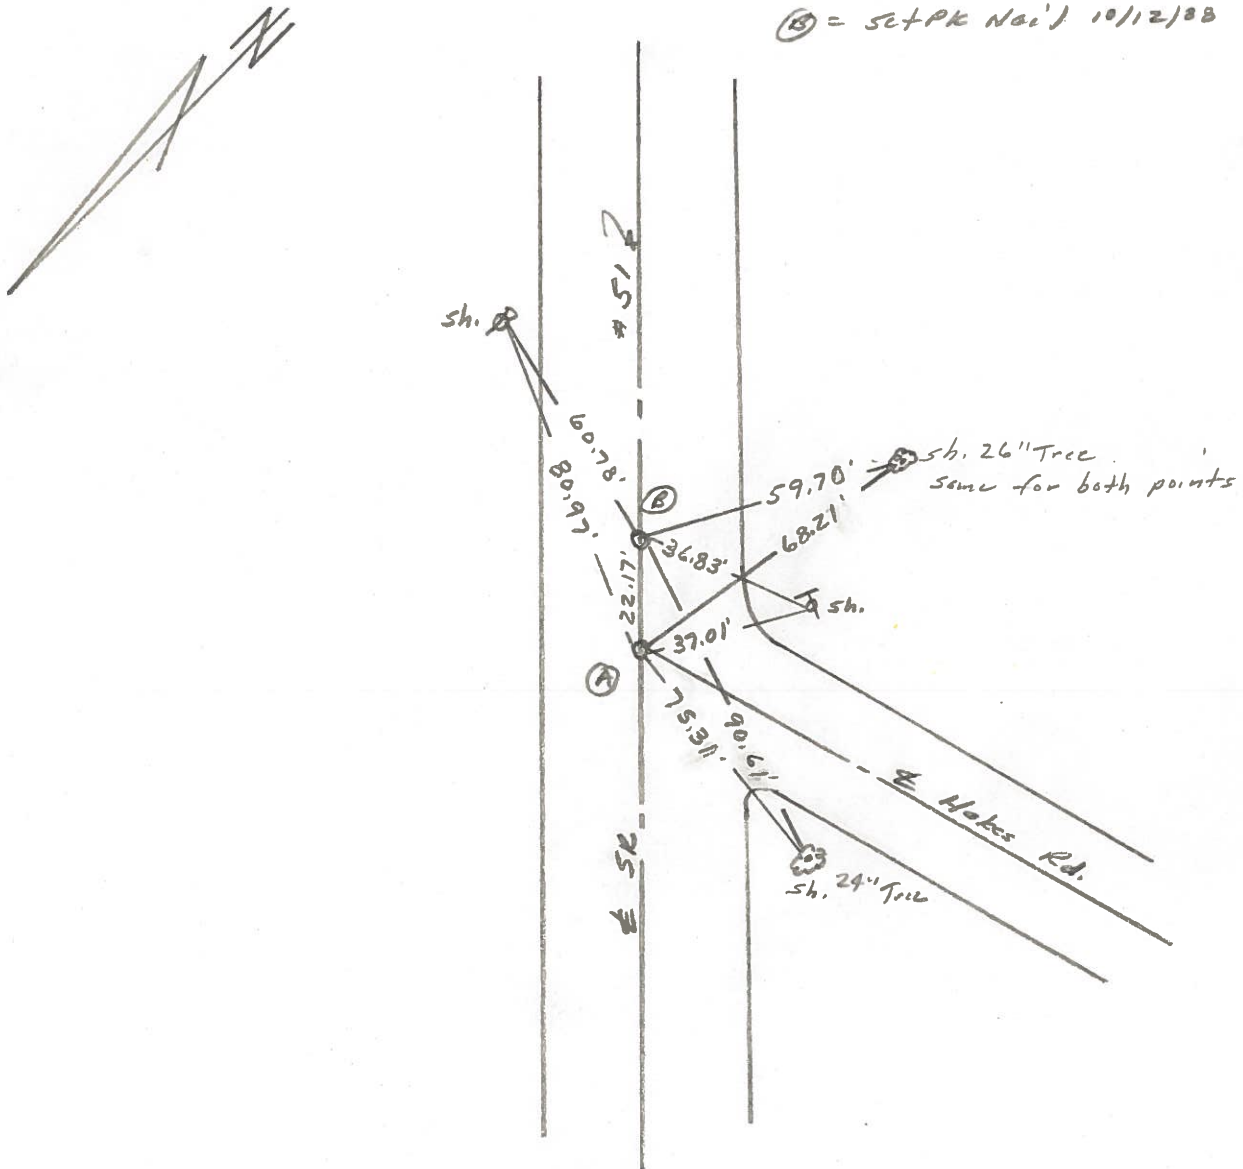

Q.D.O.T. DISTRICT 2 SURVEY OFFICE

Sht. 5 of 23
S.R.51

County WOOD

Date 6-8-78

Township _____



Weather CLOUDY

Section _____

Temp. +72°

T N, R E

Personnel BURNSIDE
SMITH
BOWERS
KNAPE
MEAD

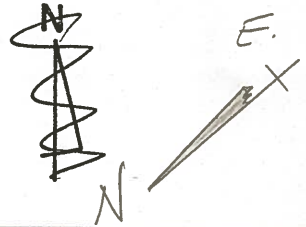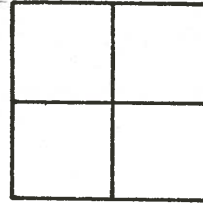

16-C

.65?
STA. 100+63.63
 $\Delta = 0^\circ - 12' - 00''$ Rt.
FD. P.K. NAIL @ SURFACE

STA. 100+41.53
HAKES ROAD
FD. P.R. SPK. @ SURFACE

