

O.D.O.T. DISTRICT 2 SURVEY OFFICE (USE ONLY)

PERSONNEL _____ REFERENCE NO. 15 A SHEET 26 OF 30

NOTES	<u>BARNHISEL</u>	DATE	<u>5/22/02</u>	ROUTE	<u>SR 51</u>
H.C.	<u>CANTERBURY</u>	WEATHER	<u>SUNNY</u>	COUNTY	<u>WOOD</u>
R.C.	<u>BRUMBAUGH</u>	TEMP.	<u>55°</u>	TOWNSHIP	<u>LAKE</u>
	<u>MALINSKI</u>			SECTION	<u>2</u>
				T	<u>7</u> N R <u>12</u> E

TYPE MONUMENT R.R. SPIKE


ON SURFACE - ~~BELOW~~ ON _____

~~LEFT~~ - CL PAV'T - RIGHT 3.2'


- TO - EDGE PAVEMENT

S.L.M. 144+75

GRID: NORTHING: - EASTING: -

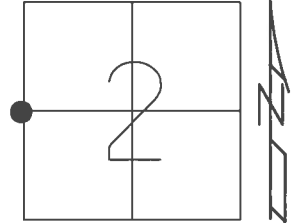

RECORD: 1971
 STA .82+26
 SET P.K./WASHER
 5/22/02, MB
 FD P.K./WASHER
 2016, DCH

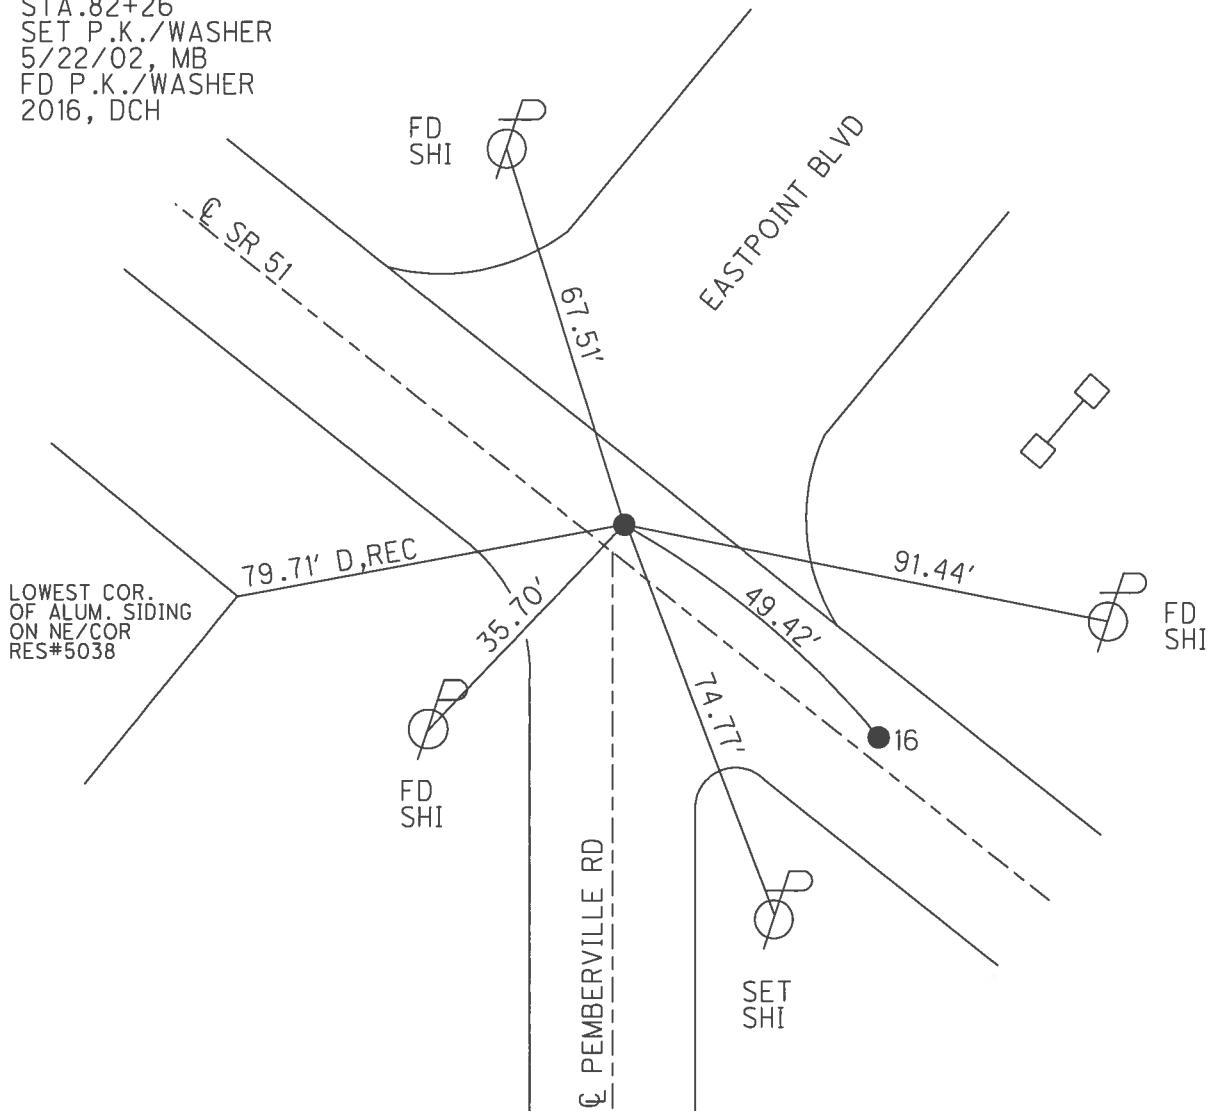

O.D.O.T. DISTRICT 2 SURVEY OFFICE

PERSONNEL

REFERENCE NO. 16

SHEET 22 OF 23

NOTES M. Bannhiser
 H.C. M. Canterbury
 R.C. C. Brambaugh
B. Malinski

DATE 5-22-02
 WEATHER Sunny
 TEMP. +55° F

ROUTE SR-51
 COUNTY Wood
 TOWNSHIP Lake
 SECTION _____
T 7 N R 12 E


TYPE MONUMENT (A) RR. Spk. (B) PK/W

ON SURFACE BELOW ON Surface


LEFT- & PAV'T. - (RIGHT) 3.2" (A) (B)

TO _____ EDGE PAVEMENT

S.L.M. (A) 144+75 (B) 144+25

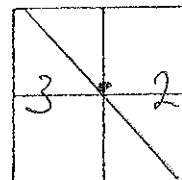

Set PK/W
Both Pts.
MB/SAH
5-22-02

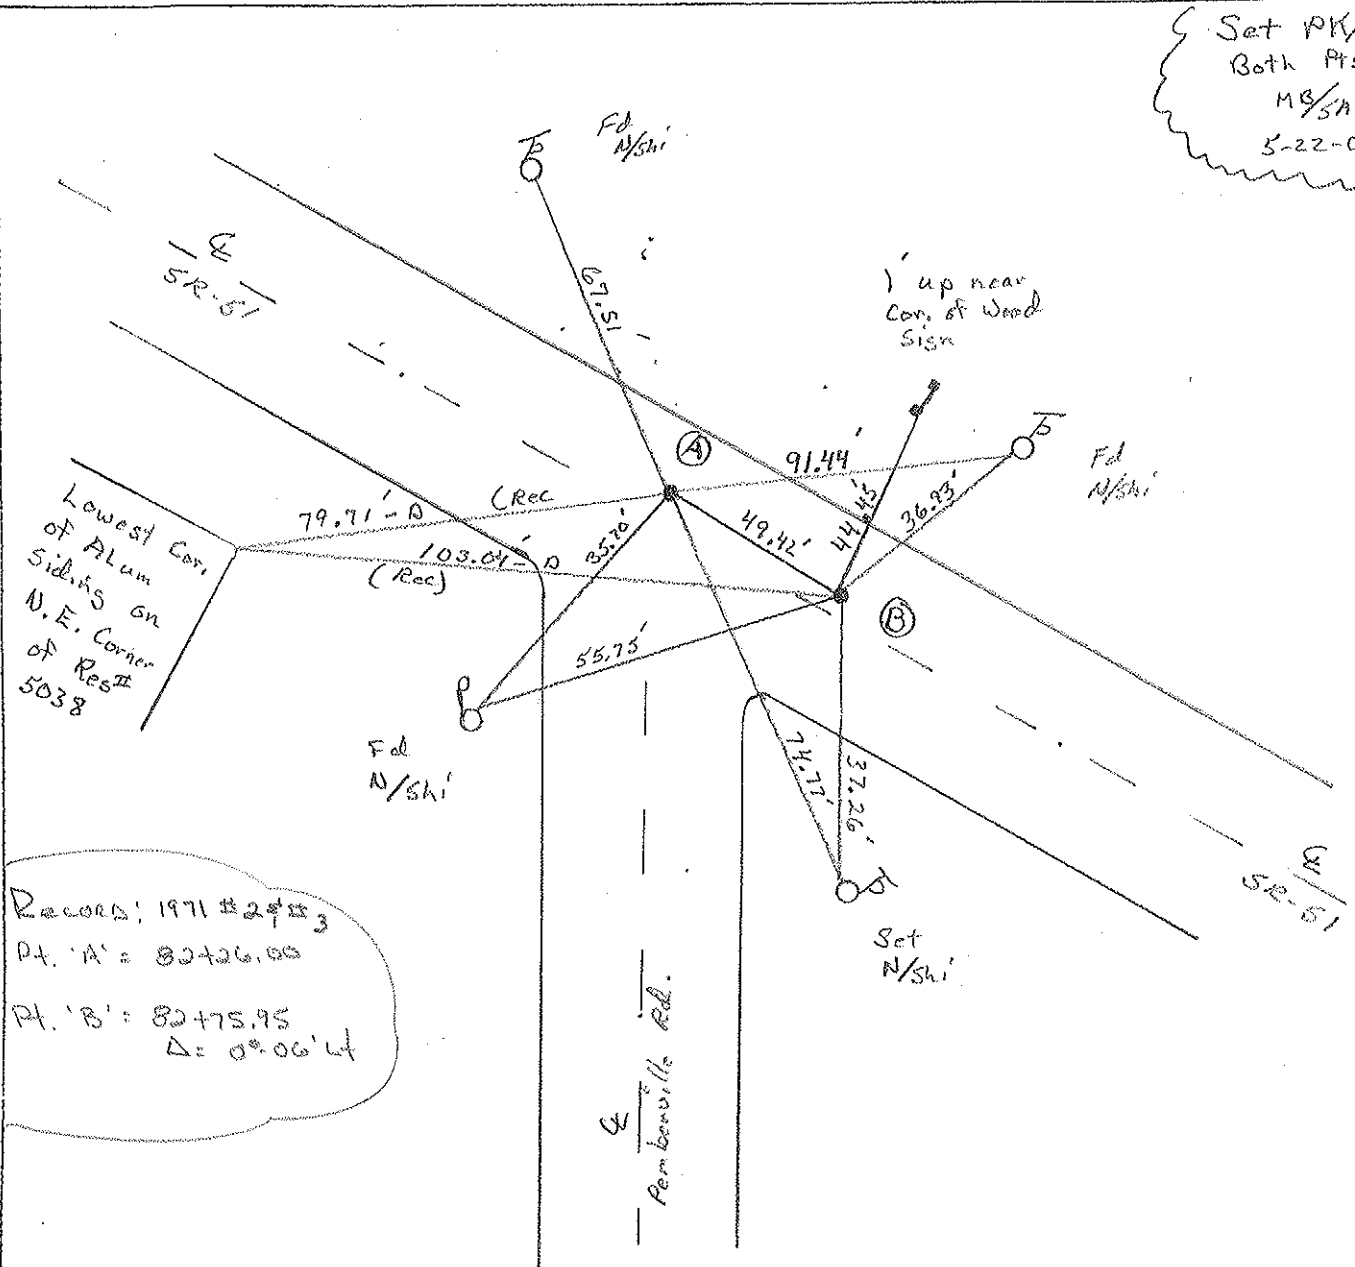

RECORD: 1971 #2453
 Pt. 'A': 82+26.00
 Pt. 'B': 82+75.95
 Δ = 0° 06' 44"