


O.D.O.T. DISTRICT 2 SURVEY OFFICE (USE ONLY)


PERSONNEL _____ REFERENCE NO. 12 SHEET 19 OF 22
 NOTES BARNHISEL/HUSS DATE 4/18/03 ROUTE SR 51
 H.C. CANTERBURY WEATHER CLOUDY COUNTY WOOD
 R.C. RYALL TEMP. 55° TOWNSHIP NORTHWOOD
GLASS/BEAMONT SECTION 34
 DWG BY NIESE PID _____ T 8 N R 12 E

TYPE MONUMENT P.K./WASHER
 ON SURFACE - ~~BELOW~~ ON
 OFFSET \odot PAVEMENT ON LT : RT
27.0' TO LT EDGE PAVEMENT
 STATION: 196+34

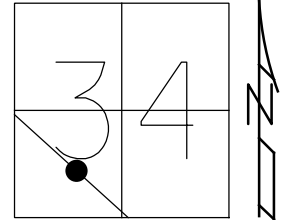

HORZ.DATUM: _____ GEOID: _____
 GRID: NORTHING: _____ EASTING: _____

RECORD:
 FD P.K./WASHER
 4/18/03, MB
 SET MAG/WASHER
 3/29/04, MB

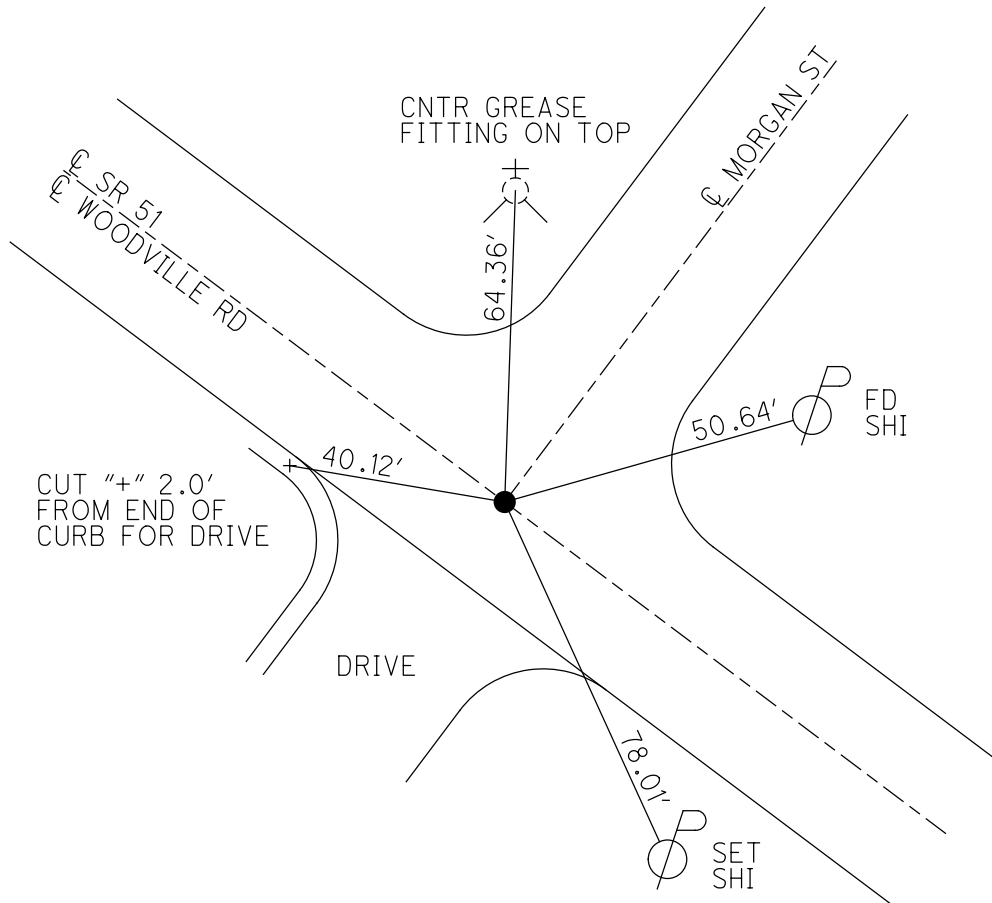

O.D.O.T. DISTRICT 2 SURVEY OFFICE

PERSONNEL

REFERENCE NO. 12

SHEET 6 OF 15

NOTES BARNHISEL / HUSS

H.C. CANTERBURY

DATE 4-18-03

ROUTE S.R. # 51

R.C. RYALL

WEATHER CLOUDY

COUNTY WOOD

GLASS

TEMP. + 55°

TOWNSHIP _____

BEAMONT

SECTION 34

T 8 N R 12 E


TYPE MONUMENT P.K. + WASHER

ON SURFACE - ~~BELOW~~ SURFACE


LEFT - ~~PAV'T.~~ RIGHT ON E

27 TO LT EDGE PAVEMENT

S.L.M. 196 + 34

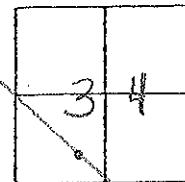

Set Mas/w
3-29-04
M.B.

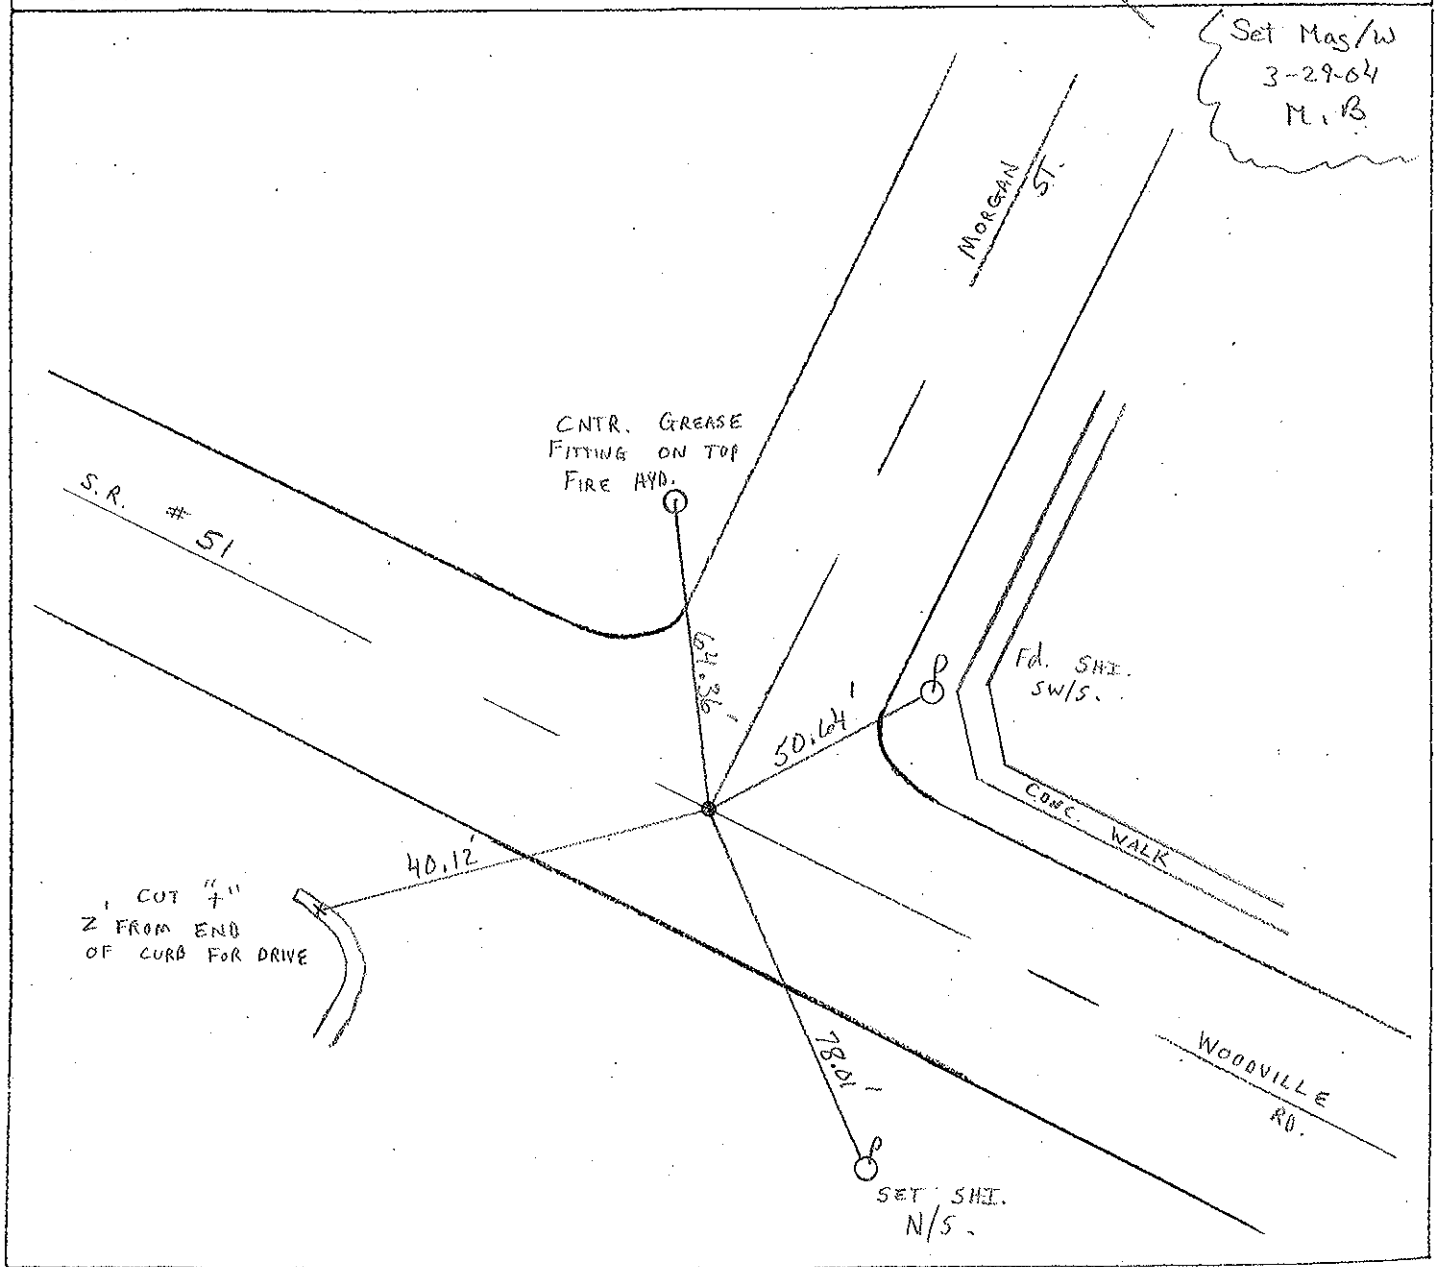

O.D.O.T. DISTRICT 2 SURVEY OFFICE

PERSONNEL

REFERENCE NO. 12

SHEET 6 OF 15

NOTES R. Cheney

H.C. R. Barbour

R.C. V. Ripple

R. Geyman

DATE 11-6-91

WEATHER Cloudy

TEMP. 35°

ROUTE 51

COUNTY Wood

TOWNSHIP LAKE

SECTION 34

T 8 N R 12 E



TYPE MONUMENT P.K. Washer

~~ON SURFACE~~ - BELOW P.K.

~~LEFT & PAV'T.~~ - RIGHT 1.5'

27' TO LT. EDGE PAVEMENT

S.L.M. 196 + 34

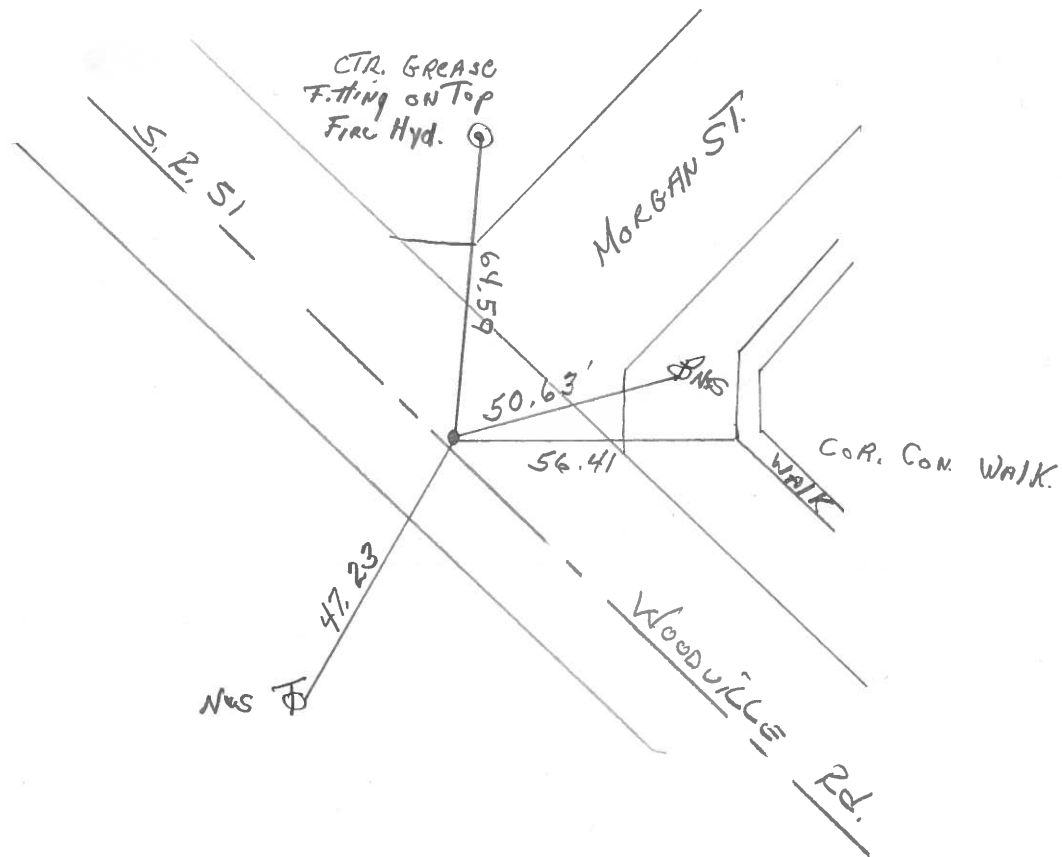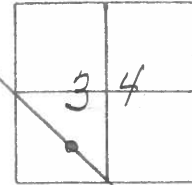

O.D.O.T. DISTRICT 2 SURVEY OFFICE

SHEET

OF

County WOOD S.R. 51

Township NORTHWOOD, OHIO

Section 34

T8N, R12E

Personnel BURNSIDE

SMITH


BOWERS

MEAD


Date 4-6-77

Weather CLOUDY

Temp. 35°

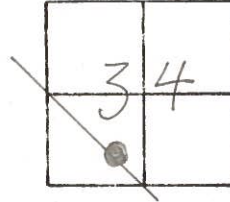

#12

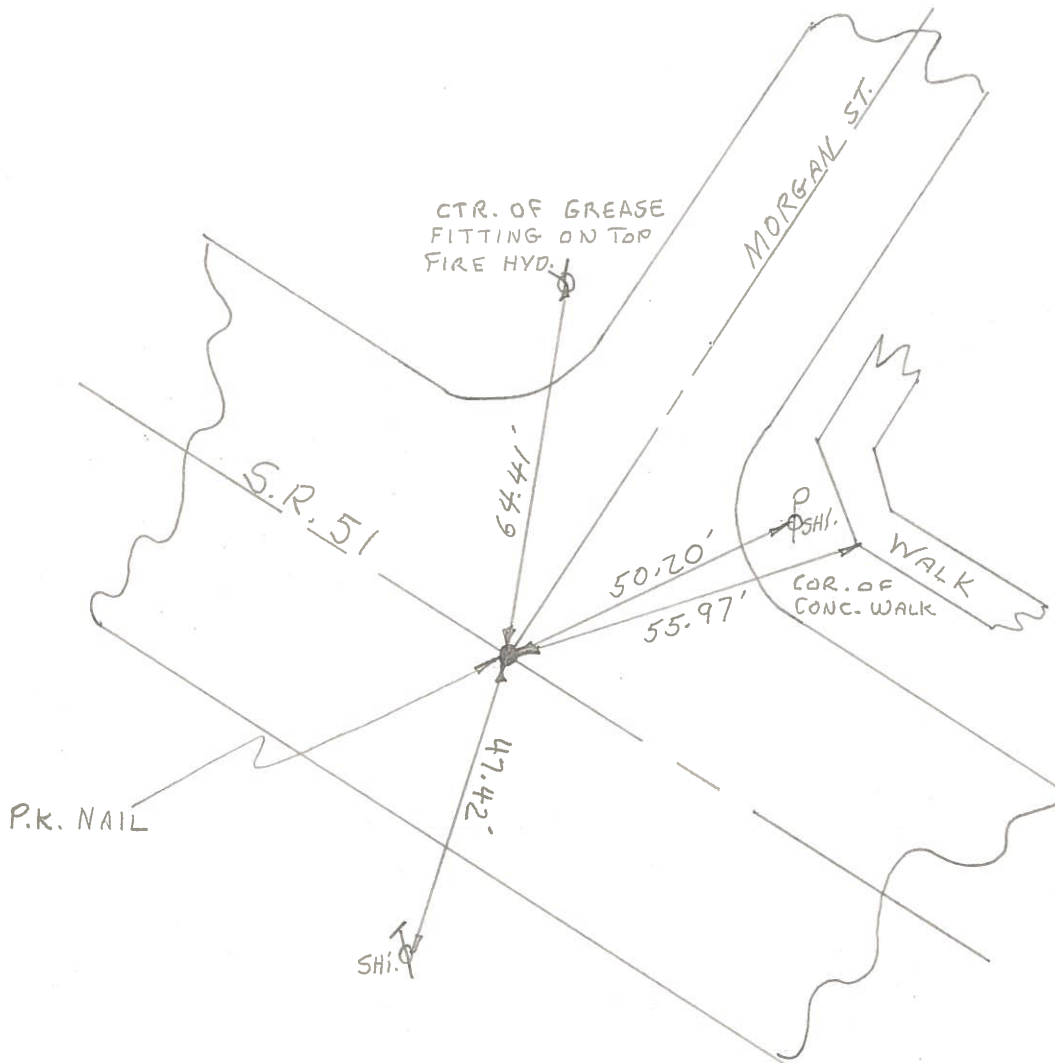

PERSONNEL TITLE PERSONNEL TITLE

COUNTY Wood DATE - - 61

S. R. # 120 51 WEATHER

SEC. TEMP.

DESCRIPTION LEFT CENTER LINE RIGHT JOB NO.

