


O.D.O.T. DISTRICT 2 SURVEY OFFICE (USE ONLY)

PERSONNEL _____ REFERENCE NO. 7 B SHEET 10 OF 13
 NOTES RHOADES DATE 4/23/18 ROUTE SR 51
 H.C. O'DONNELL WEATHER FAIR COUNTY WOOD
 R.C. RHOADES TEMP. 46° TOWNSHIP NORTHWOOD
 _____ SECTION 33
 _____ T 8 N R 12 E


TYPE MONUMENT MONBOX W/ 3/4" IPIN
 ON SURFACE - ~~BELOW~~ ON
 LEFT - ☉ PAV'T - RIGHT ON
- TO - EDGE PAVEMENT
 S.L.M. 225+06

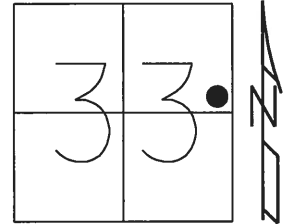

Grid: Northing: 709522.167 Easting: 1701476.003

NOTE:
NO TIES WERE PULLED

RECORD:
FD MONBOX
W/ 3/4" IPIN
REFB7
4/23/18, JFO

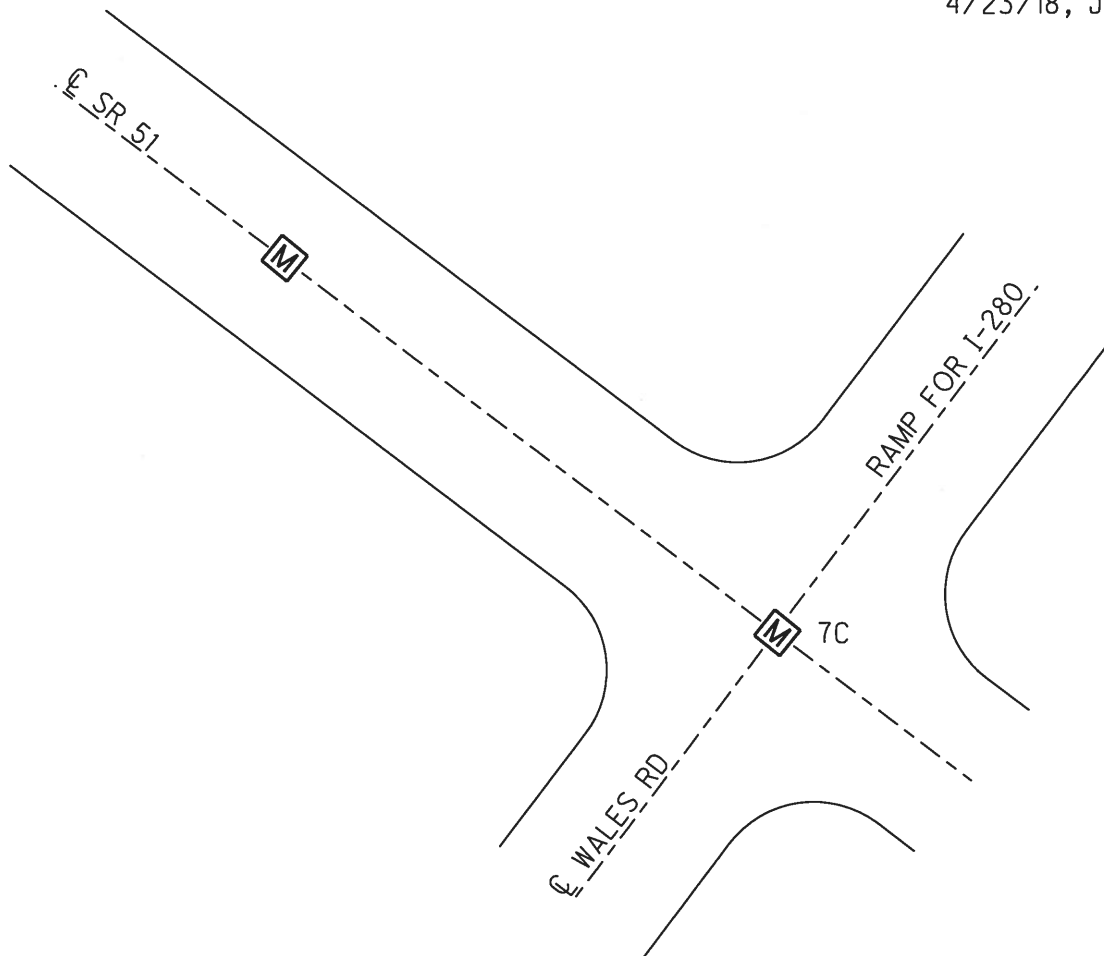

DIST. 7B-7C= 165.62'

PERSONNEL TITLE PERSONNEL TITLE

COUNTY Wood

DATE

S. R. #120 51

WEATHER

SEC.

TEMP.

DESCRIPTION

LEFT

CENTER LINE

RIGHT

JOB NO.

Sta. 35+47.48

Harding Ave.
masonry
Tack.

S.W. cor. 1-S
Fr. Res. 205
Woodville

65.85'

69.48'

75.18'

phi shi.

889

S.E. cor.
Cement block Garage

$\frac{37+57}{44}$

2" L Iron set in conc. post
meas. to L

86.89'

52.27' phi

Sta. 36+82.43

Buhl Ave.

#

890

95.40'

phi shi.

phi shi.

95.17'

34.42' phi shi.

Sta. 53+00.54

Wales Rd.
masonry tack.

#

891

62.50'

phi shi.

Sta. 54+56.58

Lemoine Rd.
masonry tack

892

83.04'

65.00'

phi shi.

98.45'

X-in conc. base Play
pole Olney school