


O.D.O.T. DISTRICT 2 SURVEY OFFICE (USE ONLY)

PERSONNEL \_\_\_\_\_ REFERENCE NO. 7 C SHEET 11 OF 13  
 NOTES RHOADES DATE 4/23/18 ROUTE SR 51  
 H.C. O'DONNELL WEATHER FAIR COUNTY WOOD  
 R.C. RHOADES TEMP. 46° TOWNSHIP NORTHWOOD  
 \_\_\_\_\_ SECTION 33  
 \_\_\_\_\_ T 8 N R 12 E


TYPE MONUMENT MONBOX W/ 3/4" IPIN  
 ON SURFACE - ~~BELOW~~ ON  
 LEFT - ☉ PAV'T - RIGHT ON  
- TO - EDGE PAVEMENT  
 S.L.M. 223+40

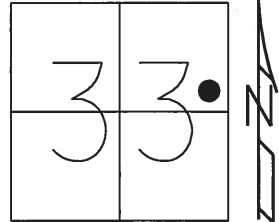

Grid: Northing: 709411.641 Easting: 1701599.340

NOTE:  
NO TIES WERE PULLED

RECORD:  
FD MONBOX  
W/ 3/4" IPIN  
REFB7  
4/23/18, JFO

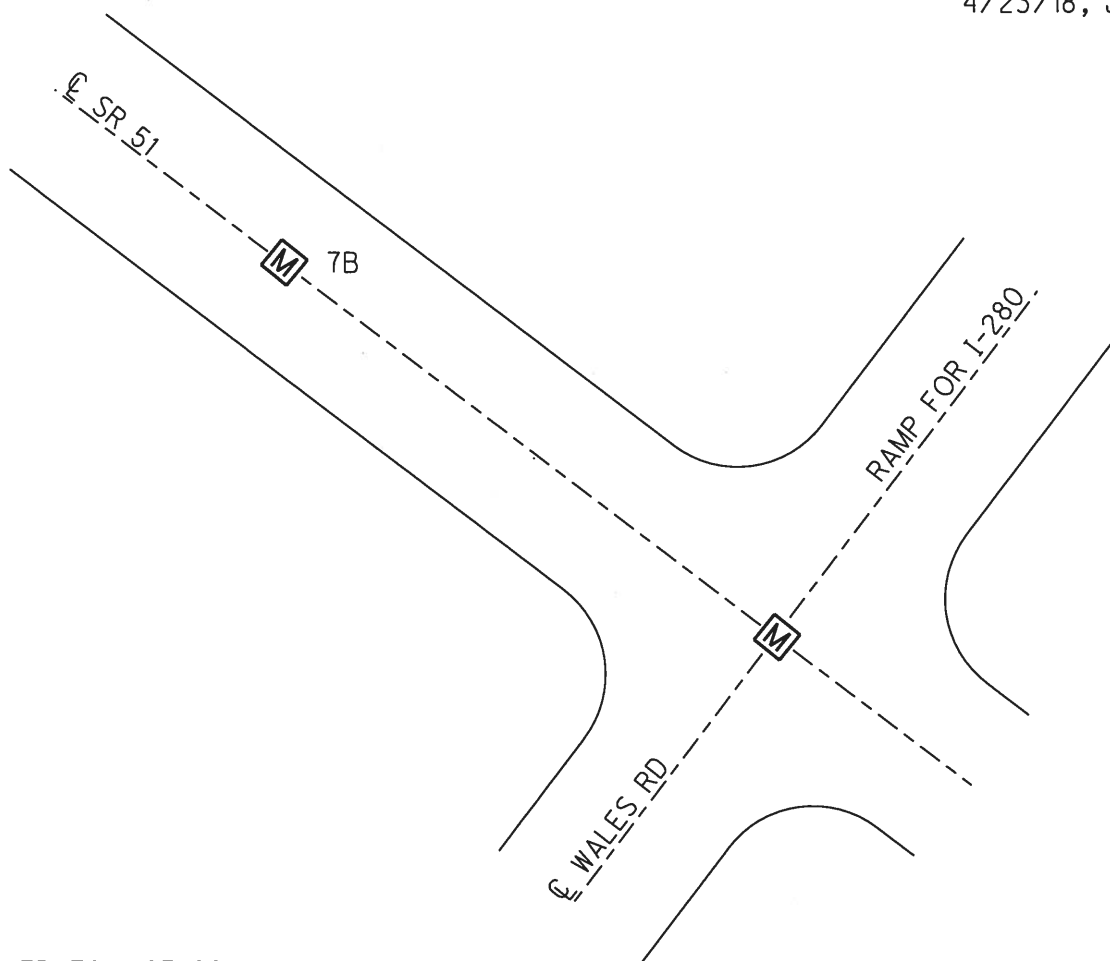

DIST. 7B-7C= 165.62'

PERSONNEL TITLE PERSONNEL TITLE

COUNTY Wood

DATE

S. R. #120 51

WEATHER

SEC.

TEMP.

DESCRIPTION

LEFT

CENTER LINE

RIGHT

JOB NO.

Sta. 35+47.48

Harding Ave.  
masonry  
Tack.

S.W. cor. 1-S  
Fr. Res. 205  
Woodville

65.85'

69.48'

75.18'

phi shi.

#889

S.E. cor.  
Cement block Garage

$\frac{37+57}{44}$

2" L Iron set in conc. post  
meas. to L

86.89'

52.27' phi

Sta. 36+82.43

Bihl Ave.

#890

95.40'

phi shi.

Sta. 53+00.54

Wales Rd.  
masonry tack.

#891

phi shi.

95.17'

34.42' phi shi.

62.50'

phi shi.

Sta. 54+56.58

Lemoine Rd.  
masonry tack

#892

phi 83.04

65.00'

phi shi.

98.45'

phi X-in conc. base Play  
pole Olney school