



DATE OF COMPLETION JULY 9, 2002

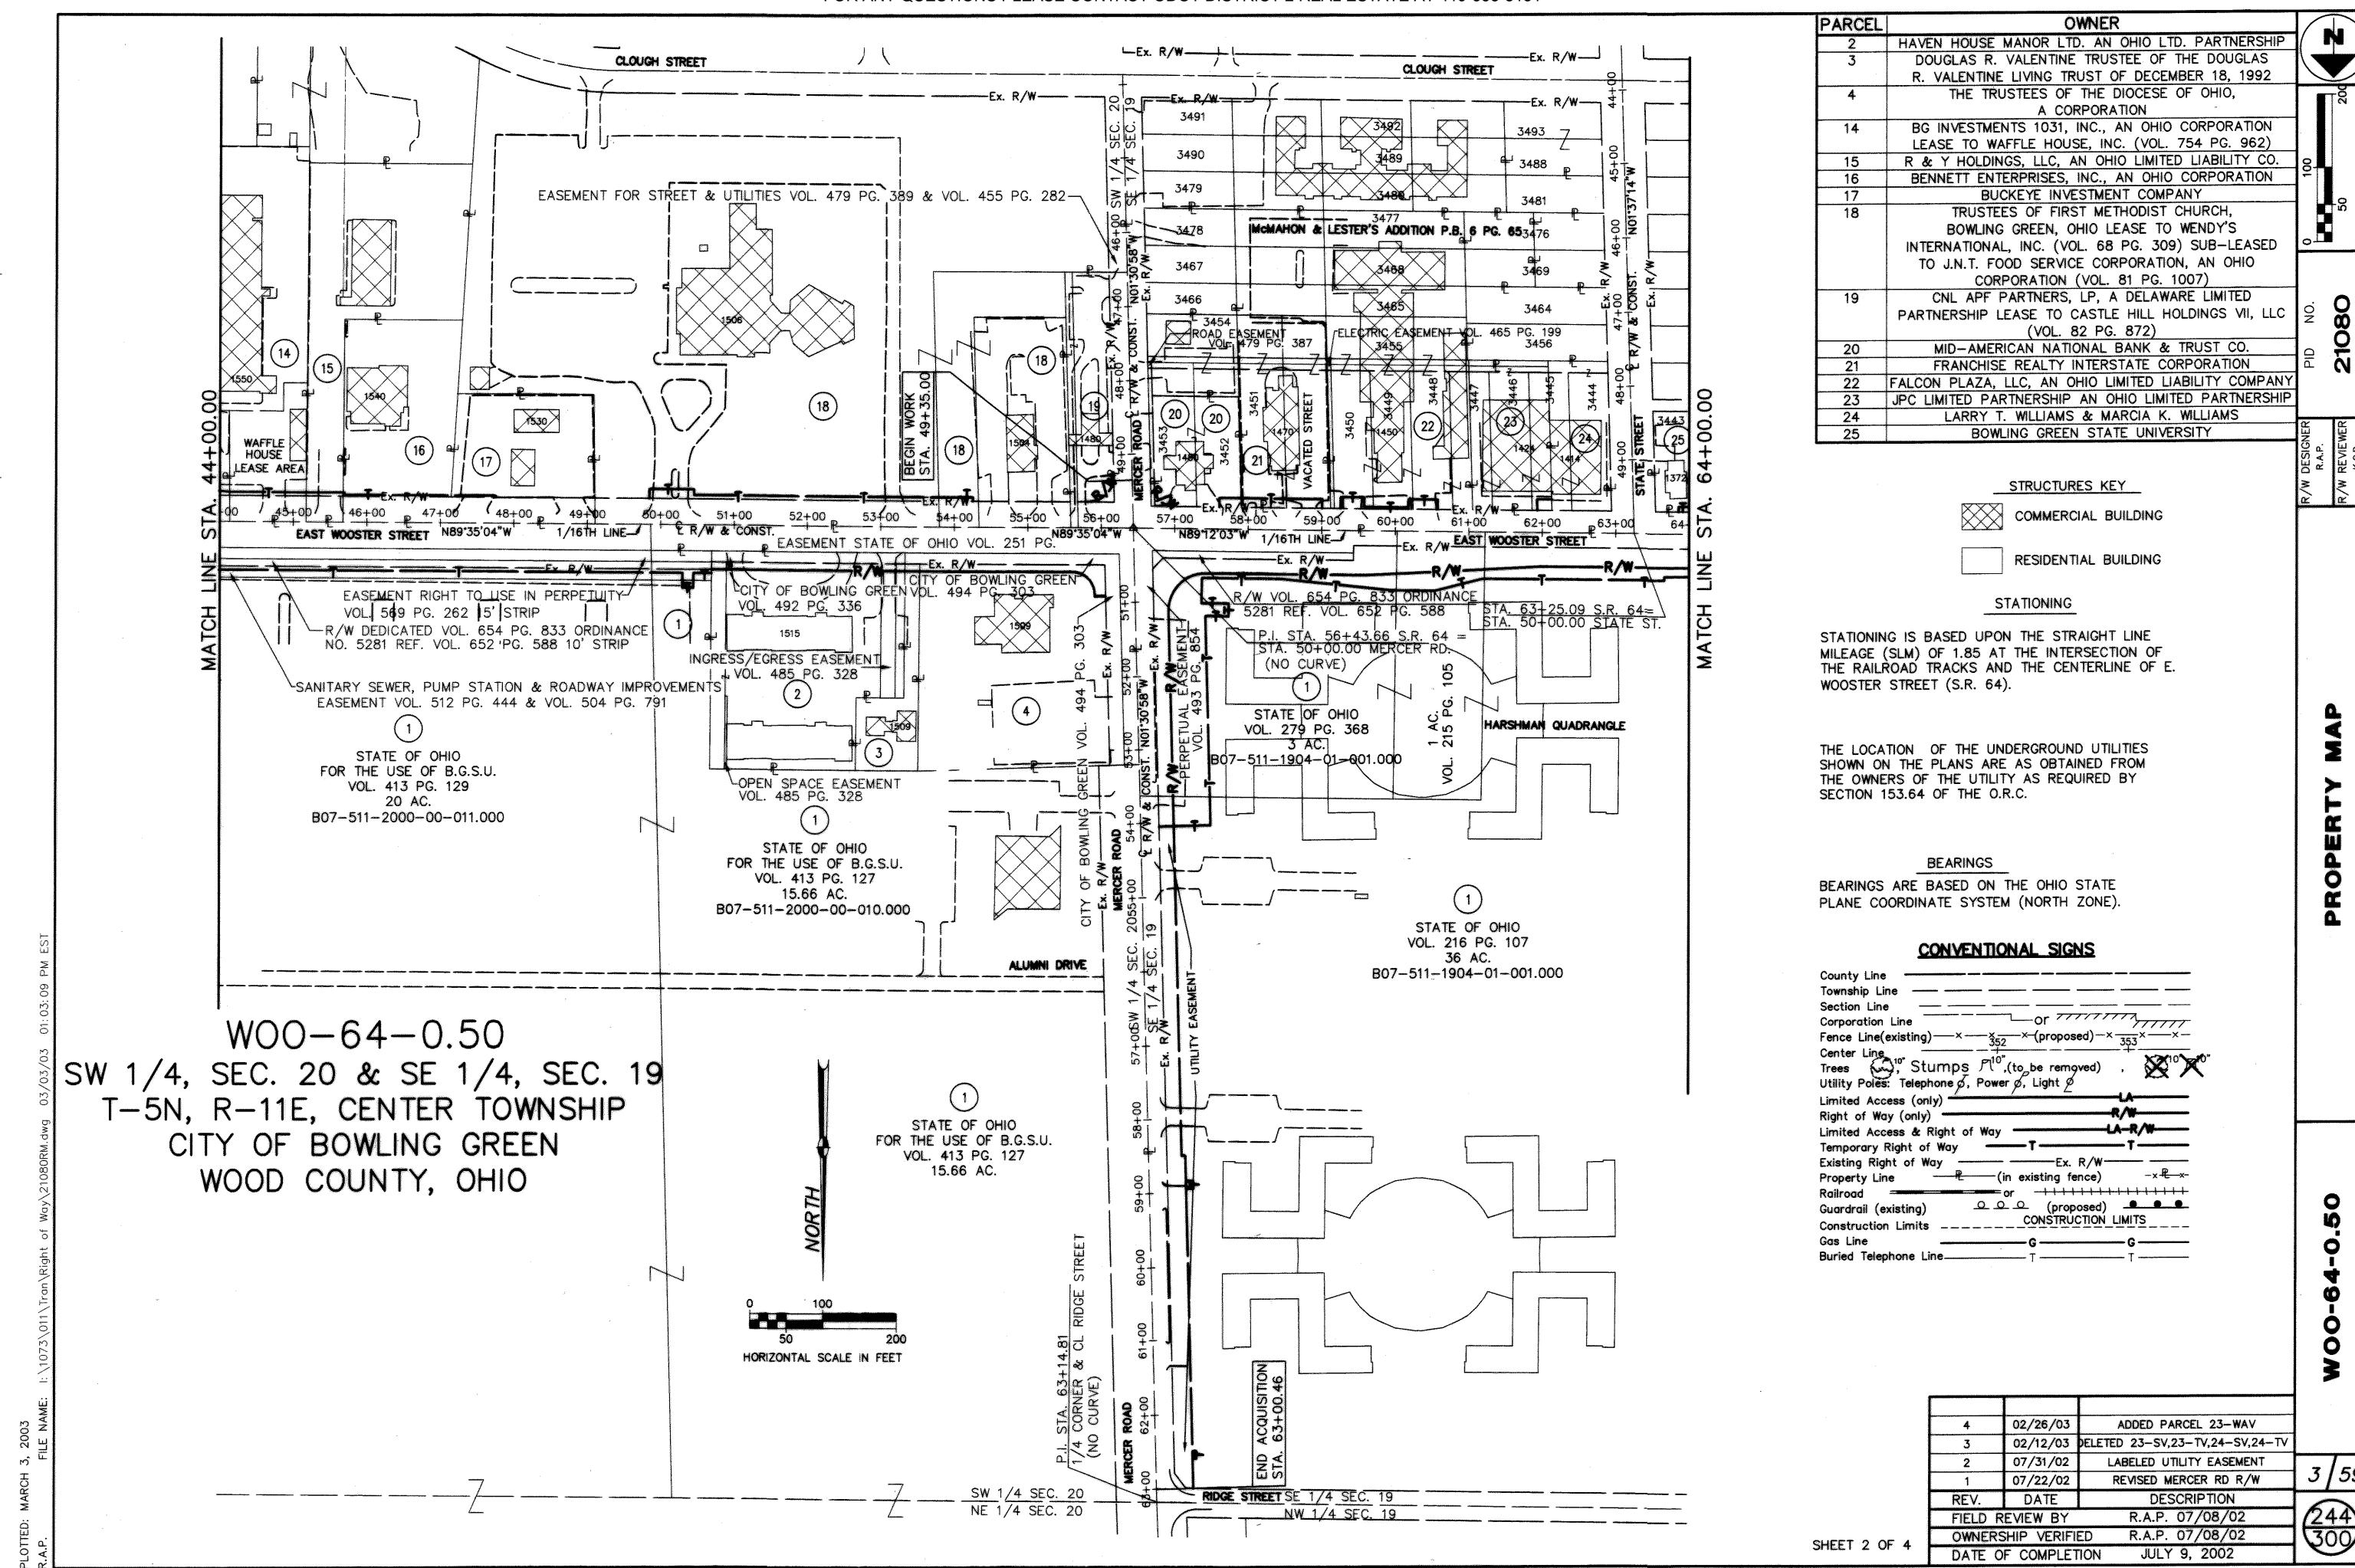

1073-011

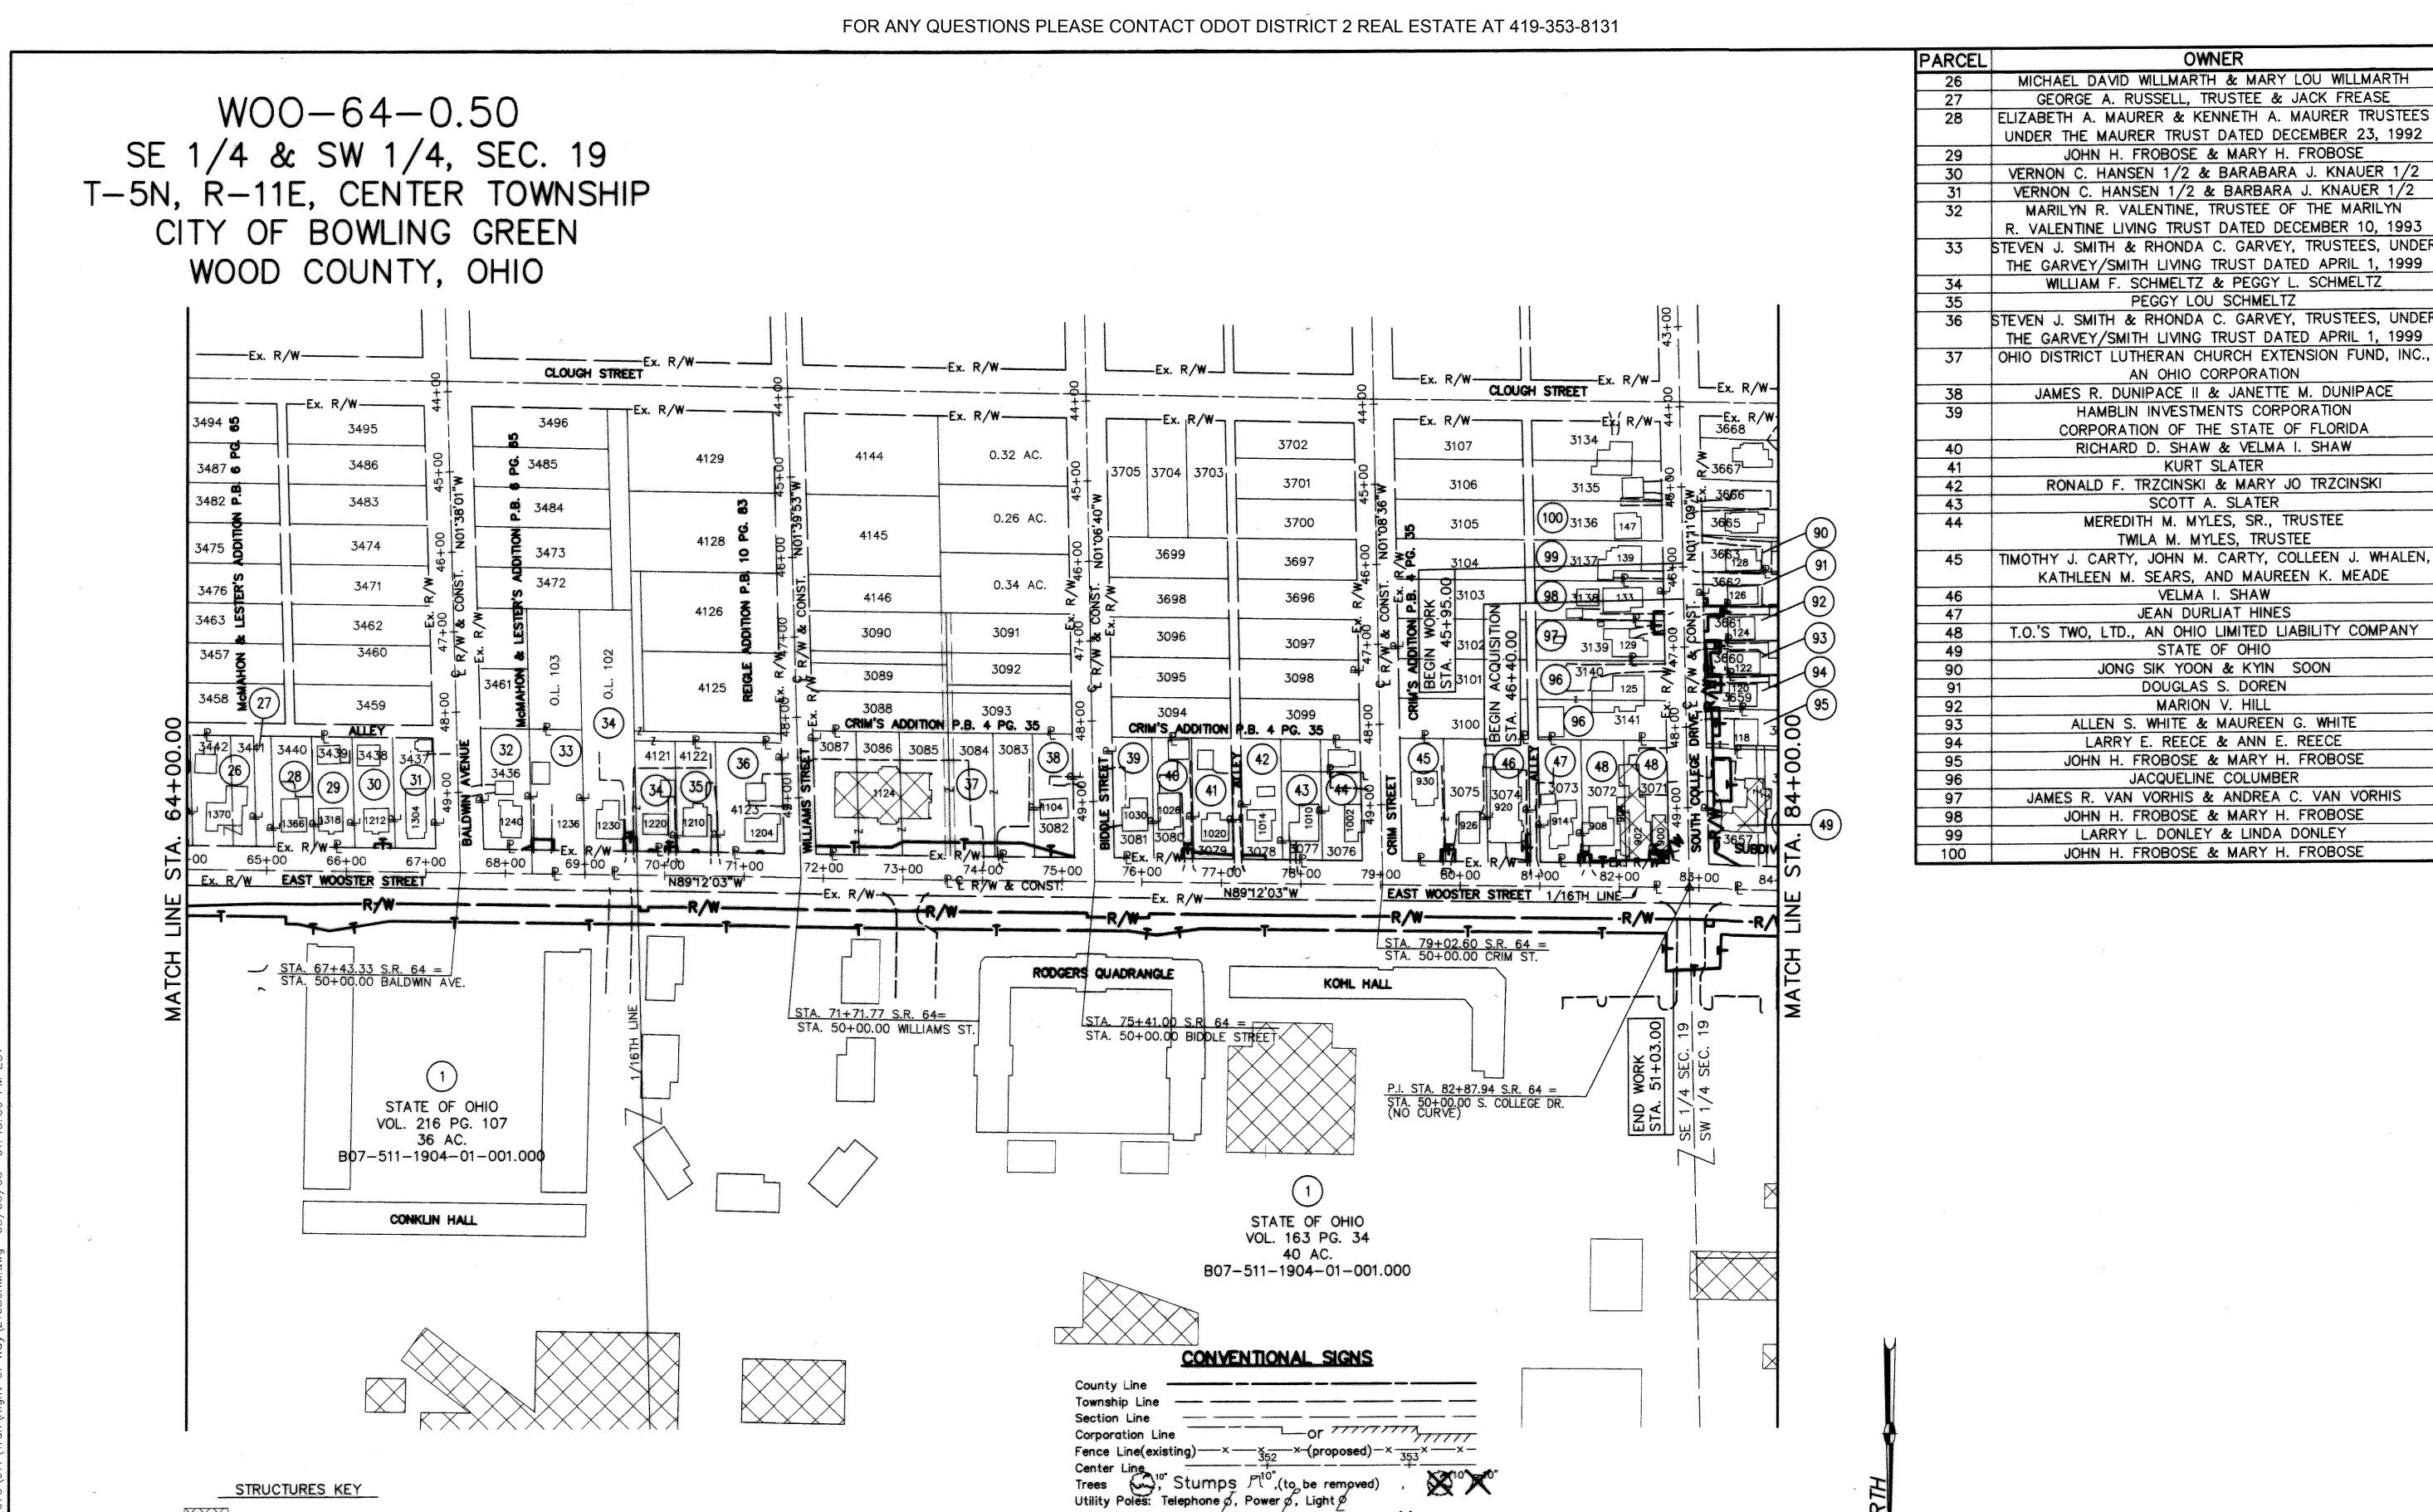

Limited Access (only) Right of Way (only)

Limited Access & Right of Way -

(in existing fence)

OOO (proposed)

STRUCTURES KEY COMMERCIAL BUILDING

RESIDENTIAL BUILDING

STATIONING

STATIONING IS BASED UPON THE STRAIGHT LINE MILEAGE (SLM) OF 1.85 AT THE INTERSECTION OF THE RAILROAD TRACKS AND THE CENTERLINE OF E. WOOSTER STREET (S.R.

THE LOCATION OF THE UNDERGROUND UTILITIES SHOWN ON THE PLANS ARE AS OBTAINED FROM THE OWNERS OF THE UTILITY AS REQUIRED BY SECTION 153.64 OF THE O.R.C.

BEARINGS BEARINGS ARE BASED ON THE OHIO STATE


PLANE COORDINATE SYSTEM (NORTH ZONE).

HORIZONTAL SCALE IN FEET

SHEET 3 OF 4

REVISED OWNER PARCELS 30 & 31 02/13/03 REVISED OWNER 98 12/20/02 REV. DESCRIPTION DATE FIELD REVIEW BY R.A.P. 07/08/02 R.A.P. 07/08/02 OWNERSHIP VERIFIED JULY 9, 2002 DATE OF COMPLETION

W00-64-0.50SW 1/4, SECTION 19 T-5N, R-11E, CENTER TOWNSHIP CITY OF BOWLING GREEN WOOD COUNTY, OHIO

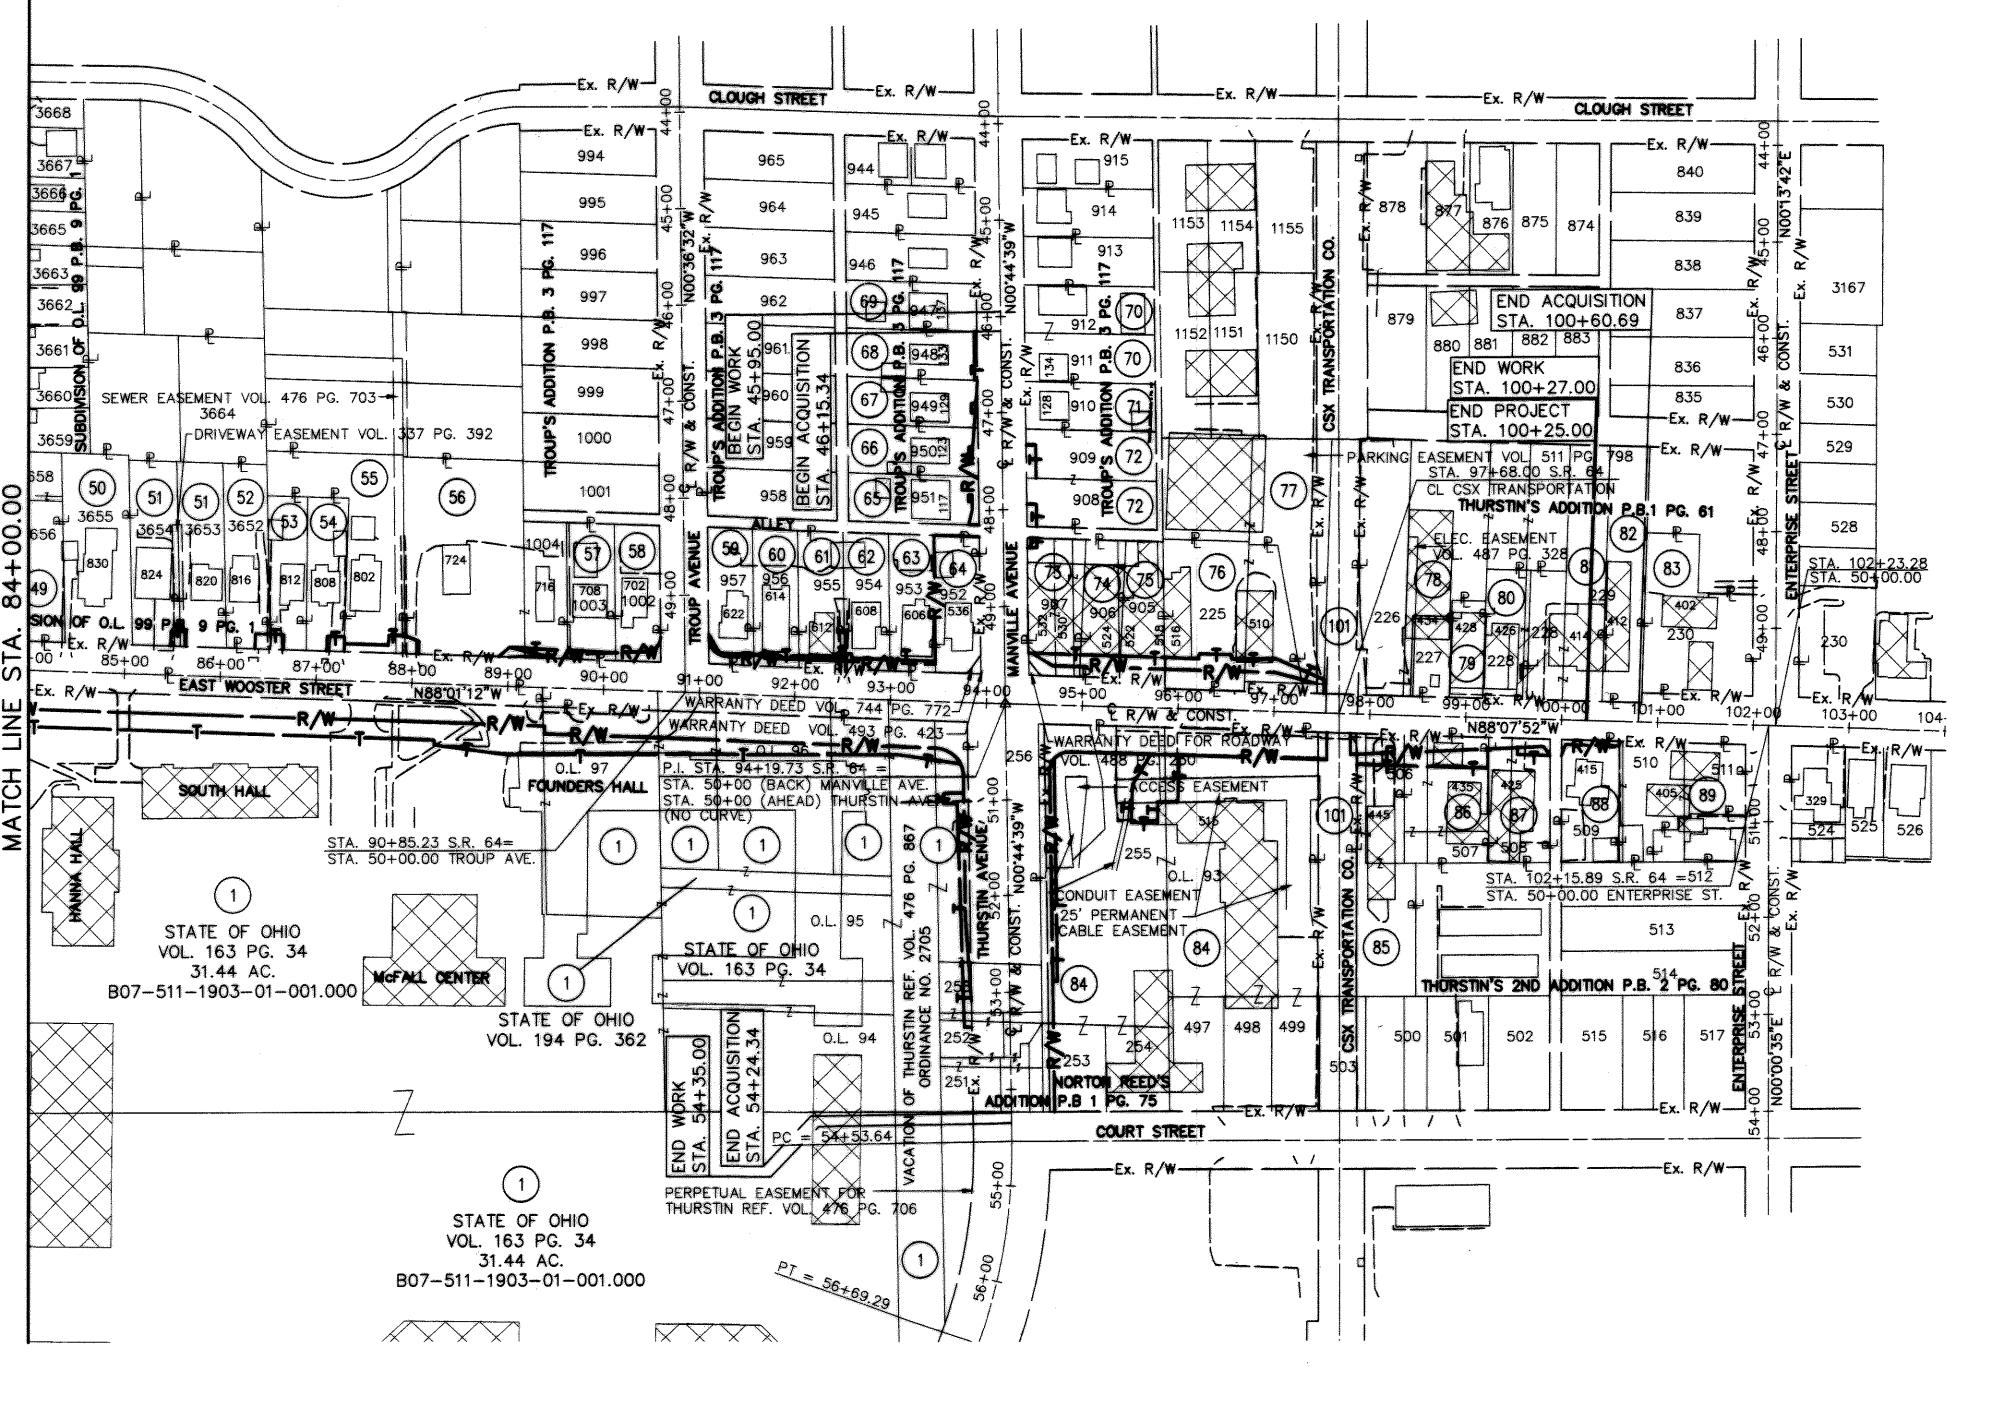

STRUCTURES KEY

COMMERCIAL BUILDING

RESIDENTIAL BUILDING

STATIONING

STATIONING IS BASED UPON THE STRAIGHT LINE MILEAGE (SLM) OF 1.85 AT THE INTERSECTION OF THE RAILROAD TRACKS AND THE CENTERLINE OF E. WOOSTER STREET (S.R.

THE LOCATION OF THE UNDERGROUND UTILITIES SHOWN ON THE PLANS ARE AS OBTAINED FROM THE OWNERS OF THE UTILITY AS REQUIRED BY SECTION 153.64 OF THE O.R.C.

BEARINGS

BEARINGS ARE BASED ON THE OHIO STATE PLANE COORDINATE SYSTEM (NORTH ZONE).

49	OWNER	1
	STATE OF OHIO	1
50	MICHAEL D. LOCEY & LENITA C. LOCEY	ľ
51	SCOTT E. PAHL & SHARON K. PAHL	L
52	ROGER A. BOGGS	Γ
53	JORDAN SCMELTZ	
54	KYLE J. HERTZFELD & DALE A. HERTZFELD	
55	THOMAS M. CARPENTER & DIANA R. CARPENTER	
56	ALLEN A. GREEN, TRUSTEE & MARY D. GREEN, TRUSTEE	
57	JAAK PANKSEPP	1
58	RANDOLPH G. SCHMELTZ & JESSIE L. SCHMELTZ	1
	EYECON ENTERPRISES, LTD., AN OHIO LIMITED LIABILITY CO	1
60	JOSEF KEGLEWITSCH & VIVIAN KEGLEWITSCH	1
61	ACTIVE CHRISTIANS TODAY CAMPUS MINISTRY, INC.	t
	KRISTIE A. FOELL	t
62	JACK A. JONES, JAMES E. JONES, JR. & BRODY B. JONES	1
63	DEVIN DAUTERMAN	1
64		1
65	ELIZABETH A. MAURER & KENNETH A. MAURER, TRUSTEES	
, , , , , , , , , , , , , , , , , , ,	UNDER THE MAURER TRUST DATED DECEMBER 23, 1992	1
66	RONALD C. SMITH & RUTH C. SMITH, TRUSTEES	l
	SMITH LIVING TRUST, DATED APRIL 11, 1998	4
67	DOUGLAS S. DOREN	_
68	STEVEN J. SMITH & RHONDA C. GARVEY, TRUSTEES, UNDER	1
	THE GARVEY/SMITH LIVING TRUST DATED APRIL 1, 1999	ŀ
69	JOHN L. NEWLOVE & LYDIA J. NEWLOVE	1
70	JOHN L. NEWLOVE & LYDIA J. NEWLOVE	
71	EYECON ENTERPRISES, LTD., AN OHIO LIMITED LIABILITY CO	
72	CITY OF BOWLING GREEN, OHIO	
73	HAMBLIN INVESTMENTS CORPORATION,	
	CORPORATION OF THE STATE OF FLORIDA	Ī
74	KELLY S. HAMBLIN	1
75	CRAIG E. CHEETWOOD & BARBARA SPLETZER-CHEETWOOD	1
<del>76</del>	MEREDITH M. MYLES, JR. & BRIDGET A. MYLES	1
77	HAMBLIN INVESTMENTS CORPORATION	1
11	CORPORATION OF THE STATE OF FLORIDA	
76	1/3 MEREDITH M. MYLES, SR., TRUSTEE OF THE MEREDITH	1
78		1
	M. MYLES SR. TRUST DATED THE 30TH DAY OF JUNE,	I
	1994 & 1/3 TWILA M. MYLES, TRUSTEE OF THE TWILA M.	
	MYLES TRUST DATED THE 30TH DAY OF JUNE, 1994 &	1
<u></u> .	1/3 MEREDITH M. MYLES, JR.	4
79	JULIANNA HOTT	4
80	ALBERT L. POTTER, II	4
81	THE TOLEDO AUTOMOBILE CLUB	4
82	DOUGLAS R. LEGALLEY & TONI M. LEGALLEY	4
83	ALBERT L. POTTER	
84	CITY OF BOWLING GREEN, OHIO	
85	ROBERT W. MAURER & PATRICIA A. MAURER	_
~ ~	MASON'S GULF SERVICE, A PARTNERSHIP	Ì
86	WILLIAM W. BURKLE & MARY JOY ANN BURKLE	1
<u>86</u> 87	ALBERT L. POTTER II	1
87	I MUDENIE, FUILENI	-4
87 88	I	1
87	BUTTONS, INC., AN OHIO CORPORATION  NEW YORK CENTRAL LINES, L.L.C.,	1

#### CONVENTIONAL SIGNS

County Line
Township Line — — — — — — — —
Section Line — — — — — — — — — — — — — — — — — — —
Corporation Line or
Corporation Line Or
Trees (5), Stumps Pl, (to be removed),
Trees Stumps 10", (to be removed), Utility Poles: Telephone of, Power of, Light of
Limited Access (only)
Right of Way (only)
Limited Access & Right of Way
Temporary Right of Way
Existing Right of Way — Ex. R/W — —
Property Line ———— (in existing fence) —×———————————————————————————————————
Railroad or ++++++++++++
Guardrail (existing)
Construction Limits CONSTRUCTION LIMITS
Gas Line 6 6
969 FILE

02/11/03 ADDED SUSPEND WORK FLAGS 09/26/02 REV. DATE

REVISED OWNER PARCEL 88 DESCRIPTION R.A.P. 07/08/02 FIELD REVIEW BY R.A.P. 07/08/02 JULY 9, 2002

300

OWNERSHIP VERIFIED DATE OF COMPLETION

HORIZONTAL SCALE IN FEET

SHEET 4 OF 4

TOTAL NUMBER OF:

75 OWNERSHIPS

112 PARCELS

OWNERSHIPS WITH "P" ITEMS

AREA SHOWN IN ACRES

### SUMMARY OF ADDITIONAL RIGHT OF WAY

PARCEL	OWNER	SHEET	OWNERS	RECORD	AUDITOR'S	RECORD AREA	TOTAL P.R.O.	GROSS TAKE	P.R.O. IN TAKE	NET	STRUC-	NET RES	RIGHT	TYPE	REMARKS AND PERSONALITY	AS AC	CQU
	OMILIN .	NO.	VOLUME	PAGE	ID NUMBER	ACRES	ACRES				ł		ACRES	FUNDS		VOLUME	
SHV	STATE OF OHIO FOR THE USE OF	3-5,25-42,47,	279	368	B07-511-1904-01-001.000	3.0000	0.4896	0.8179	0.4896	0.3283	NO			CITY			
	BOWLING GREEN STATE UNIVERSITY	48, 53-56	215	105	B07-511-1904-01-001.000	1.0000	0.0549	0.1484	0.0549	0.0935							
			216	107	B07-511-1904-01-001.000	36.0000 40.0000		The state of the s	0.4113								+
	·		163 163	34 34	B07-511-1904-01-001.000 B07-511-1903-01-001.000	31.4400			0.0070				.,,,,,				
			194	362-366													-
	GRAND TOTAL		281	556	B07-511-1903-01-002.000	1.2000 112.6400	0.6807		0.6807 2.5412			1	04.9927				+
	GRAND TOTAL					112.0400	3.3343	4.0042	2.3412	2.1130			04.9327				
1-SV		4, 37,38, 53, 54	163	34	B07-511-1903-01-001.000	31.4400		0.0018		0.0018					DRAINAGE STRUCTURE		
1-UV		3, 47-52	216	107	B07-511-1904-01-001.000	36.0000		0.4591		0.4591					STORM SEWER		
															WALLA DOUG BOAD WADDON CHENT A COADING		1
1-TV1		2,3,17-24,45,46	413 413	127 129	B07-511-2000-00-010.000 B07-511-2000-00-011.000	15.6600 20.0000		0.4317		0.4317					WALK, DRIVE, ROAD IMPROVEMENT & GRADING		
			503	165	B07-511-2000-00-012.000	······································											
															WALK DOWE DOAD IMBROVENENT & CRADING		سحمتن السا
1-TV2		3-5,25-42, 47, 48, 53-56	279 215	368 105	B07-511-1904-01-001.000 B07-511-1904-01-001.000	3.0000 1.0000		1.9998		1.9998					WALK, DRIVE, ROAD IMPROVEMENT & GRADING		+
		17, 40, 33 30	216	107	B07-511-1904-01-001.000	36.0000											
			163	34	B07-511-1904-01-001.000	40.0000											+
and the second			163 281	34 556	B07-511-1903-01-001.000 B07-511-1903-01-002.000	31.4400 1.2000											1
		.,			307 311 1303 01 002.000	1.2000											1
I-TV3		5,41,42, 55-58	216	107	B07-511-1903-01-002.000	1.2000		0.0398		0.0398					DRIVE IMPROVEMENTS & GRADING		
_TV4		3, 49, 50	216	107	B07-511-1904-01-001.000	36.0000		0.0023		0.0023					STORM SEWER REPLACEMENT		
															OTODAL CEMED DEDI ACEMENT		
1-TV5		3, 51, 52	216	107	B07-511-1904-01-001.000	36.0000		0.0011		0.0011					STORM SEWER REPLACEMENT		+
2-SHV	HAVEN HOUSE MANOR LIMITED,	3, 23-26	669	963	B07-511-2003-04-001.000	0.1300	0.0000	0.0046	0.0000	0.0046							
	AN OHIO LIMITED PARTNERSHIP		485	328	B07-511-2003-04-002.000	1.7600			0.0000				4.0004				-
	GRAND TOTAL					1.8900	0.0000	0.0606	0.0000	0.0606			1.8294				+
3-SHV	DOUGLAS R. VALENTINE, TRUSTEE OF THE	3, 25, 26	708	9	B07-511-2003-04-003.000	0.1500	0.0000	0.0046	0.0000	0.0046			0.1454				
	DOUGLAS R. VALENTINE LIVING TRUST																_
	OF DECEMBER 18, 1992																+
4-WDV	THE TRUSTEES OF THE DIOCESE OF OHIO,	3,25,26,47,48	338	121	B07-511-2003-04-004.000	1.8000	0.0000	0.0732	0.0000	0.0732			1.7268				
	A CORPORATION																_
5	BEF REIT, INC. AN OHIO CORPORATION	2, 13, 14	708	681	B07-511-2004-01-004.000	1.1430									NO TAKE		
													4,				
6	RAYMOND L. FRICK	2, 13–16	669	63	B07-511-2004-01-003.000	1.3020				~					NO TAKE		+
7-TV	BP EXPLORATION & OIL, INCORPORATED,	2, 15–16	730	405	B07-511-2004-01-002.000	0.3100		0.0157		0.0157					DRIVE IMPROVEMENTS & GRADING		
	AN OHIO CORPORATION				B07-511-2004-01-001.000	0.7100											_
					B07-511-2003-01-001.000 B07-511-2003-01-002.000	0.8900											+
	GRAND TOTAL				507 311 2000 01 002.000	2.0300											1
	NORMAN E HOLLEY TOHOTTE OF THE MODULAN E HOLLEY							0.0005		0.0005					DRIVE IMPROVEMENT & GRADING		+
8-TV	NORMAN E. HOLLEY, TRUSTEE OF THE NORMAN E. HOLLEY TRUST RESTATED ON JULY 31, 1997 &	2, 15–18	726 726	338 333	B07-511-2003-01-003.000	0.7835		0.0225		0.0225					DRIVE IMPROVEMENT & GRADING		1
	BARBARA A. HOLLEY, TRUSTEE OF THE BARBARA A.						1										1
	HOLLEY TRUST RESTATED ON JULY 31, 1997 (FEE OWNER)		<u> </u>														
8-PR	LEASE TO MARATHON OIL COMPANY	2, 15–18	LEASE VOL	57 PG. 83	B07-511-2003-01-003.000	0.7835		0.0225		0.0225		·			DRIVE IMPROVEMENT & GRADING		
	AMMENDED		LEASE VOL	.60 PG. 196													
	CHOIFACE TO EMPO MADVETIMO COMPANY			.73 PG. 876			-	1									+
	SUBLEASE TO EMRO MARKETING COMPANY  AMENDED			.76 PG. <mark>84</mark> 0 .77 PG. 232													
															ONLY ILINON PLINIT A ON ANILIO		$\bot$
9-TV	BOWLING GREEN LODGE, A LIMITED LIABILITY COMPANY AN OHIO LIMITED LIABILITY COMPANY	2, 17, 18	703	809	B07-511-2003-01-004.000 B07-511-2003-01-004.001	1.2300 2.1400		0.0398		0.0398					DRIVE IMPROVEMENT & GRADING		+
	AN VIIIV LIMITED LIADILITY COMPANT			<del>jan</del>	807-311-2003-01-004.001	4.1700											
	A & M GREEN FAMILY LIMITED PARTNERSHIP	2, 17,18	751	876	B07-511-2003-01-006.001	3.3830		0.0049		0.0049	S(3)				DRAINAGE STRUCTURE		

GRANTEE: ALL RIGHT OF WAY ACQUIRED IN NAME OF THE CITY OF BOWLING GREEN, OHIO UNLESS OTHERWISE NOTED.

NOTE: UNDER NO CIRCUMSTANCES ARE TEMPORARY EASEMENTS TO BE USED FOR STORAGE OF MATERIAL OR EQUIPMENT BY THE CONTRACTOR UNLESS NOTED OTHERWISE.

\*\* DENOTES RIGHT OF WAY ENCROACHMENT

NOTE: ALL TEMPORARY PARCELS TO BE OF 18 MONTHS DURATION.

NET RESIDUE = RECORD AREA - TOTAL PRO - NET TAKE (PERMANENT ONLY)

5 03/04/03 REVISED PARCEL 3-WDV TO 3-SHV
4 03/04/03 REVISED PARCEL 2-WDV TO 2-SHV
3 02/26/03 REVISED PARCEL 4-WDV
2 09/26/02 REVISED PP. NO. 9-TV
1 08/13/02 REVISED 1-UV
6/59
REV. DATE DESCRIPTION
FIELD REVIEW BY R.A.P. DATE 07/08/02
OWNERSHIP VERIFIED BY R.A.P. DATE 07/08/02
DATE OF COMPLETION JULY 9, 2002

LOTTED: MARCH 4, 2003

AREA SHOWN IN ACRES

## SUMMARY OF ADDITIONAL RIGHT OF WAY

ARCEL	OWNER	SHEET	OWNERS	RECORD	AUDITOR'S	RECORD AREA	TOTAL P.R.O.	GROSS TAKE		NET	STRUC-	NET RES	 TYPE	REMARKS AND PERSONALITY	AS ACQUIR
TROLL	OWILK	NO.	VOLUME	PAGE	ID NUMBER	ACRES	ACRES		· · · · · · · · · · · · · · · · · · ·	TAKE	TURE	1	 UNDS		VOLUME PA
-TV		2, 45, 46			B07-511-2003-01-006.002	2.8350		0.0017		0.0017	NO		CITY	DRIVE IMPROVEMENTS	
<b>5</b> 27	LE ENTEDODICES INS AN OURS CORROLATION								0.0704	0.0070		0.5904			
/DV	J-F ENTERPRISES, INC., AN OHIO CORPORATION	2,19,20,45,46	635	878	B07-511-2003-01-006.100	0.8650	0.2724	0.2/56	0.2724	0.0032		0.5894			
TV		2,19,20,45,46			B07-511-2003-01-006.100	0.8650		0.0176		0.0176				DRIVE IMPROVEMENT, PAVEMENT REMOVAL &	
			i i											GRADING	
WDV	HEKRON INVESTMENT, INC., AN OHIO CORPORATION	2,19,20,45,46	673	770	B07-511-2003-03-001.000	0.8140	0.2152	0.2586	0.2152	0.0434					
					B07-511-2003-03-002.000		0.0918	0.1387	0.0918	0.0469		4 4 7 7 7			
	GRAND TOTAL	A CONTRACTOR AND ANALYSIS OF A CONTRACTOR ANALYSIS OF A CO				1.5710	0.3070	0.3973	0.3070	0.0903		1.1737			
-TV		2,19,20,45,46	673	770	B07-511-2003-03-001.000			0.0238		0.0238				DRIVE IMPROVEMENT & GRADING	
					B07-511-2003-03-002.000	0.7570									
-TV	SPEEDWAY SUPERAMERICA, LLC,	2, 21, 22,	731	739	B07-511-2003-03-004.002	1.3245		0.0292		0.0292				DRIVE IMPROVEMENT & GRADING	
	A DELAWARE LIMITED LIABILITY COMPANY														
-TV	GREEN DAYS, LLC, AN OHIO LIMITED LIABILITY COMPANY	2, 3, 21, 22	O.R. 2194	693	B07-511-2003-03-004.000	2.5220		0.0122		0.0122				DRIVE IMPROVEMENT & GRADING	
	(FEE OWNER)														
PR	LEASE TO WAFFLE HOUSE, INCOPORATED,  A GEORGIA CORPORATION — AMENDED	2,3,21,22	754	962 84 PG. 972	B07-511-2003-03-004.000	0.3930		0.0122		0.0122					
	A GEORGIA CORFORATION - AMENDED		LEEASE VOL	94 FG. 9/2						-					
ν	R & Y HOLDINGS, LLC,	3, 21, 22	775	184	B07-511-2003-03-003.000									DRIVE IMPROVEMENT & GRADING	
	AN OHIO LIMITED LIABILITY COMPANY		775	107	B07-511-2003-03-004.001 B07-511-2003-03-005.000	0.1130 0.6521									
					B07-511-2003-03-006.000	0.4300		0.0057		0.0057				DRIVE IMPROVEMENT & GRADING	
					B07-511-2003-03-007.000	1.0419				· ·					
TV	BENNETT ENTERPRISES, INC., AN OHIO CORPORATION	3, 21-24	707	569	B07-511-2003-03-008.000	0.8200		0.0066		0.0066				GRADING	
														DOWE IMPROVEMENT & CRADING	
·TV	BUCKEYE INVESTMENT COMPANY	3, 23, 24	729	46	B07-511-2003-03-009.000	0.6200		0.0028	1	0.0028				DRIVE IMPROVEMENT & GRADING	
TV	TRUSTEES OF FIRST METHODIST CHURCH,	3, 23-26	403	285	B07-511-2003-03-010.000	9.3300		0.0618		0.0618				DRIVE IMPROVEMENT & GRADING	
	BOWLING GREEN, OHIO (FEE OWNER)		406 550	271	B07-511-2003-03-011.000	0.5000								** SPLIT RAIL FENCE	
-PR	LEASE TO WENDY'S INTERNATIONAL		11 Carrier 1997 1997 1997 1997 1997 1997 1997 199	Maria de la constanta de la co	B07-511-2003-03-012.000 B07-511-2003-03-012.000	0.8200 0.8200									
	SUB-LEASE TO J.N.T. FOOD SERVICE		The same of the sa	81 PG. 1007											
	CORPORTATION (VOL. 81 PG. 1007)														
WDV V	CNL APF PARTNERS, LP, A DELEWARE LIMITED	3,25,26,47,48	763	290	B07-511-2003-03-014.000				0.0000	0.0065	\$			REMOVE EXISTING SIGN	
	PARTNERSHIP (FEE OWNER)  GRAND TOTAL		2		B07-511-2003-03-013.000	0.0795 0.6195			0.0000	0.0065		0.3659		** SPLIT RAIL FENCE	
PR	LEASE TO CASTLE HILL HOLDINGS, LLC		LEASE VOL	.82 PG. 872	B07-511-2003-03-014.000	0.5400			0.0000			0.0000			
					B07-511-2003-03-013.000	0.0795			0.0000						
WDV	MID-AMERICAN NATIONAL BANK & TRUST COMPANY	3,25,26,47,48	464	421	B07-511-1904-02-001.000	0.1352	0.0000	0.0028	0.0000	0.0028		0.1324		** CHAIN FENCE	
VD V	MID AMERICAN NATIONAL BAIN & TROOT COMPANY	9,60,20,00,00			B07-311-1004-02-001.000										
TV		3, 27, 28			B07-511-1904-02-002.000	0.1330		0.0083	(	0.0083				DRIVE IMPROVEMENT & GRADING	
TV	FRANCHISE REALTY INTERSTATE CORPORATION	3, 27, 28	490	726	B07-511-1904-02-003.000	0.5639		0.0302		0.0302				DRIVE IMPROVEMENT & GRADING	
								0.005		0.0057				DRIVE IMPROVEMENT & GRADING	
-TV	FALCON PLAZA, LLC, AN OHIO LIMITED LIABILITY COMPANY	3, 27, 28	743	47	B07-511-1904-02-005.000 B07-511-1904-02-006.000	0.2490 0.2318		0.0257		0.0257				DAIVE IMPROVEMENT & GRADING	
					B07-511-1904-02-007.000	0.2318									
			<u> </u>		B07-511-1904-02-012.000	0.1159									
VAV	JPC LIMITED PARTNERSHIP	3, 27, 28,29,30	712	812	B07-511-1904-02-013.000	0.1209									
	AN OHIO LIMITED PARTNERSHIP		۰		B07-511-1904-02-014.000			0.0069		0.0069				** SIGN ENCROACHMENT  MODIFICATION TO EXISTING BLOCK WALL	
					B07-511-1904-02-015.000	0.1209		0.0063		U. UUUB				HOVE TOUTH TO EMOINTO DECON WALL	
4	LARRY T. WILLIAMS & MARCIA K. WILLIAMS	3, 29, 30	778	466	B07-511-1904-02-016.000									NO TAKE	
					B07-511-1904-02-017.000	U.2417								** PLANTER & R/R TIE WALL	
							<b>*</b>				NO		 TTY T		

GRANTEE: ALL RIGHT OF WAY ACQUIRED IN NAME OF THE CITY OF BOWLING GREEN, OHIO UNLESS OTHERWISE NOTED.

NOTE: UNDER NO CIRCUMSTANCES ARE TEMPORARY EASEMENTS TO BE USED FOR STORAGE OF MATERIAL OR EQUIPMENT BY THE CONTRACTOR UNLESS NOTED OTHERWISE.

\*\* DENOTES RIGHT OF WAY ENCROACHMENT

NOTE: ALL TEMPORARY PARCELS TO BE OF 18 MONTHS DURATION.

NET RESIDUE = RECORD AREA - TOTAL PRO - NET TAKE (PERMANENT ONLY)

5	02/27/03	REVISED OWNER PARCEL 14
4	02/26/03	ADDED PARCEL 23-WAV
3	02/12/03	DELETED 23-SV,23-TV,24-SV,24-TV
2	02/06/03	REVISED PARCELS 11-WDV & 12-WDV
1	12/20/02	ENCROACHMENTS PARCELS 19&23
REV.	DATE	DESCRIPTION
TELD RE	VIEW BY R	A.A.P. DATE 07/08/02
<b>DWNERSH</b>	IIP VERIFIEI	D BY R.A.P. DATE 07/08/02
DATE OF	COMPLETION	ON JULY 9, 2002
	4 3 2 1 REV. FIELD RE	4 02/26/03 3 02/12/03 2 02/06/03 1 12/20/02 REV. DATE FIELD REVIEW BY R

					I OI ADD					\ \ \ \ \ \ \ \ \ \ \ \ \ \ \ \ \ \ \		VV / V			
PARCEL	OWNER	SHEET NO.	OWNERS VOLUME	S RECORD PAGE	AUDITOR'S ID NUMBER	RECORD AREA ACRES	TOTAL P.R.O ACRES	TAKE			TRUC- TURE		TYPE FUNDS	REMARKS AND PERSONALITY	AS ACQUIRE VOLUME PAG
											NO		CITY		
5-SV	BOWLING GREEN STATE UNIVERSITY	3, 29, 30	O.R. 2043	475	B07-511-1904-03-001.000	0.1635		0.0024	0	0024				YARD INLET & GRADING	
26	MICHAEL DAVID WILLMARTH & MARY LOU WILLMARTH	4, 29, 30	672	873	B07-511-1904-03-002.000	0.1604								NO TAKE	
					B07-511-1904-03-003.000										
27	GEORGE A. RUSSELL, TRUSTEE & JACK FREASE	4, 29, 30	696	767	B07-511-1904-03-004.000	0.0693								NO TAKE	
			581	538											
28	ELIZABETH A. MAURER & KENNETH A. MAURER, TRUSTEES	4, 29, 30	737	886	B07-511-1904-03-005.000	0.1604								NO TAKE	
	OF THE MAURER TRUST DATED DECEMBER 23, 1992		683	561											
29	JOHN H. FROBOSE & MARY H. FROBOSE	4, 29, 30	758	324	B07-511-1904-03-006.000	0.1604								** ENCROACHMENT - FENCE NO TAKE	
-sv	VERNON C. HANSEN 1/2 &	4, 29, 30	O.R. 2175	249	B07-511-1904-03-007.000	0.1604		0.0023	0.	0023				YARD INLET & GRADING	
	BARBARA J. KNAUER 1/2														
31	VERNON C. HANSEN 1/2 &c	4, 29-32	763	510	B07-511-1904-03-008.000	0.1604				•				NO TAKE	
	BARBARA J. KNAUER 1/2		0.R. 2175	251											
32-SV	MARILYN R. VALENTINE, TRUSTEE OF	4, 31, 32	683	376	B07-511-1904-04-001.000	0.2169		0.0007	0	0007				STORM SEWER	
	THE MARILYN R. VALENTINE LIVING TRUST DATED DECEMBER 10, 1993							ulando de la compansión d							
<del>3</del> –\$V	STEVEN J. SMITH & RHONDA L. GARVEY, TRUSTEES,	4, 31, 32	779	298	B07-511-1904-04-002.000	0.2273		0.0082	0	0082				STORM INLET & DRIVE IMPROVEMENT	
	UNDER THE GARVEY/SMITH LIVING TRUST									- Acceptance of the second sec					
	DATED APRIL 1, 1999														
– TV:1	WILLIAM F. SCHMELTZ & PEGGY L. SCHMELTZ	4, 31, 32	404	531	B07-511-1904-04-003.000	0.4545		0.0064	0.	0064				DRIVE IMPROVEMENT & GRADING	
-TV2		4, 31, 32	362	563	B07-511-1904-04-004.000	0.1573		0.0021	0	.0021				DRIVE IMPROVEMENT & GRADING	
-WAV		4, 31, 32			B07-511-1904-04-004.000			0.0002	0	0002				** RAILROAD TIE WALL STEP RE-CONSTRUCTION	
														STEP RE-CONSTRUCTION	
5-WAV	PEGGY LOU SCHMELTZ	4, 31, 32	508	557	B07-511-1904-04-005.000	0.1573		0.0003	0	0003				STEP RE-CONSTRUCTION	
S-WAV	STEVEN J. SMITH & RHONDA L. GARVEY, TRUSTEES,	4, 31, 32	779	298	B07-511-1904-04-006.000	0.2610		0.0003	0	0003				STEP RE-CONSTRUCTION	
	UNDER THE GARVEY/SMITH LIVING TRUST DATED APRIL 1, 1999														
7 70/	OURO DISTRICT LUTLIFRAN CHURCH EVTENSION FUND INC	4, 31–34	733	693	B07-511-1904-05-001.000	0.1911		0.0901		.0901				DRIVE IMPROVEMENT & GRADING	
7–TV	OHIO DISTRICT LUTHERAN CHURCH EXTENSION FUND, INC., AN OHIO CORPORATION		733	093	B07-511-1904-05-002.000	0.1911		0.0301							
					B07-511-1904-05-003.000 B07-511-1904-05-004.000										
					B07-511-1904-05-005.000	0.0115									
					B07-511-1904-05-006.000	0.1758									
B-TV	JAMES R. DUNIPACE II & JANETTE M. DUNIPACE	4, 33, 34	690	314	B07-511-1904-05-007.000	0.1758		0.0076	0	0076				GRADING	
39	HAMBLIN INVESTMENTS CORPORATION	4, 33, 34	670	853	B07-511-1904-06-001.000	0.1758								NO TAKE	
	CORPORATION OF THE STATE OF FLORIDA														
0-SV	RICHARD D. SHAW & VELMA I. SHAW	4, 33, 34	641	843	B07-511-1904-06-002.000	0.1758		0.0040		.004				STORM INLET & DRIVE IMPROVEMENT	
I-SV	KURT SLATER	4, 33–36	754	791	B07-511-1904-06-003.000	0.1758		0.0074	<u> </u>	0074				STORM SEWER	
2-SV	RONALD F. TRZCINSKI & MARY JO TRZCINSKI	4, 35, 36	740	163	B07-511-1904-06-004.000	0.1758		0.0032	0	0032				STORM INLET & GRADING	
43	SCOTT A. SLATER	4, 35, 36	725	638	B07-511-1904-06-005.000	0.1299								NO TAKE	
44	MEREDITH M. MYLES, SR., TRUSTEE	4, 35, 36	703	698 & 703	B07-511-1904-06-006.000	0.1299								NO TAKE	
	TWILA M. MYLES, TRUSTEE														
5-TV	TIMOTHY J. CARTY, JOHN M. CARTY, COLLEEN J. WHALEN,	4, 35, 36	656	960	B07-511-1904-07-001.000			0.0062	0.	0062				DRIVE IMPROVEMENT & GRADING	
	KATHLEEN M. SEARS, & MAUREEN K. MEADE				B07-511-1904-07-002.000	0.1864					NO		CITY		

GRANTEE: ALL RIGHT OF WAY ACQUIRED IN NAME OF THE CITY OF BOWLING GREEN, OHIO UNLESS OTHERWISE NOTED.

NOTE: UNDER NO CIRCUMSTANCES ARE TEMPORARY EASEMENTS TO BE USED FOR STORAGE OF MATERIAL OR EQUIPMENT BY THE CONTRACTOR UNLESS NOTED OTHERWISE.

\*\* DENOTES RIGHT OF WAY ENCROACHMENT

NOTE: ALL TEMPORARY PARCELS TO BE OF 18 MONTHS DURATION. NET RESIDUE = RECORD AREA - TOTAL PRO - NET TAKE (PERMANENT ONLY)

	REVISED OWNER 30 & 31	02/10/03	3
	REVISED PAGE NO. 45-TV	08/12/02	2
1	REVISED OWNERSHIP 30-SV	08/12/02	1
	DESCRIPTION	DATE	REV.
] /	A.P. DATE 07/08/02	VIEW BY R.	
1t	BY R.A.P. DATE 07/08/02	HIP VERIFIED	OWNERS
		COMPLETIC	

SHEET 3 OF 7 DATE OF COMPLETION

					I OI ADD		ATTENDED TO THE REAL PROPERTY.							
PARCEL	OWNER	SHEET NO.	OWNERS VOLUME	RECORD PAGE	AUDITOR'S ID NUMBER	RECORD TOTAL AREA P.R. ACRES ACR	O. TAKE		4	NET F LEFT ACRES	RESIDUE TYPE ACRES FUNDS	REMARKS AND PERSONALITY	 CQUIRED PAGE	
46-TV	VELMA I. SHAW	4, 35, 36	371	66	B07-511-1904-07-003.000	0.1960	0.0040	0.004	o no		CITY	DRIVE IMPROVEMENTS & GRADING		
47-TV	JEAN DURLIAT HINES	4, 35, 36	678	806	B07-511-1904-07-004.000	0.1893	0.0014	0.001	4			DRIVE IMPROVEMENTS & GRADING		1
48-WDV	T.O.'S TWO, LTD., AN OHIO LIMITED LIABILITY COMPANY	4, 35–38	756	207	B07-511-1904-07-006.000	0.1893 0.00	00 0.0012	0.0000 0.001	2 5	0.1881				1
48-TV		4, 37, 38			B07-511-1904-07-005.000	0.1893	0.0146	0.014	6			DRIVE IMPROVEMENTS & GRADING		
49-SHV	STATE OF OHIO	4, 5, 37, 38,	242	351	B07-511-1903-23-001.000	0.2097 0.00	00 - 0.0310		0					STATE
		53, 54	241	284	B07-511-1903-23-002.000 B07-511-1903-23-003.000									S
	GRAND TOTAL					0.4194 0.00	00 0.0310	0.0000 0.031	0	0.3884				
49-TV		4, 5, 37, 38, 53, 54	242	351	B07-511-1903-23-001.000	0.2097	0.0268	0.026	8			DRIVE IMPROVEMENTS & GRADING		
49-WAV		37,38,53,54					0.0012	0.001	2			WALK IMPROVEMENT		ୁ ଆଞ୍ଚ
50	MICHAEL D. LOCEY & LENITA C. LOCEY	5, 37, 38	534	382	B07-511-1903-23-004.000	0.3214						NO TAKE		
					007 54 4007 07 005 000	0.0101	0.0055	0.005				DRIVE IMPROVEMENTS & GRADING		_
51-TV	SCOTT E. PAHL & SHARON K. PAHL	5, 37, 38	716 743	1078 169	B07-511-1903-23-005.000 B07-511-1903-23-006.000		0.0055	0.005	<u> </u>			DRIVE IMPROVEMENTS & ORADINO		
			2019	995										1 <
52-TV	ROGER A. BOGGS	5, 37, 38	704	1055	B07-511-1903-23-007.000	0.2006	0.0055	0.005	5			DRIVE IMPROVEMENTS & GRADING  ** CONCRETE WALL		
53-TV	JORDAN SCHMELTZ	5, 37, 38	778	791	B07-511-1903-23-008.000	0.1354	0.0048	0.004	8			DRIVE IMPROVEMENTS & GRADING		
54-TV	KYLE J. HERTZFELD & DALE A. HERTZFELD	5, 39, 40	688	426	B07-511-1903-23-009.000	0.1439	0.0062	0.006	2			DRIVE IMPROVEMENTS & GRADING		
55-TV	THOMAS M. CARPENTER & DIANA R. CARPENTER	5, 39, 40	721	682	B07-511-1903-23-010.000		0.0156	0.015	6			DRIVE IMPROVEMENTS & GRADING		
												** CONCRETE WALL & GUARDRAIL		-
56-WDV	ALLEN A. GREEN, TRUSTEE & MARY D. GREEN, TRUSTEE	5, 39, 40	680	841	B07-511-1903-23-016.000 B07-511-1903-23-017.000			0.0000 0.000 0.0000 0.002				** CHAIN LINK FENCE		
	GRAND TOTAL				B07-311-1903-23-017.000			0.0000 0.003		0.7225				
56-SV		5, 39, 40					0.0054	0.005	4			YARD INLET & GRADING		1>
56-TV1		5, 39, 40					0.0052	0.005	2			DRIVE IMPROVEMENT & GRADING		
56-TV2		5, 39, 40					0.0060	0.006	0			GRADING & FENCE REMOVAL		
57-WDV	JAAK PANKSEPP	5, 39, 40	689	984	B07-511-1903-23-018.000	0.0089 0.00	00 0.0002		-,1-,			** CHAIN LINK FENCE		
	GRAND TOTAL				B07-511-1903-23-019.000	0.1532 0.00 0.1621 0.00		0.0000 0.006 0.0000 0.007		0.1550				
.57-TV		5, 39, 40					0.0026	0.002	6			GRADING		
58-WDV	RANDOLPH G. SCHMELTZ & JESSIE L. SCHMELTZ	5, 39, 40	524	895	B07-511-1903-23-020.000	0.1532 0.00		0.0000 0.011	5	0.1417		** WRE CABLE FENCE		_
59-WDV	EYECON ENTERPRISES, LTD. ,	5, 39, 40	779	785	B07-511-1903-22-001.000		ŀ	0.0000 0.010		0.1427				
	AN OHIO LIMITED LIABILITY COMPANY	0, 00, 40	7/19	7,00	507 311 1303 22 301.300		0.0040					GRADING		
59-TV	LOCE MENTON I A VANANT MENTON	E 70 40	600	4.0.70	DOZ 544 4007 00 000 000	0.1572 0.00				0.1445				
60-WDV	JOSEF KEGLEWITSCH & VIVIAN KEGLEWITSCH	5, 39 - 42	606	1078	B07-511-1903-22-002.000	0.1532 0.00		0.0000 0.008		0.1+40		GRADING		-
60-TV							0.0033			04445		GNADINO		
61-WDV	ACTIVE CHRISTIANS TODAY CAMPUS MINISTRY, INC.	5, 41, 42	544	702	B07-511-1903-22-003.000	0.1532 0.00		0.0000 0.008		0.1445		DOINE IMPONEMENT & CONDING		<b>-</b>
61-TV		5, 41, 42					0.0042					DRIVE IMPROVEMENT & GRADING		1
62-WDV	KRISTIE A. FOELL	5, 41, 42	741	814	B07-511-1903-22-004.000	0.1532 0.00		0.0000 0.008		0.1445		GRADING		-
62-TV		5, 41, 42					0.0041	0.004	1 NO		STATE	DRIVE IMPROVEMENT & GRADING		

GRANTEE: ALL RIGHT OF WAY ACQUIRED IN NAME OF THE CITY OF BOWLING GREEN, OHIO UNLESS OTHERWISE NOTED.

NOTE: UNDER NO CIRCUMSTANCES ARE TEMPORARY EASEMENTS TO BE USED FOR STORAGE OF MATERIAL OR EQUIPMENT BY THE CONTRACTOR UNLESS NOTED OTHERWISE. \*\* DENOTES RIGHT OF WAY ENCROACHMENT

NOTE: ALL TEMPORARY PARCELS TO BE OF 18 MONTHS DURATION. NET RESIDUE = RECORD AREA - TOTAL PRO - NET TAKE (PERMANENT ONLY)

	REVISED PARCEL 49-SHV	4 02/28/03
	ADDED PARCEL 49-WAV	3 10/10/02
^	REVISED 49-WDV TO 49-SHV	2 09/26/02
9	ADDED VOL. & PG. PARCEL 49-WDV	1 08/12/02
	DESCRIPTION	REV. DATE
/2		FIELD REVIEW BY R
(3	D BY R.A.P. DATE 07/08/02	OWNERSHIP VERIFIE

DATE OF COMPLETION

) A (2) O (2)	PARALET TO	611		e proces		RECORD		1	P.R.O. IN	MET	etbus	NET RES		TYPE	REMARKS AND PERSONALITY	AS A	ACQUIE
ARCEL	OWNER	SHEET NO.	VOLUME	S RECORD PAGE	AUDITOR'S ID NUMBER	AREA ACRES	P.R.O. ACRES	TAKE ACRES	TAKE ACRES	NET TAKE				UNDS	REMARKS AND PERSONALITI	VOLUME	
											NO			CITY			
-WD∨	JACK A. JONES, JAMES E. JONES, JR. & BRODY B. JONES	5, 41, 42, 55, 5	6 730	1048	B07-511-1903-22-005.000	0.1532	0.0000	0.0087	0.0000	0.0087		0.1445					
3-TV								0.0033		0.0033					GRADING		
4-WDV	DEVIN DAUTERMAN	5, 41, 42, 55, 5	<b>6</b> 656	546	B07 511 1003 32 006 000	0.1200					YES (2)				REMOVE 2 STY RES. & BLOCK GARAGE		
4- <i>N</i> DV	DE VIN DAUTERMAN	3, 41, 42, 33, 3	036	340	B07-511-1903-22-006.000 CALCULATED	0.1200	0.0000	0.1502	0.0000			0.0000			TOTAL TAKE		
5-WDV	ELIZABETH A. MAURER & KENNETH A. MAURER, TRUSTEES	5, 55, 56	709	645	B07-511-1903-22-007.000	0.1558	0.0000	0.0088	0.0000	0.0088			0.1470				
5-WAV	OF THE MAURER TRUST DATED DECEMBER 23, 1992							0.0006		0.0006					STEP IMPROVEMENTS		
6-WDV	RONALD C. SMITH & RUTH C. SMITH, TRUSTEES	5, 55, 56	734	349	B07-511-1903-22-008.000	0.1558	0.0000	0.0069	0.0000	0.0069			0.1489				
	SMITH LIVING TRUST, DATED APRIL 11, 1998														STEP IMPROVEMENTS		
66-WAV				_				0.0009		0.0009		· .					
7-WDV	DOUGLAS S. DOREN	5, 55, 56	748	190	B07-511-1903-22-009.000	0.1558	0.0000	0.0024	0.0000	0.0024			0.1534		** R/R TIE WALL		
57-WAV		5, 55, 56						0.0029		0.0029					STEP IMPROVEMENTS		
68-TV	STEVEN J. SMITH & RHONDA C. GARVEY, TRUSTEES UNDER	5, 55, 56	779	298	B07-511-1903-22-010.000	0.1558		0.0034		0.0034					GRADING		
	THE GARVEY/SMITH LIVING TRUST DATED APRIL 1, 1999																
69	JOHN L. NEWLOVE & LYDIA J. NEWLOVE	5, 55, 56	756	1035	B07-511-1903-22-011.000	0.1558				. [					NO TAKE		
70	JOHN L. NEWLOVE & LYDIA J. NEWLOVE	5, 55, 56	552	283	B07-511-1903-21-025.000										NO TAKE		
				<u> </u>	B07-511-1903-21-026.000	0.1558											
71	EYECON ENTERPRISES, LTD. , AN OHIO LIMITED LIABILITY COMPANY	5, 55, 56	779	785	B07-511-1903-21-027.000	0.1558									NO TAKE		
70 T)/4		E 55 56	<b>E</b> 44	100	DO7 511 1007 31 038 000	0.1550		0.0078		0.0078					DRIVE IMPROVEMENT & GRADING		
72-TV1	CITY OF BOWLING GREEN, OHIO	5, 55, 56	511	192	B07-511-1903-21-028.000												
72-TV2		5, 55, 56	512	18	B07-511-1903-21-029.000	0.1558		0.0053		0.0053					DRIVE IMPROVEMENT & GRADING		
73-WDV	HAMBLIN INVESTMENTS CORPORATION,	5,41,42,55,56	670	849 & 853	B07-511-1903-21-001.000				0.0000		\$				** SIGN, CANOPY, 3 VENTS ENCROACHMENT		
	CORPORATION OF THE STATE OF FLORIDA				B07-511-1903-21-002.000 B07-511-1903-21-003.000		0.0000	0.0014	0.0000	0.0014							
	GRAND TOTAL			s		0.1742	0.0000	0.0143	0.0000	0.0143		0.1599					
73–TV1		5,41,42,55,56						0.0114		0.0114					WALK IMPROVEMENT		
73-TV2		5,41,42,55,56						0.0023		0.0023					DRIVE IMPROVEMENT & GRADING		
74-WD∨	KELLY S. HAMBLIN	<b>5</b> , 41, 42, 55, 5	6 766	409	B07-511-1903-21-004.000	0.1214	0.0000	0.0095	0.0000	0.0095							
		7, 11, 12, 33, 3			B07-511-1903-21-005.000	0.0139	0.0000	0.0001	0.0000	0.0001		1057					
	GRAND TOTAL					0.1353	0.0000	0.0096	0.0000			).1257					
74-TV		5, 41, 42, 55, 5	6					0.0118		0.0118					WALK IMPROVEMENT		
75-WDV	CRAIG E. CHEETWOOD & BARBARA SPLETZER-CHEETWOOD	5, 41-44	671	967	B07-511-1903-21-006.000	0.1500		0.0108		0.0108	\$ 0	0.1392			SIGN & WOOD DECK REMOVED  ** WOOD DECK ENCROACHMENT		
75-TV		5, 41, 42						0.0129		0.0129					WALK IMPROVEMENT & WOOD DECK REMOVAL		
′6-WD∨	MEREDITH M. MYLES, JR. & BRIDGET A. MYLES	5, 41, 42	533	151	B07-511-1903-21-007.000	0.1025	0.0000	0.0101	0.0000	0.0101	S(2)				SIGNS, CONCRETE DECK, FLAGPOLE &		
O MDV	MENEDINI M. MILEO, ON G. DAIDOLI A. MILEO	<b>V</b> , 41, 42	634	649	B07-511-1903-21-008.000	0.1200	0.0000	0.0280	0.0000	0.0280					RR TIES REMOVED		
	GRAND TOTAL		634	649	B07-511-1903-21-011.000	0.1297 0.3522			0.0000		0	0.2884					
76-TV		5, 41-44						0.0442		0.0442					WALK & DRIVE IMPROVEMENT &		
/U-IV		<b>3 1 1</b>								V.UTTL					CONCRETE DECK REMOVAL		
77−WD∨	HAMBLIN INVESTMENTS CORPORATION	5, 43, 44	670	849&853	B07-511-1903-21-013.000	0.0800	0.0000	0.0041	0.0000	0.0041							
	CORPORATION OF THE STATE OF FLORIDA				B07-511-1903-21-014.000			0.0000									

GRANTEE: ALL RIGHT OF WAY ACQUIRED IN NAME OF THE CITY OF BOWLING GREEN, OHIO UNLESS OTHERWISE NOTED.

NOTE: UNDER NO CIRCUMSTANCES ARE TEMPORARY EASEMENTS TO BE USED FOR STORAGE OF MATERIAL OR EQUIPMENT BY THE CONTRACTOR UNLESS NOTED OTHERWISE. \*\* DENOTES RIGHT OF WAY ENCROACHMENT

NOTE: ALL TEMPORARY PARCELS TO BE OF 18 MONTHS DURATION. NET RESIDUE = RECORD AREA - TOTAL PRO - NET TAKE (PERMANENT ONLY)

3			
	ENCROACHMENTS PARCELS 73&75	12/20/02	5
	68-TV REVISED REMARKS	09/30/02	4
	REVISED AREA 64-WDV	09/26/02	3
40	REVISED RECORD AREA 75-WDV	08/12/02	2
וטו	REVISED RECORD AREA 64-WDV	08/12/02	1
	DESCRIPTION	DATE	REV.
/2	A.P. DATE 07/08/02	EVIEW BY R	FIELD R
(30	D BY R.A.P. DATE 07/08/02	HIP VERIFIED	OWNERS
Z.	W. 125 W. 105 W.	F COMPLETIC	

SHEET 5 OF 7

						RECORD	ř	1	P.R.O. IN			NET RE		~n∈	REMARKS AND PERSONALITY	AS A	COLUE
RCEL	OWNER	SHEET NO.	VOLUME	S RECORD PAGE	AUDITOR'S ID NUMBER	AREA ACRES	P.R.O. ACRES	TAKE ACRES	in the second se	NET TAKE	STRUC- TURE	LEFT ACRES		TYPE UNDS	REMARKS AND PERSONALITY	VOLUME	and the second s
7—TV		5, 43, 44						0.0035		0.0035	NO			CITY	WALK & DRIVE IMPROVEMENT		
															NO TAVE		
78	1/3 MEREDITH M. MYLES, SR., TRUSTEE OF THE MEREDITH M. MYLES SR. TRUST DATED THE 30TH DAY OF	5, 43, 44	703 512	698 & 703 250	B07-511-1903-19-001.000 B07-511-1903-19-002.000										NO TAKE		
	JUNE, 1994 & 1/3 TWILA M. MYLES, TRUSTEE OF THE TWILA		312	200	B07-511-1903-19-003.000												
	M. MYLES TRUST DATED THE 30TH DAY OF JUNE, 1994 &				B07-511-1903-19-004.000												
: : :	1/3 MEREDITH M. MYLES, JR. GRAND TOTAL		502	250		0.7184											
	ONAND TOTAL																
79	JULIANNA HOTT	5, 43, 44	497	424	B07-511-1903-19-005.000	0.0803									NO TAKE		
			573	300													
80	ALBERT L. POTTER, II	5, 43, 44	712	111	B07-511-1903-19-006.000	0.1267									NO TAKE		
					B07-511-1903-19-007.000												
G-1	THE TOLEDO ALITOMODILE CLUB		E 0.7		DO7 E11 1007 10 009 000	0 1101									NO TAKE		
81	THE TOLEDO AUTOMOBILE CLUB	5, 43, 44	503	551	B07-511-1903-19-008.000 B07-511-1903-19-009.000	·											
82	DOUGLAS R. LEGALLEY & TONI M. LEGALLEY	5, 43, 44	674	529	B07-511-1903-19-010.000	0.2503									NO TAKE		
83	ALBERT L. POTTER	5, 43, 44	712	147	B07-511-1903-19-011.000	0.2197		1							NO TAKE		
			1 4	1 7 7	B07-511-1903-19-012.000	0.1386											
					***************************************												
84-WDV	CITY OF BOWLING GREEN, OHIO	5, 41-44, 57, 5	5 <mark>8 2</mark> 61	433	B07-511-1903-11-007.000	1.0100			0.0000						** ENCROACHMENT EXISTING FENCE ON		
					B07-511-1903-11-008.000 B07-511-1903-11-001.000	0.9400 0.1363		0.1406	0.0461	0.0945					THURSTIN AVENUE		
	GRAND TOTAL				B07-311-1903-11-001.000	2.0863	0.0606						1.7968				
															TENOT DE CONCEDITATION A CRADINO		
84-TV1		5, 41, 42, 57, 5	<u> </u>					0.0262		0.0262					FENCE RE-CONSTRUCTION & GRADING		1.
84-TV2		5, 41, 42						0.0618		0.0618					DRIVE IMPROVEMENT & GRADING		
																	_
35-WDV	ROBERT W. MAURER & PATRICIA A. MAURER	5, 43,44	765	144	B07-511-1903-12-035.000	0.1248 0.1647		0.0179	0.0000	0.0179							1
					B07-511-1903-12-036.000 B07-511-1903-12-037.000	**************************************			0.0000	0.0048							
	GRAND TOTAL					0.3466			0.0000				0.3239				
								0.0139		0.0139					DRIVE IMPROVEMENT & GRADING		
85-TV		5, 43,44						0.0139		0.0133					DATE BY NOTEMENT & CHAPITO		
86-SHV	MASON'S GULF SERVICE, A PARTNERSHIP	5,43,44	563	558	B07-511-1903-12-031.000	0.1476	0.0000			0.0208							
					B07-511-1903-12-032.000			0.0000							·		
					B07-511-1903-12-033.000 B07-511-1903-12-034.000	0.0193 0.0559			0.0000	0.0095							
	GRAND TOTAL	And the second s			30, 01, 1000 12	0.2744			0.0000				0.2441				
								0.0000		0.0000					FIRE HYDRANT		
86-UV		5,43,44			B07-511-1903-12-031.000	U.14/6		0.0006		0.0006					TINC PITONANT		<u> </u>
86-TV		5, 43,44						0.0339		0.0339					DRIVE IMPROVEMENT, GRADING &		
															CANOPY REMOVAL		<u> </u>
37-WDV	WILLIAM W. BURKLE & MARY JOY ANN BURKLE	5,43,44	542	40	B07-511-1903-12-028.000	0.1100	0.0000	0.0088	0.0000	0.0088							
,, - 11U V	WILLIAM W. DOWNLE & MINITE OF MINITED INTO				B07-511-1903-12-029.000				0.0000	0.0062							
					B07-511-1903-12-030.000	0.0015	0.0000		0.0000				0.1765				
	GRAND TOTAL					0.1915	0.0000	0.0150	0.0000	0.0150			0.1765				+
87-TV		5,43,44						0.0058		0.0058					GRADING & RE-PAVING		
			(Alb.) (1900)			Land Land Control							0.4055				
38-WDV	ALBERT L. POTTER II	5,43,44	O.R. 2099	688	B07-511-1903-12-021.000	0.1757	0.0000	0.0075	0.0000	0.0075			0.1682				
89	BUTTONS, INC., AN OHIO CORPORATION	5, 43, 44	721	345	B07-511-1903-12-018.000										NO TAKE		-
				<u></u>	B07-511-1903-12-019.000 B07-511-1903-12-020.000												
		4	1	1	DU/-3  - 3UJ- Z-UZU.UUU	1 0.011/	4.	1	ı	ľ		1		1 1			+

GRANTEE: ALL RIGHT OF WAY ACQUIRED IN NAME OF THE CITY OF BOWLING GREEN, OHIO UNLESS OTHERWISE NOTED.

NOTE: UNDER NO CIRCUMSTANCES ARE TEMPORARY EASEMENTS TO BE USED FOR STORAGE OF MATERIAL OR EQUIPMENT BY THE CONTRACTOR UNLESS NOTED OTHERWISE. \*\* DENOTES RIGHT OF WAY ENCROACHMENT

NOTE: ALL TEMPORARY PARCELS TO BE OF 18 MONTHS DURATION. NET RESIDUE = RECORD AREA - TOTAL PRO - NET TAKE (PERMANENT ONLY)

1		
3	09/26/02	REVISED OWNER 88-WDV
2	08/12/02	REVISED RECORD AREA 87-TV
1	08/12/02	REVISED RECORD AREAS 87-WDV
REV.	DATE	DESCRIPTION
FIELD R	EVIEW BY R	.A.P. DATE 07/08/02
OWNERS	HIP VERIFIEI	BY R.A.P. DATE 07/08/02
DATE O	F COMPLETION	ON JULY 9, 200

SHEET 6 OF 7

Washington and the second and the se					T OF ADD	-					- Annual Control	7-10 -110-						
PARCEL	OWNER	SHEET NO.	OWNERS VOLUME	RECORD PAGE	AUDITOR'S ID NUMBER	RECORD AREA ACRES	P.R.O. ACRES	TAKE	P.R.O. IN TAKE ACRES	NET	STRUC- TURE	LEFT	RIGHT ACRES	TYPE FUNDS	<b>₽</b>	AND PERSONALITY	AS AC	CQUIRED PAGE
											NO			CITY				
90	JONG SIK YOON & KYIN SOON	4, 53, 54	603	216	B07-511-1903-23-054.000	0.1520										O TAKE		
1-WAV	DOUGLAS S. DOREN	4, 53, 54	729 780	873 741	B07-511-1903-23-055.000	0.1540		0.0007		0.0007					STEP II	MPROVEMENTS		
92-TV	MARION V. HILL	4, 53, 54	302	494	B07-511-1903-23-056.000	0.1540		0.0096		0.0096					DRIVE & STEP IM	PROVEMENTS & GRADING		
			534	502														
3-WDV	ALLEN S. WHITE & MAUREEN G. WHITE, TRUSTEES	4, 53, 54	768	637	B07-511-1903-23-057.000	0.1522	0.0000	0.0025	0.0000	0.0025		0.1497						
93-TV		4, 53, 54						0.0095		0.0095					DRIVE & STEP IM	PROVEMENTS & GRADING		
4-WDV	LARRY E. REECE & ANN E. REECE	4, 53, 54	691	972	B07-511-1903-23-058.000	0.1576	0.0000	0.0052	0.0000	0.0052		0.1524						
94-TV		4, 53, 54						0.0079		0.0079		· ·			DRIVE & STEP IM	PROVEMENTS & GRADING		
95-WDV	JOHN H. FROBOSE & MARY H. FROBOSE	4, 53, 54	726	110	B07-511-1903-23-059.000	0.1446	0.0000	0.0090	0.0000	0.0090								
					B07-511-1903-23-060.000 B07-511-1903-23-061.000		0.0000	0.0009	0.0000	0.0009								
	GRAND TOTAL				B07-311-1903-23-061.000	0.0072	0.0000	0.0099	0.0000	0.0099		0.1491						
95-TV		4, 53, 54						0.0075		0.0075					DRIVE & STEP IMI	PROVEMENTS & GRADING		
96	JACQUELINE COLUMBER	4, 53, 54	766	379	B07-511-1904-07-007.000										<u> </u>	O TAKE		
					B07-511-1904-07-008.000	0.1854												
97-TV	JAMES R. VAN VORHIS & ANDREA C. VAN VORHIS	4, 53, 54	658	436	B07-511-1904-07-009.000	0.1854		0.0019		0.0019					DRIVE IMPROV	EMENTS & GRADING		
98-TV	JOHN H. FROBOSE & MARY H. FROBOSE	4, 53, 54	O.R. 2072	972	B07-511-1904-07-010.000	0.1854		0.0035		0.0035					DRIVE IMPROV	EMENTS & GRADING		
99	LARRY L. DONLEY & LINDA DONLEY	4, 53, 54	544	781	B07-511-1904-07-011.000	0.1854									N	O TAKE		
100	JOHN H. FROBOSE & MARY H. FROBOSE	4	722	374	B07-511-1904-07-012.000	0.1854									N	O TAKE		
101-SHV1	NEW YORK CENTRAL LINES, L.L.C., A DELAWARE LIMITED LIABILITY COMPANY	5, 43, 44	763	432	B07-511-1903-26-920.200	5.4900		0.0026		0.0026								
101-SHV2	· · · · · · · · · · · · · · · · · · ·	5, 43, 44		· · · · · · · · · · · · · · · · · · ·				0.0058		0.0058								
101-SHV3		5, 43, 44						0.0033		0.0033			, , , , , , , , , , , , , , , , , , ,					
	GRAND TOTAL					5.4900		0.0117		0.0117		5.4783						
											NO			CITY				
											-							
																· · · · · · · · · · · · · · · · · · ·		


GRANTEE: ALL RIGHT OF WAY ACQUIRED IN NAME OF THE CITY OF BOWLING GREEN, OHIO UNLESS OTHERWISE NOTED.


NOTE: UNDER NO CIRCUMSTANCES ARE TEMPORARY EASEMENTS TO BE USED FOR STORAGE OF MATERIAL OR EQUIPMENT BY THE CONTRACTOR UNLESS NOTED OTHERWISE. \*\* DENOTES RIGHT OF WAY ENCROACHMENT


NOTE: ALL TEMPORARY PARCELS TO BE OF 18 MONTHS DURATION. NET RESIDUE = RECORD AREA - TOTAL PRO - NET TAKE (PERMANENT ONLY)

02/2/02 REVISED PARCEL 95-WDV REVISED OWNER PARCEL 98 12/20/02 DESCRIPTION FIELD REVIEW BY R.A.P. DATE 07/08/02 OWNERSHIP VERIFIED BY R.A.P. DATE 07/08/02 DATE OF COMPLETION JULY 9, 2002

SHEET 7 OF 7

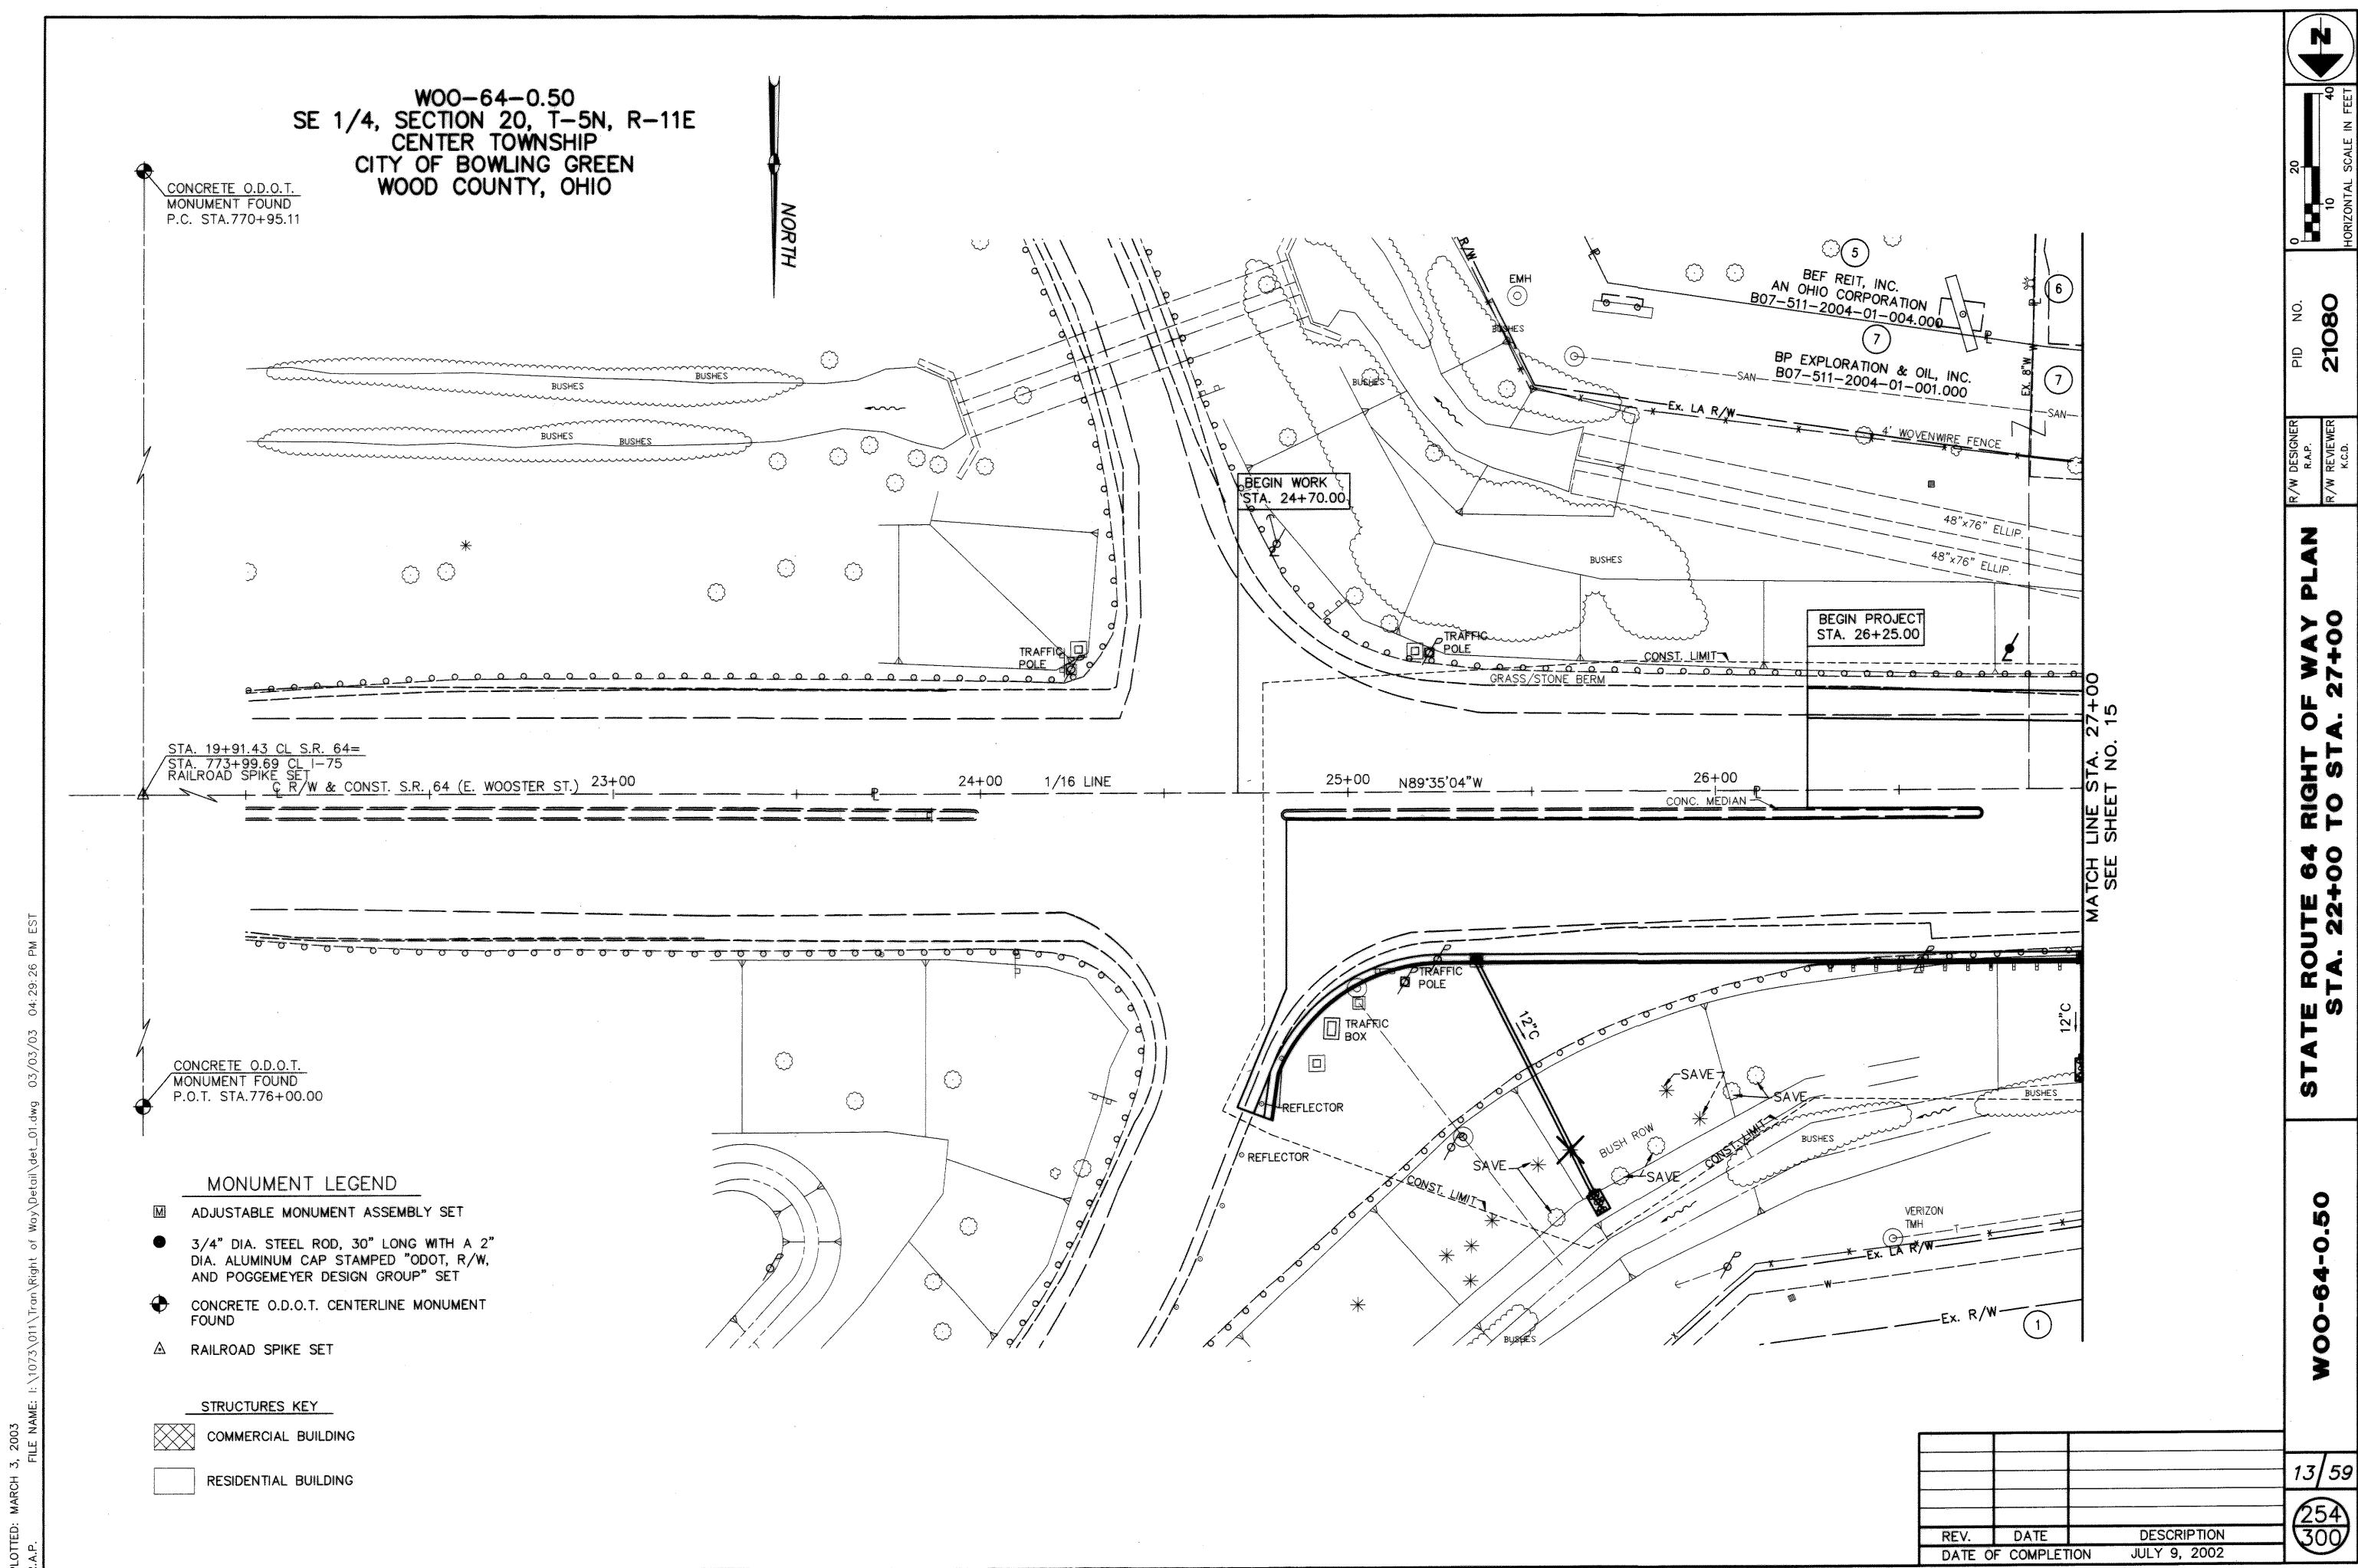

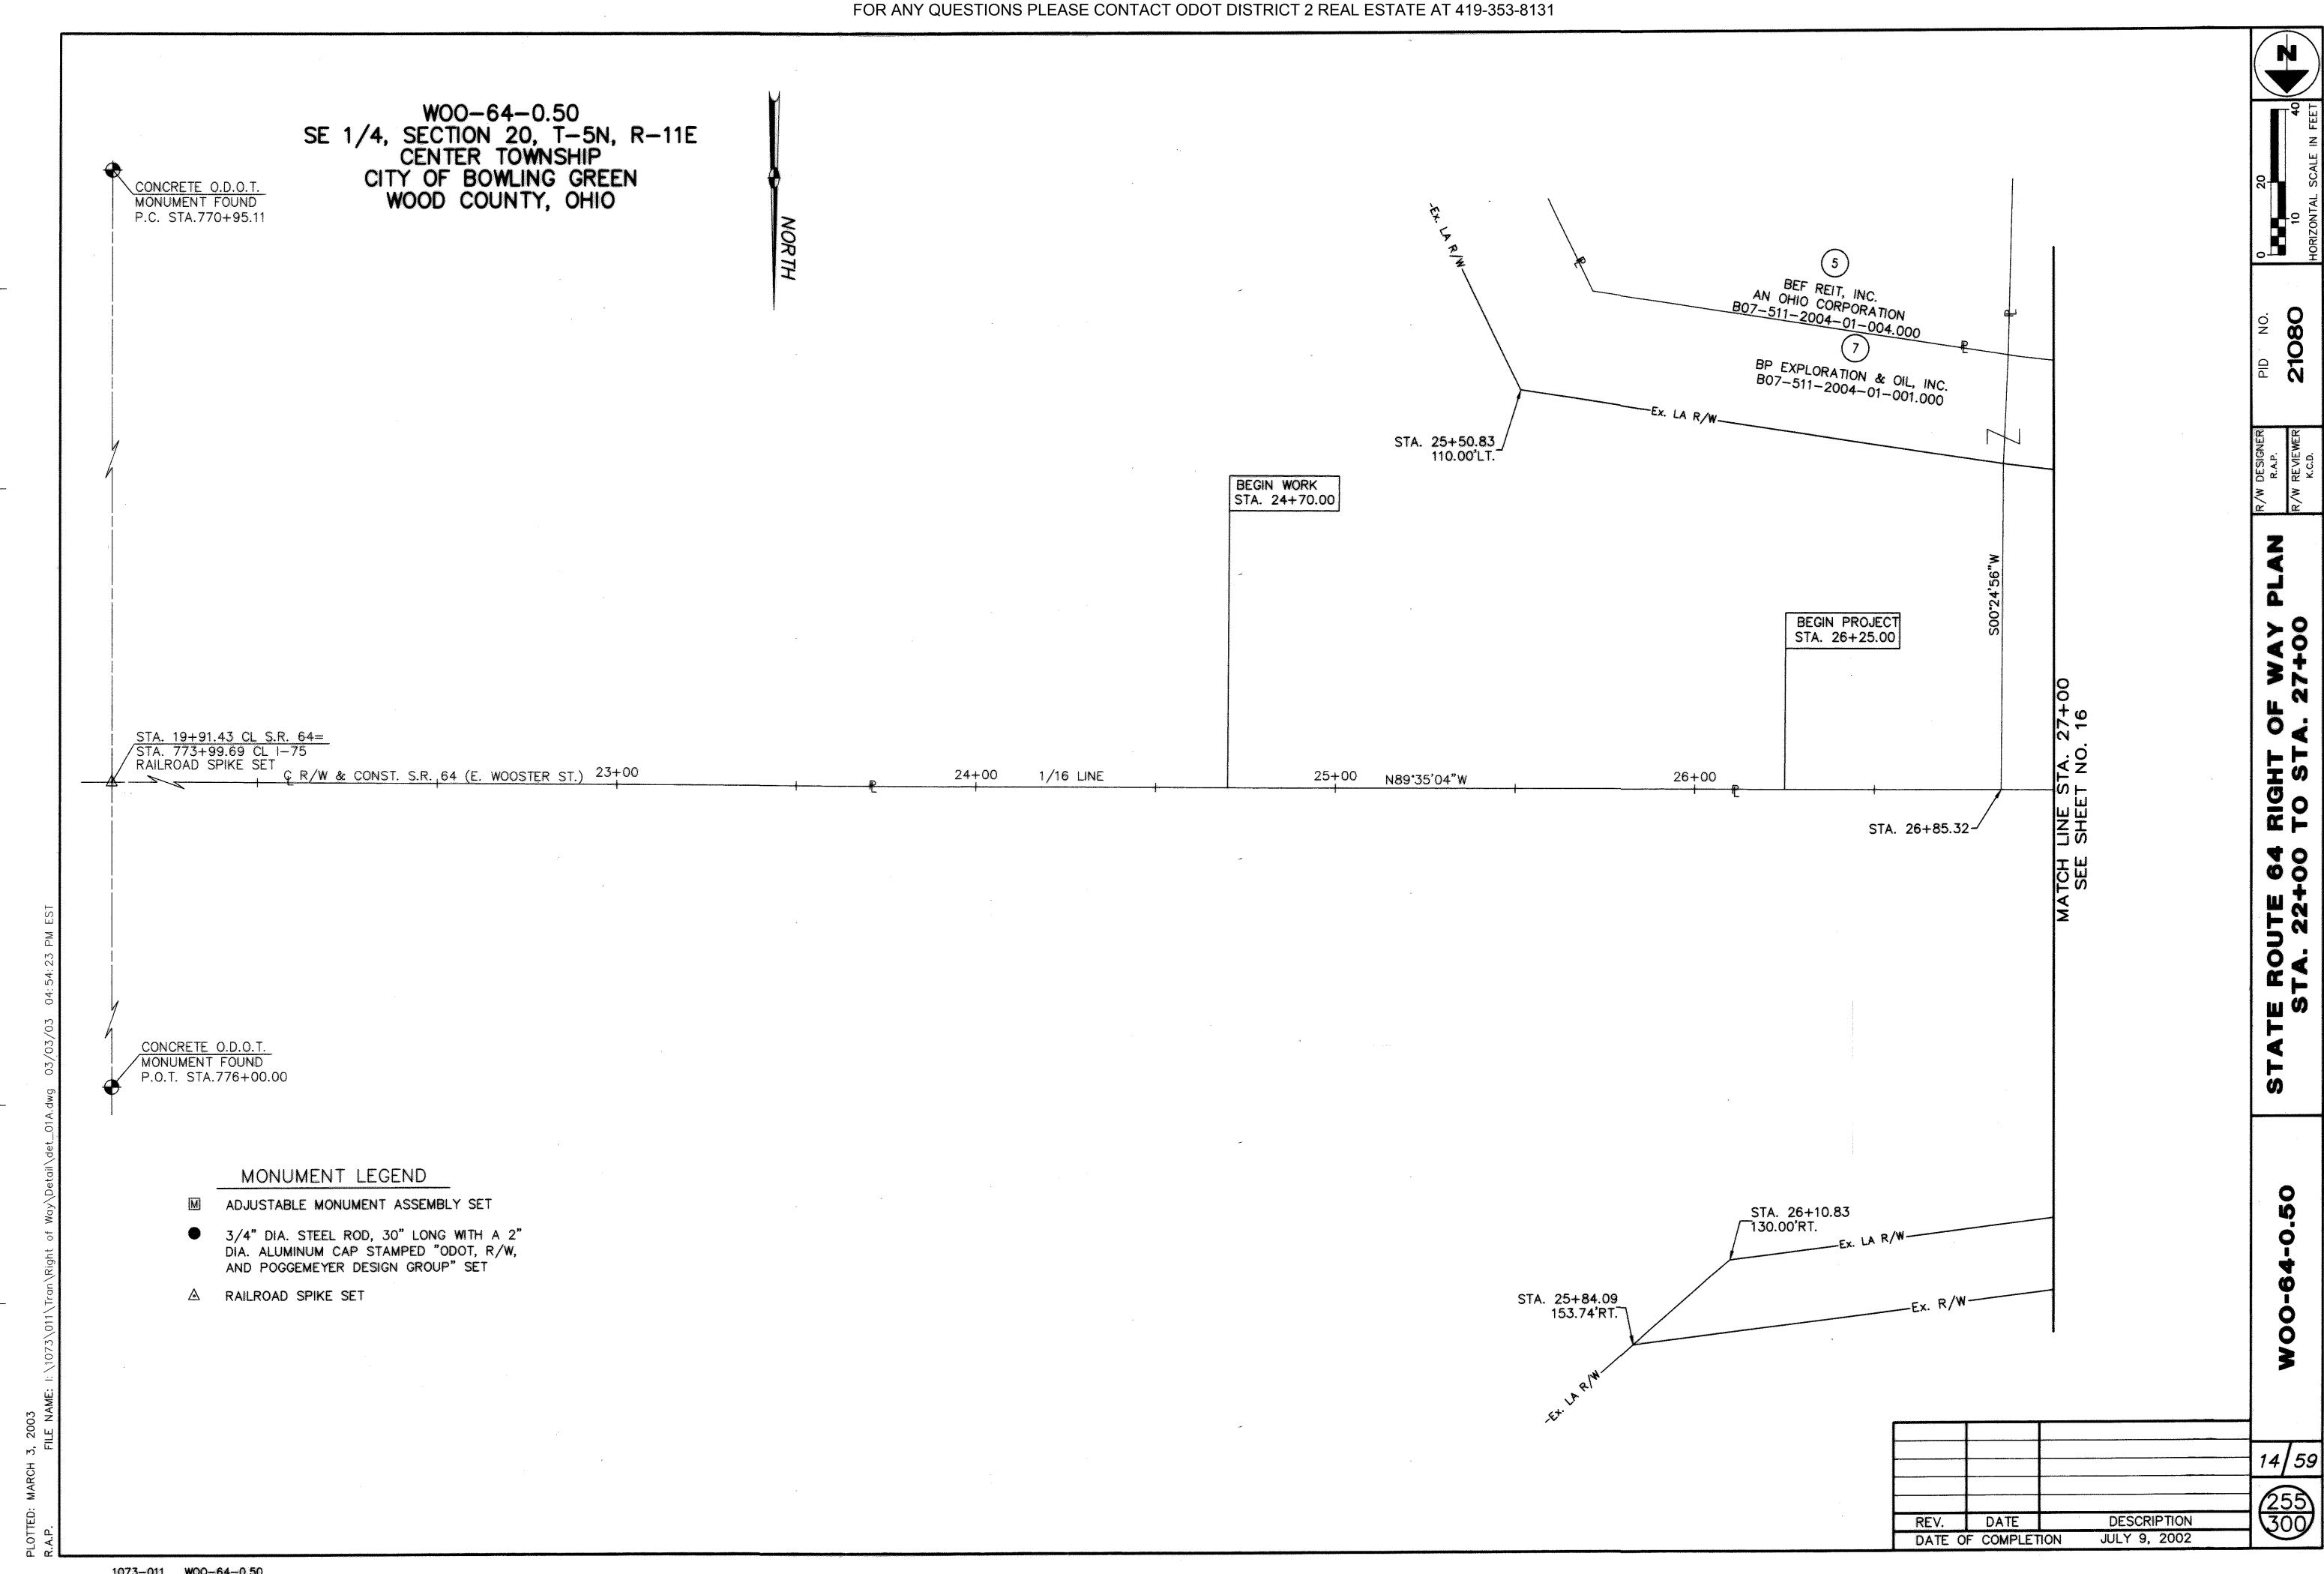


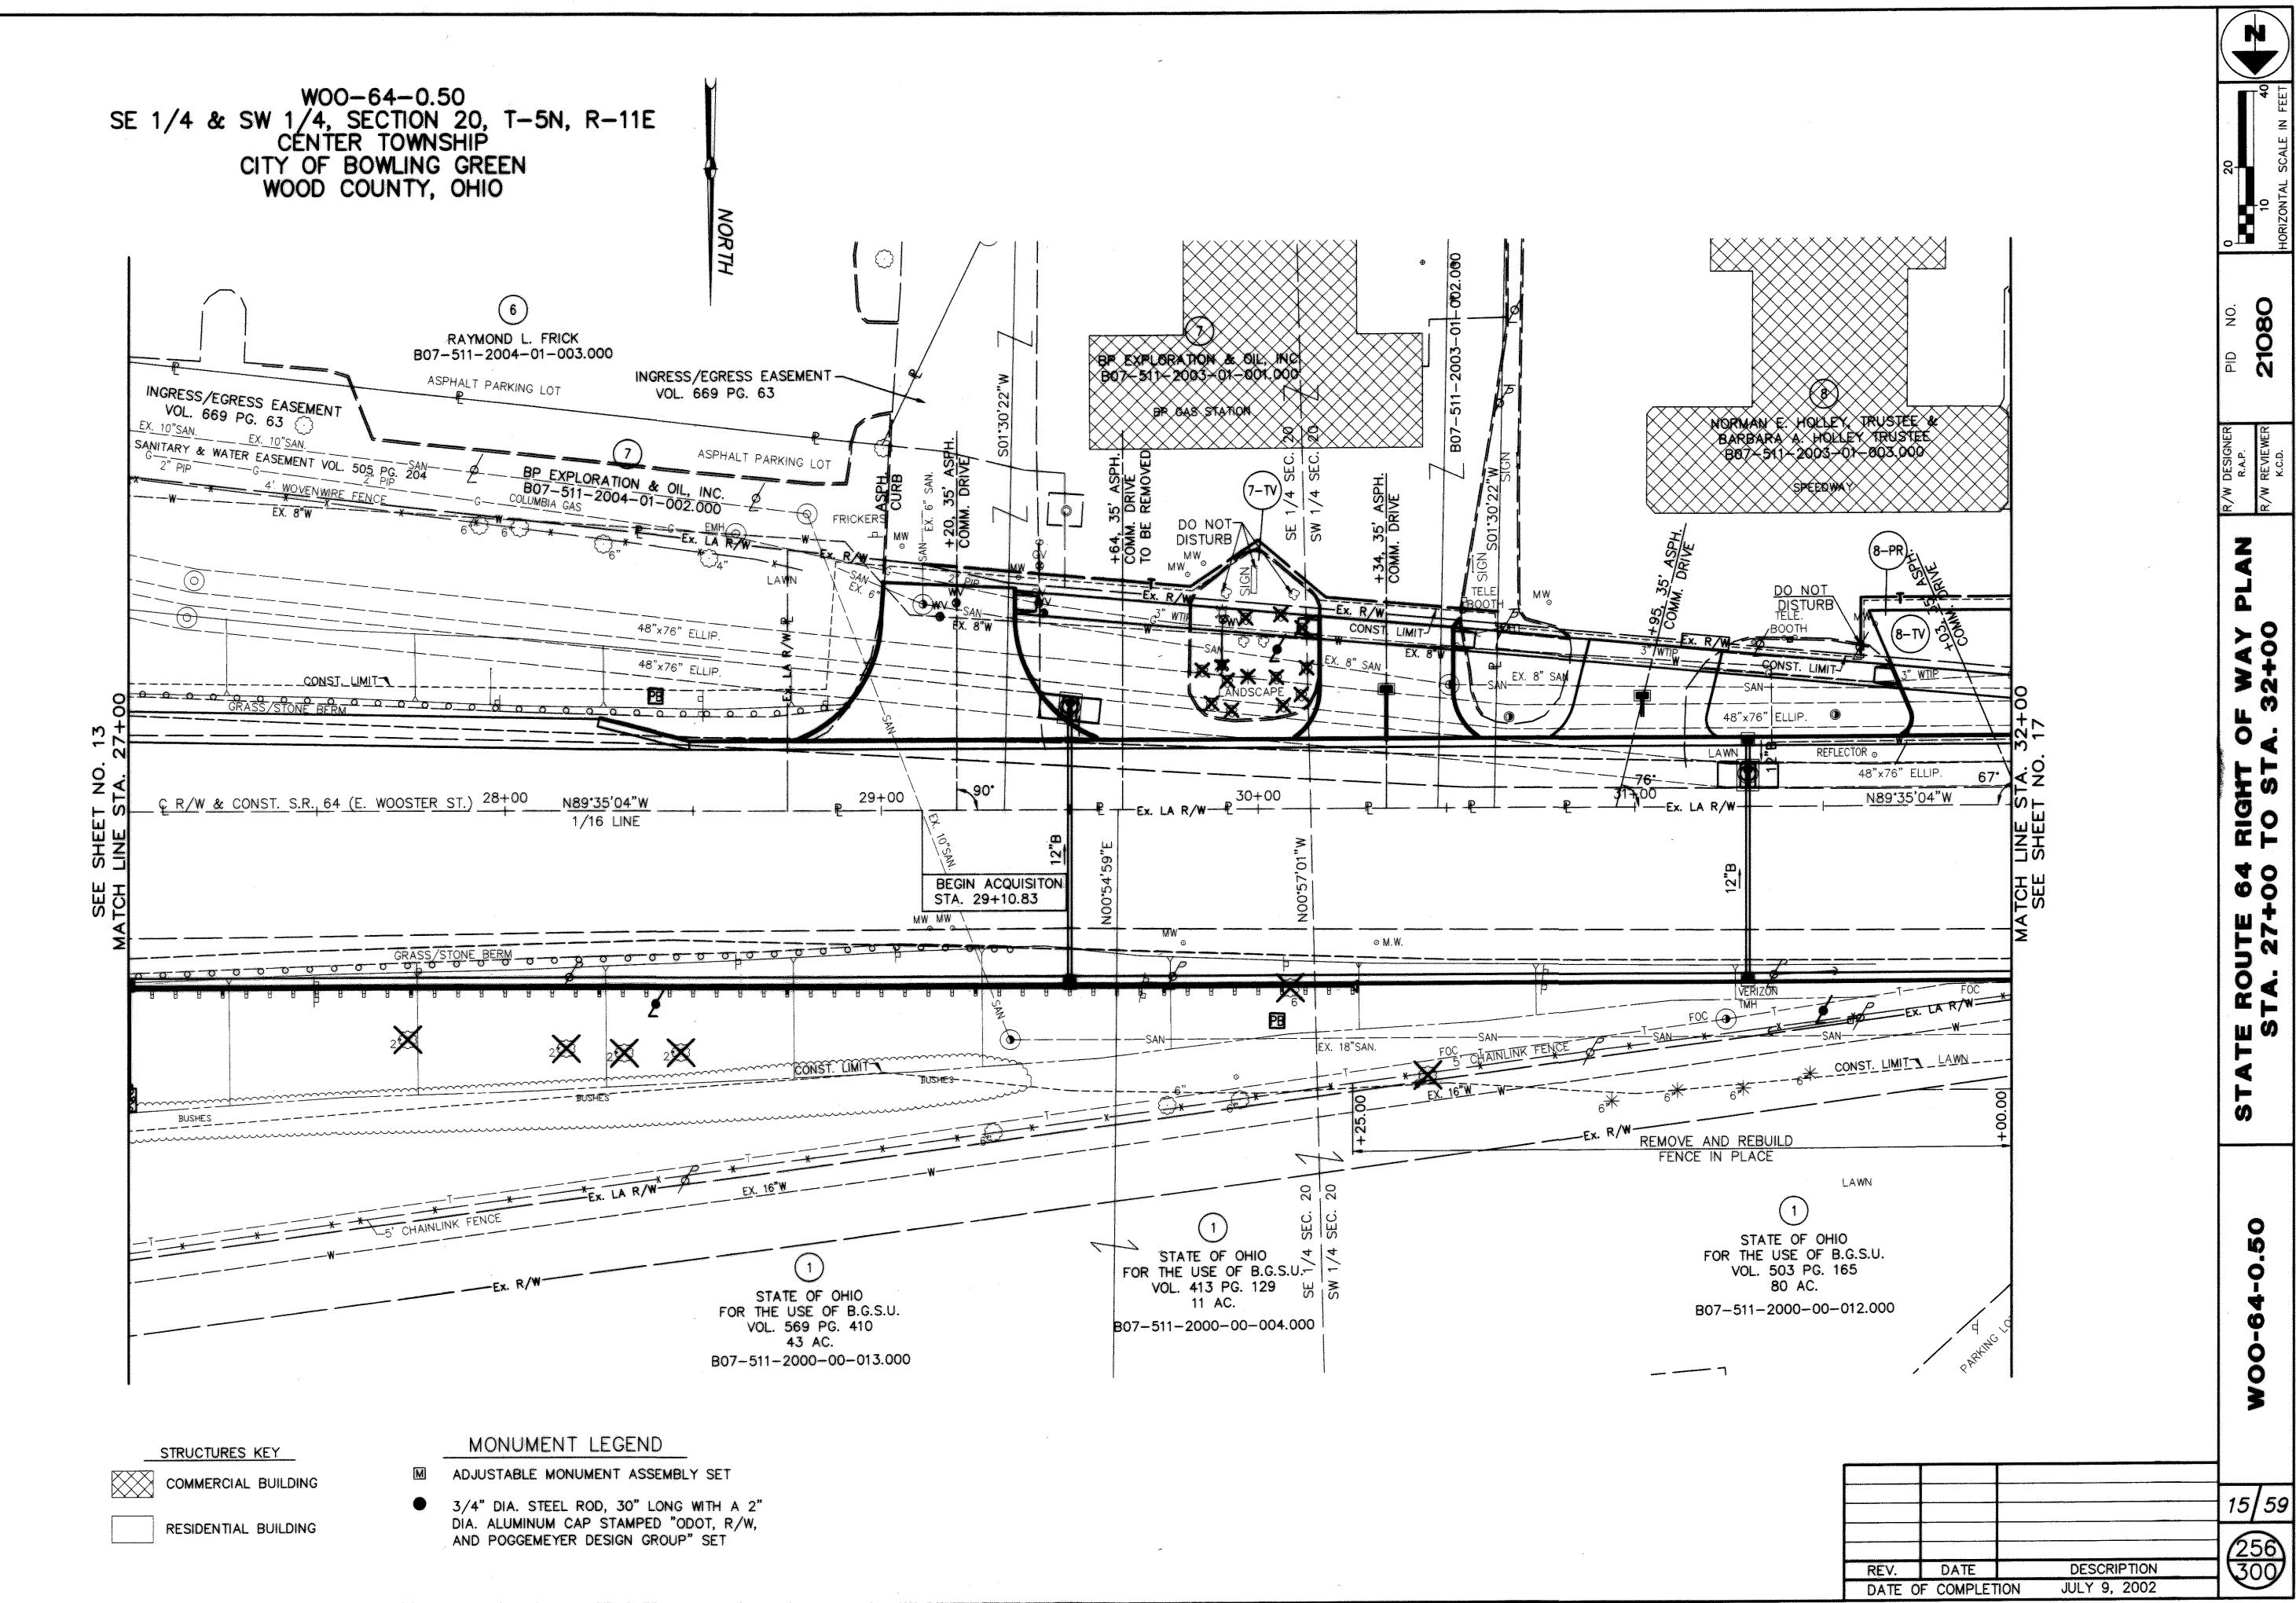


D: MARCH 4, 2003


7. A.


1073 011 WOO 64 0 50

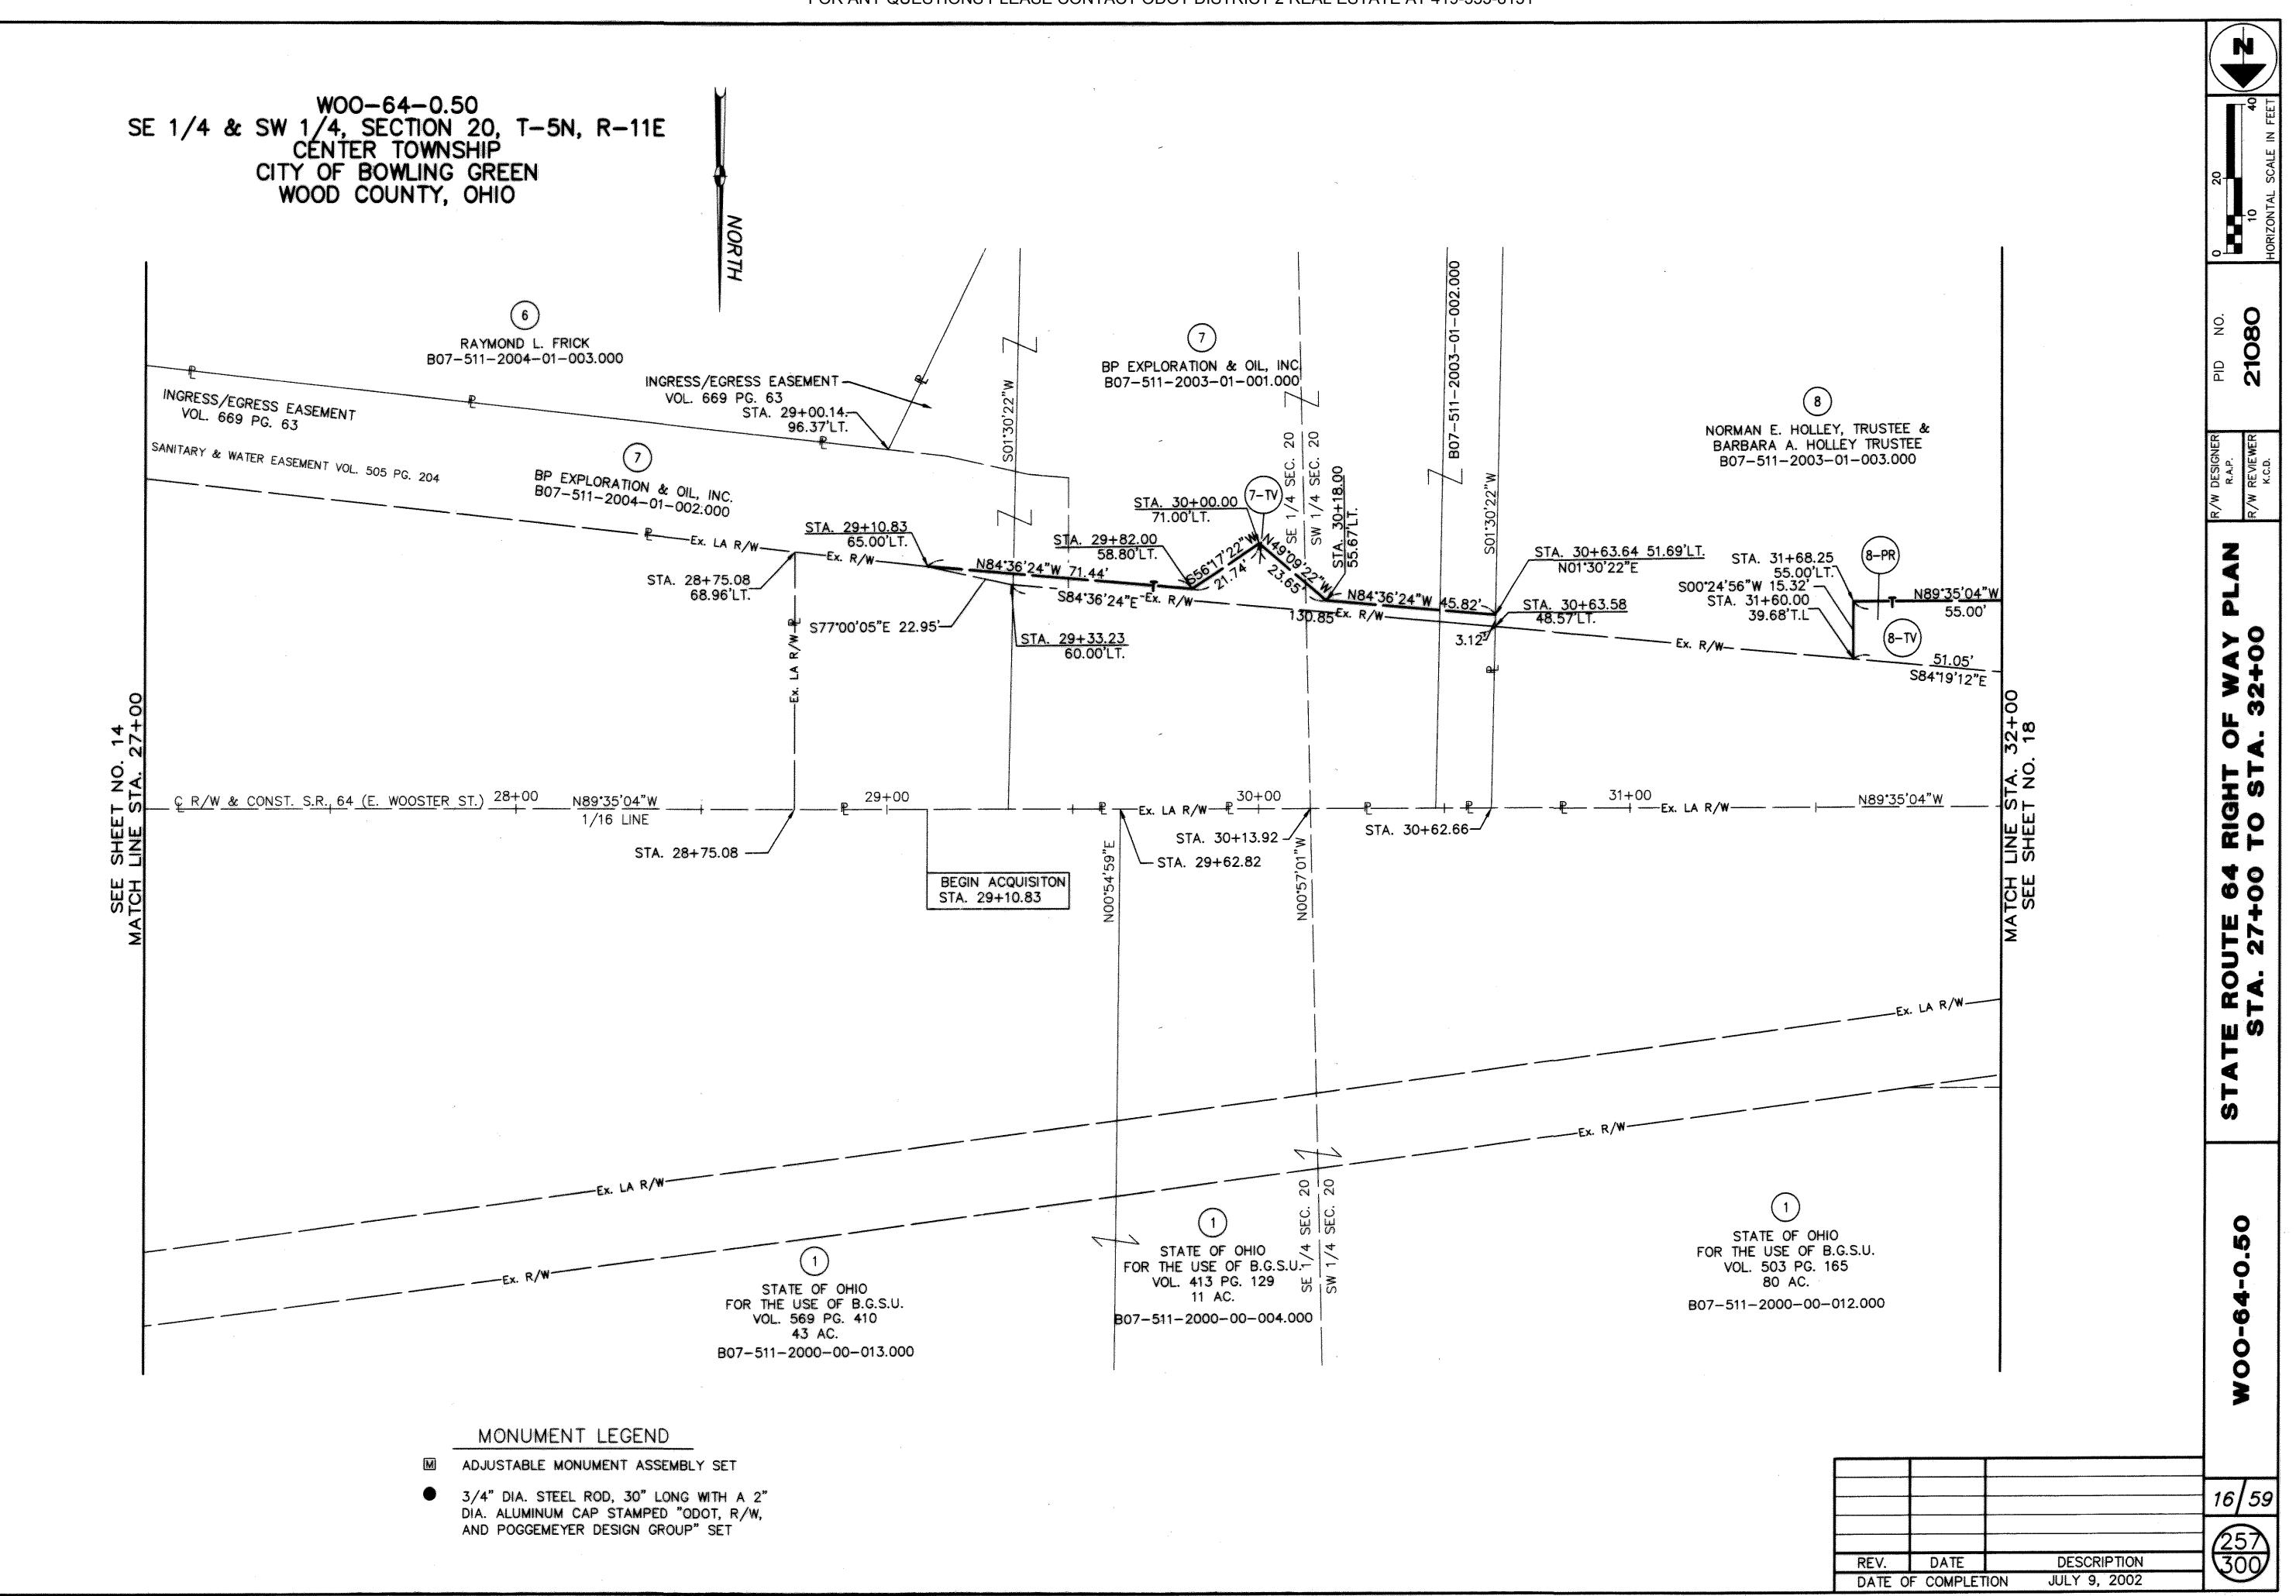

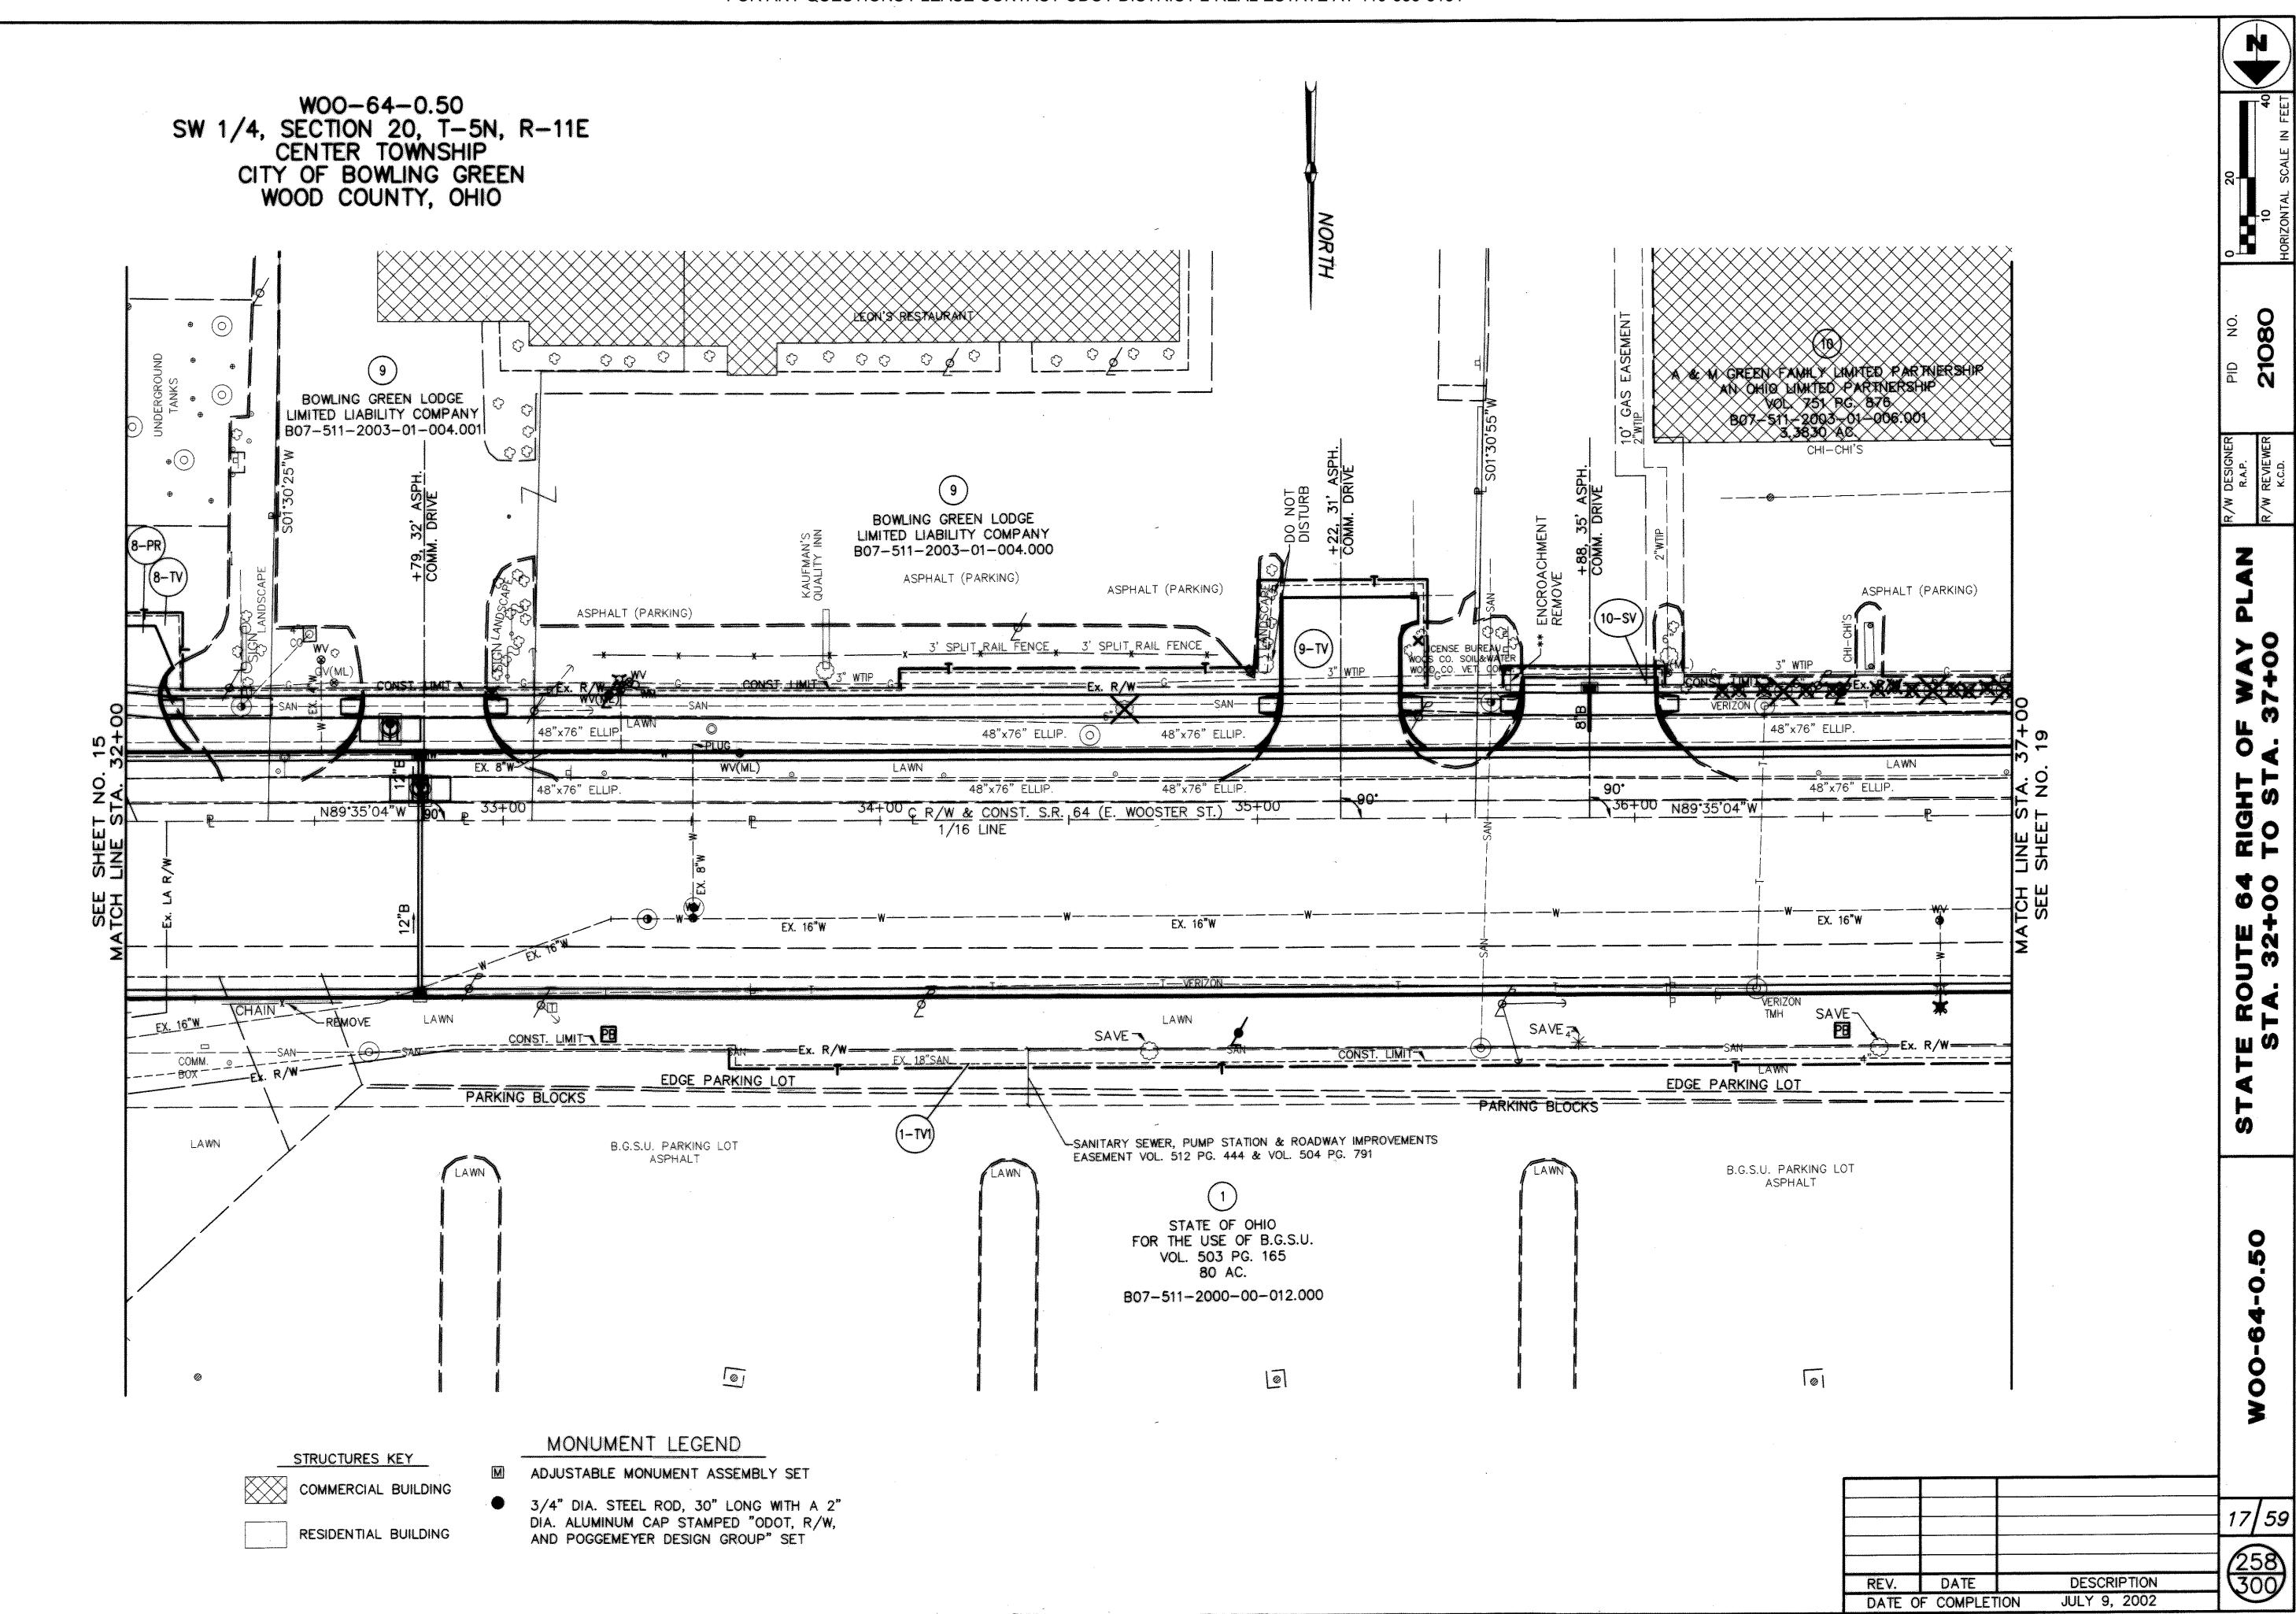



TTED: FEBRUAR

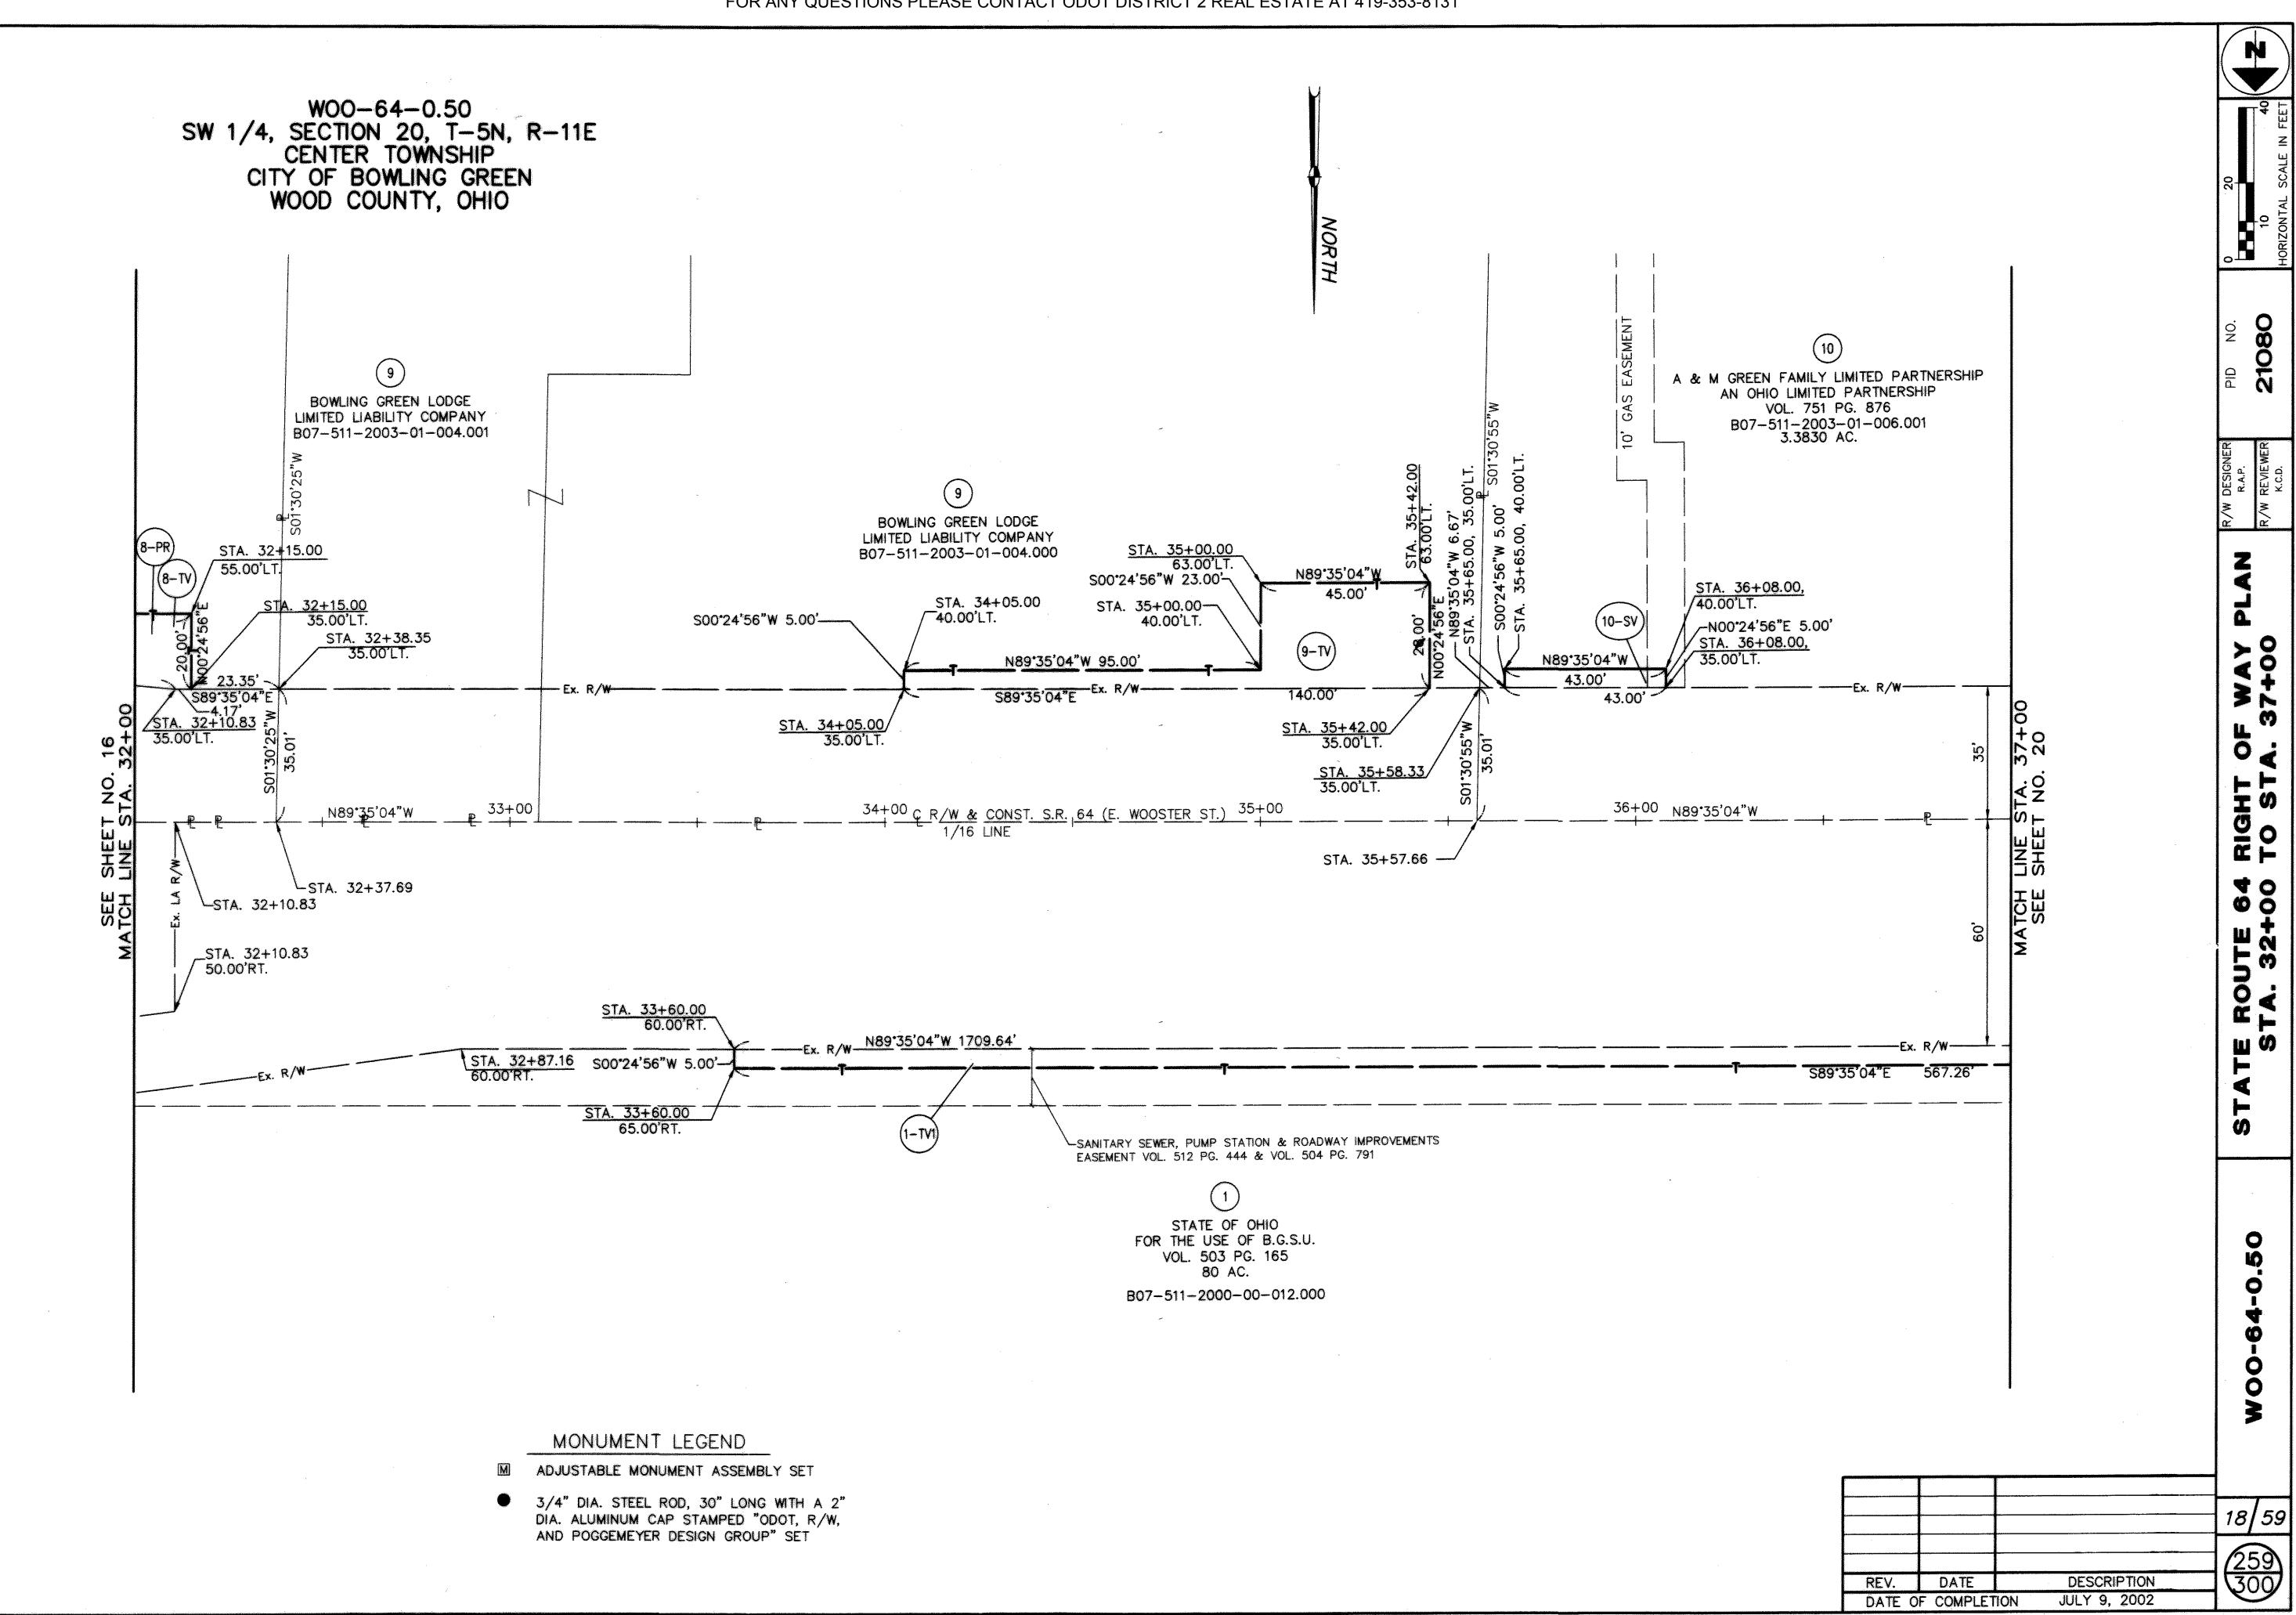

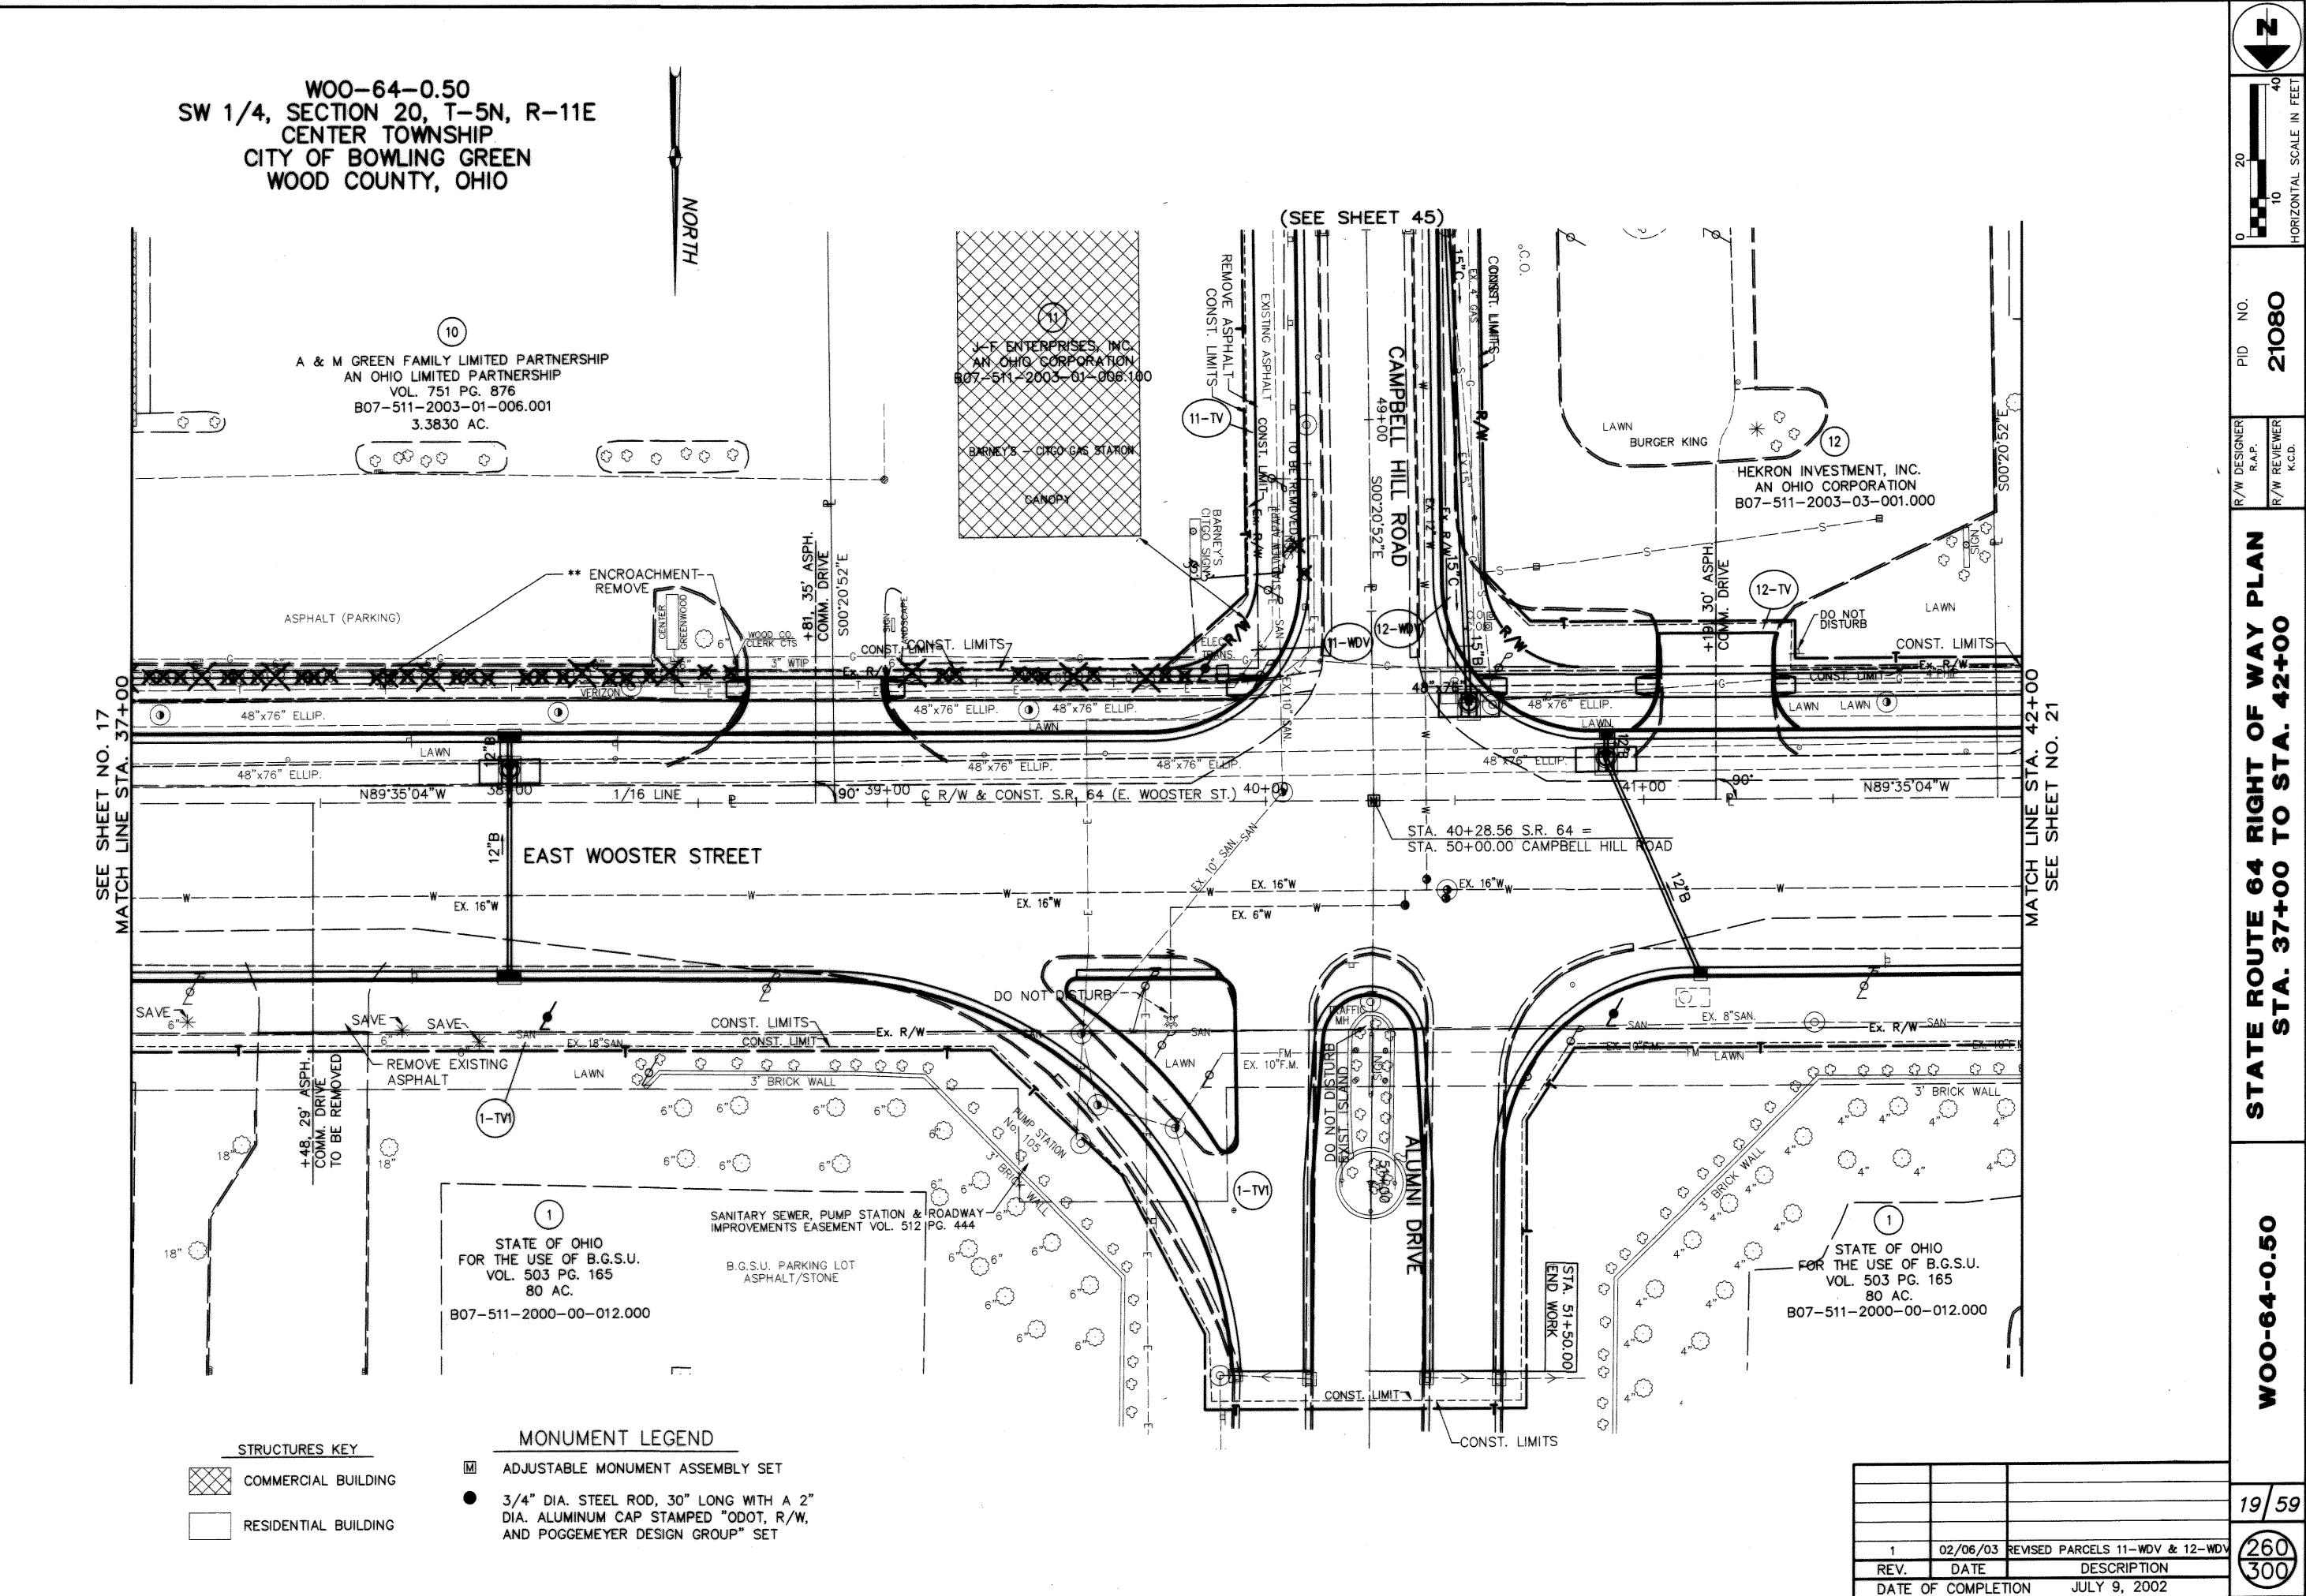


1073\_011 W00\_64\_0 50

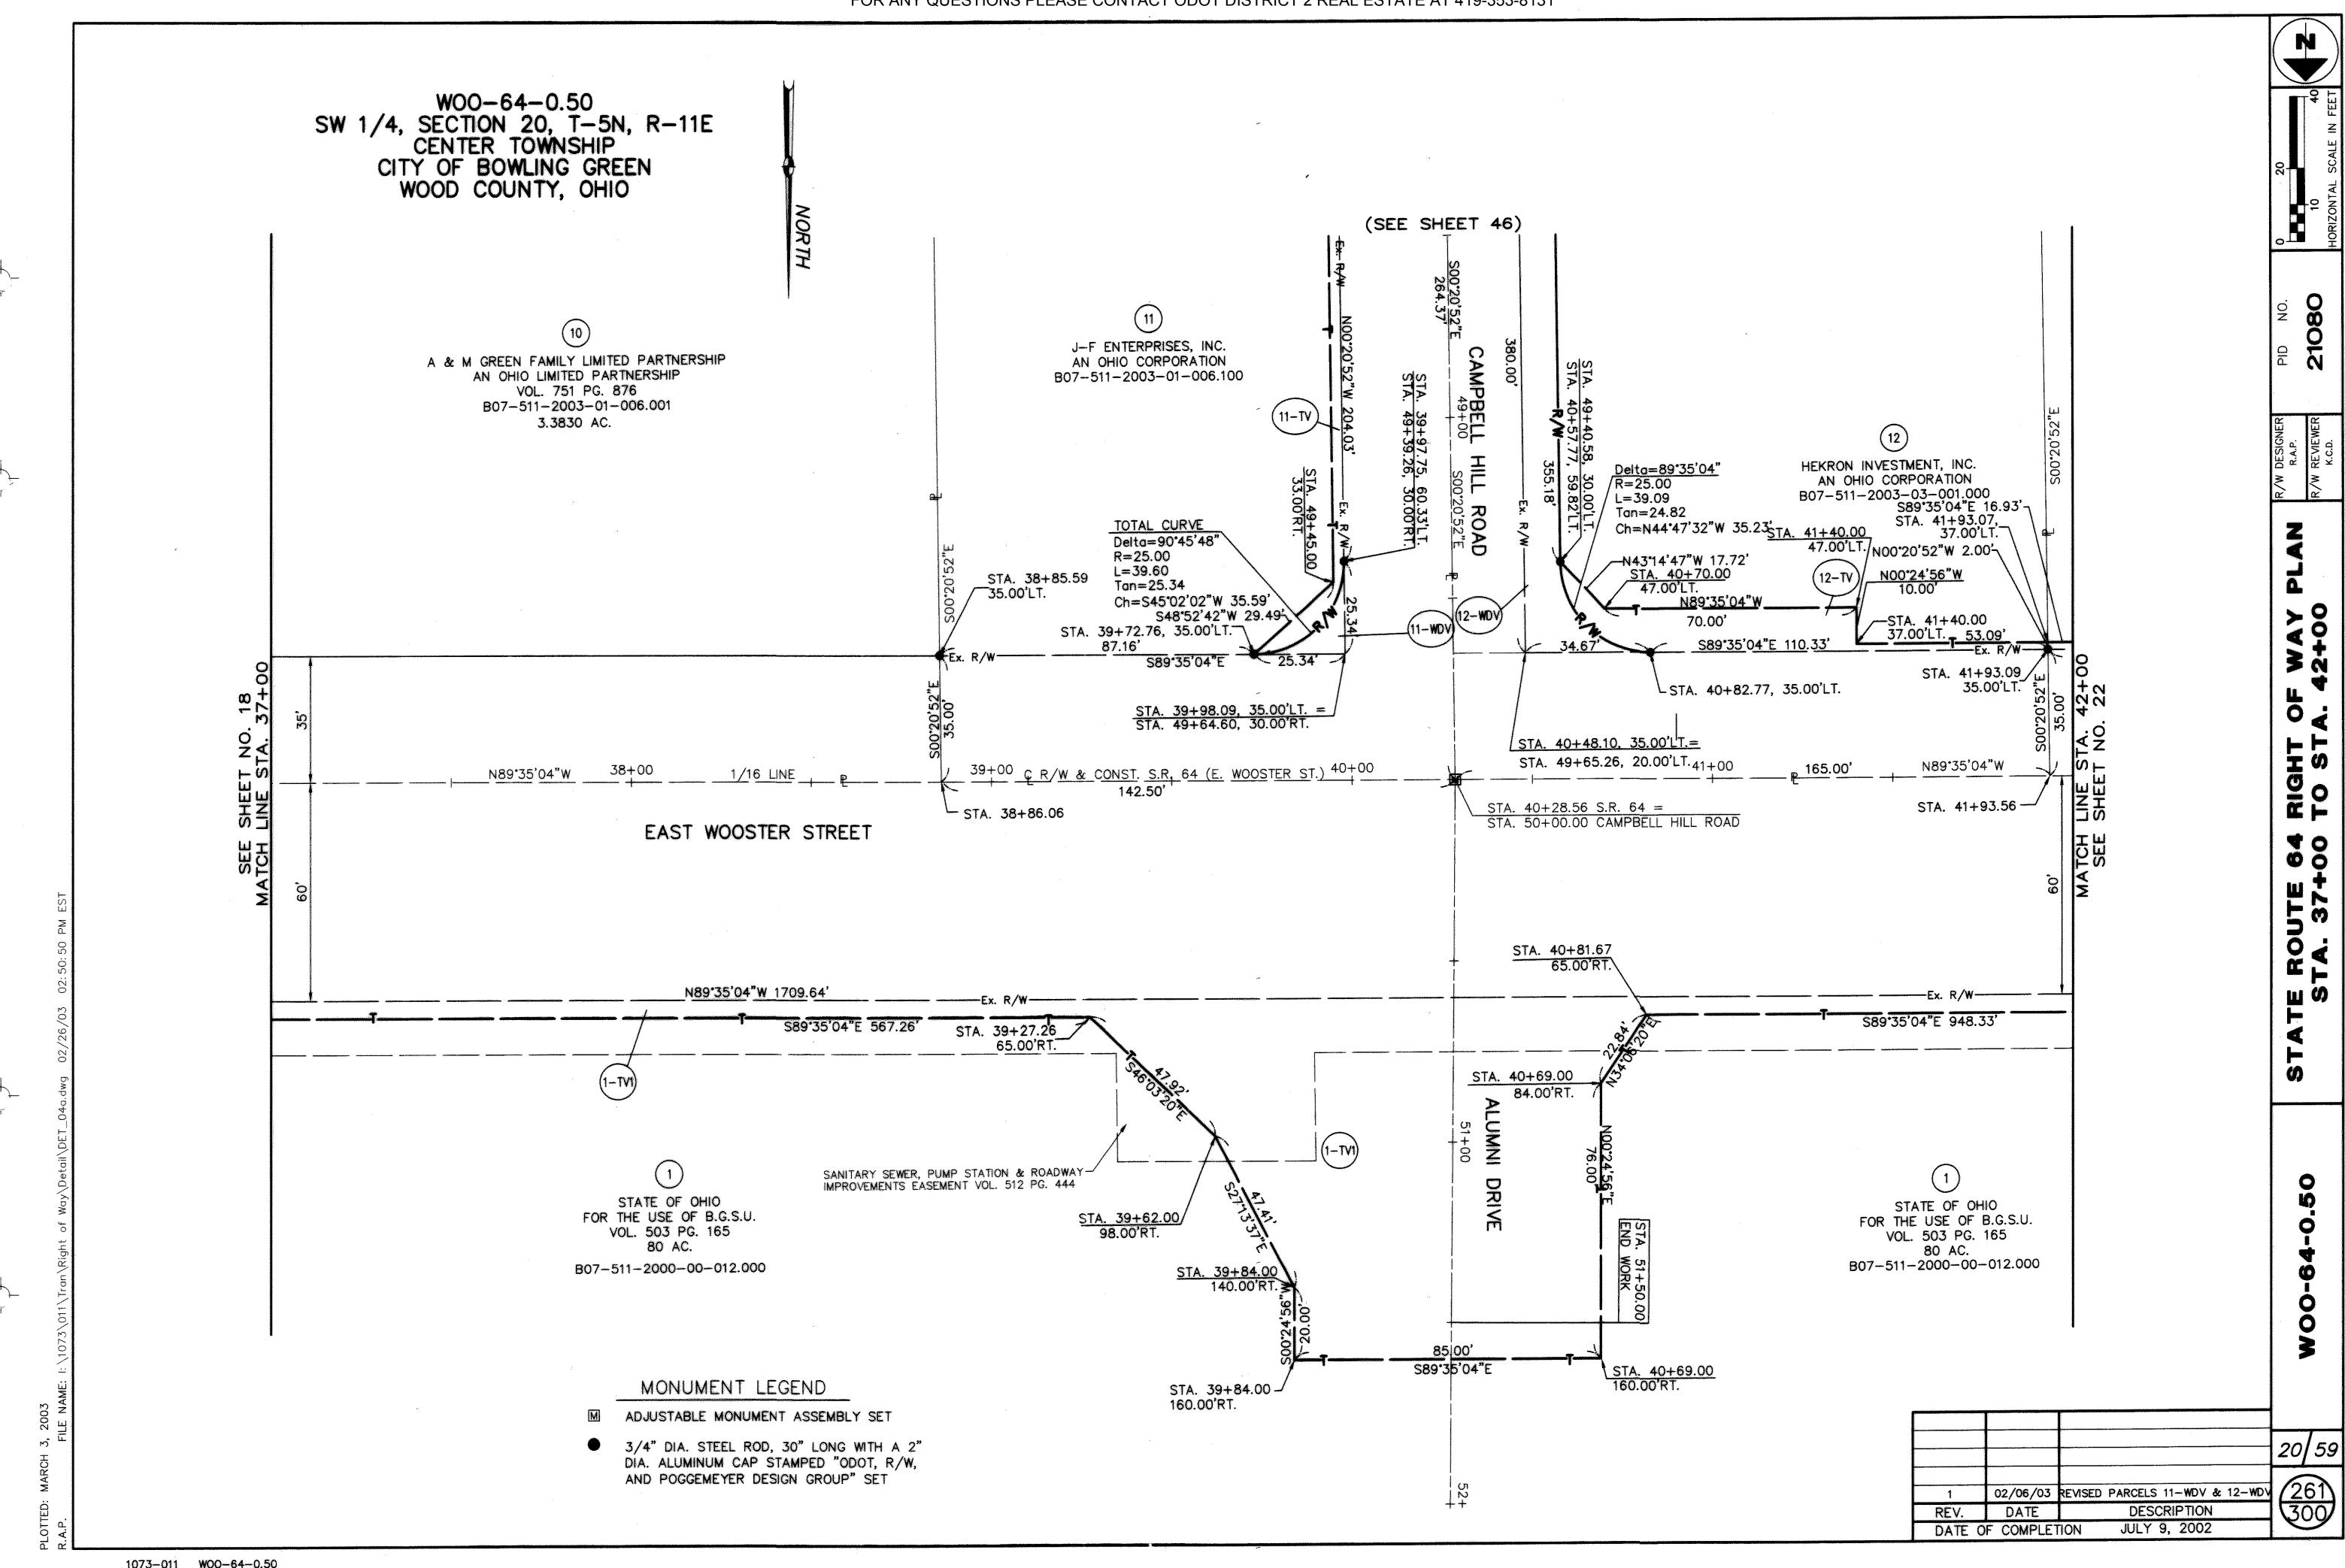

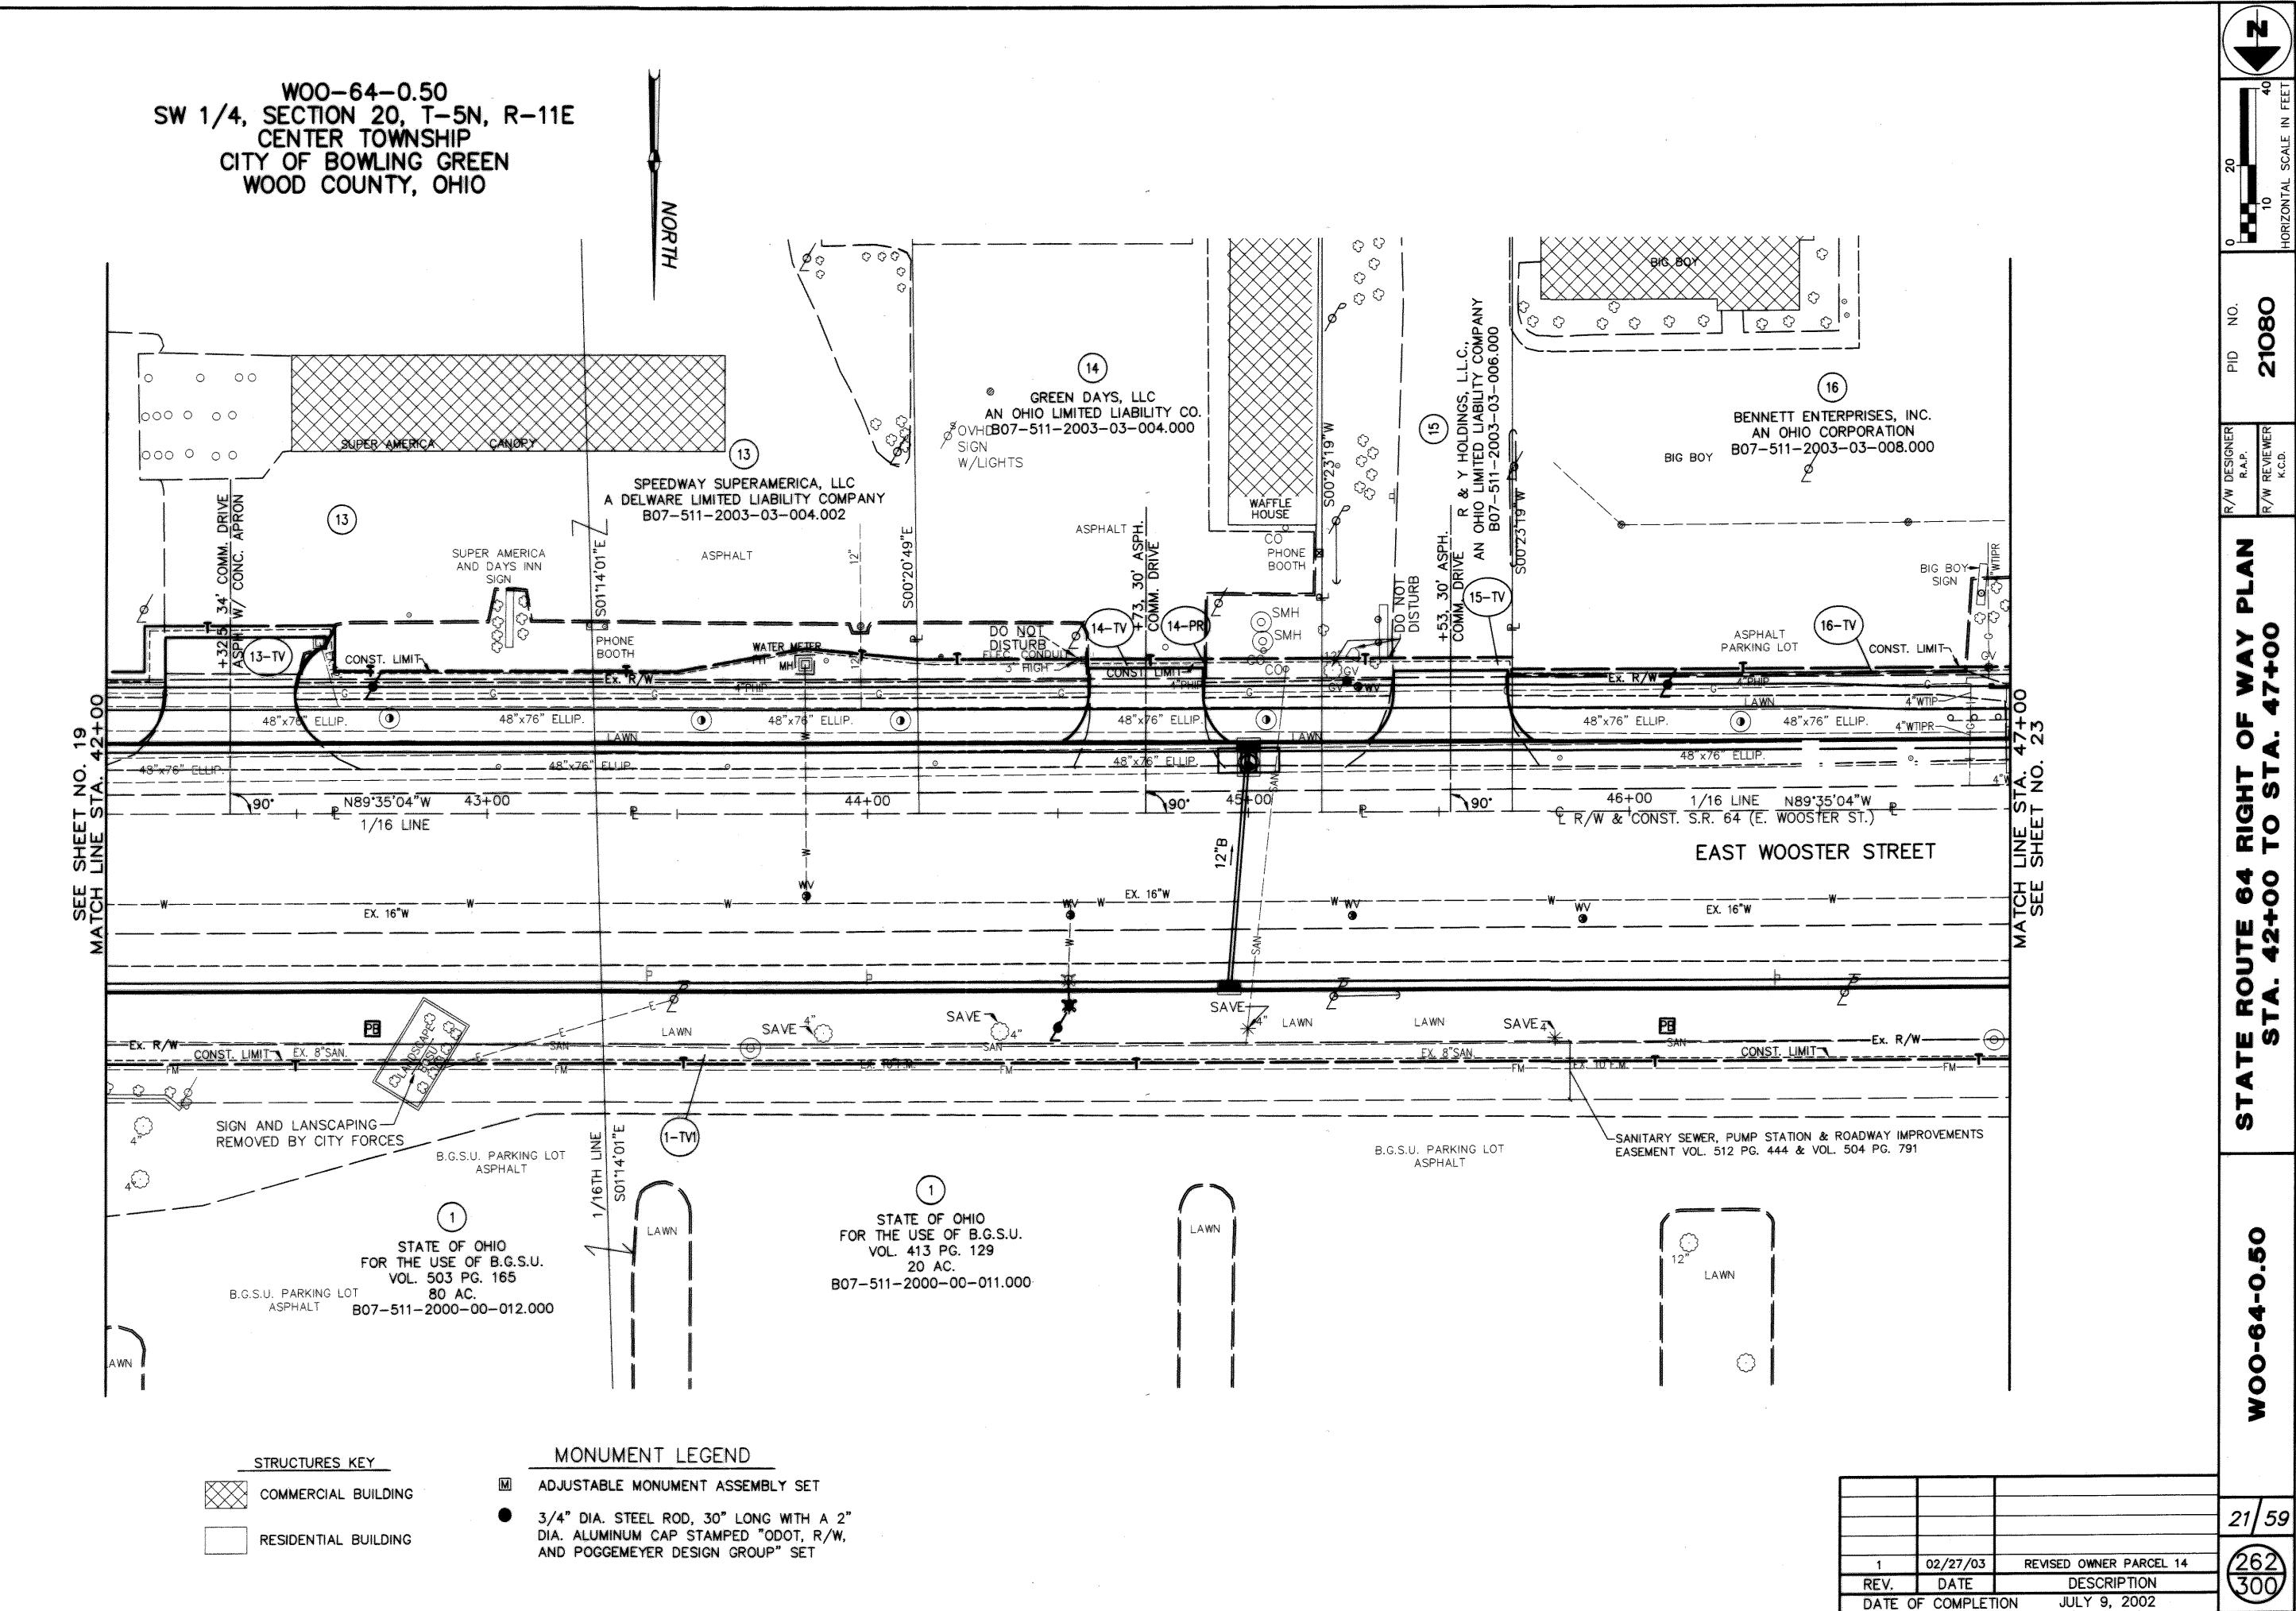

1073\_011 WOO\_64\_0 50

JULY 9, 2002

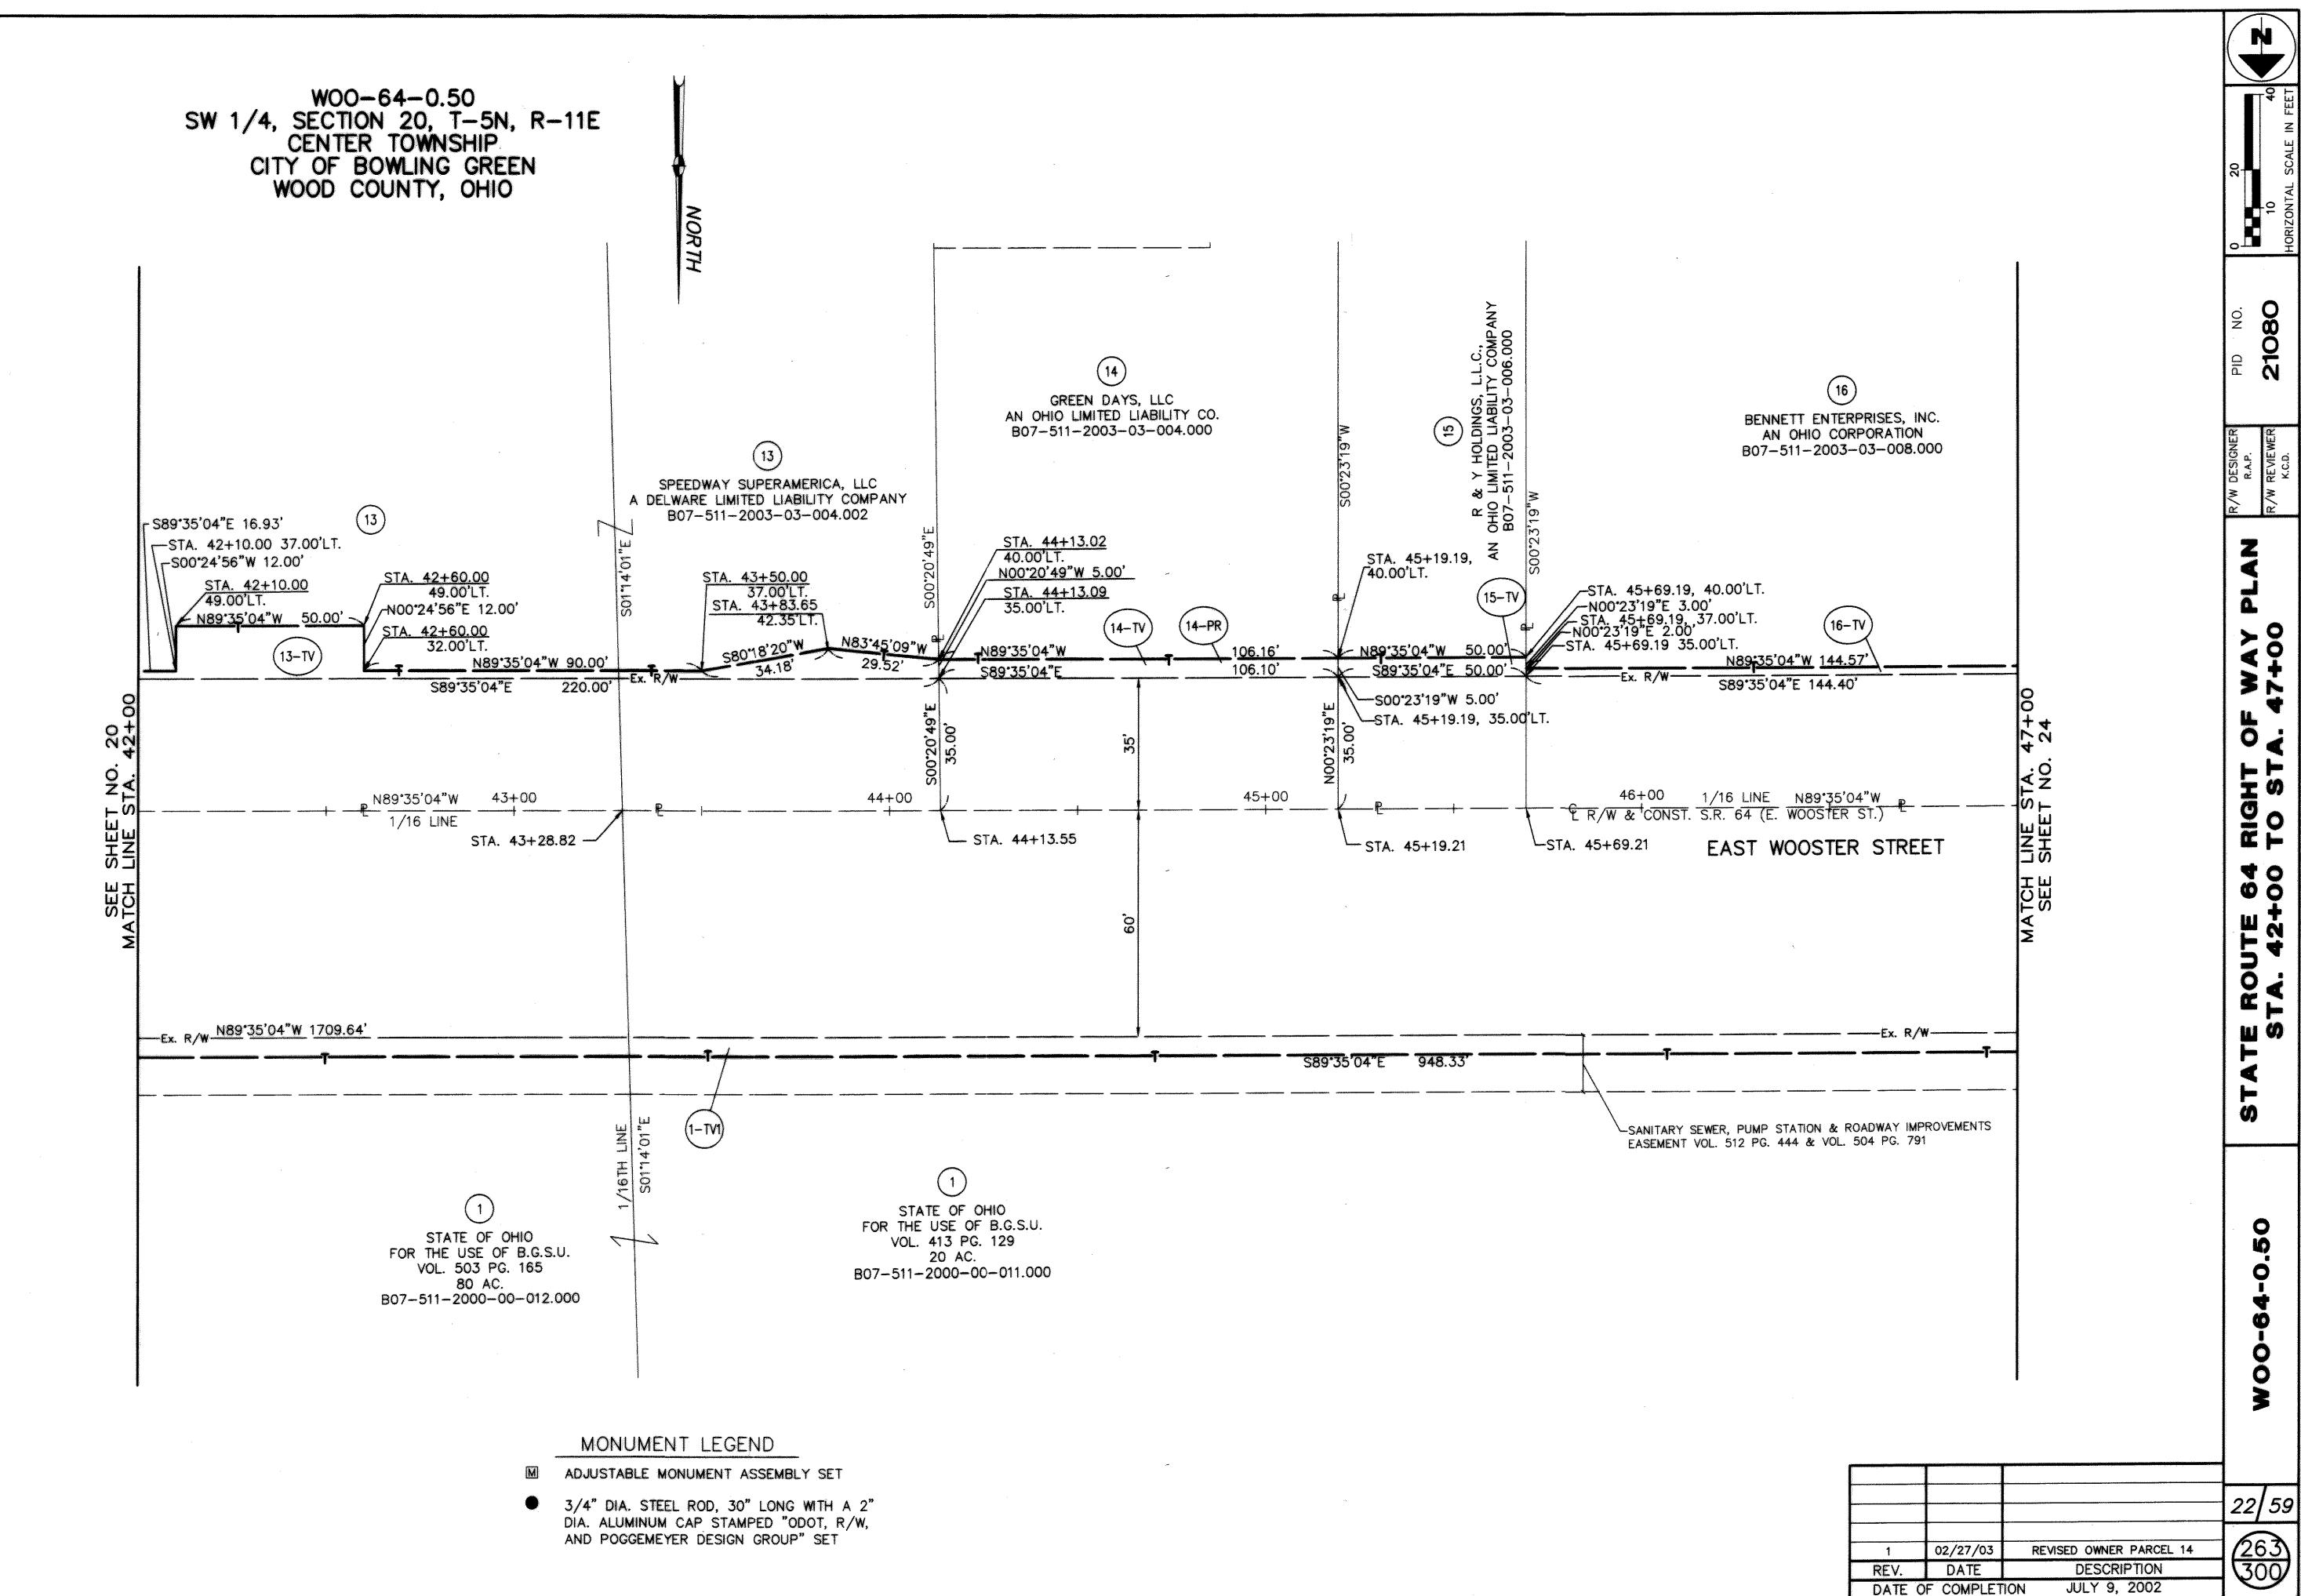

1073-011 WOO-64-0.50

#### MONUMENT LEGEND

N0512'24"E 2.01


S89'35'04"E 61.41'

STA. 47+13.59
35.00'LT.


∠STA. 47+10.66


- M ADJUSTABLE MONUMENT ASSEMBLY SET
- 3/4" DIA. STEEL ROD, 30" LONG WITH A 2" DIA. ALUMINUM CAP STAMPED "ODOT, R/W, AND POGGEMEYER DESIGN GROUP" SET


24 59 03/04/03 REVISED PARCEL 2-WDV TO 2-SHV 300 DESCRIPTION REV. DATE JULY 9, 2002 DATE OF COMPLETION

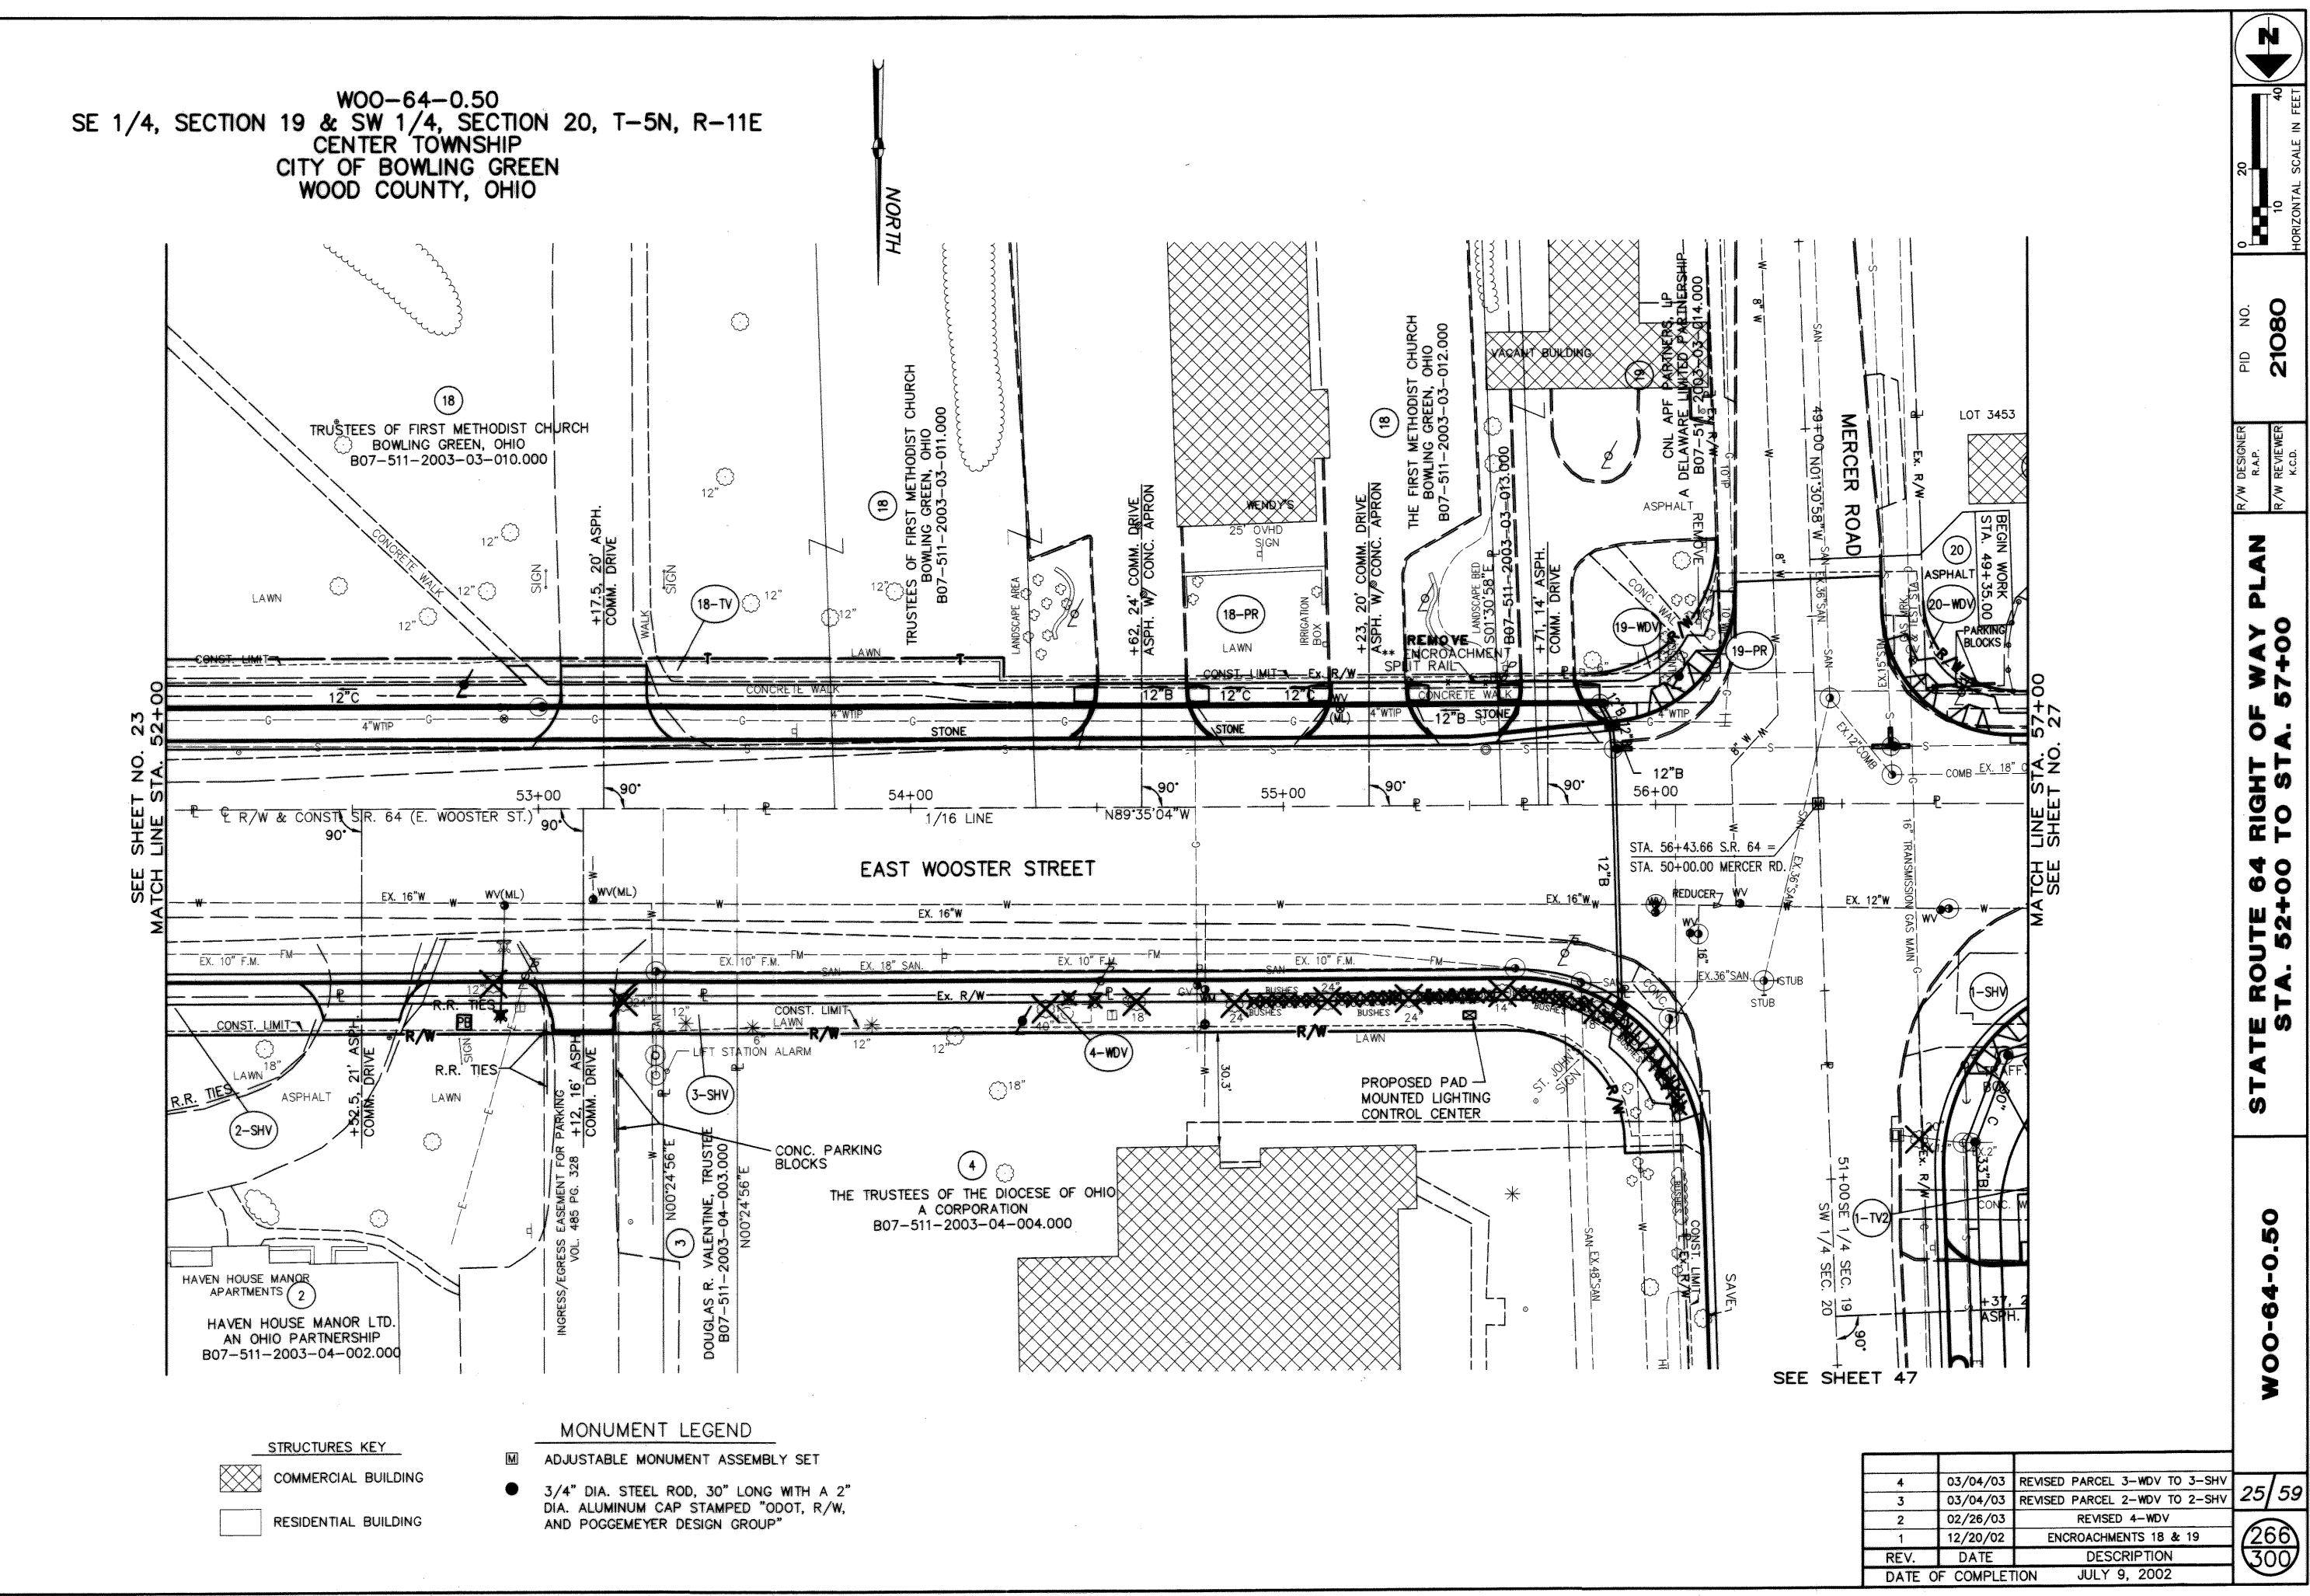


1073\_011 W00\_64\_0 50

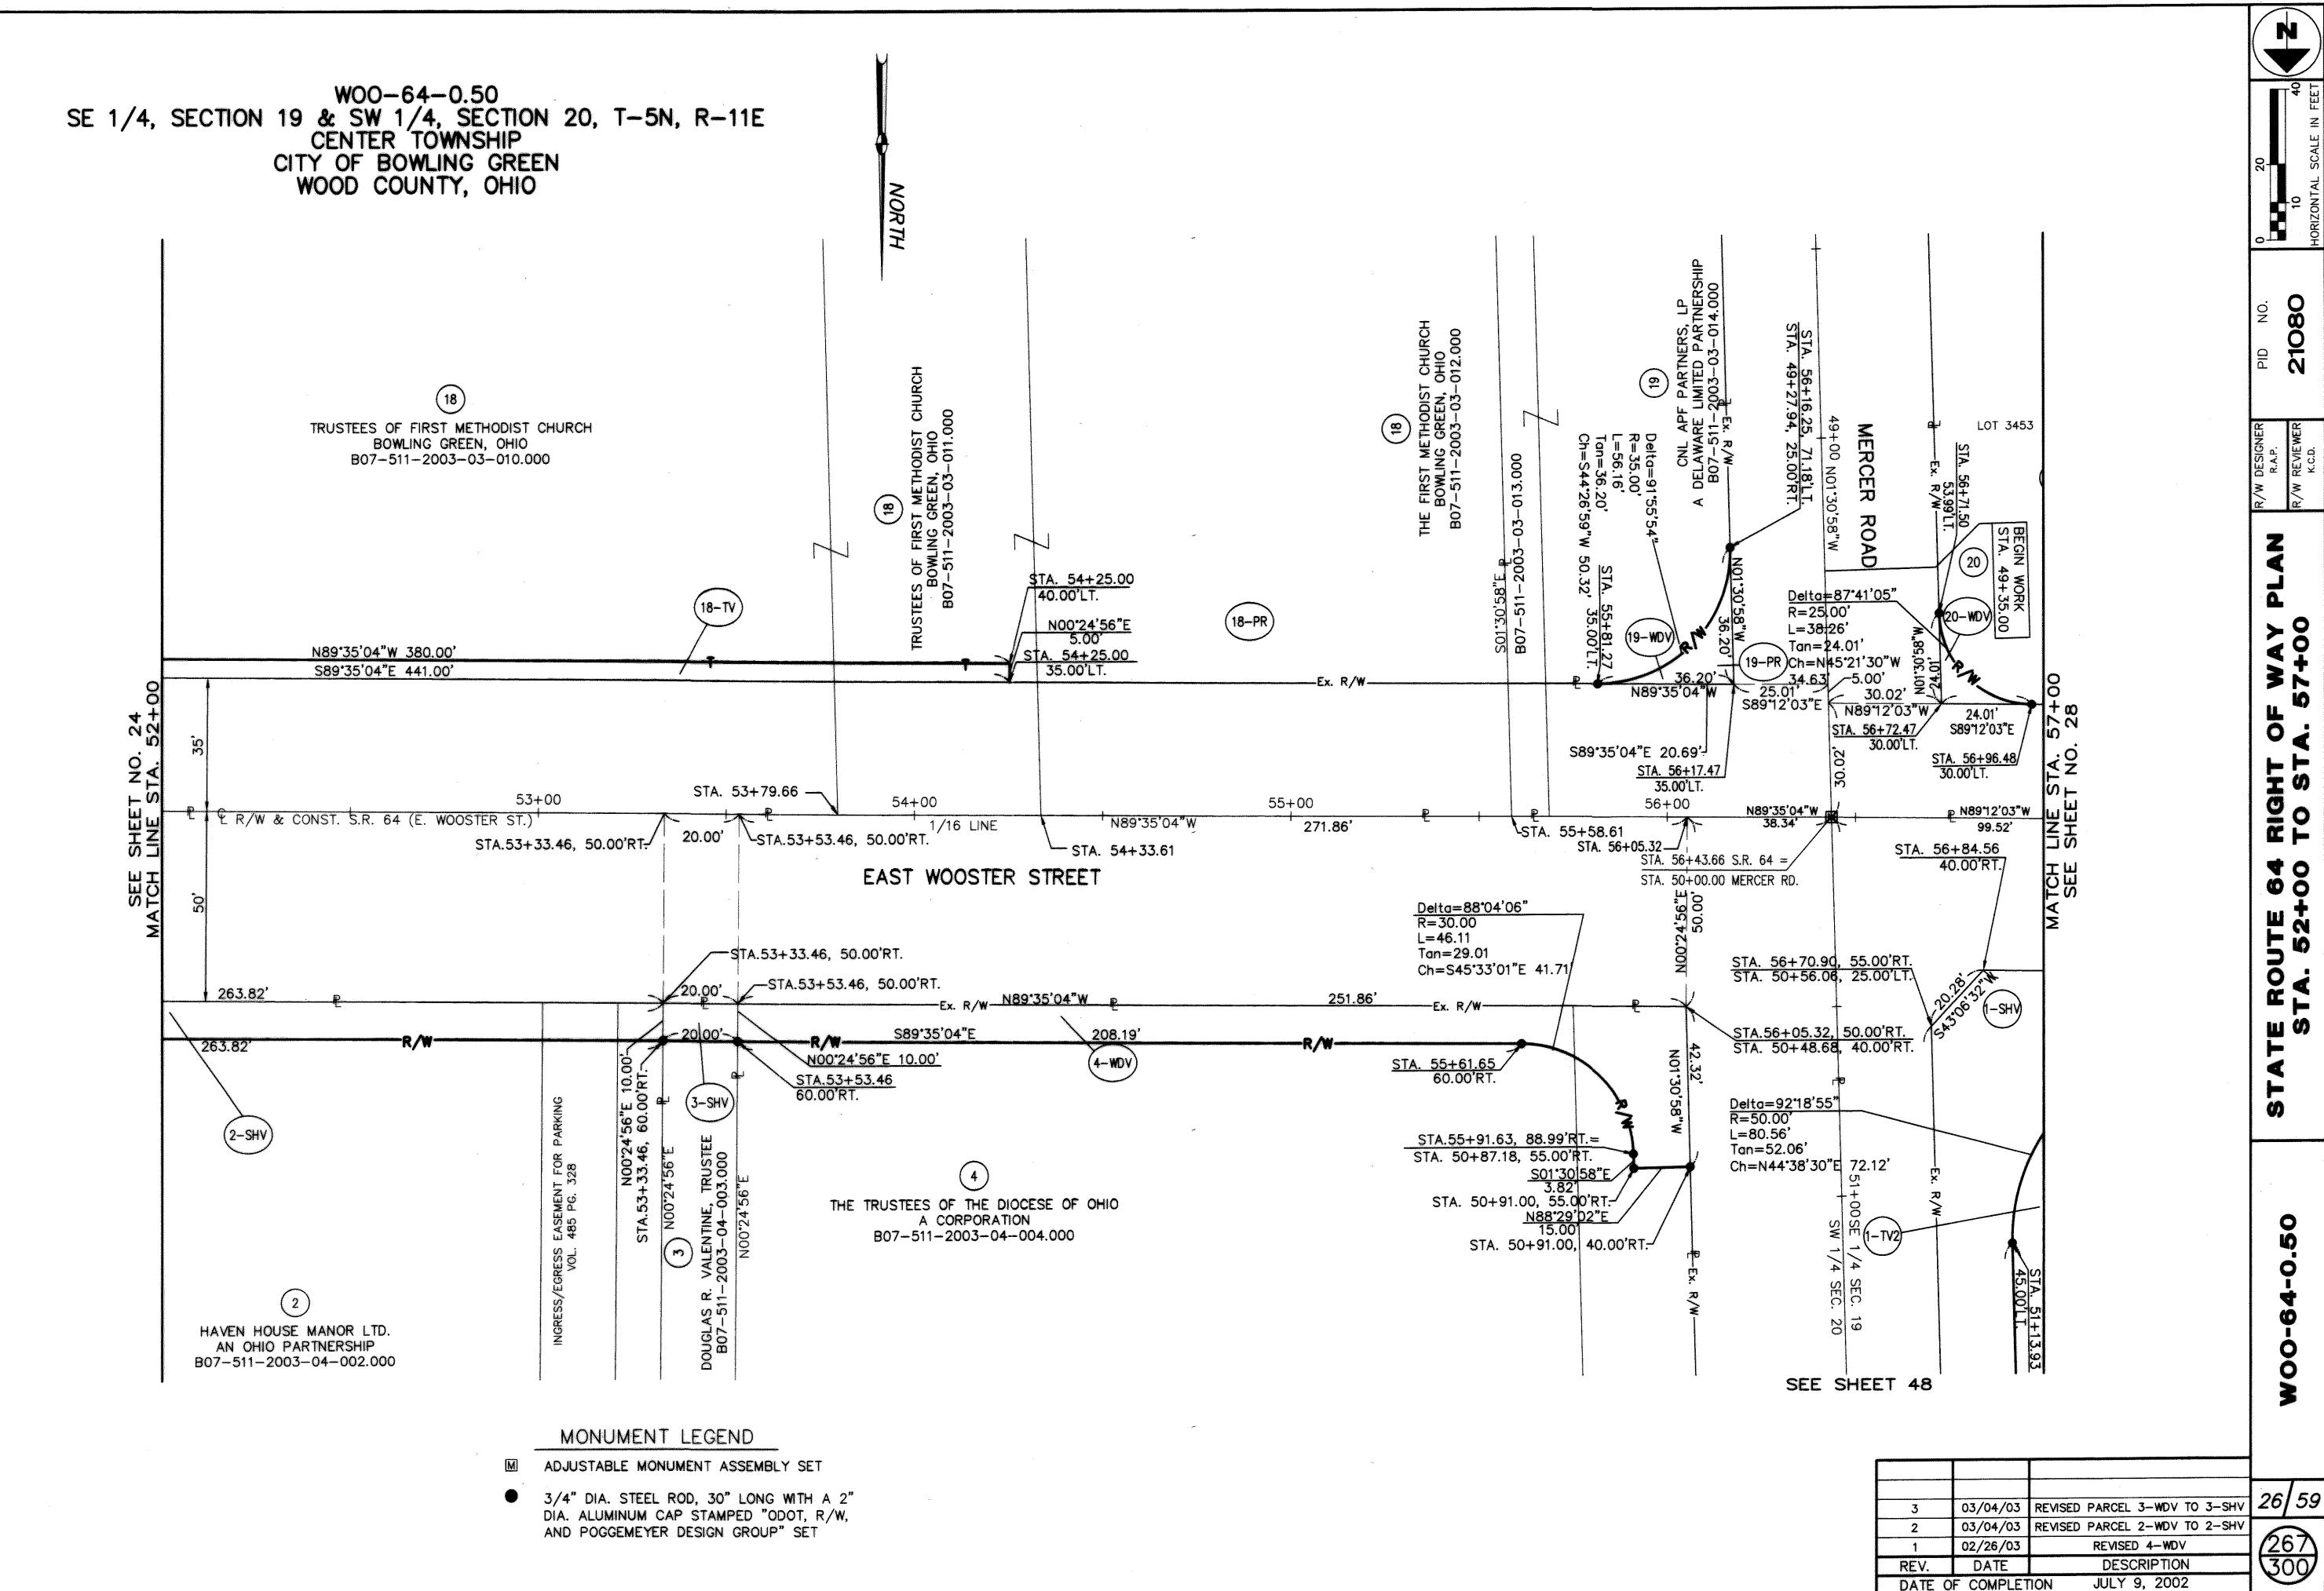

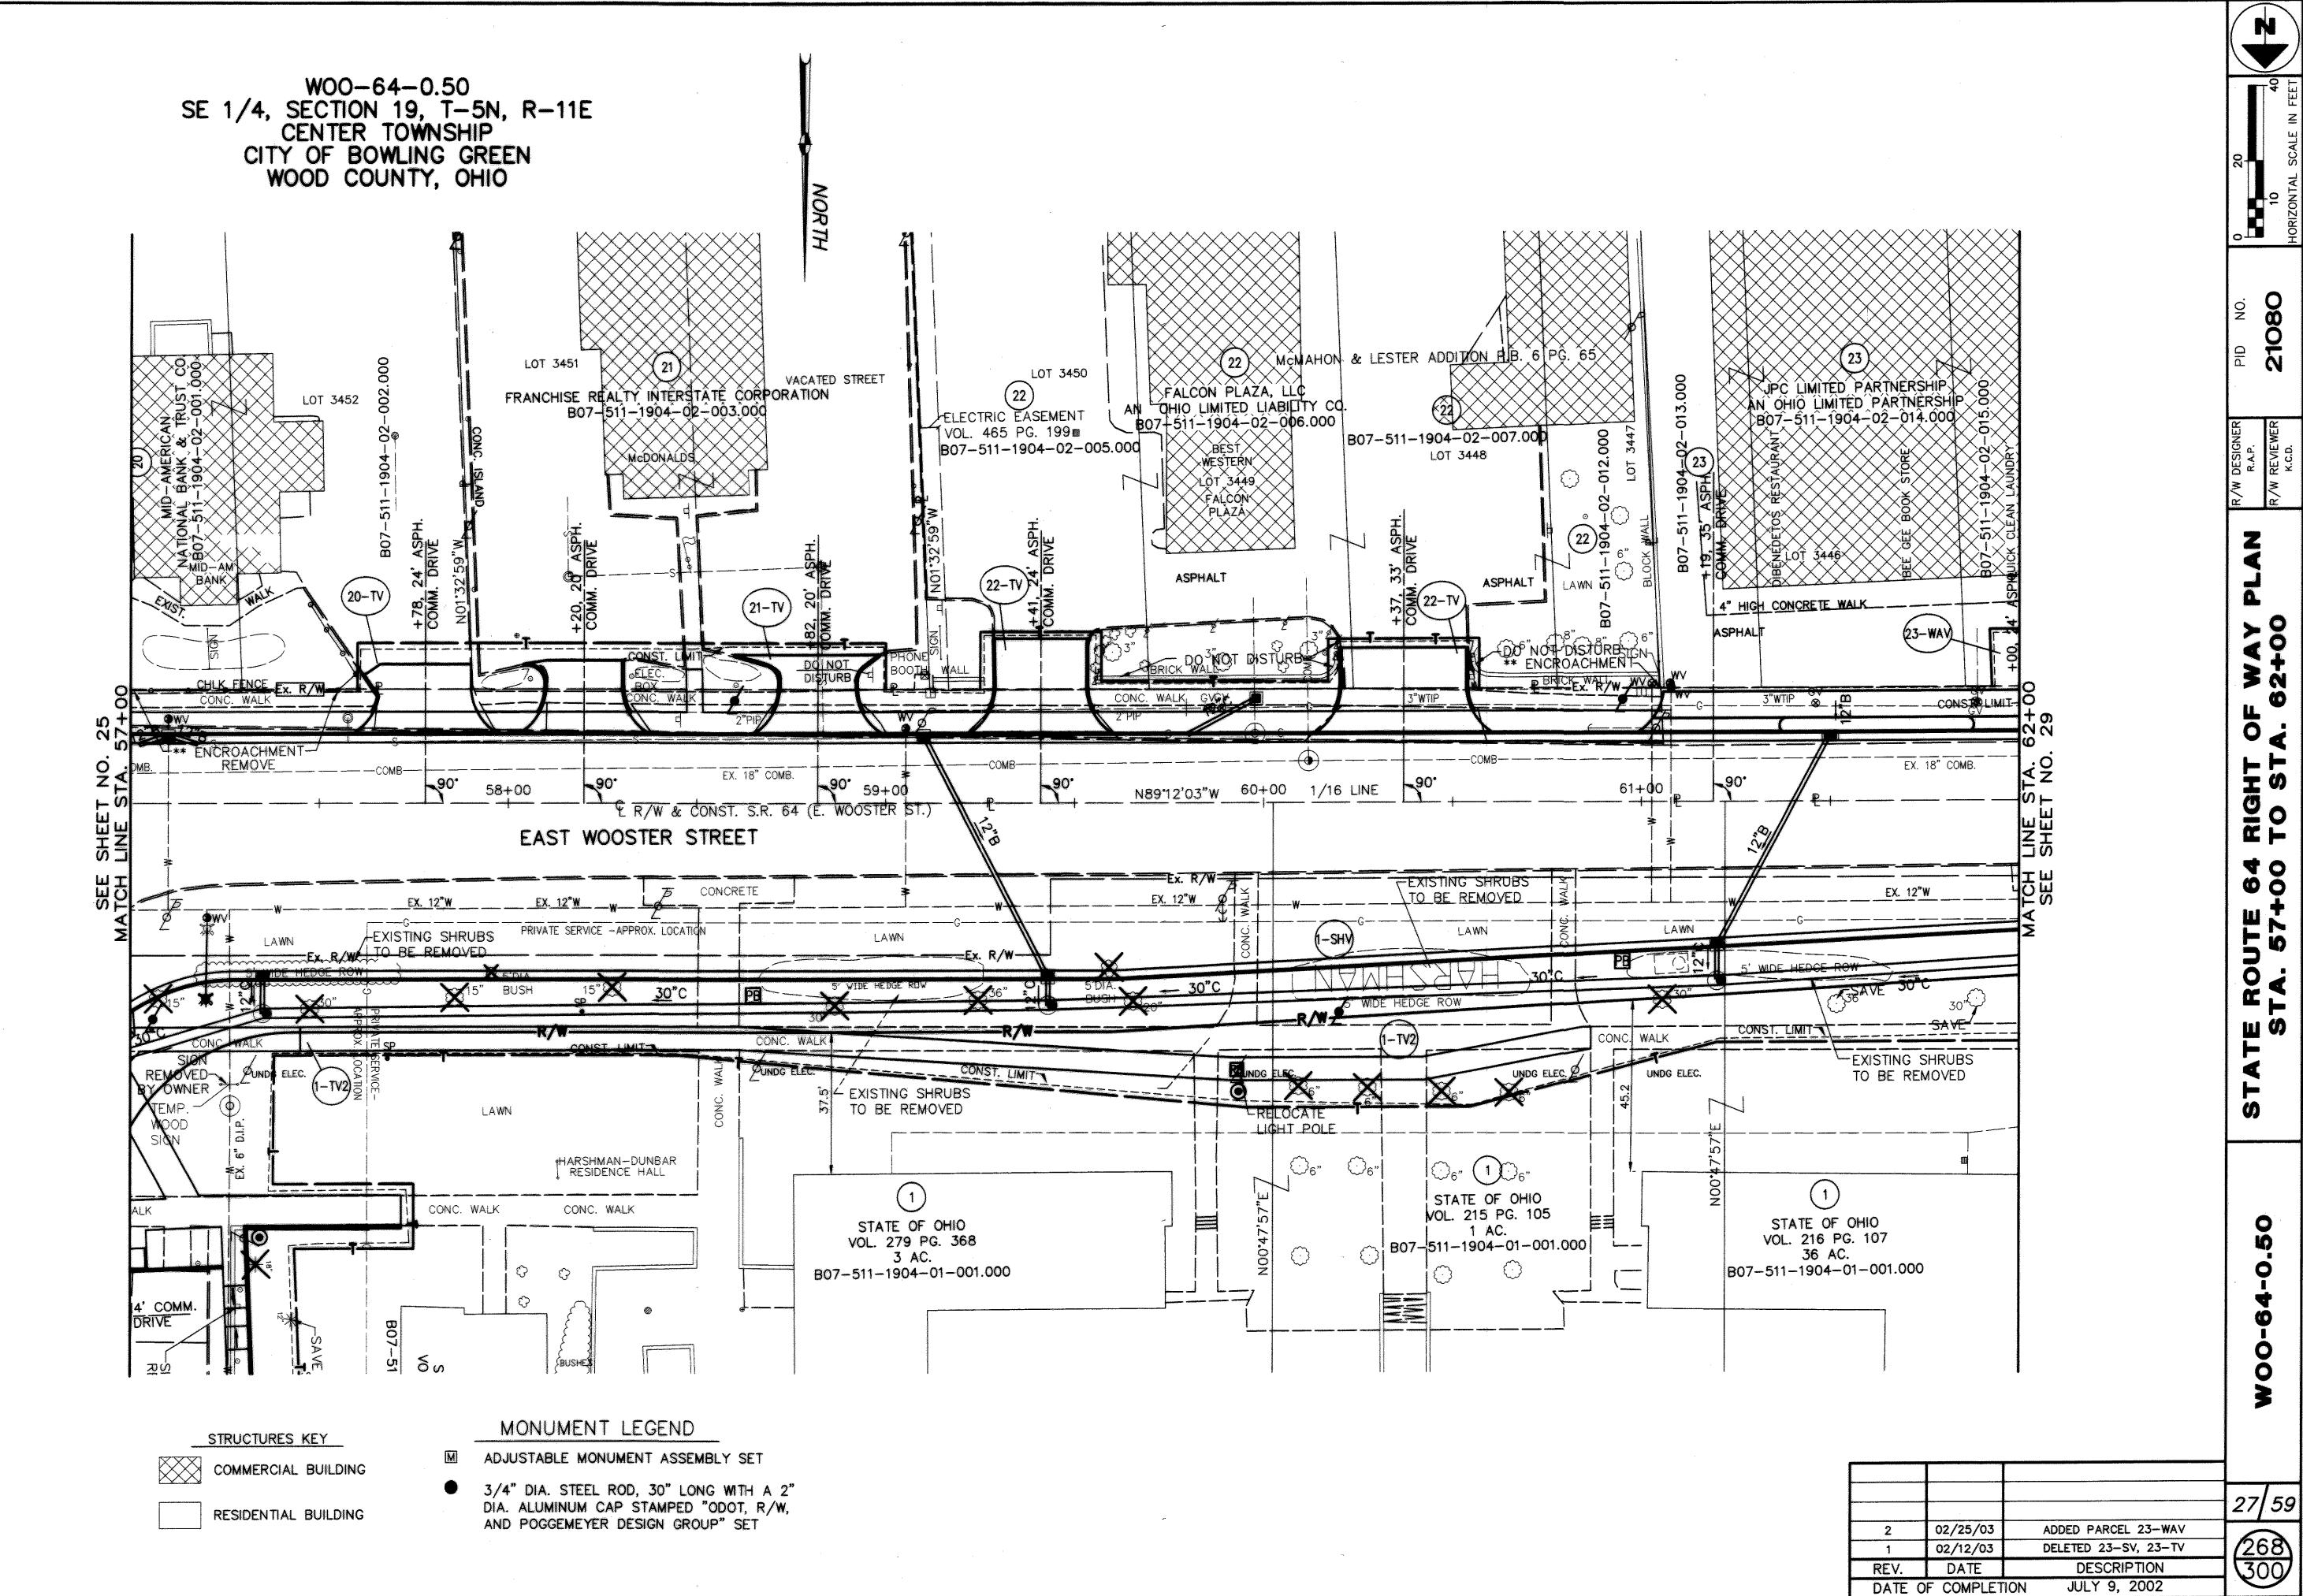


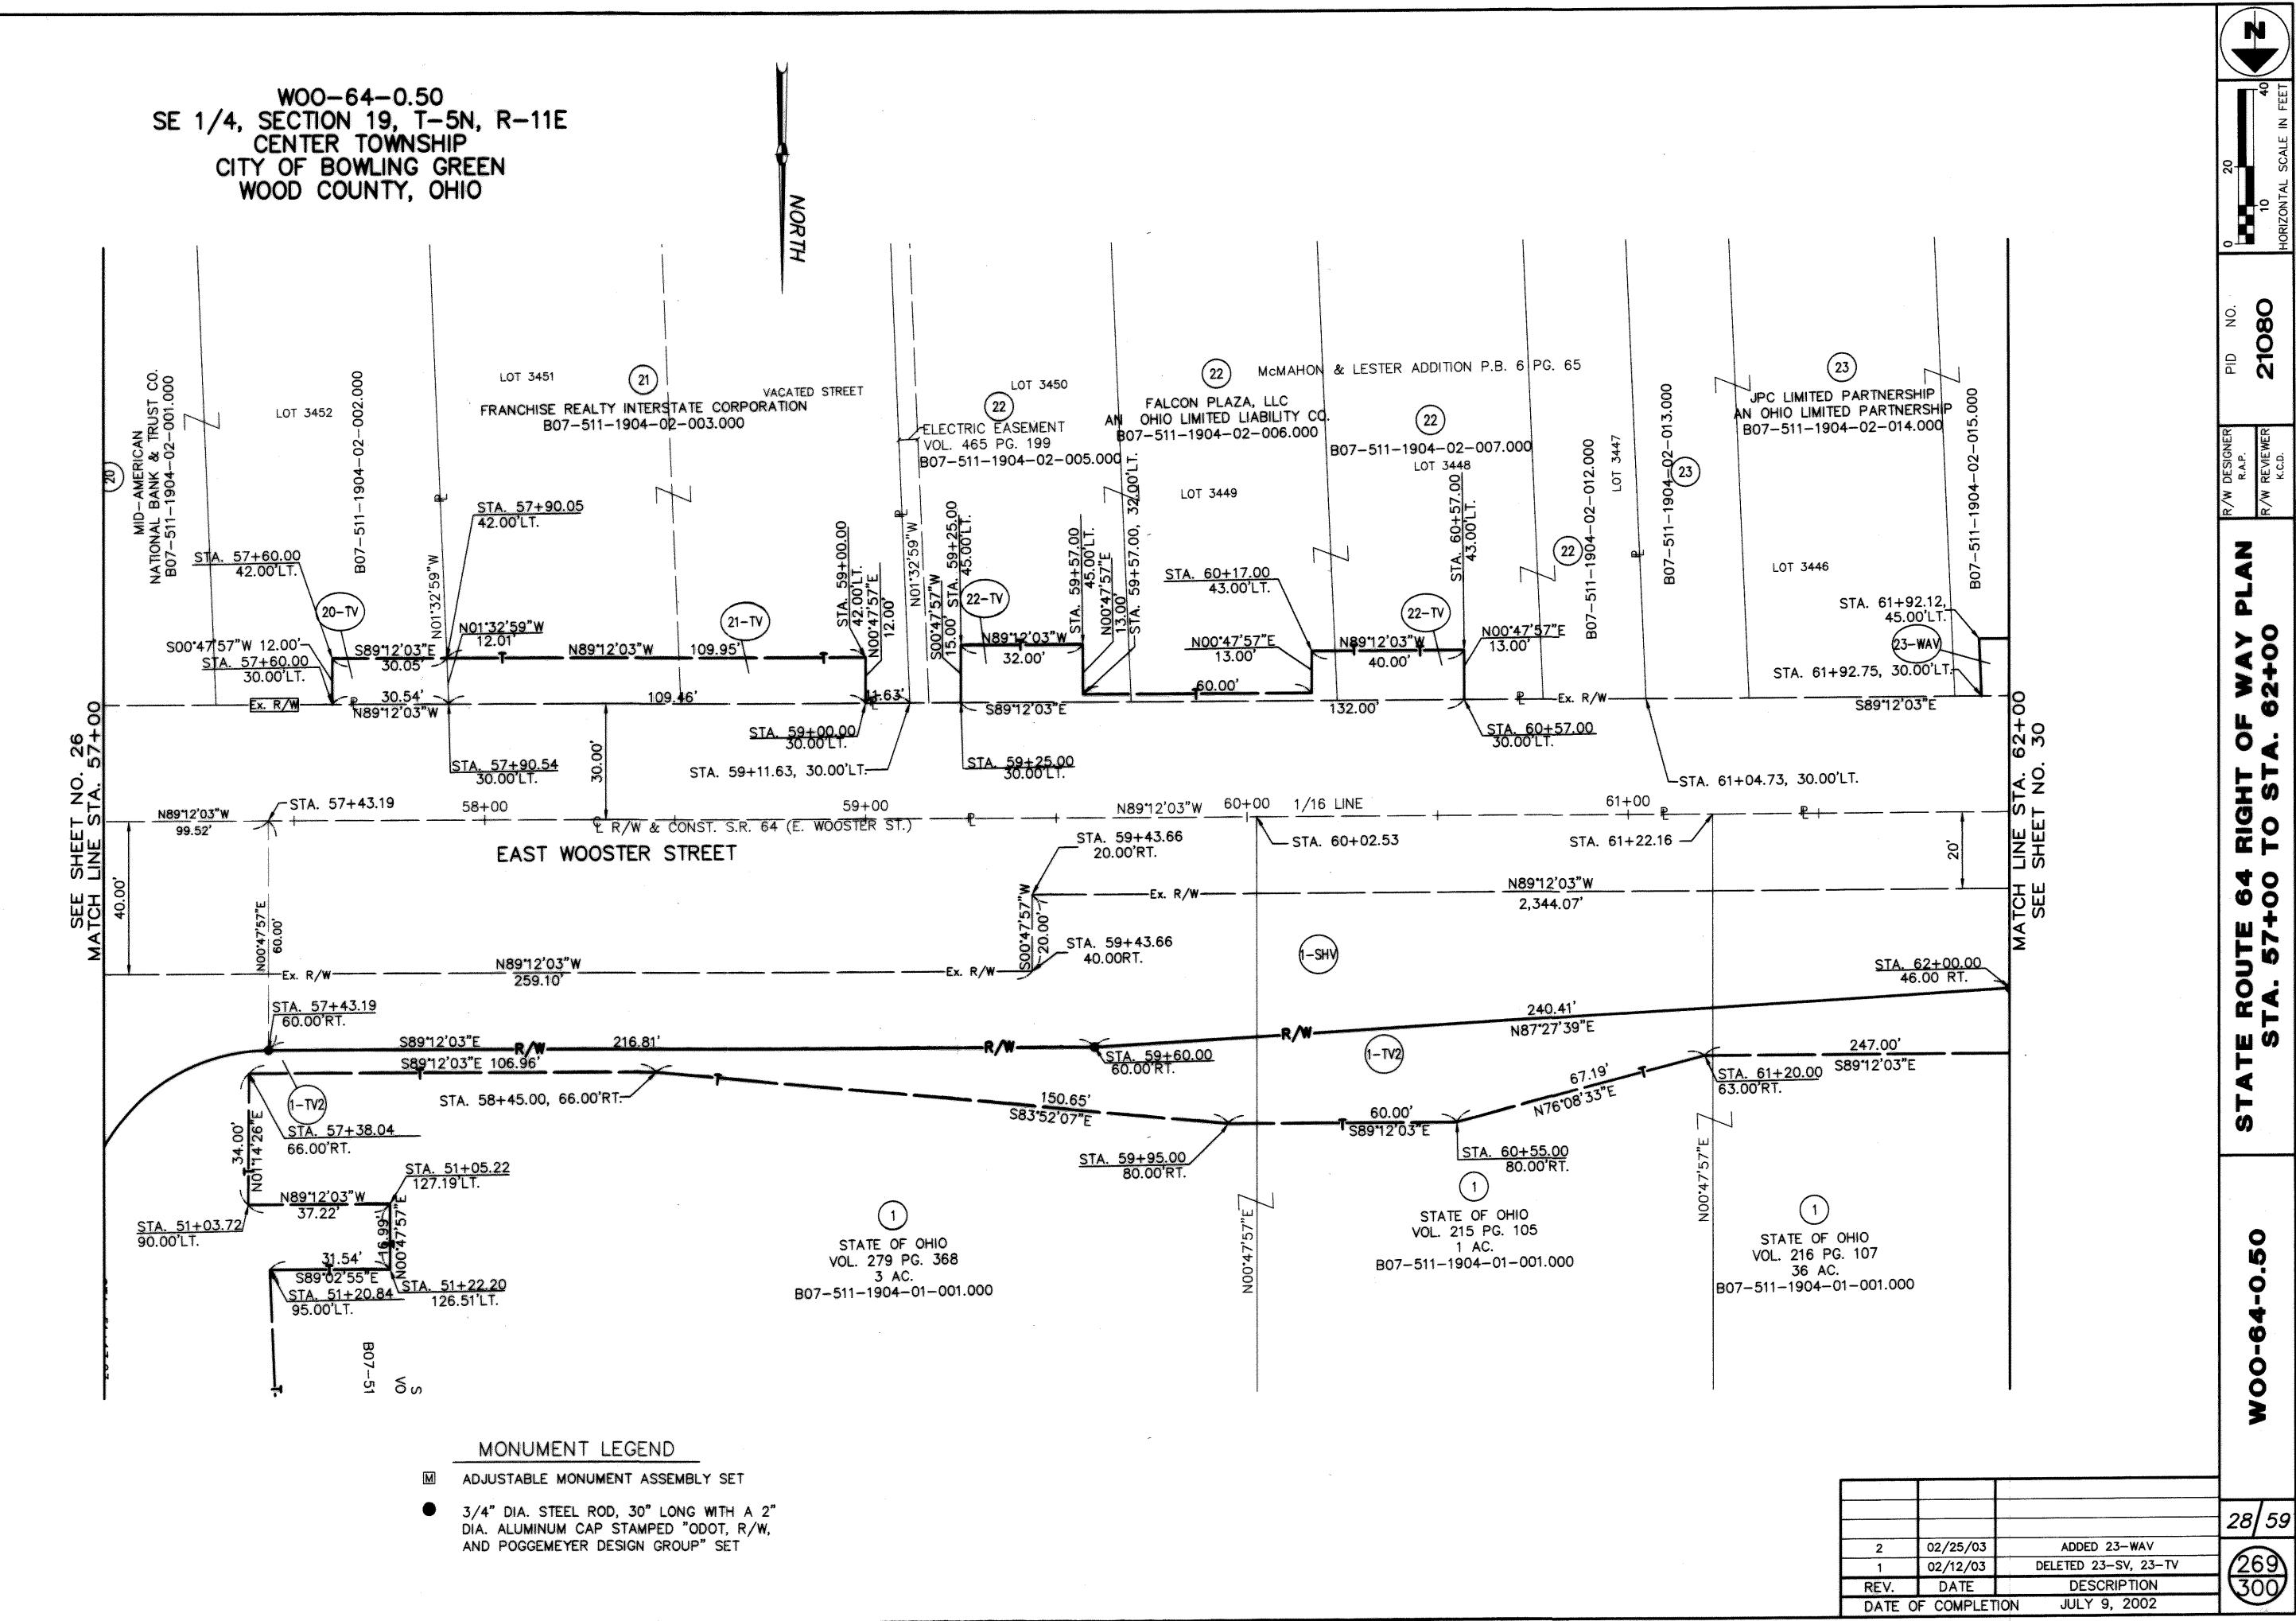

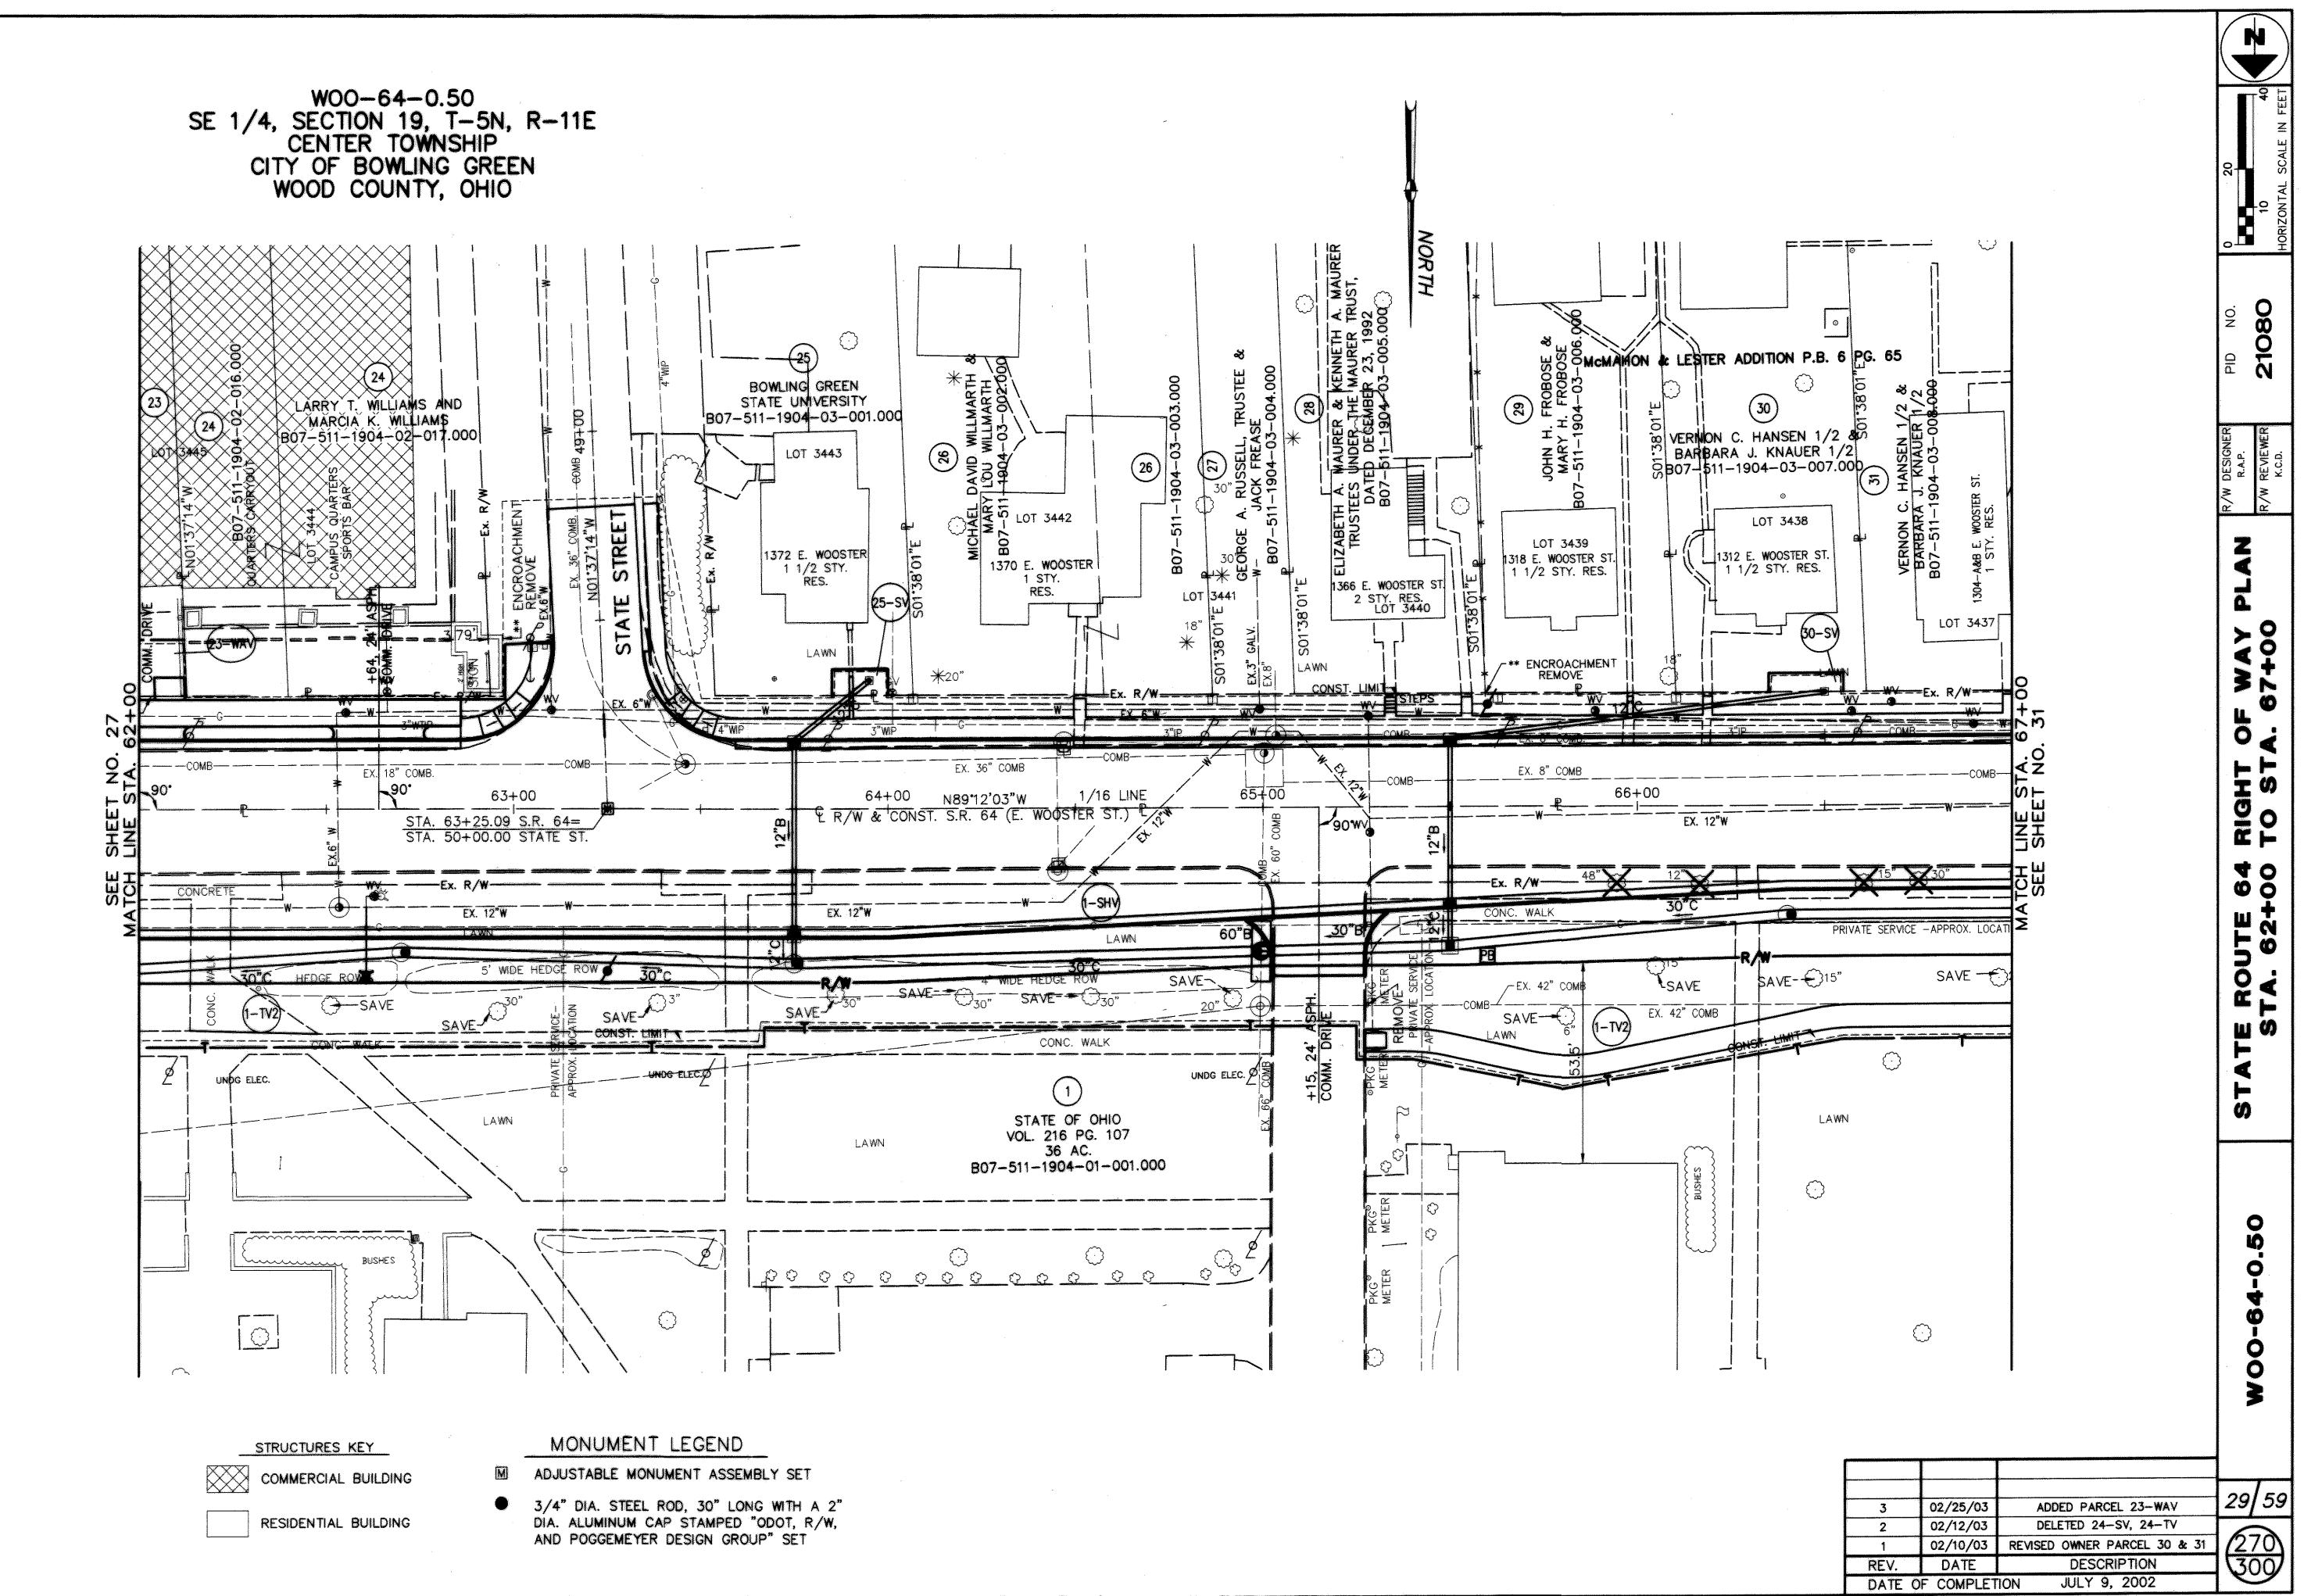


OTTED: MABOU A 3003

4

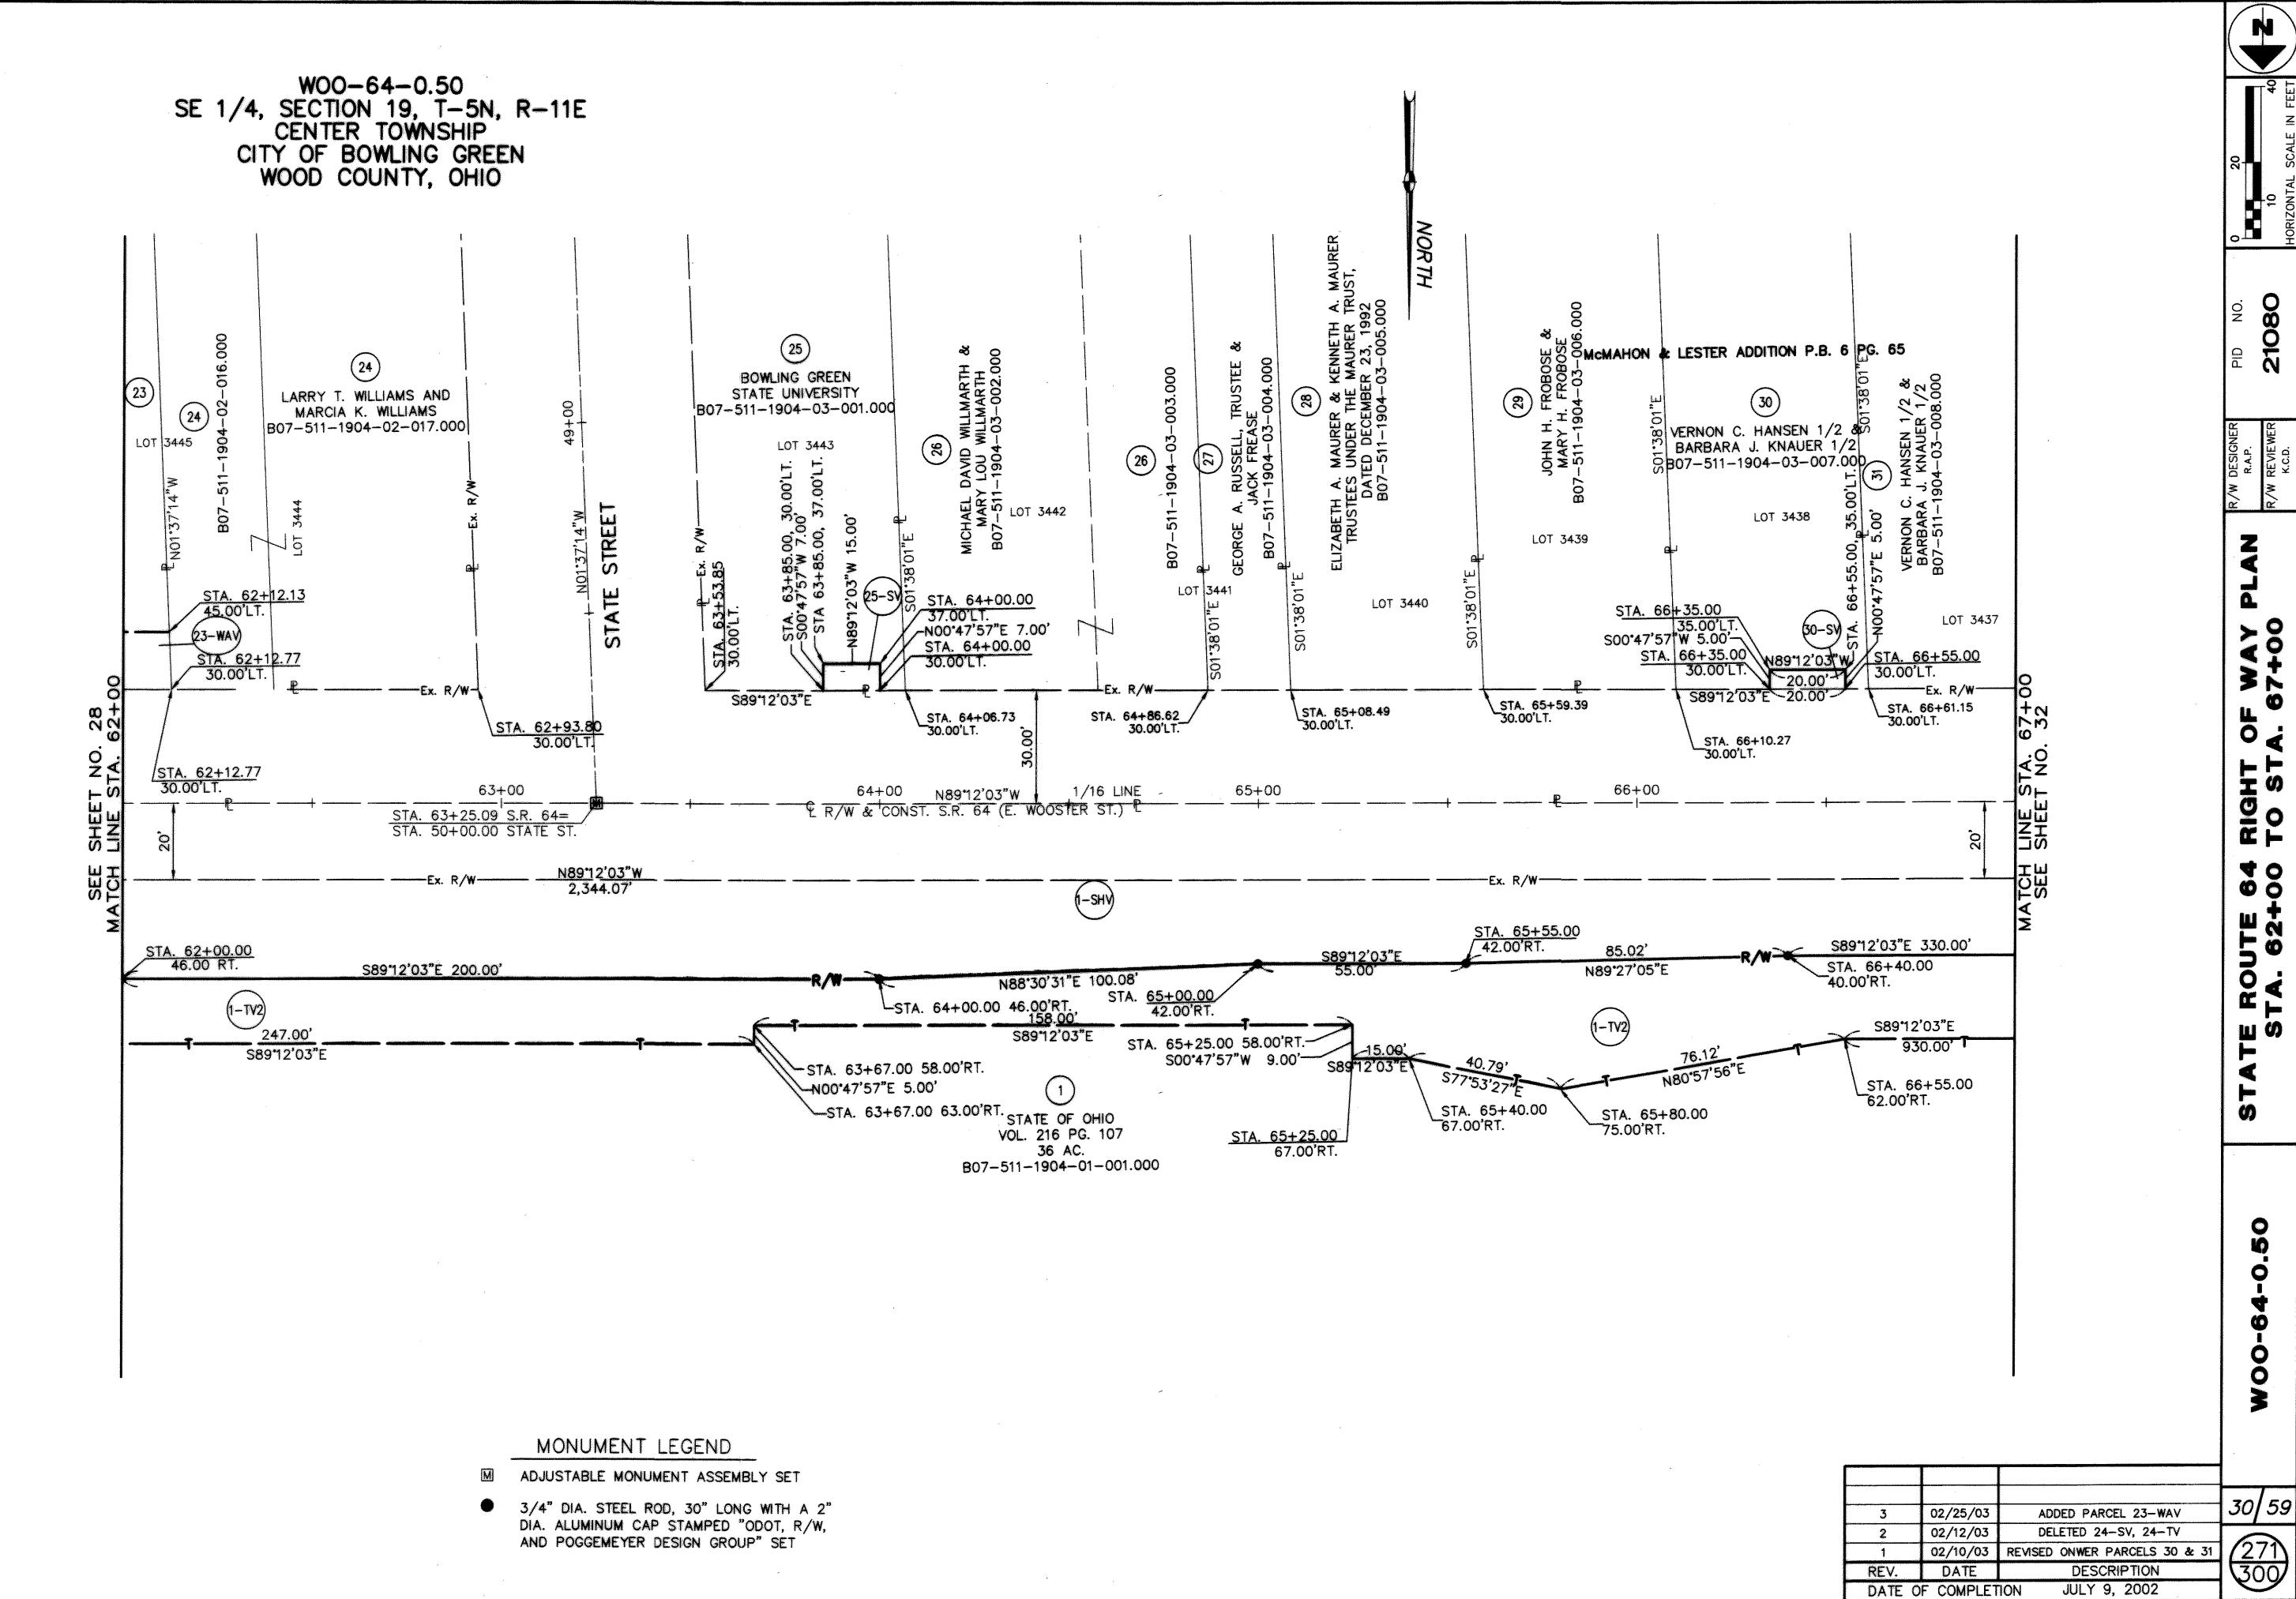

1073-011 WOO-64-0.50

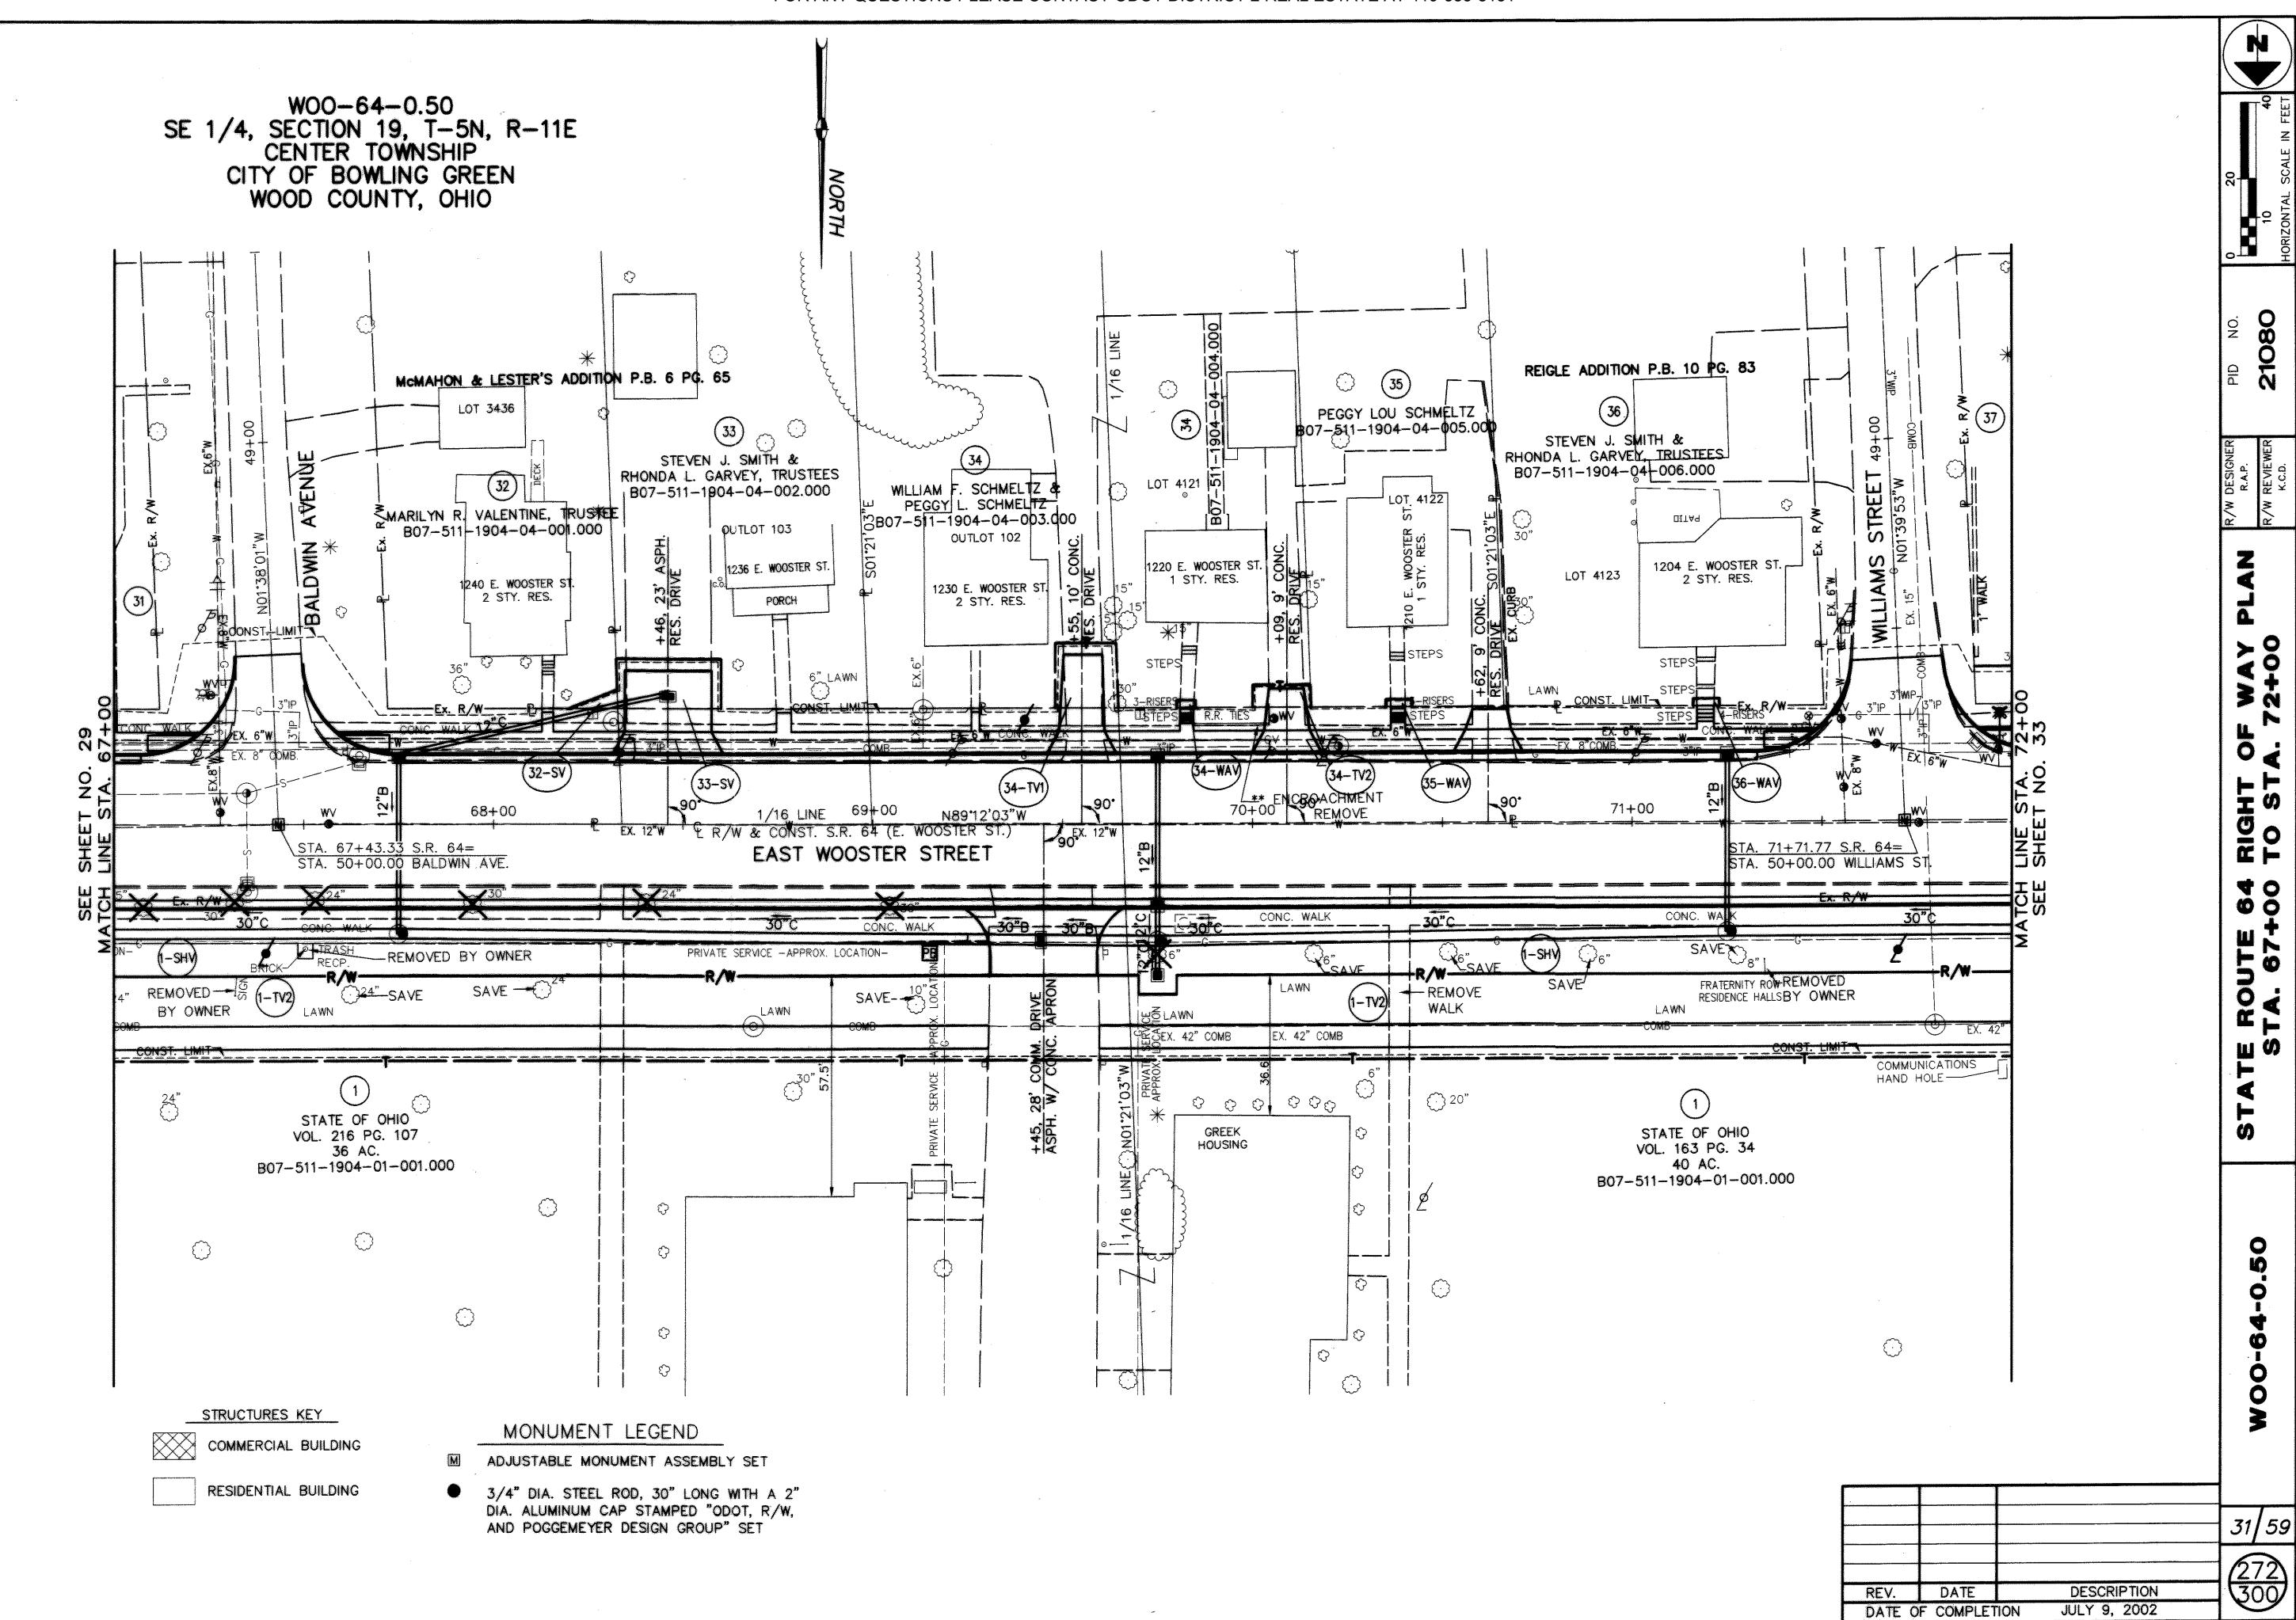


MARCH 4, 2003


PLOTTED: R.A.P.

1073-011 W00-64-0 50

.

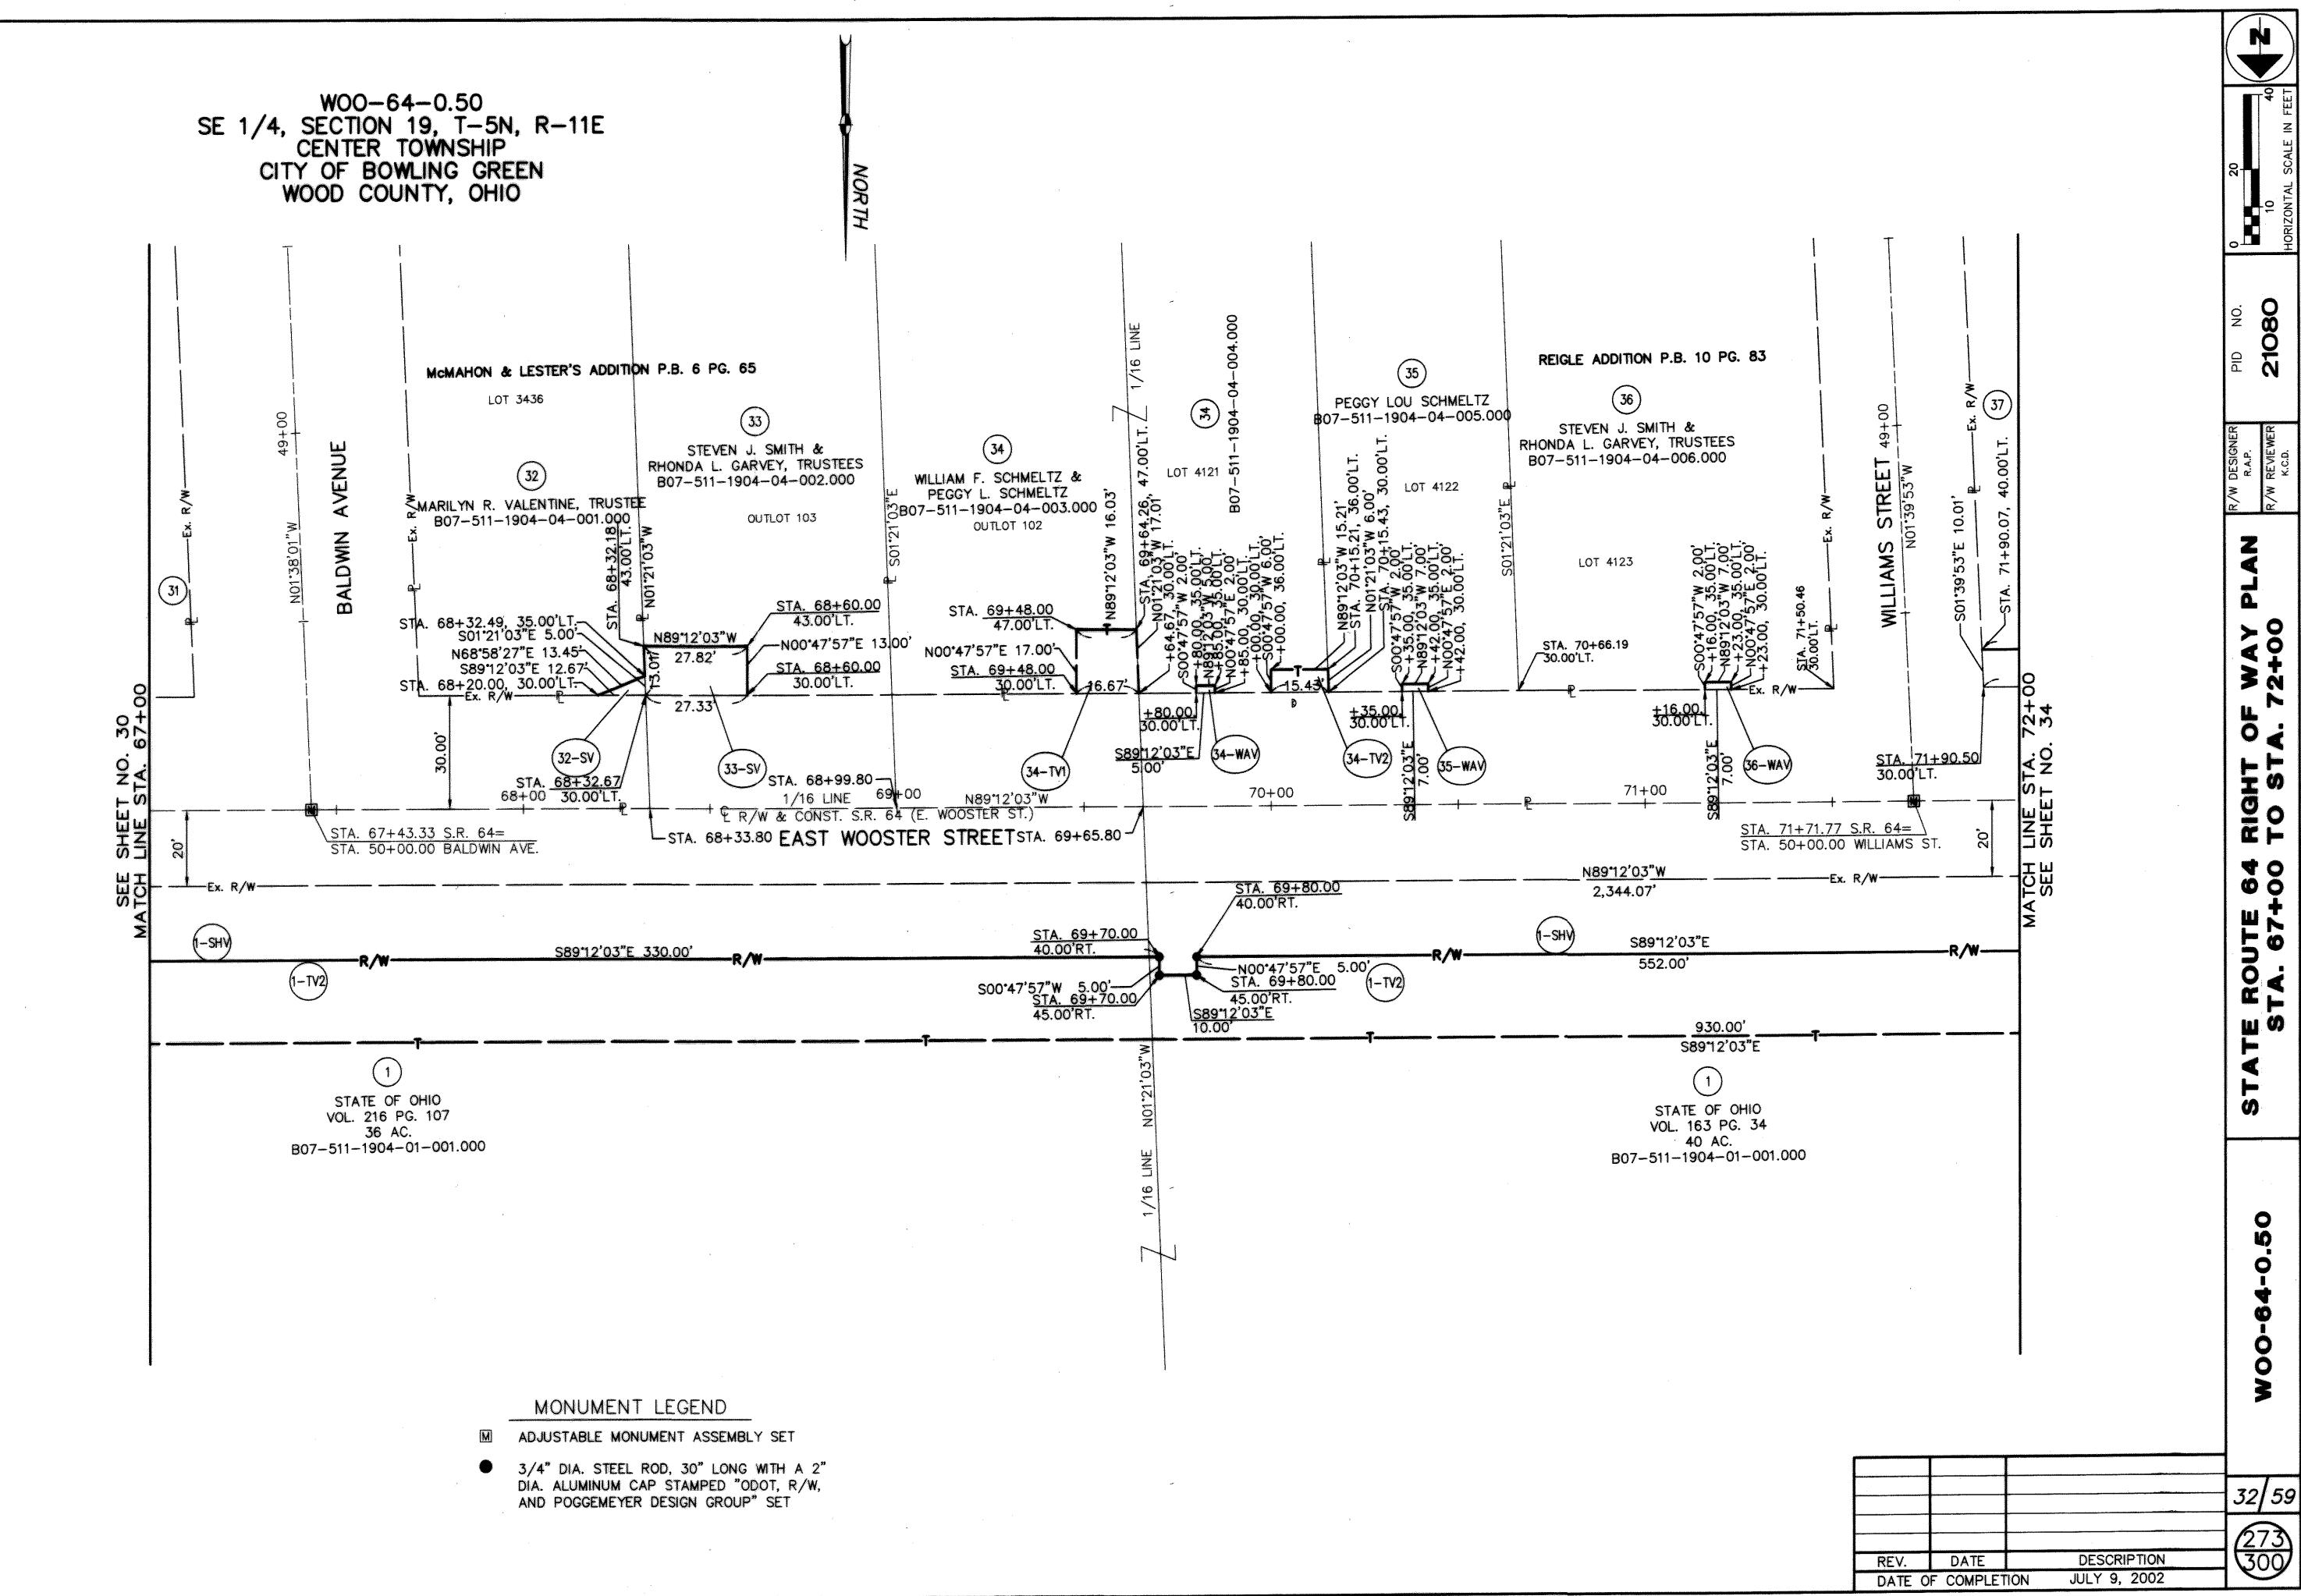


TED: MARCH 4, 2003

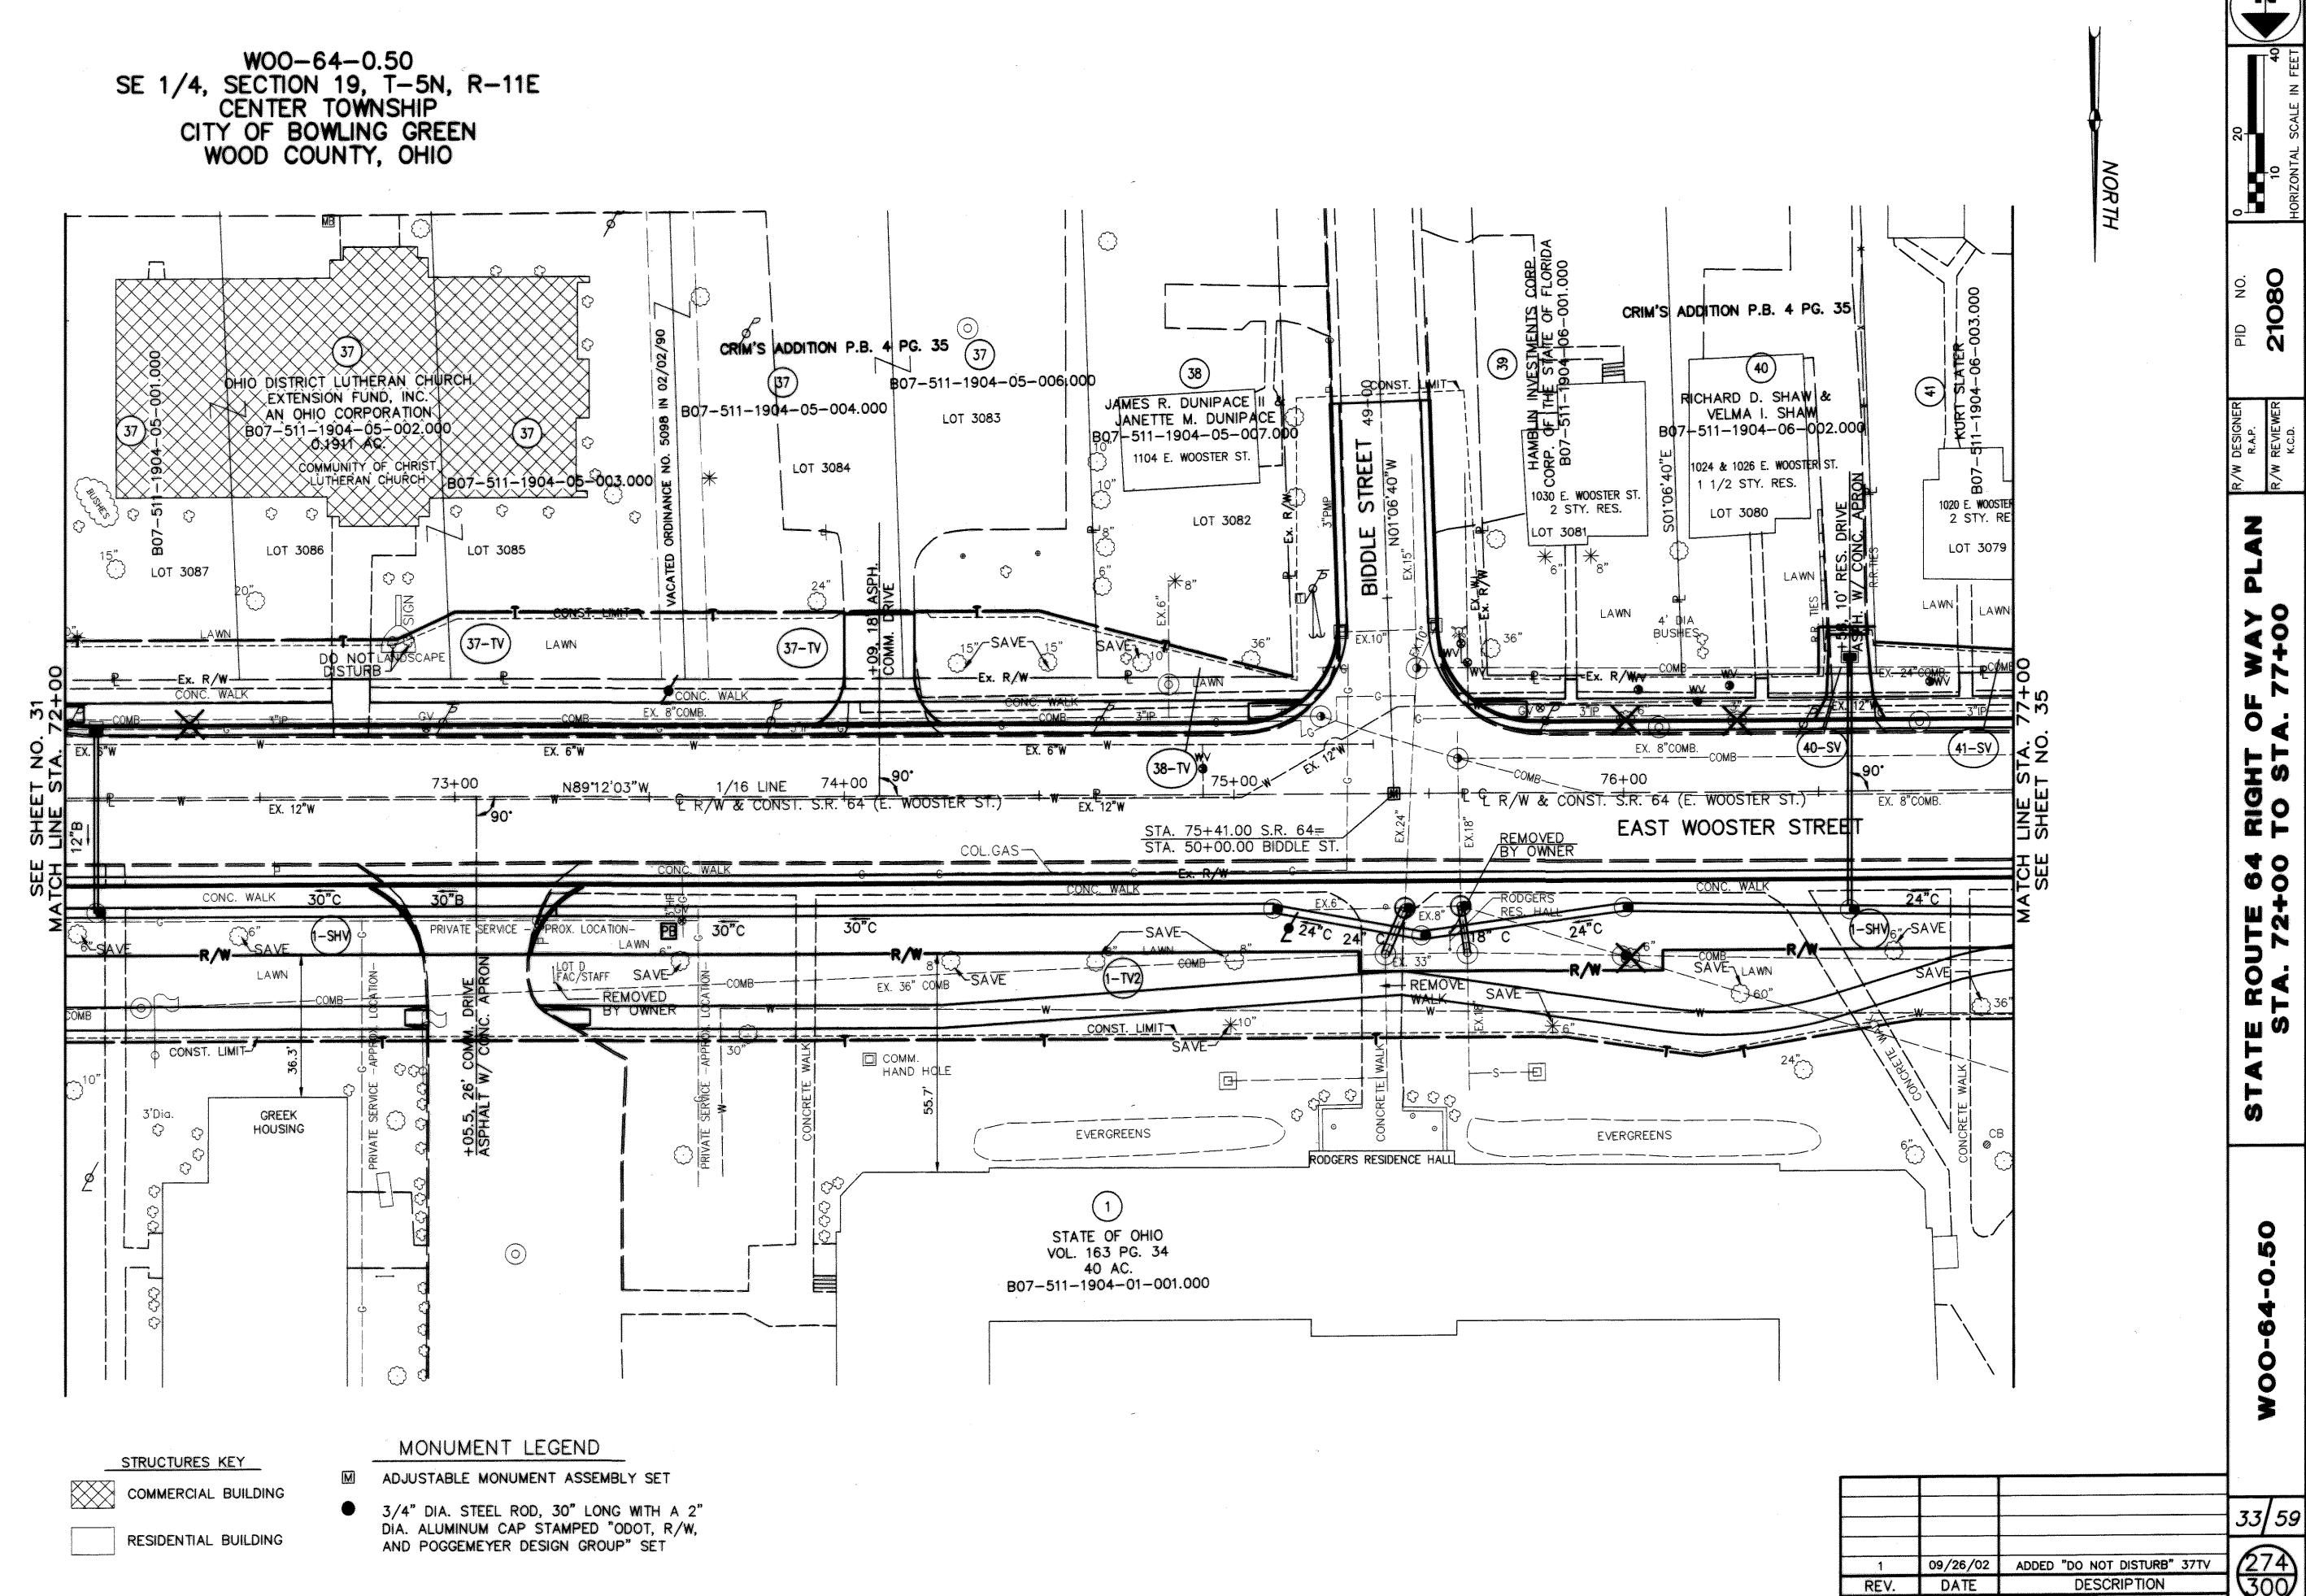

7

1073\_011 W00\_64\_0 50

DATE OF COMPLETION JULY 9, 2002

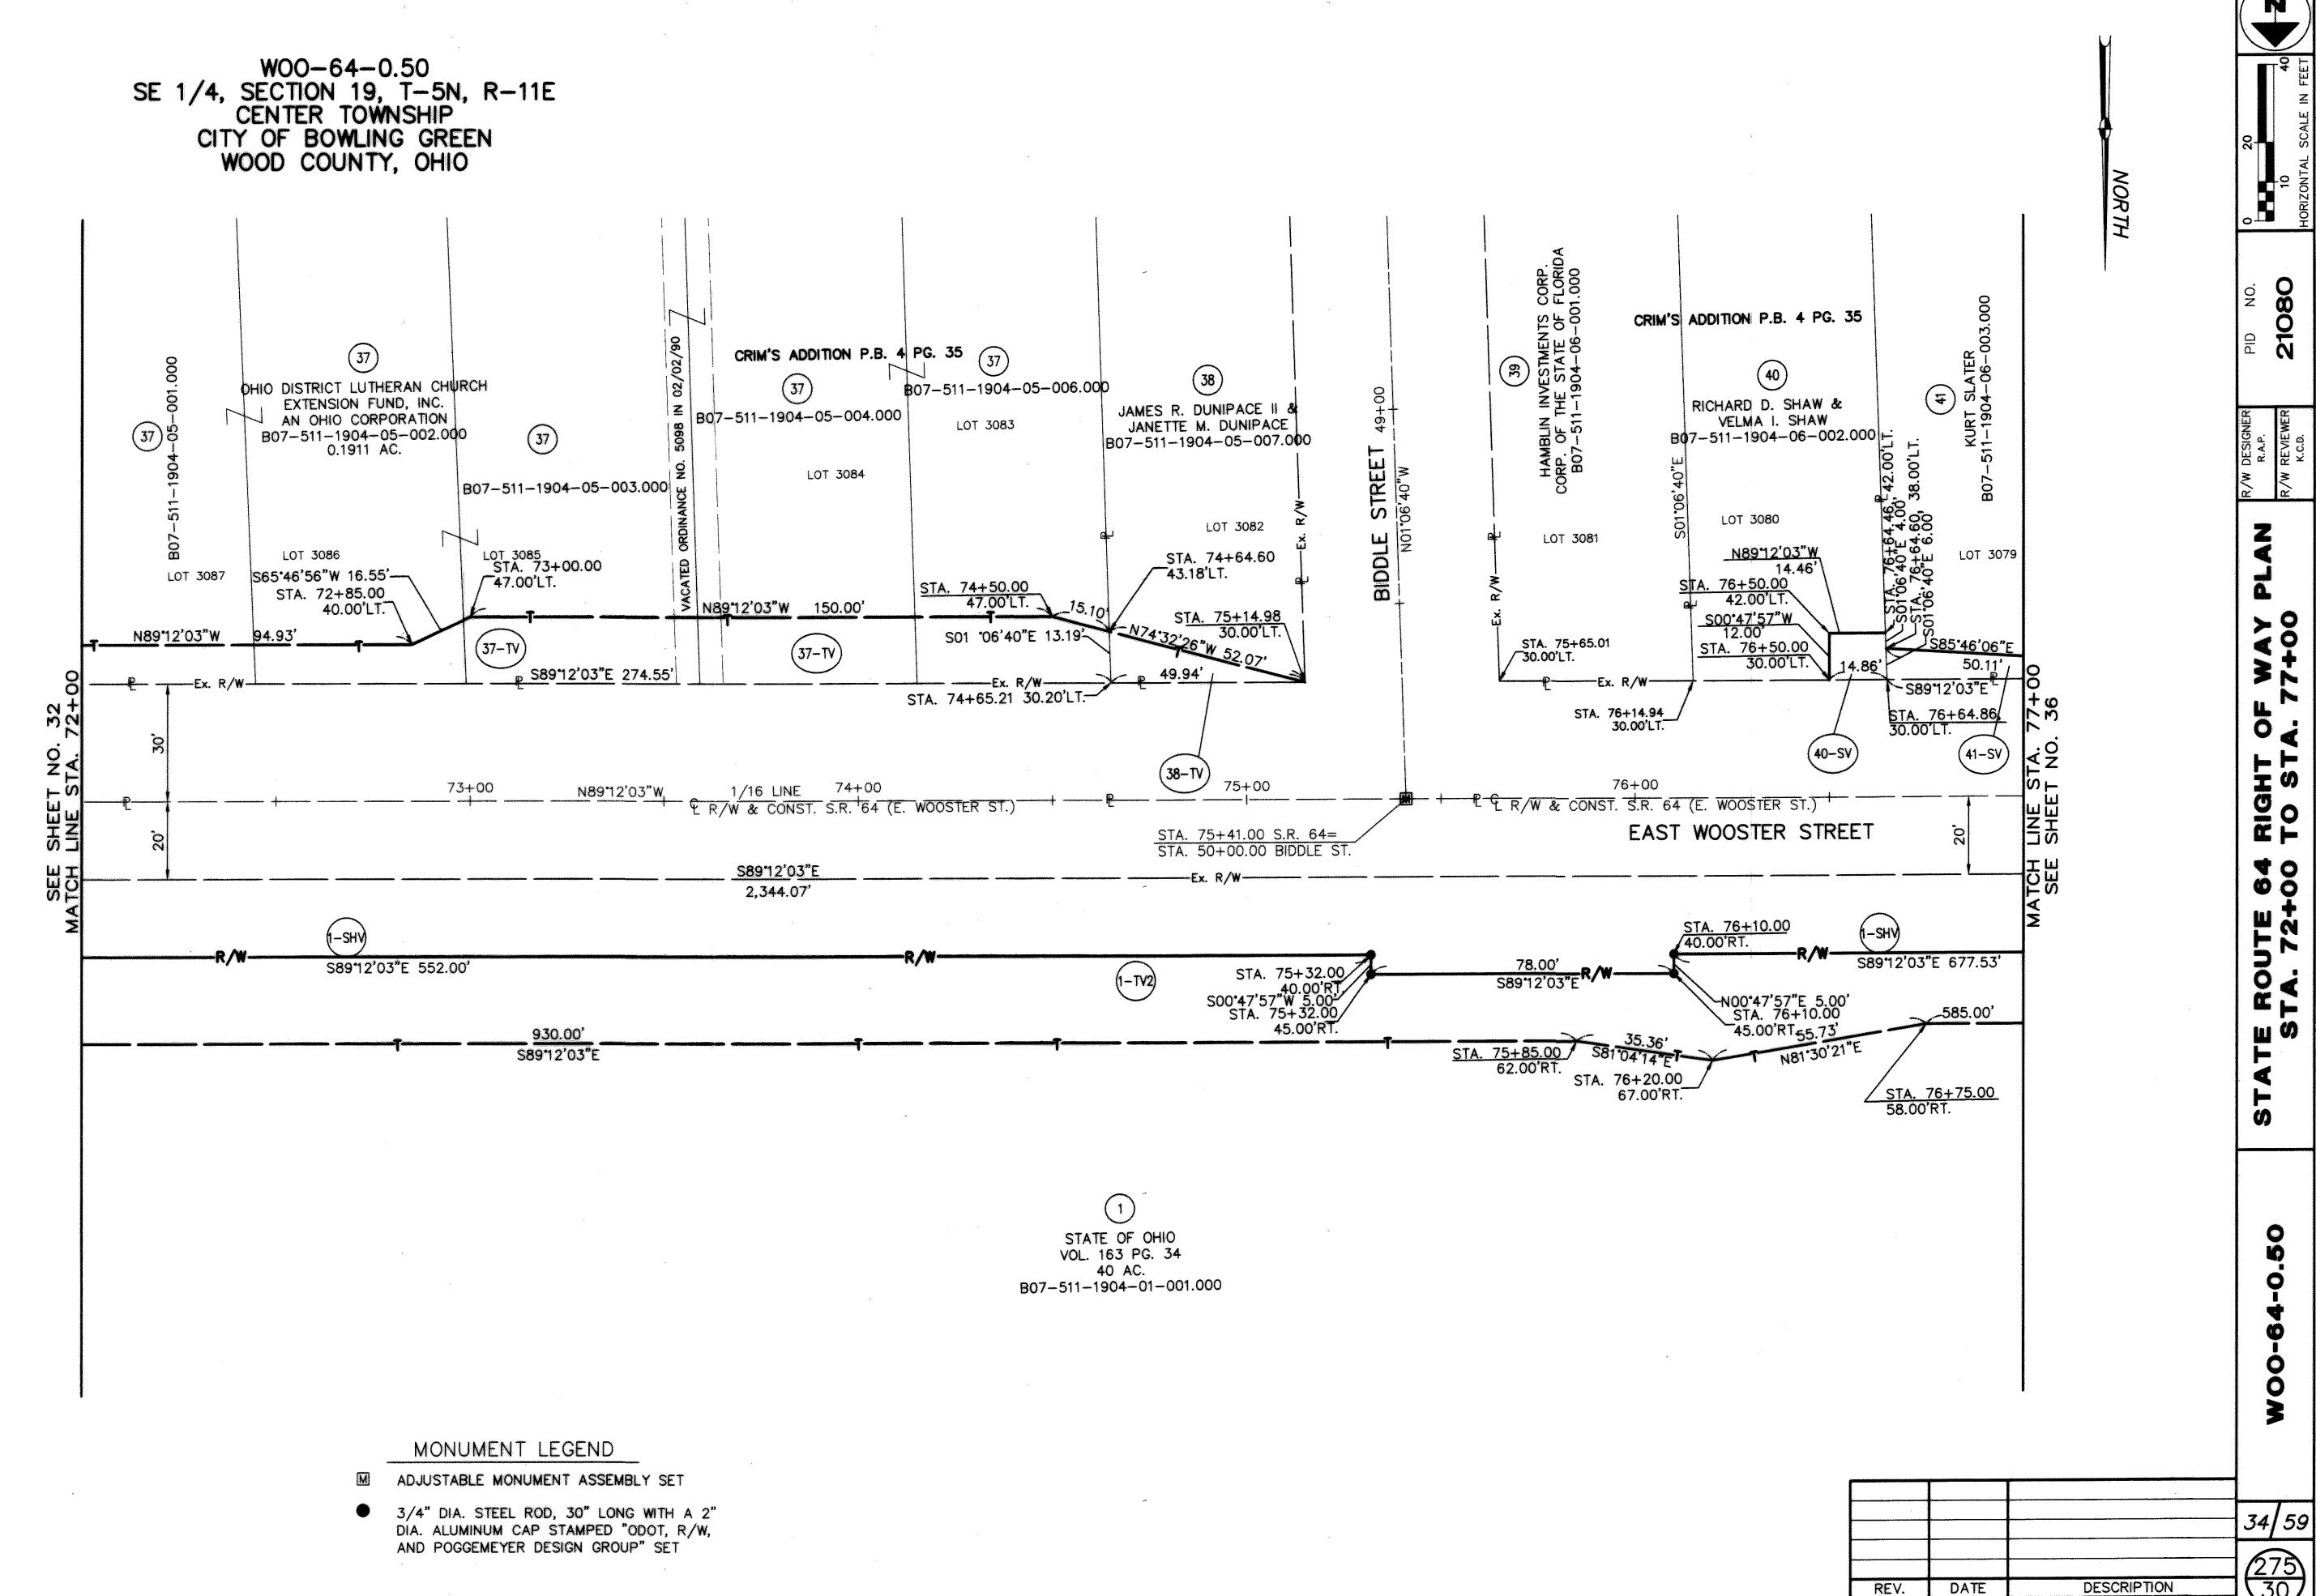


1073-011 W00-64-0 50


275 30


JULY 9, 2002


DATE OF COMPLETION

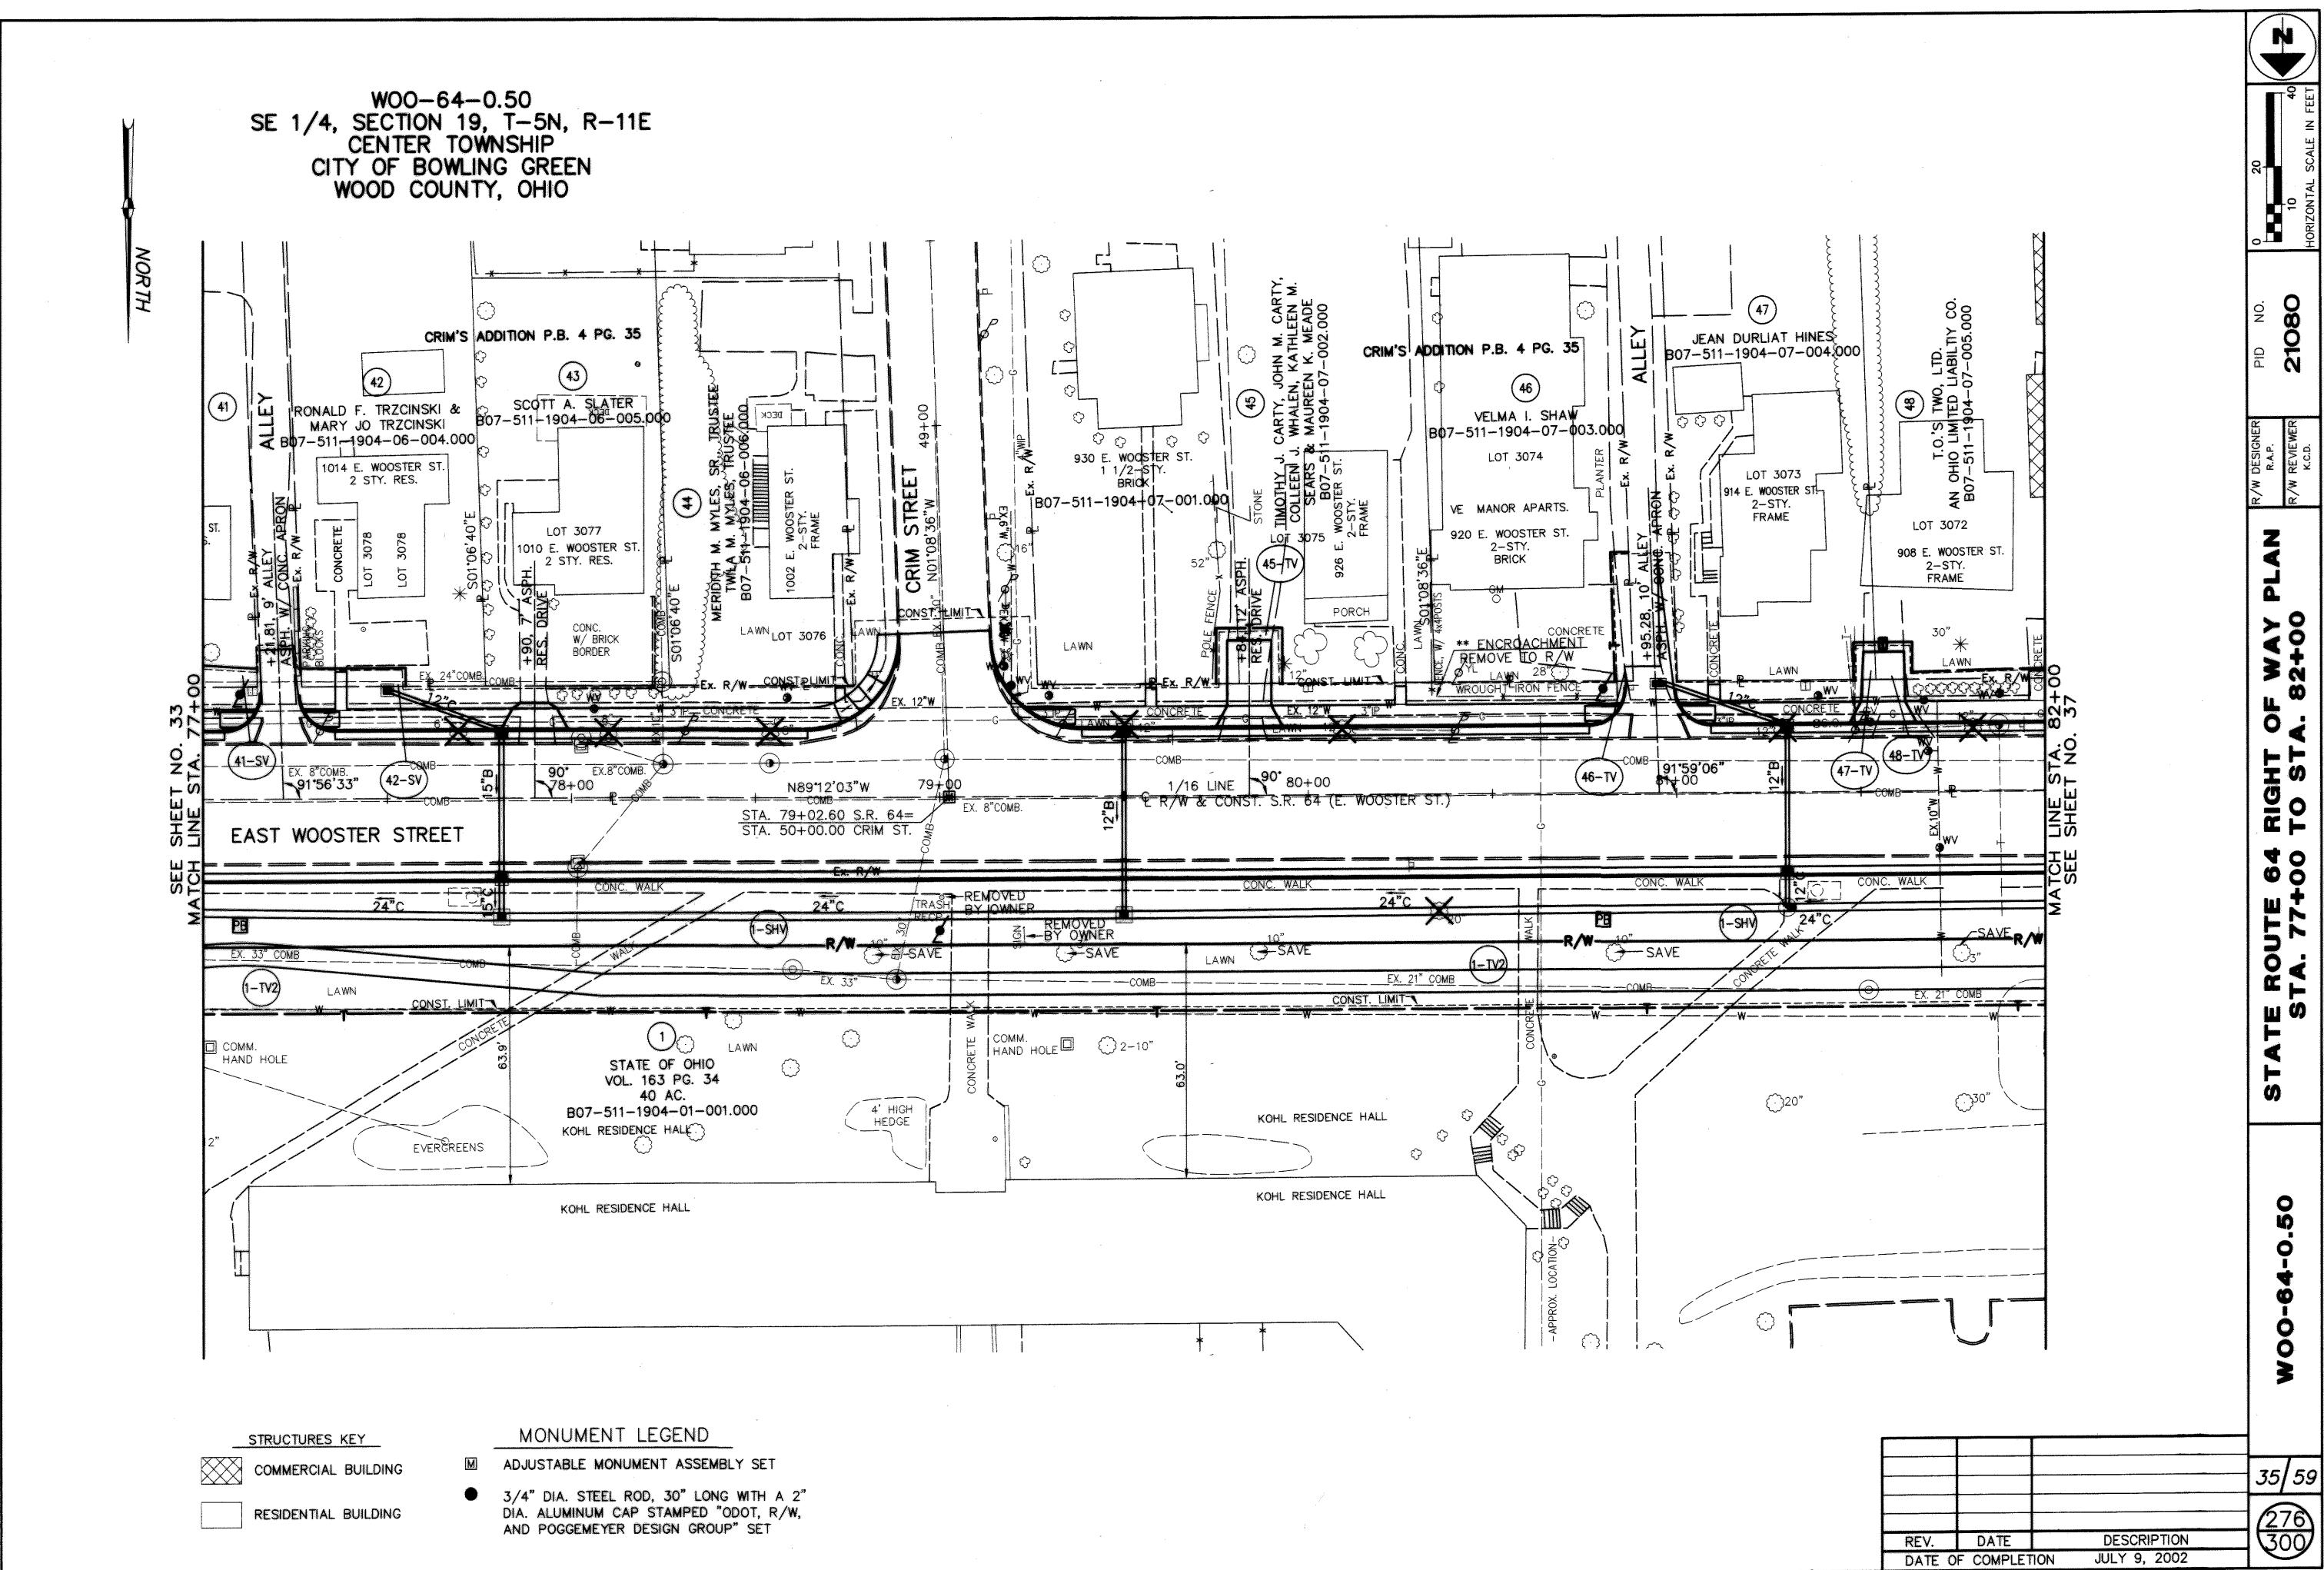


1077 011 WOO 64 0 50

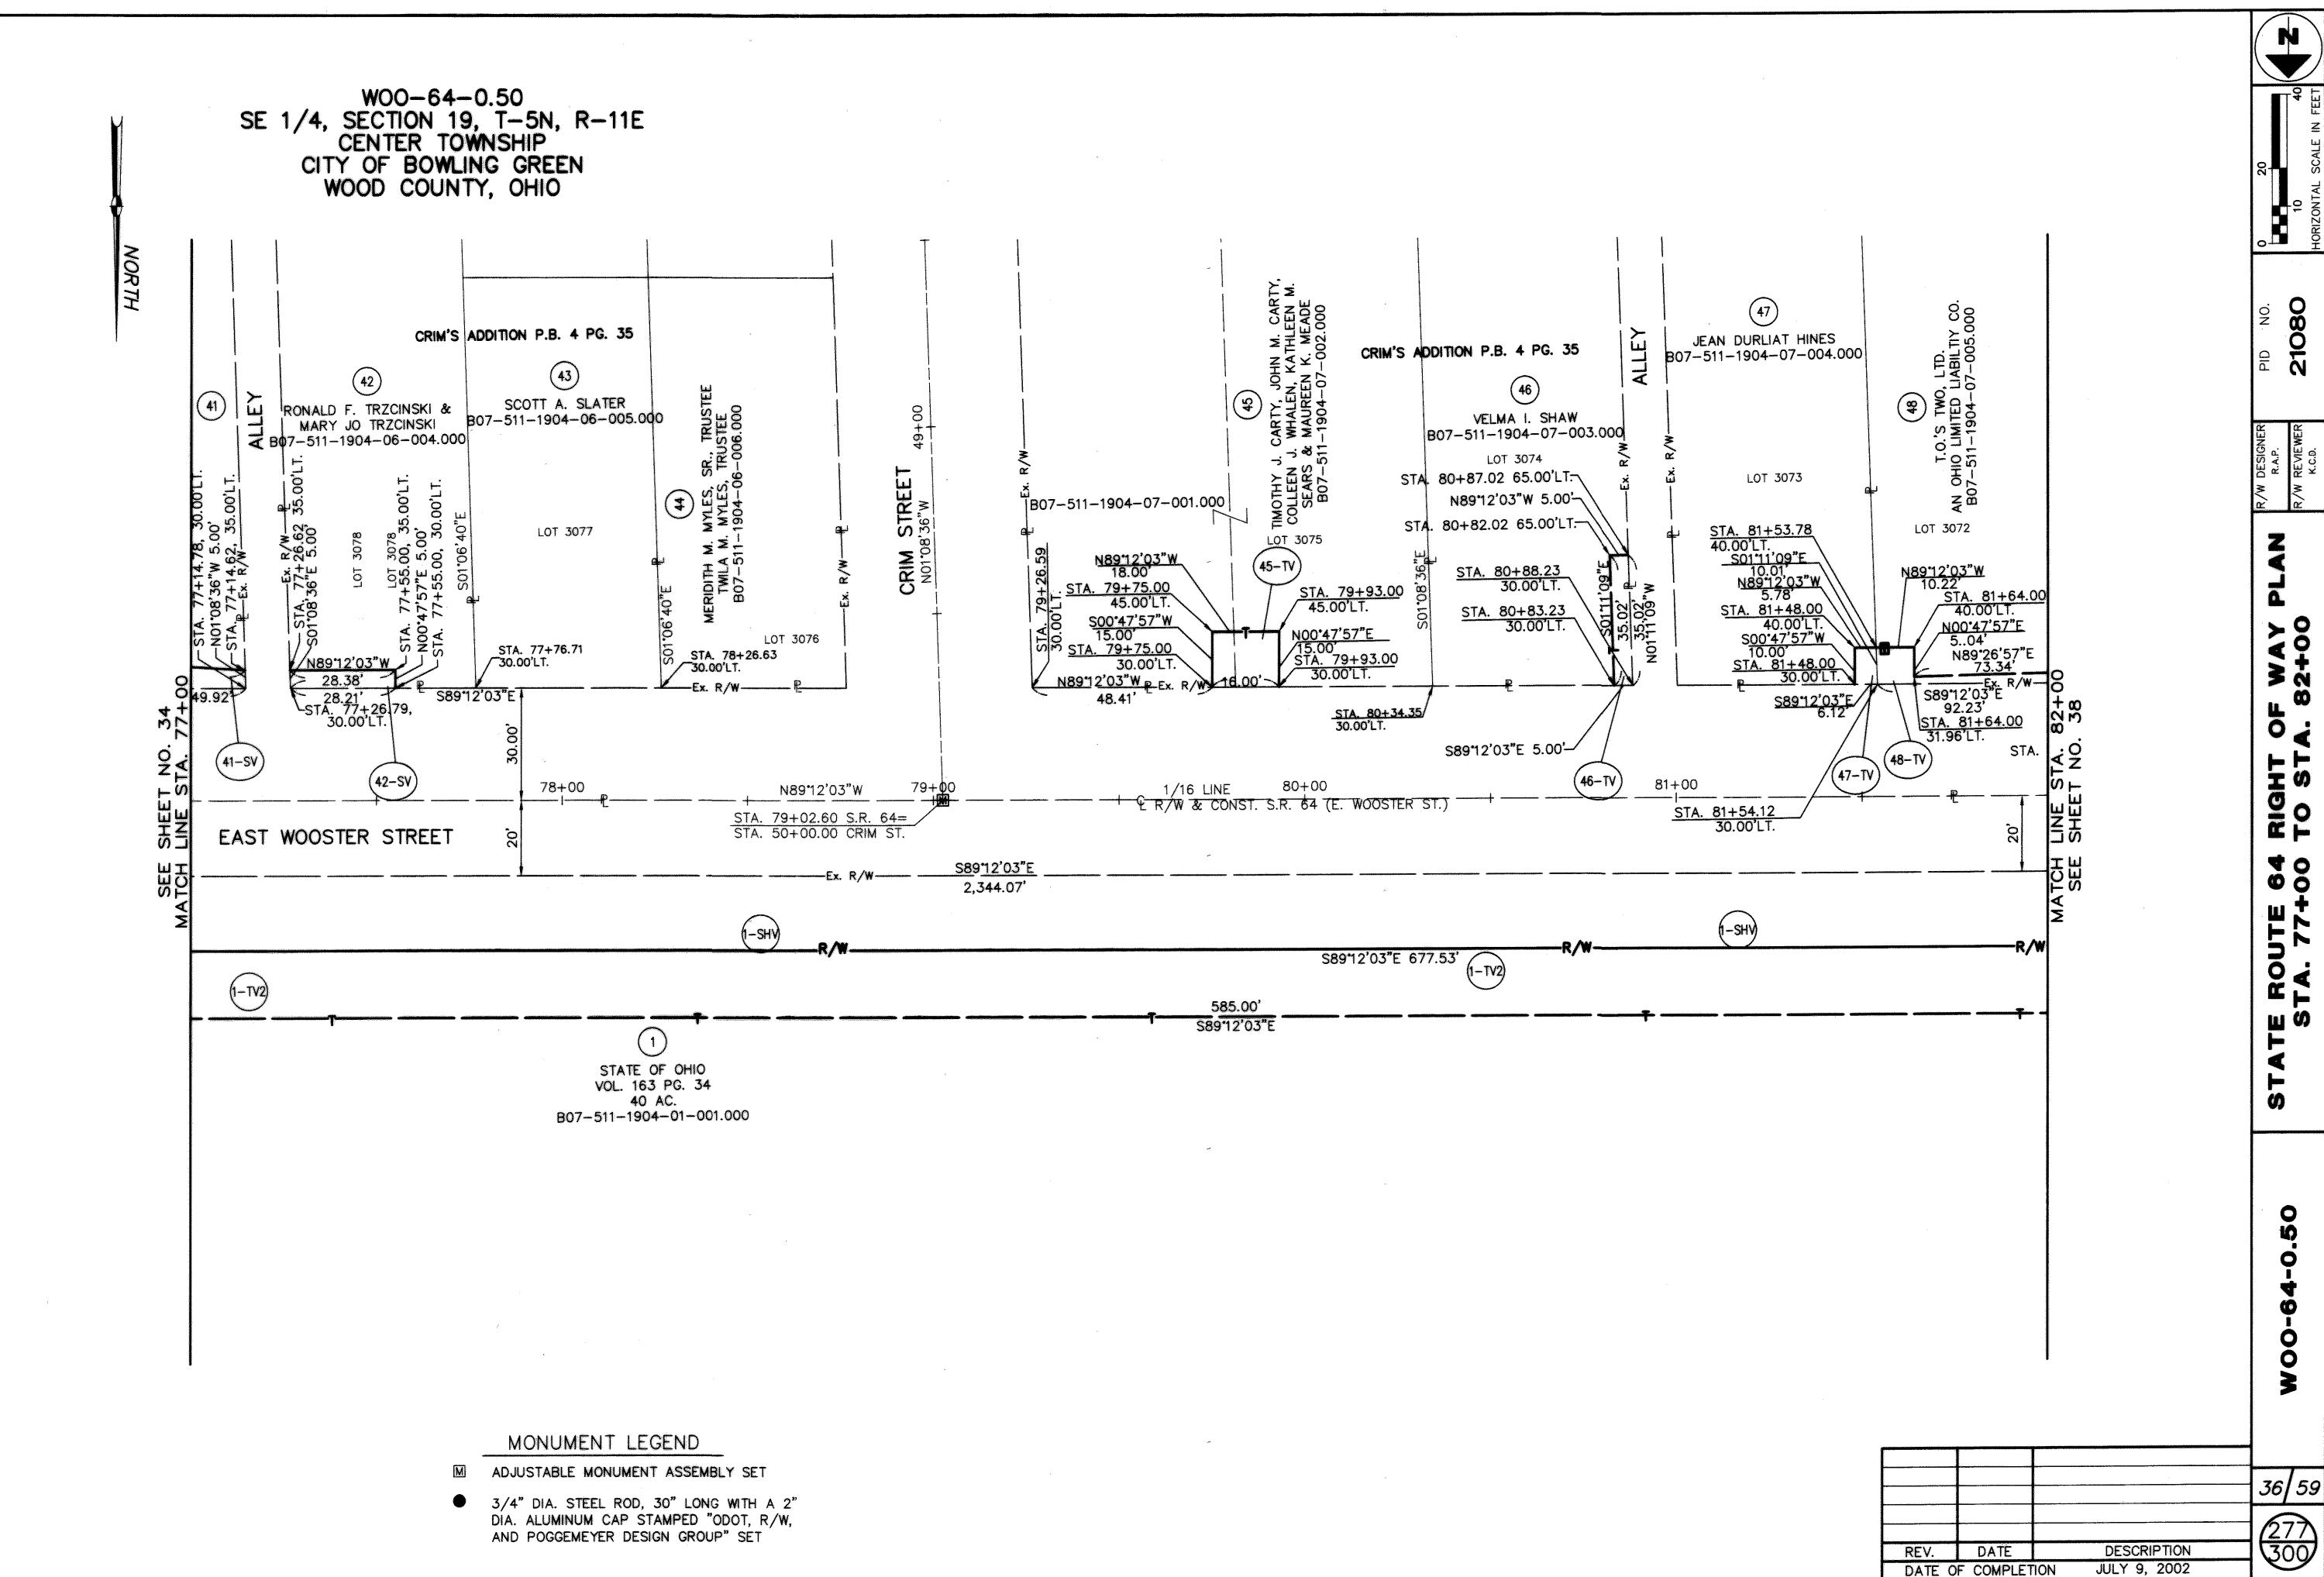

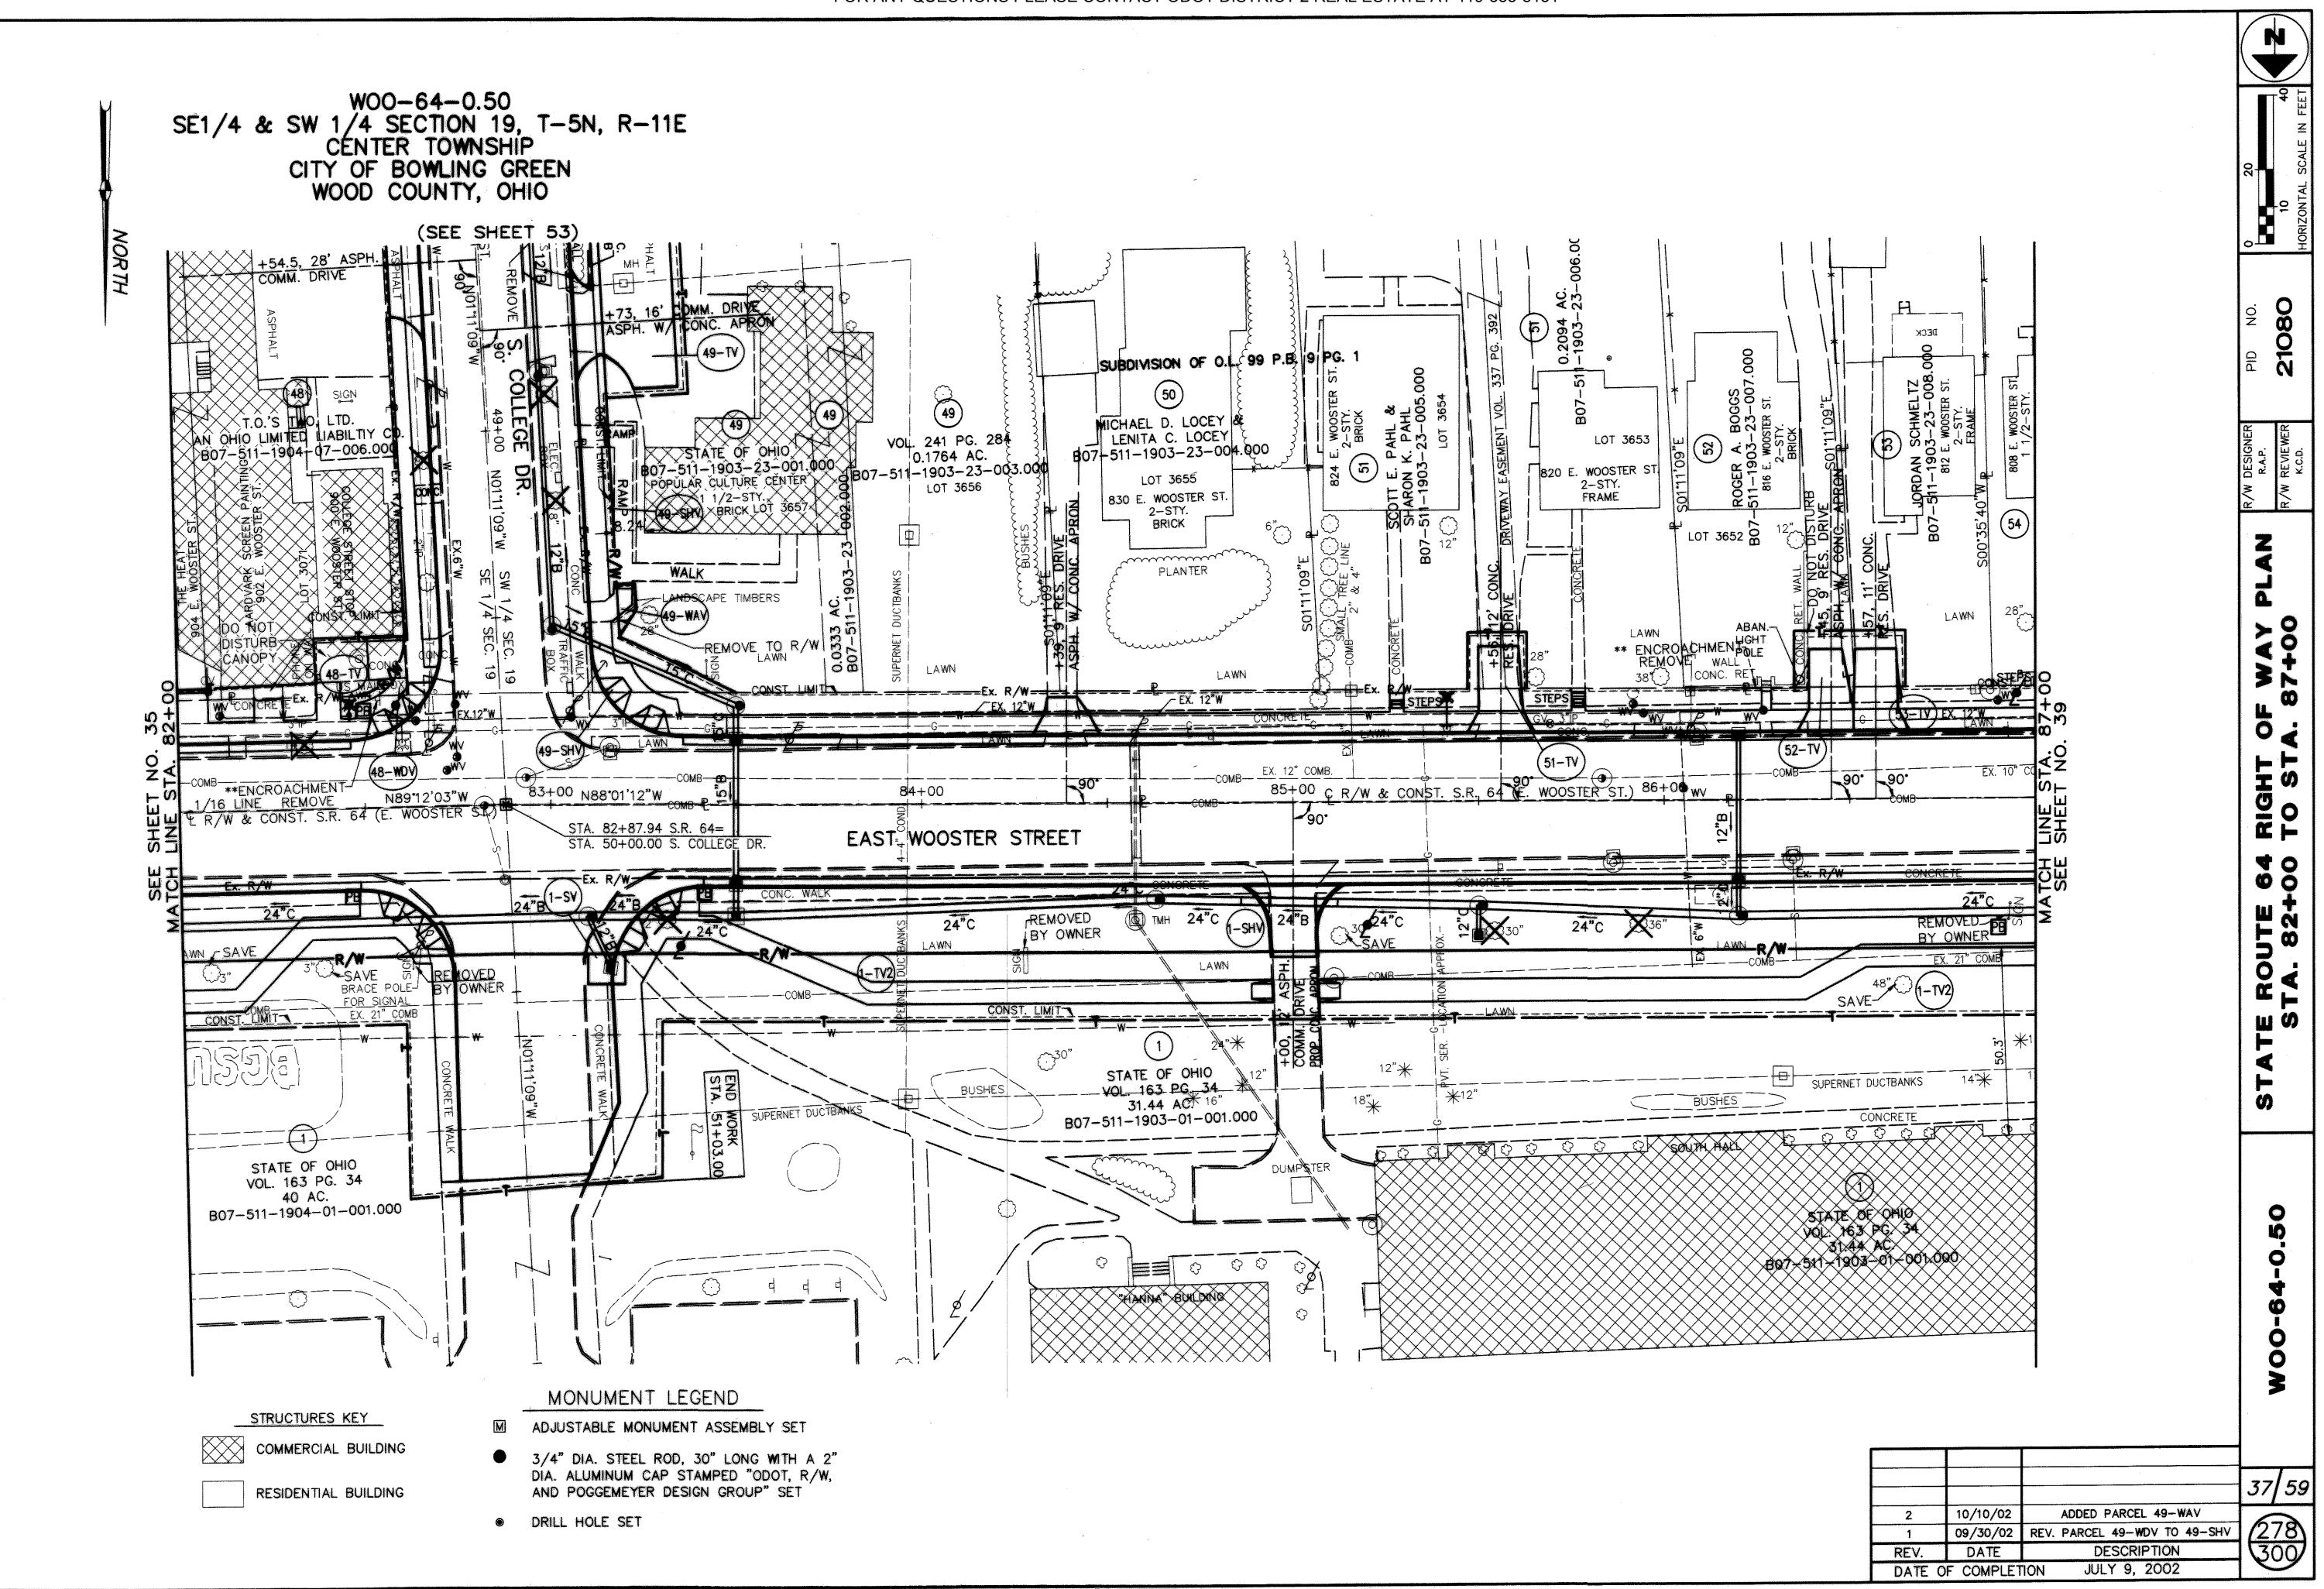


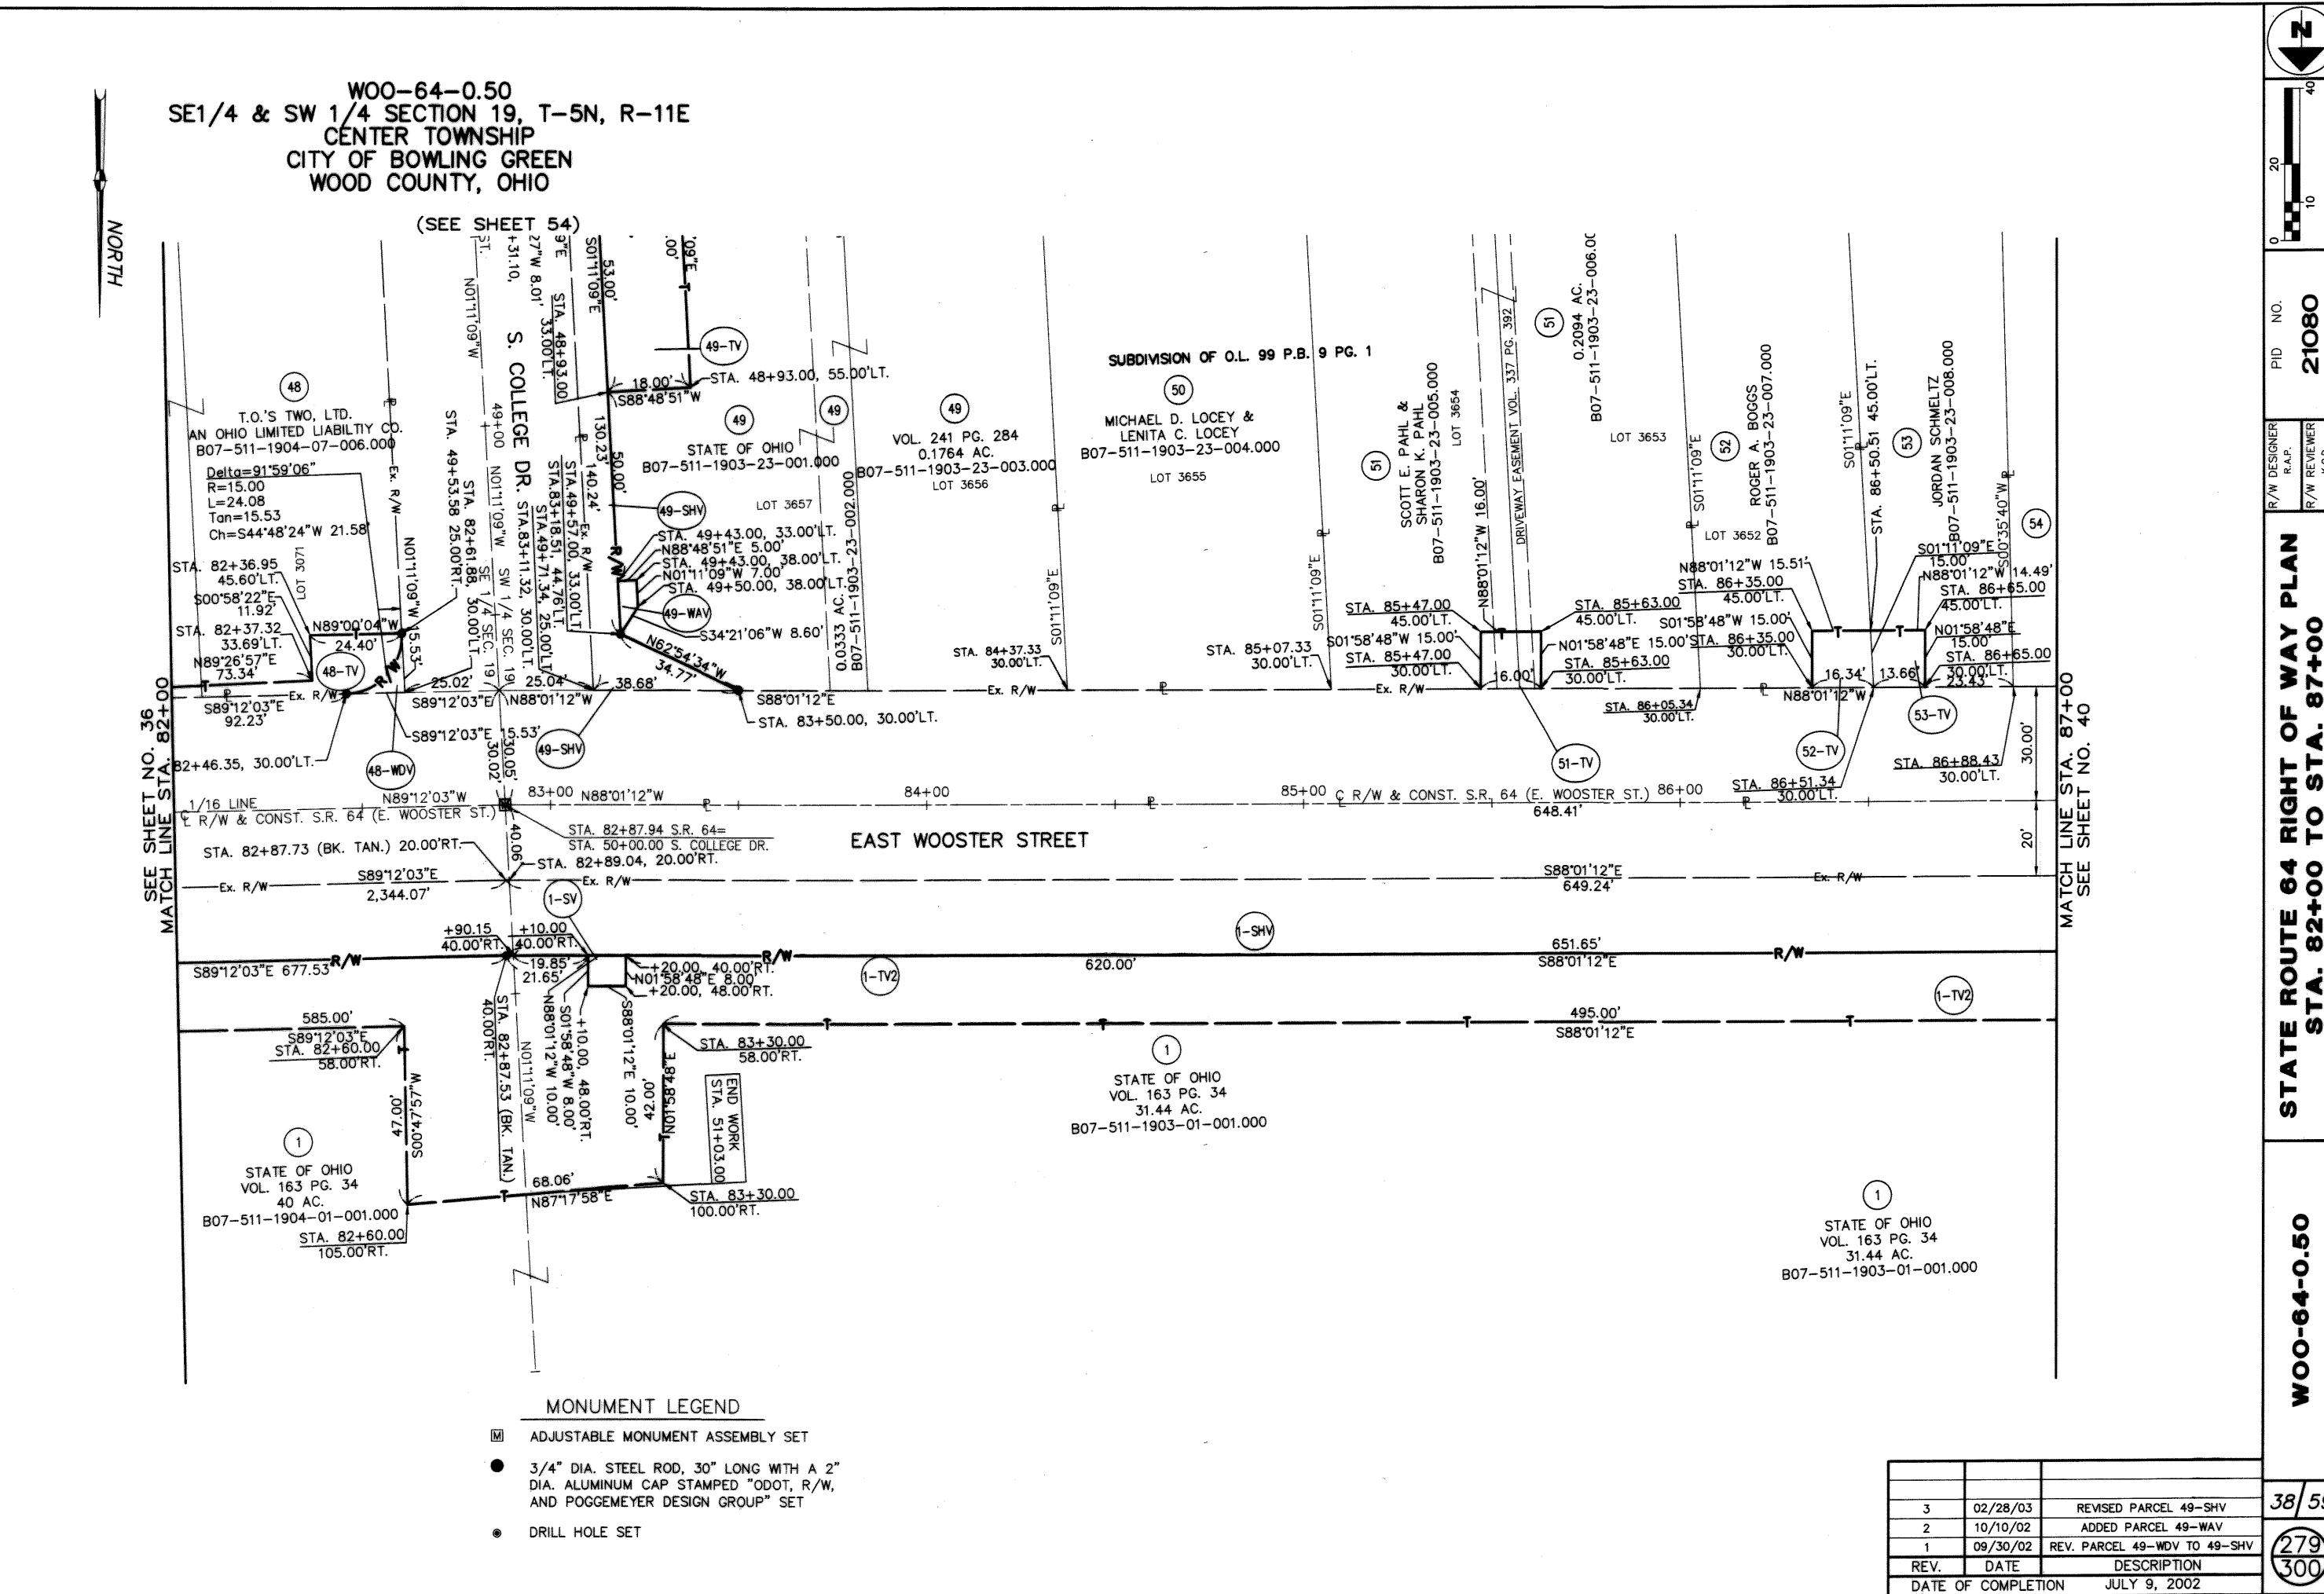


300

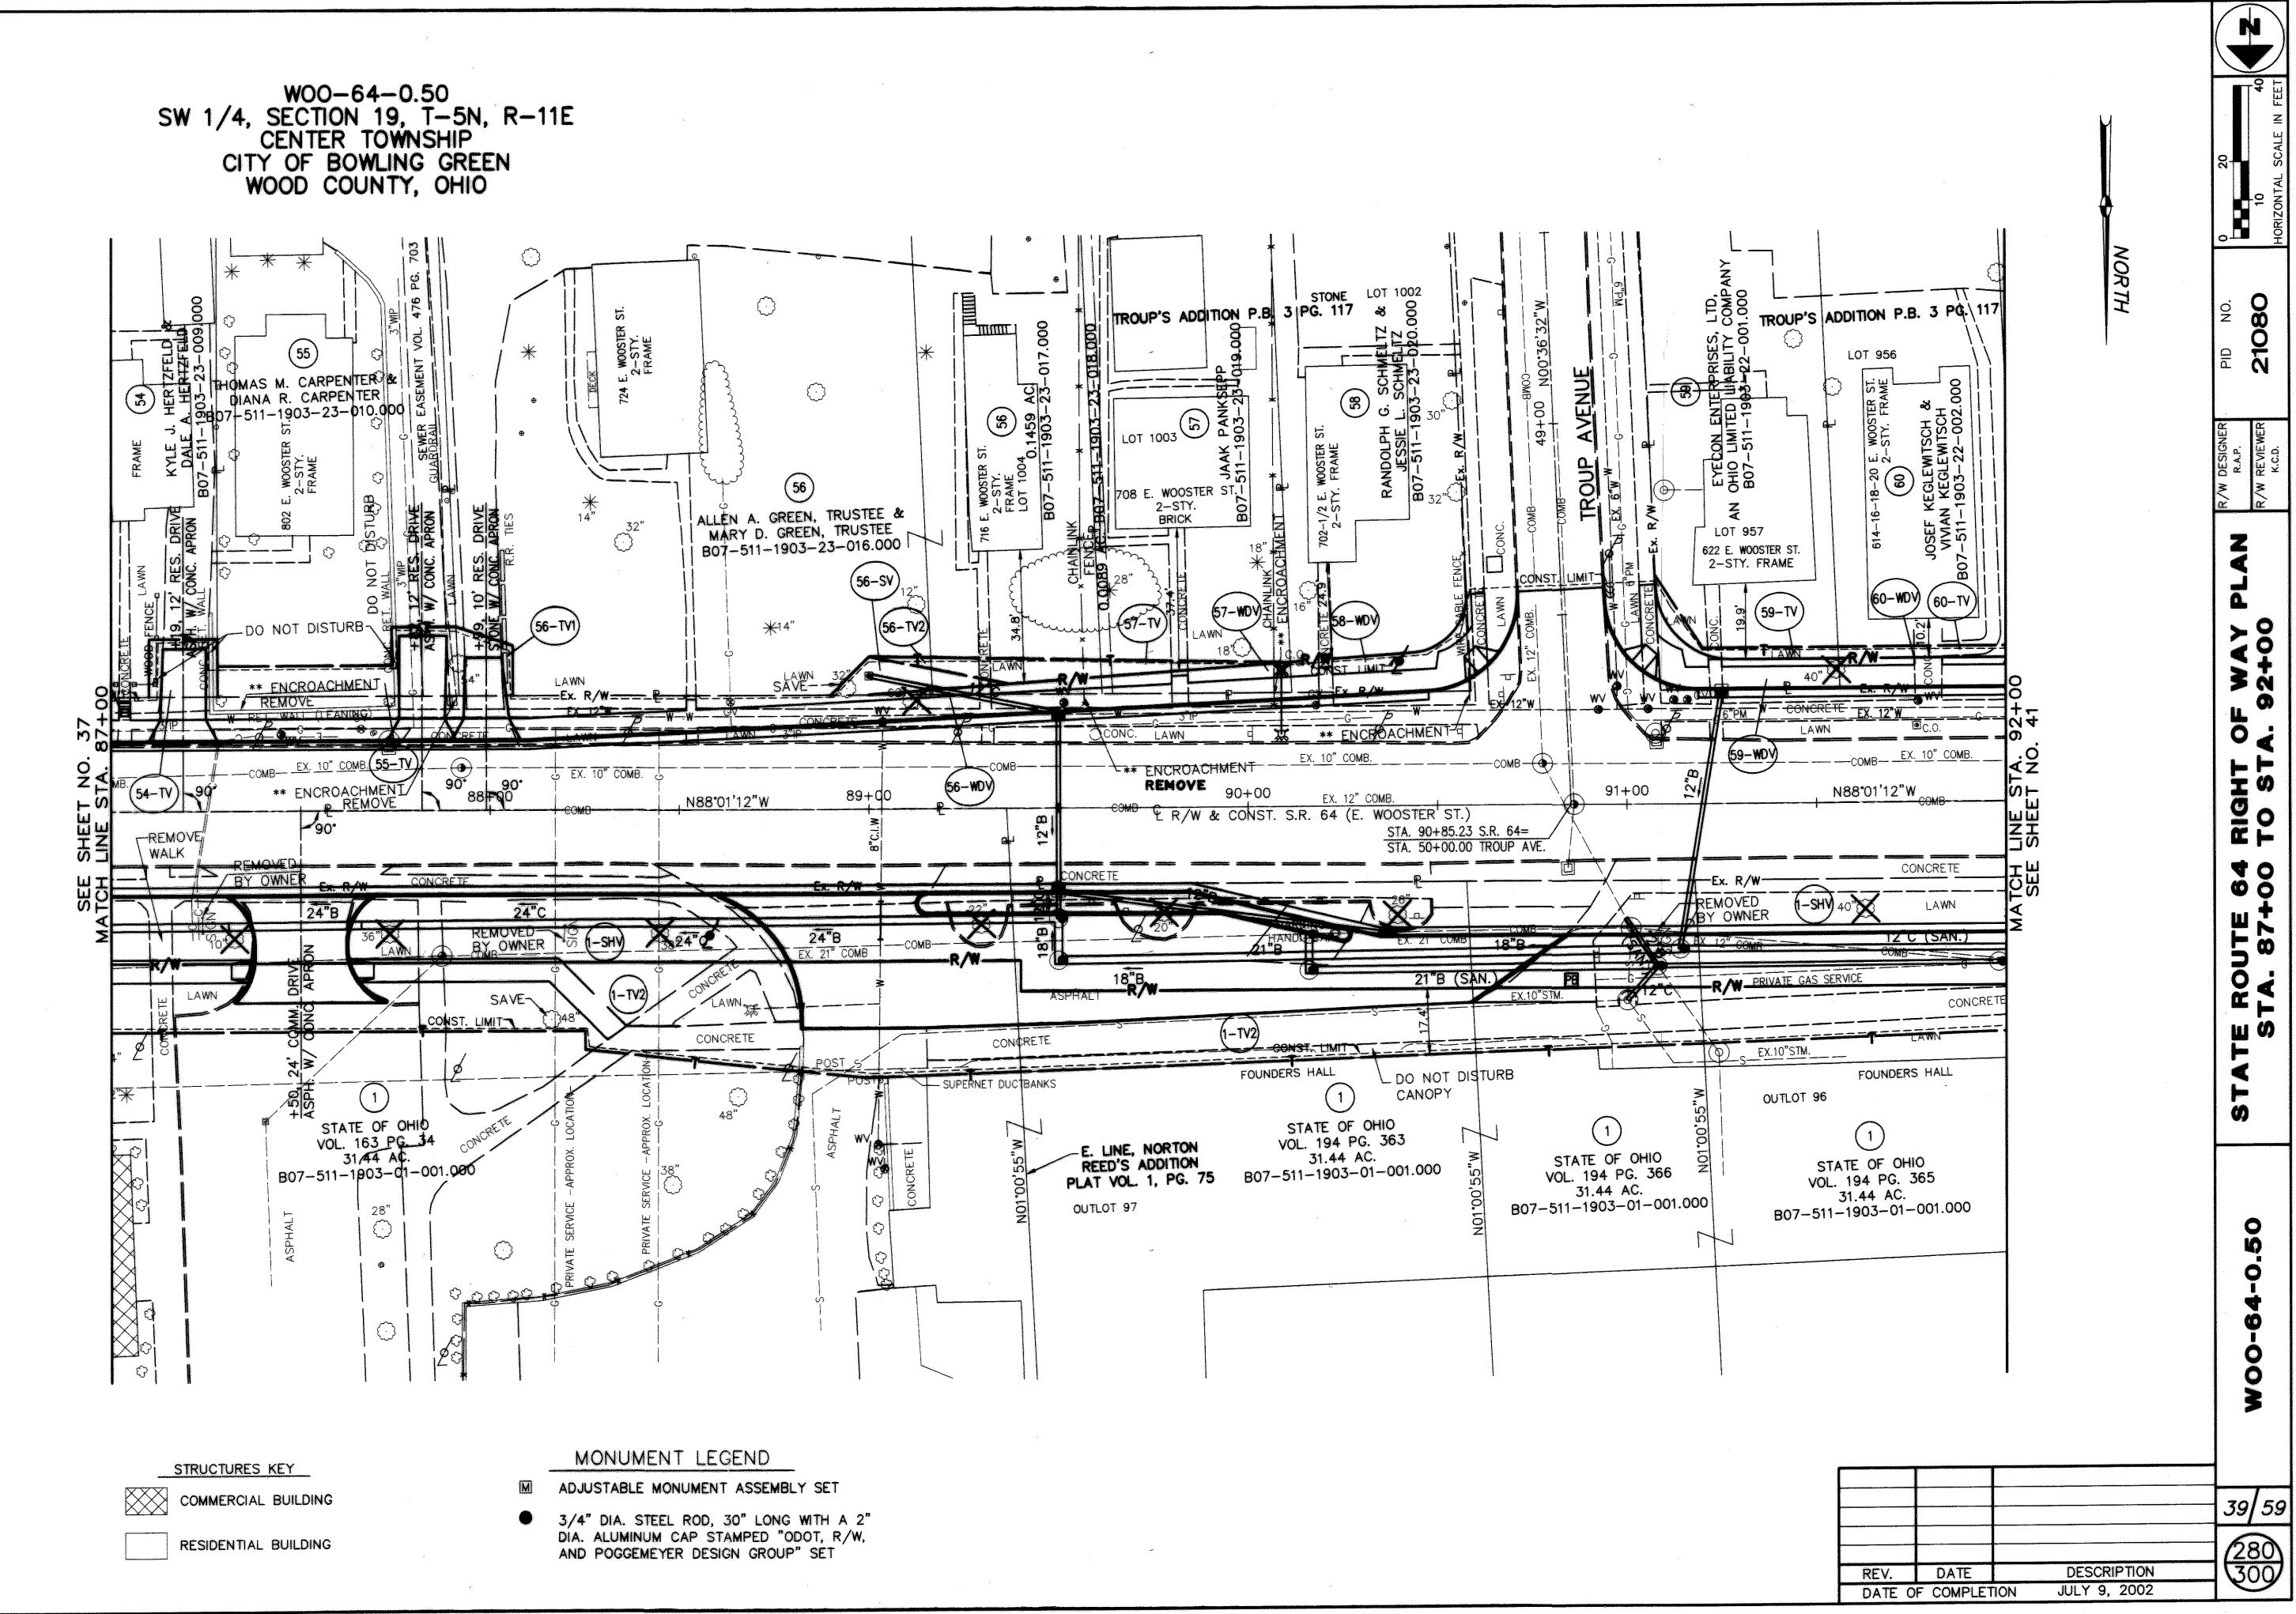

LOTTED: MAR

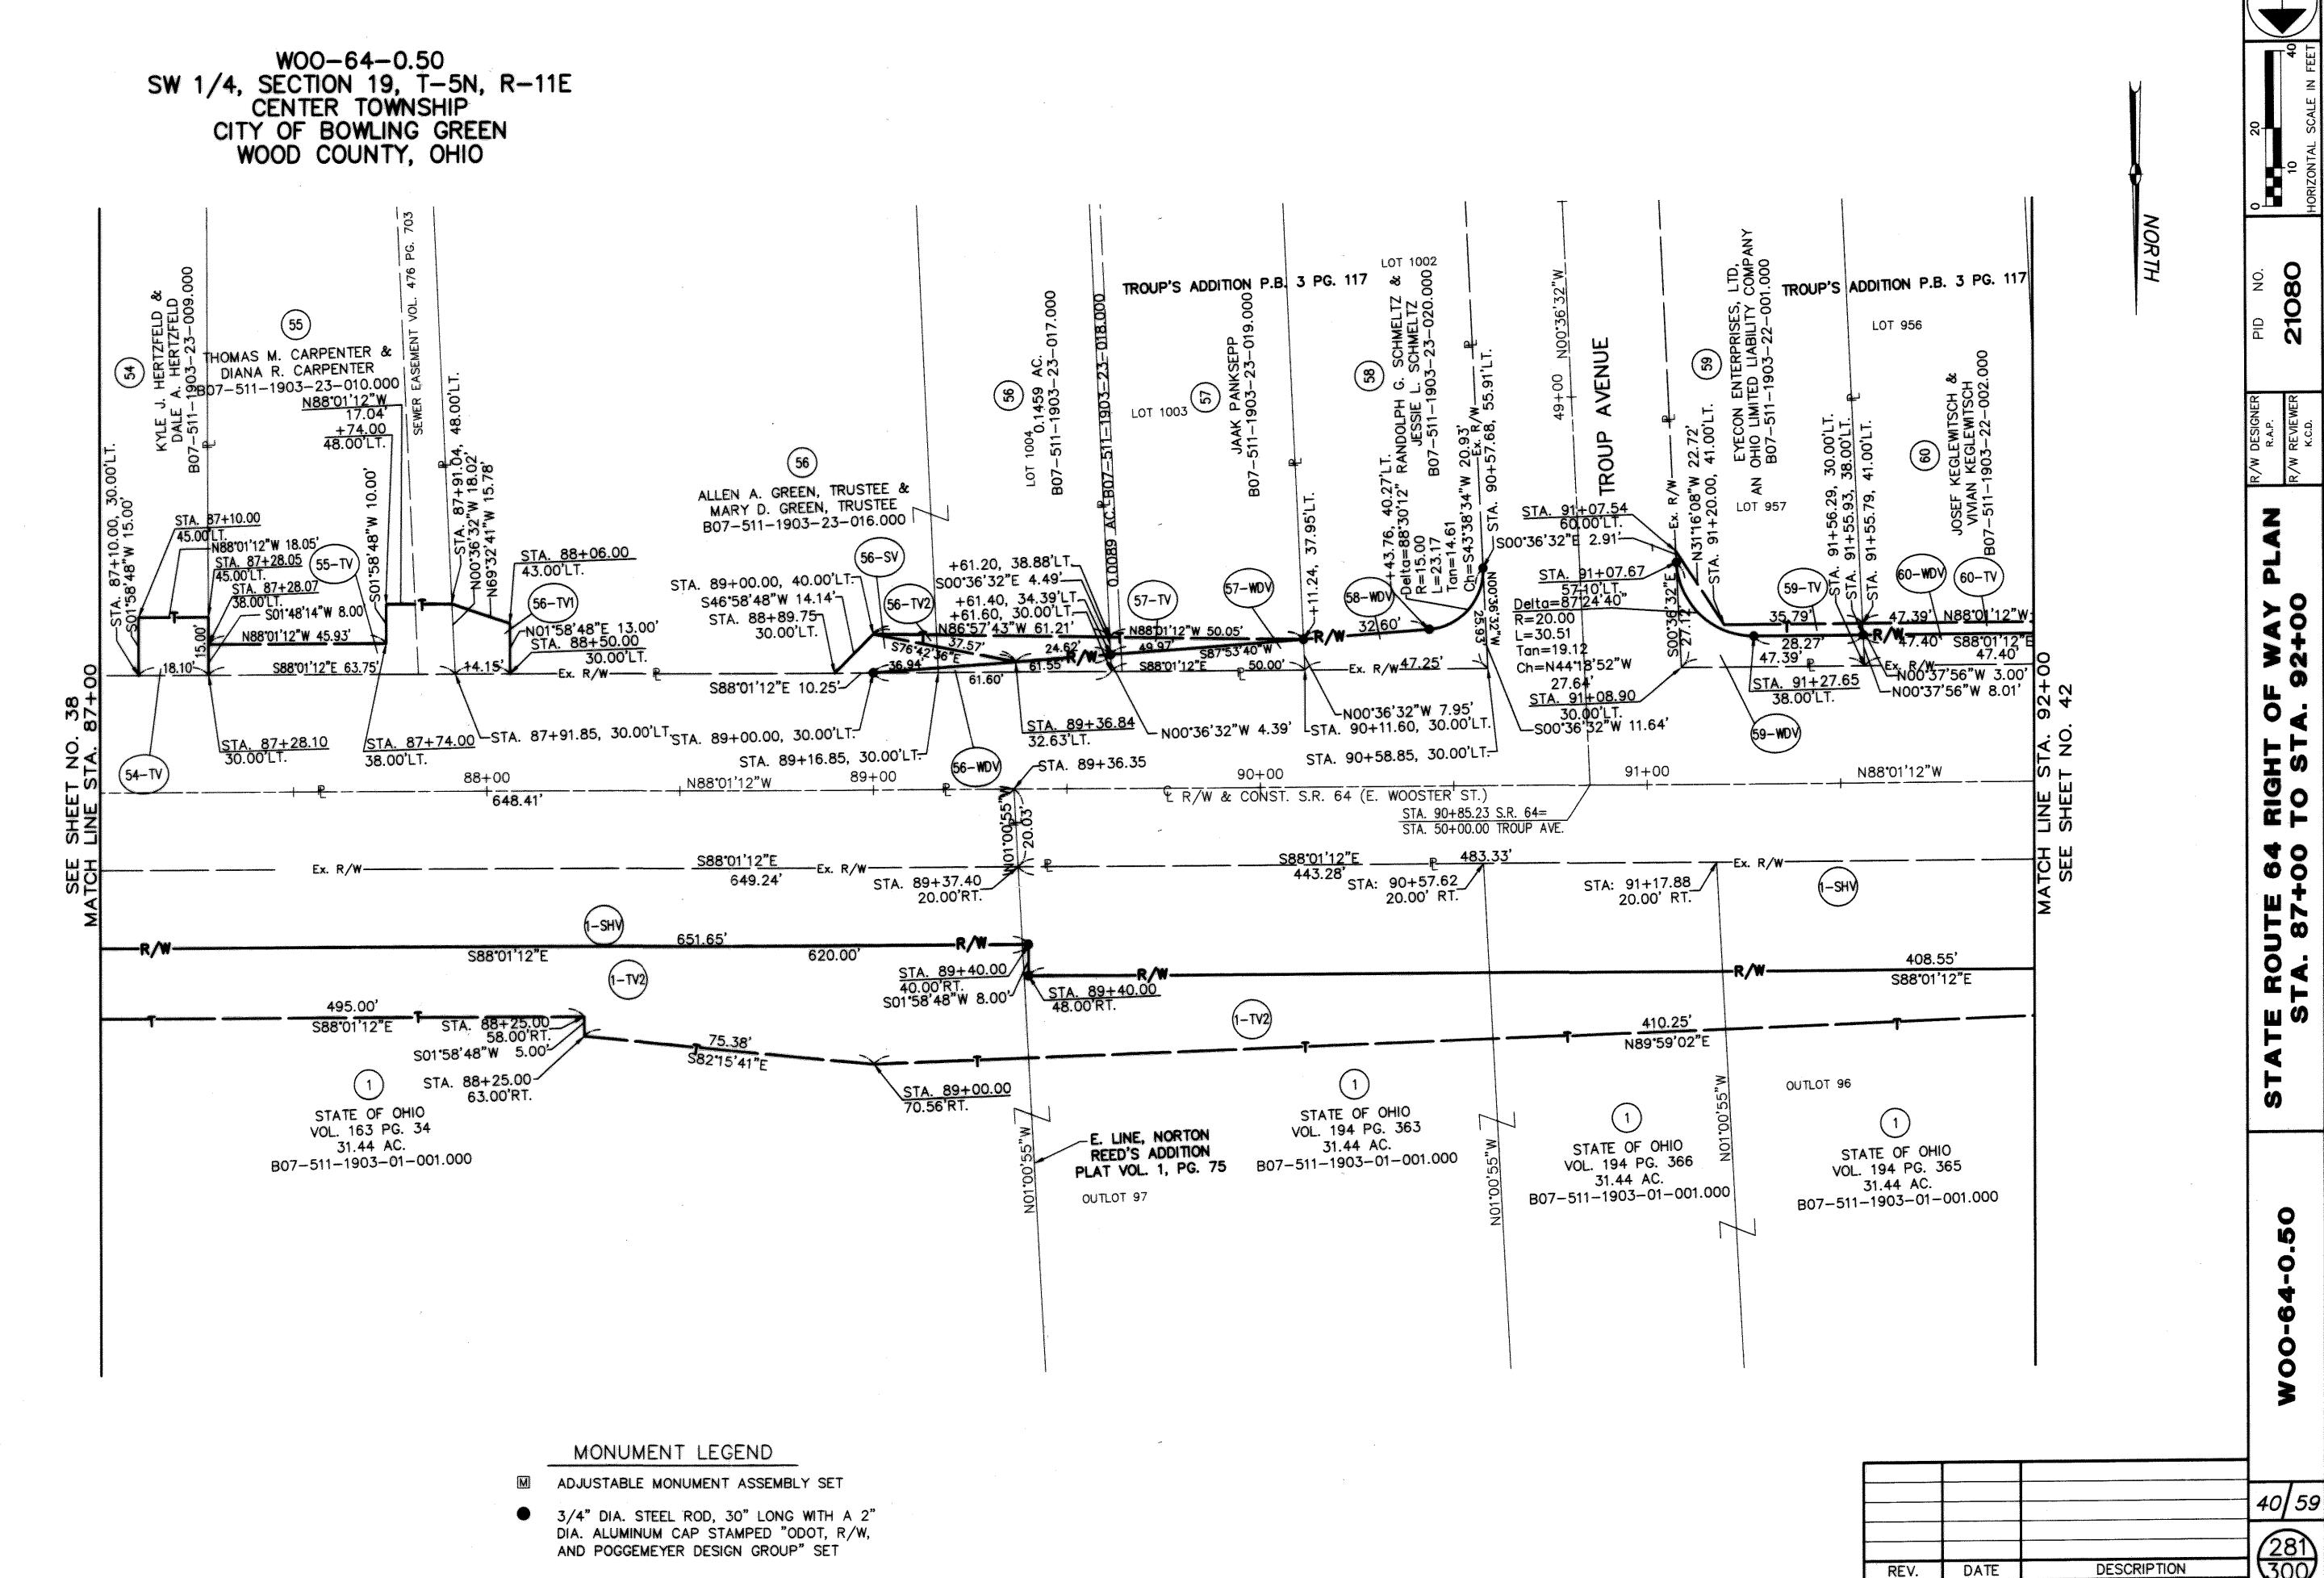


281 300 JULY 9, 2002 DATE OF COMPLETION

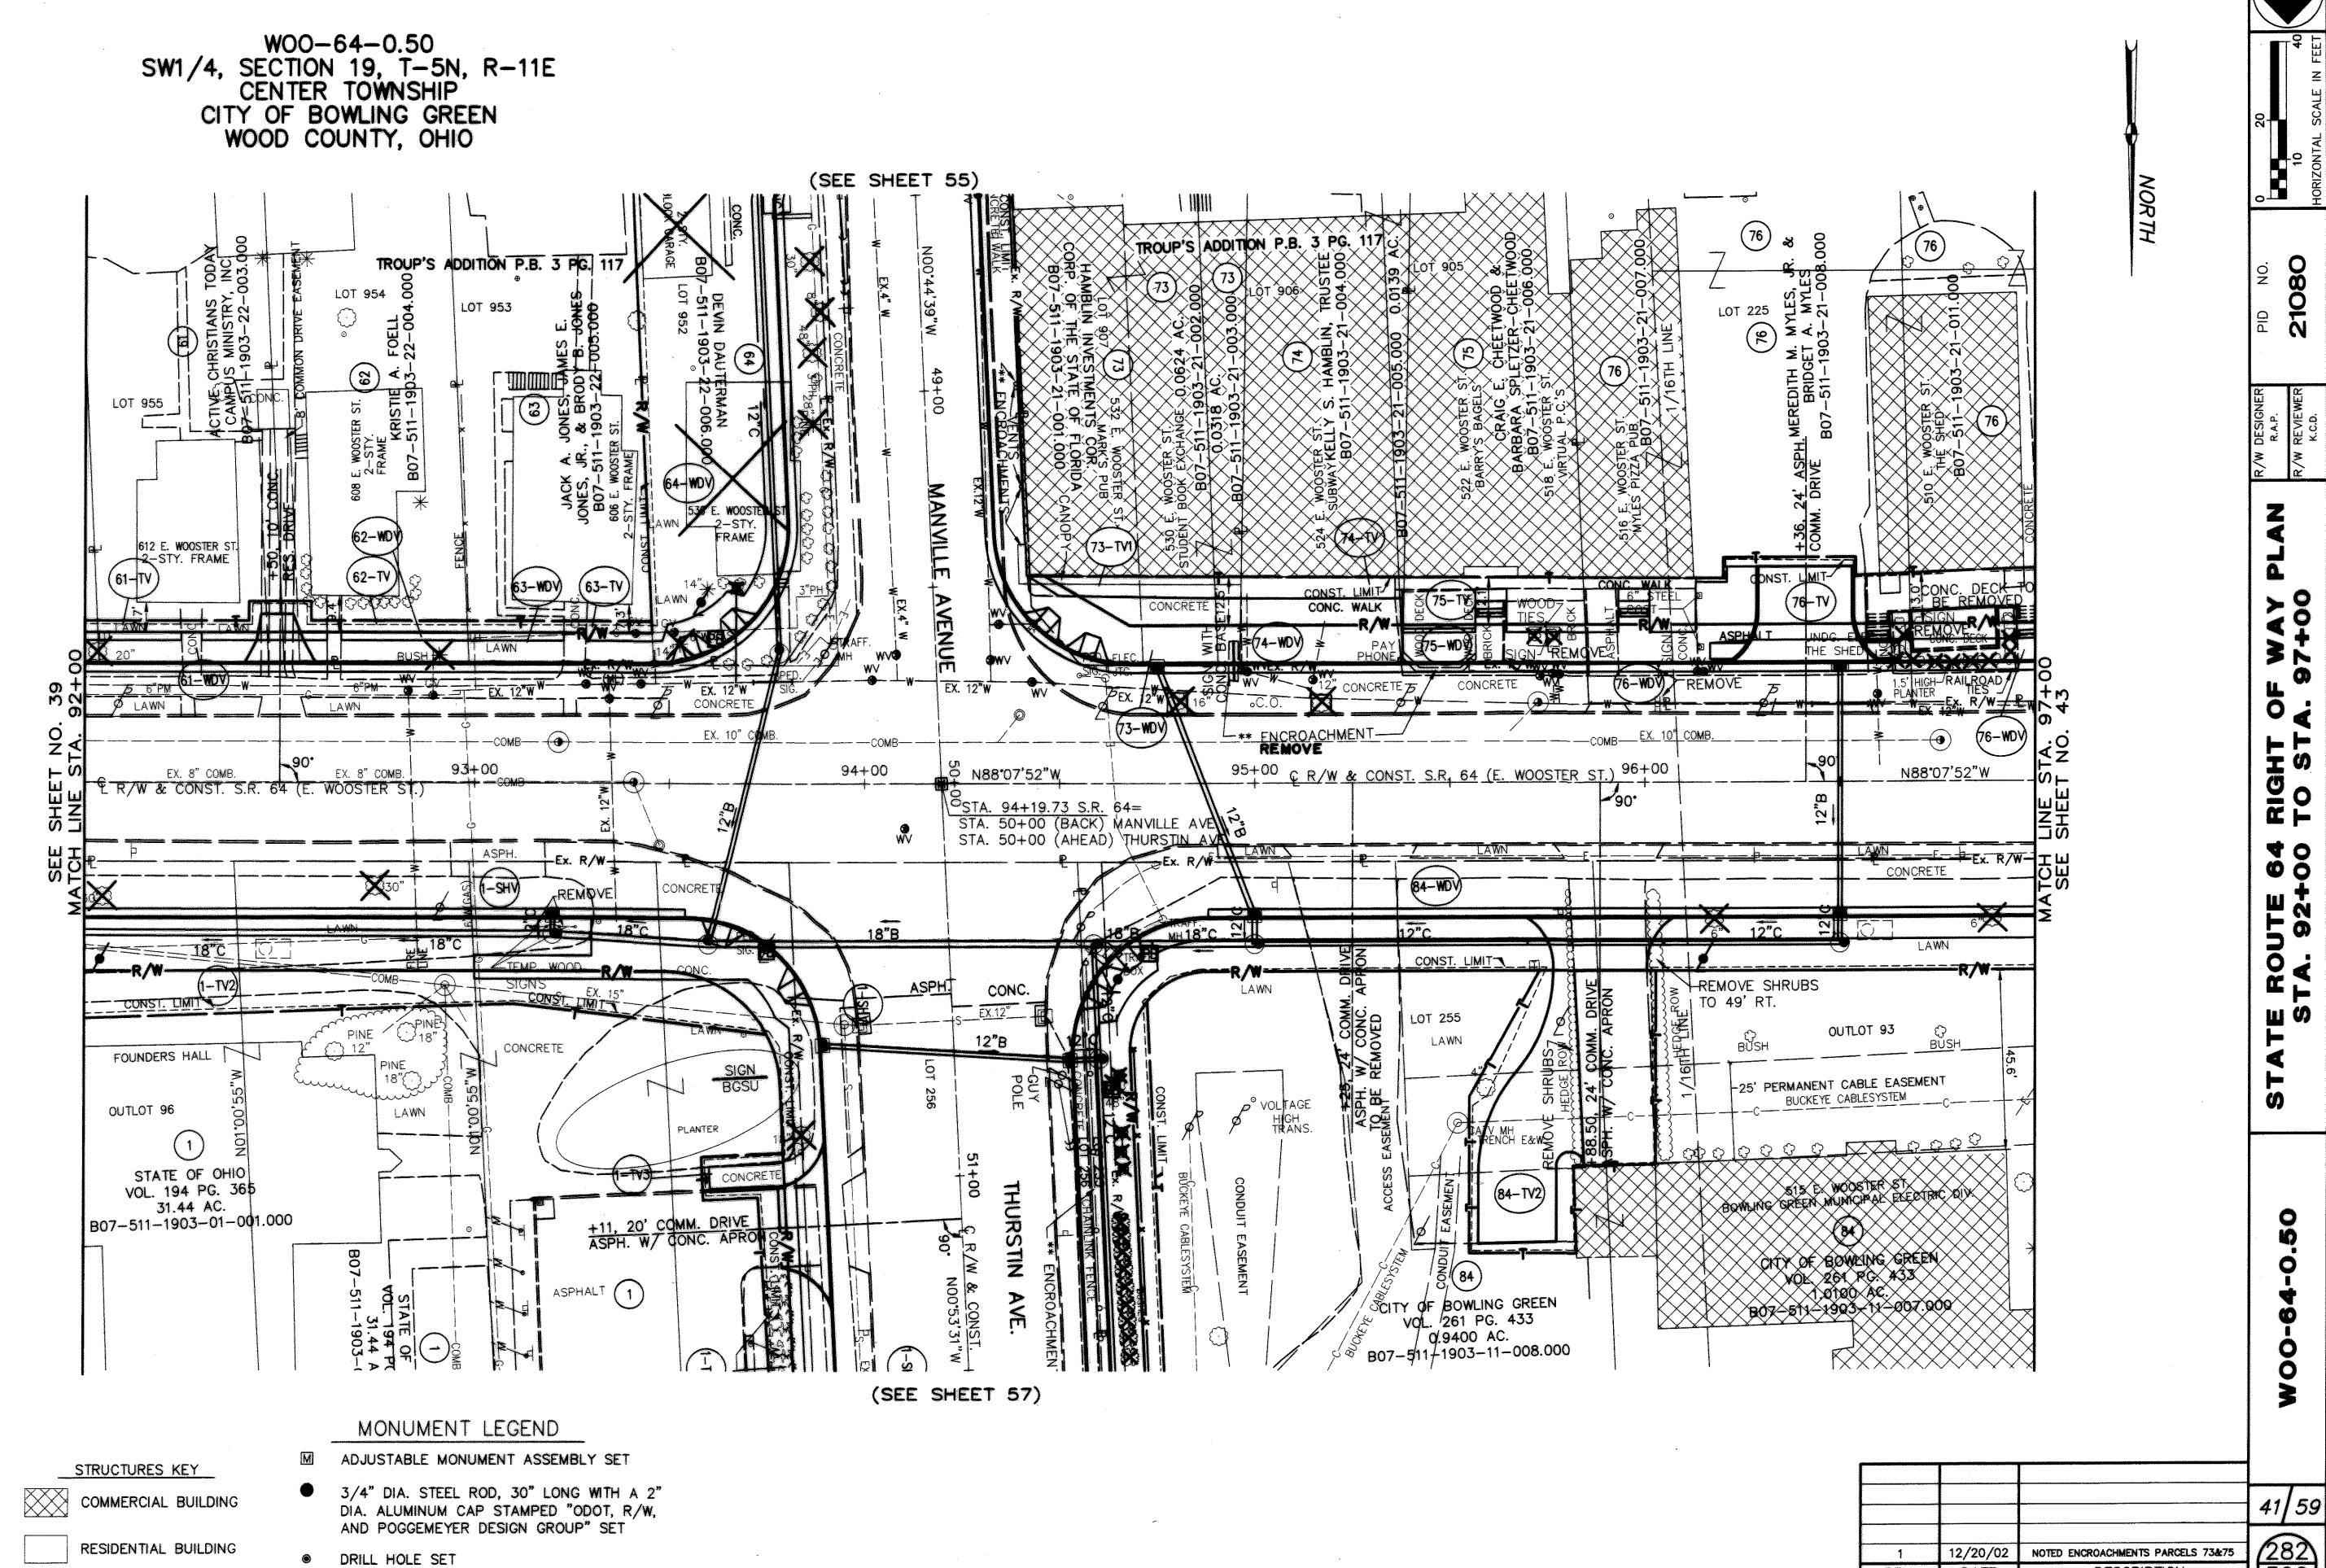

NOTED ENCROACHMENTS PARCELS 73&75 300 DESCRIPTION DATE OF COMPLETION JULY 9, 2002

REV.

DATE

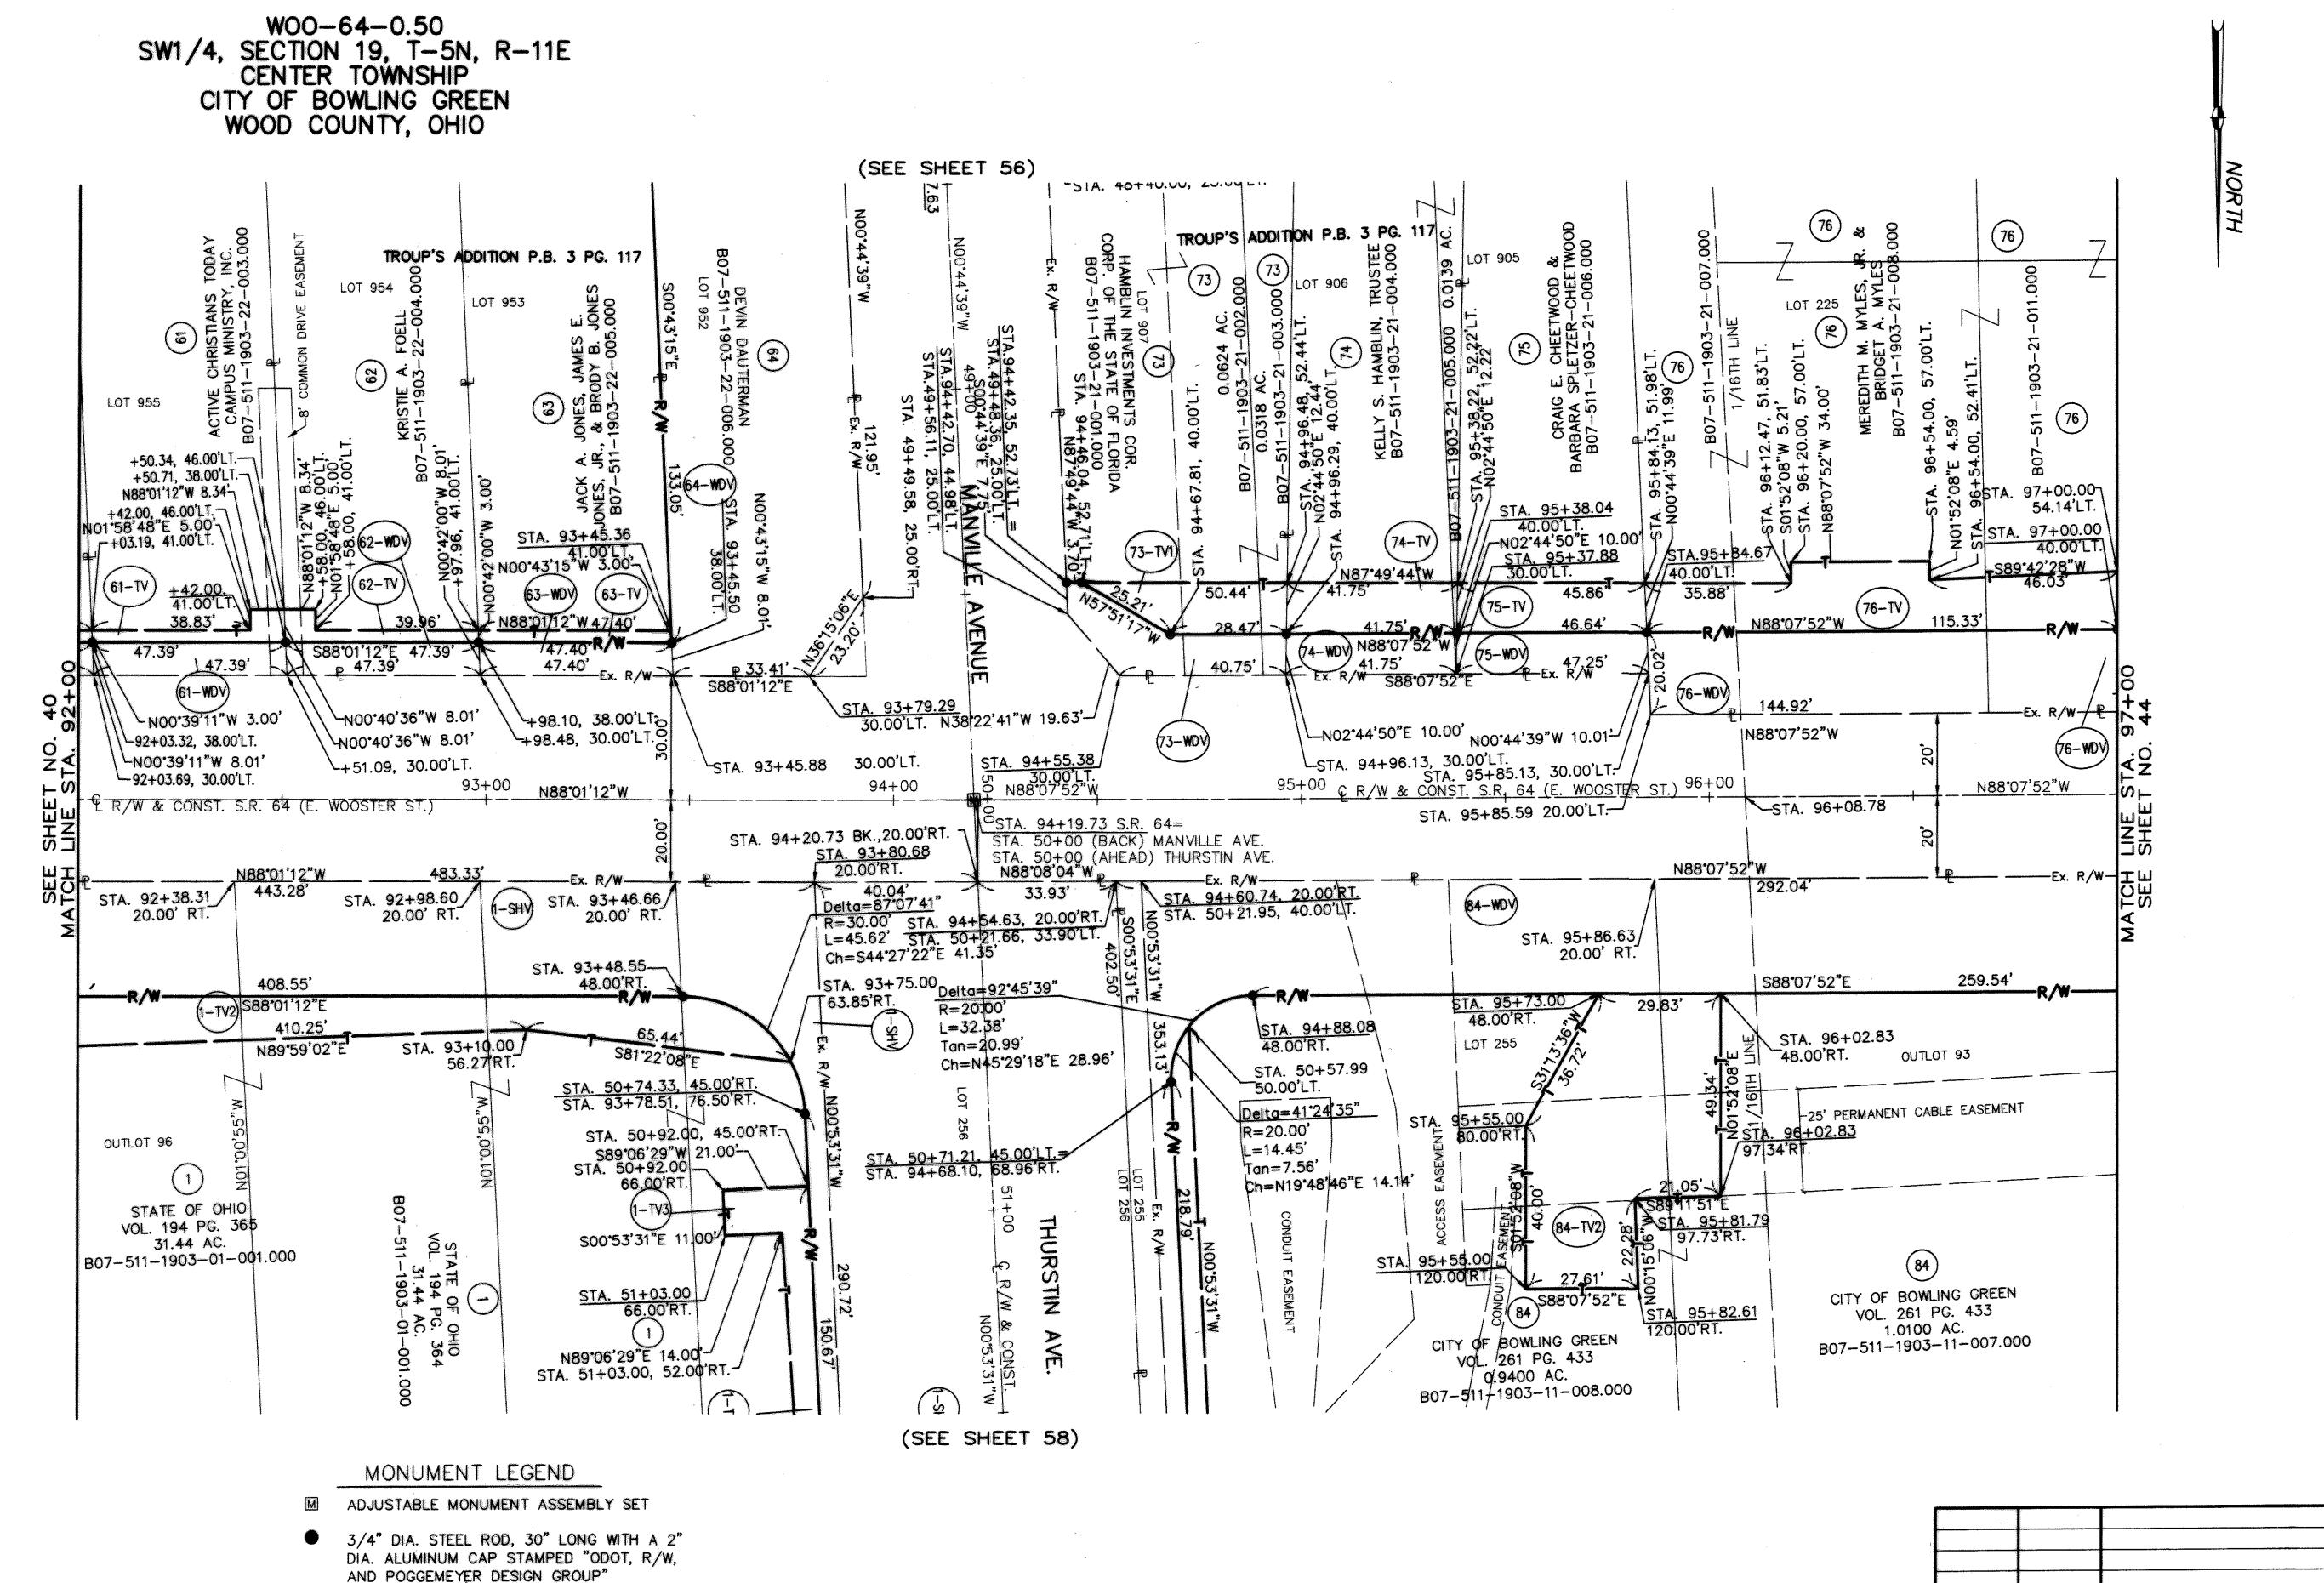

DESCRIPTION

JULY 9, 2002

DATE


DATE OF COMPLETION


REV.


180 180


国の

DRILL HOLE SET

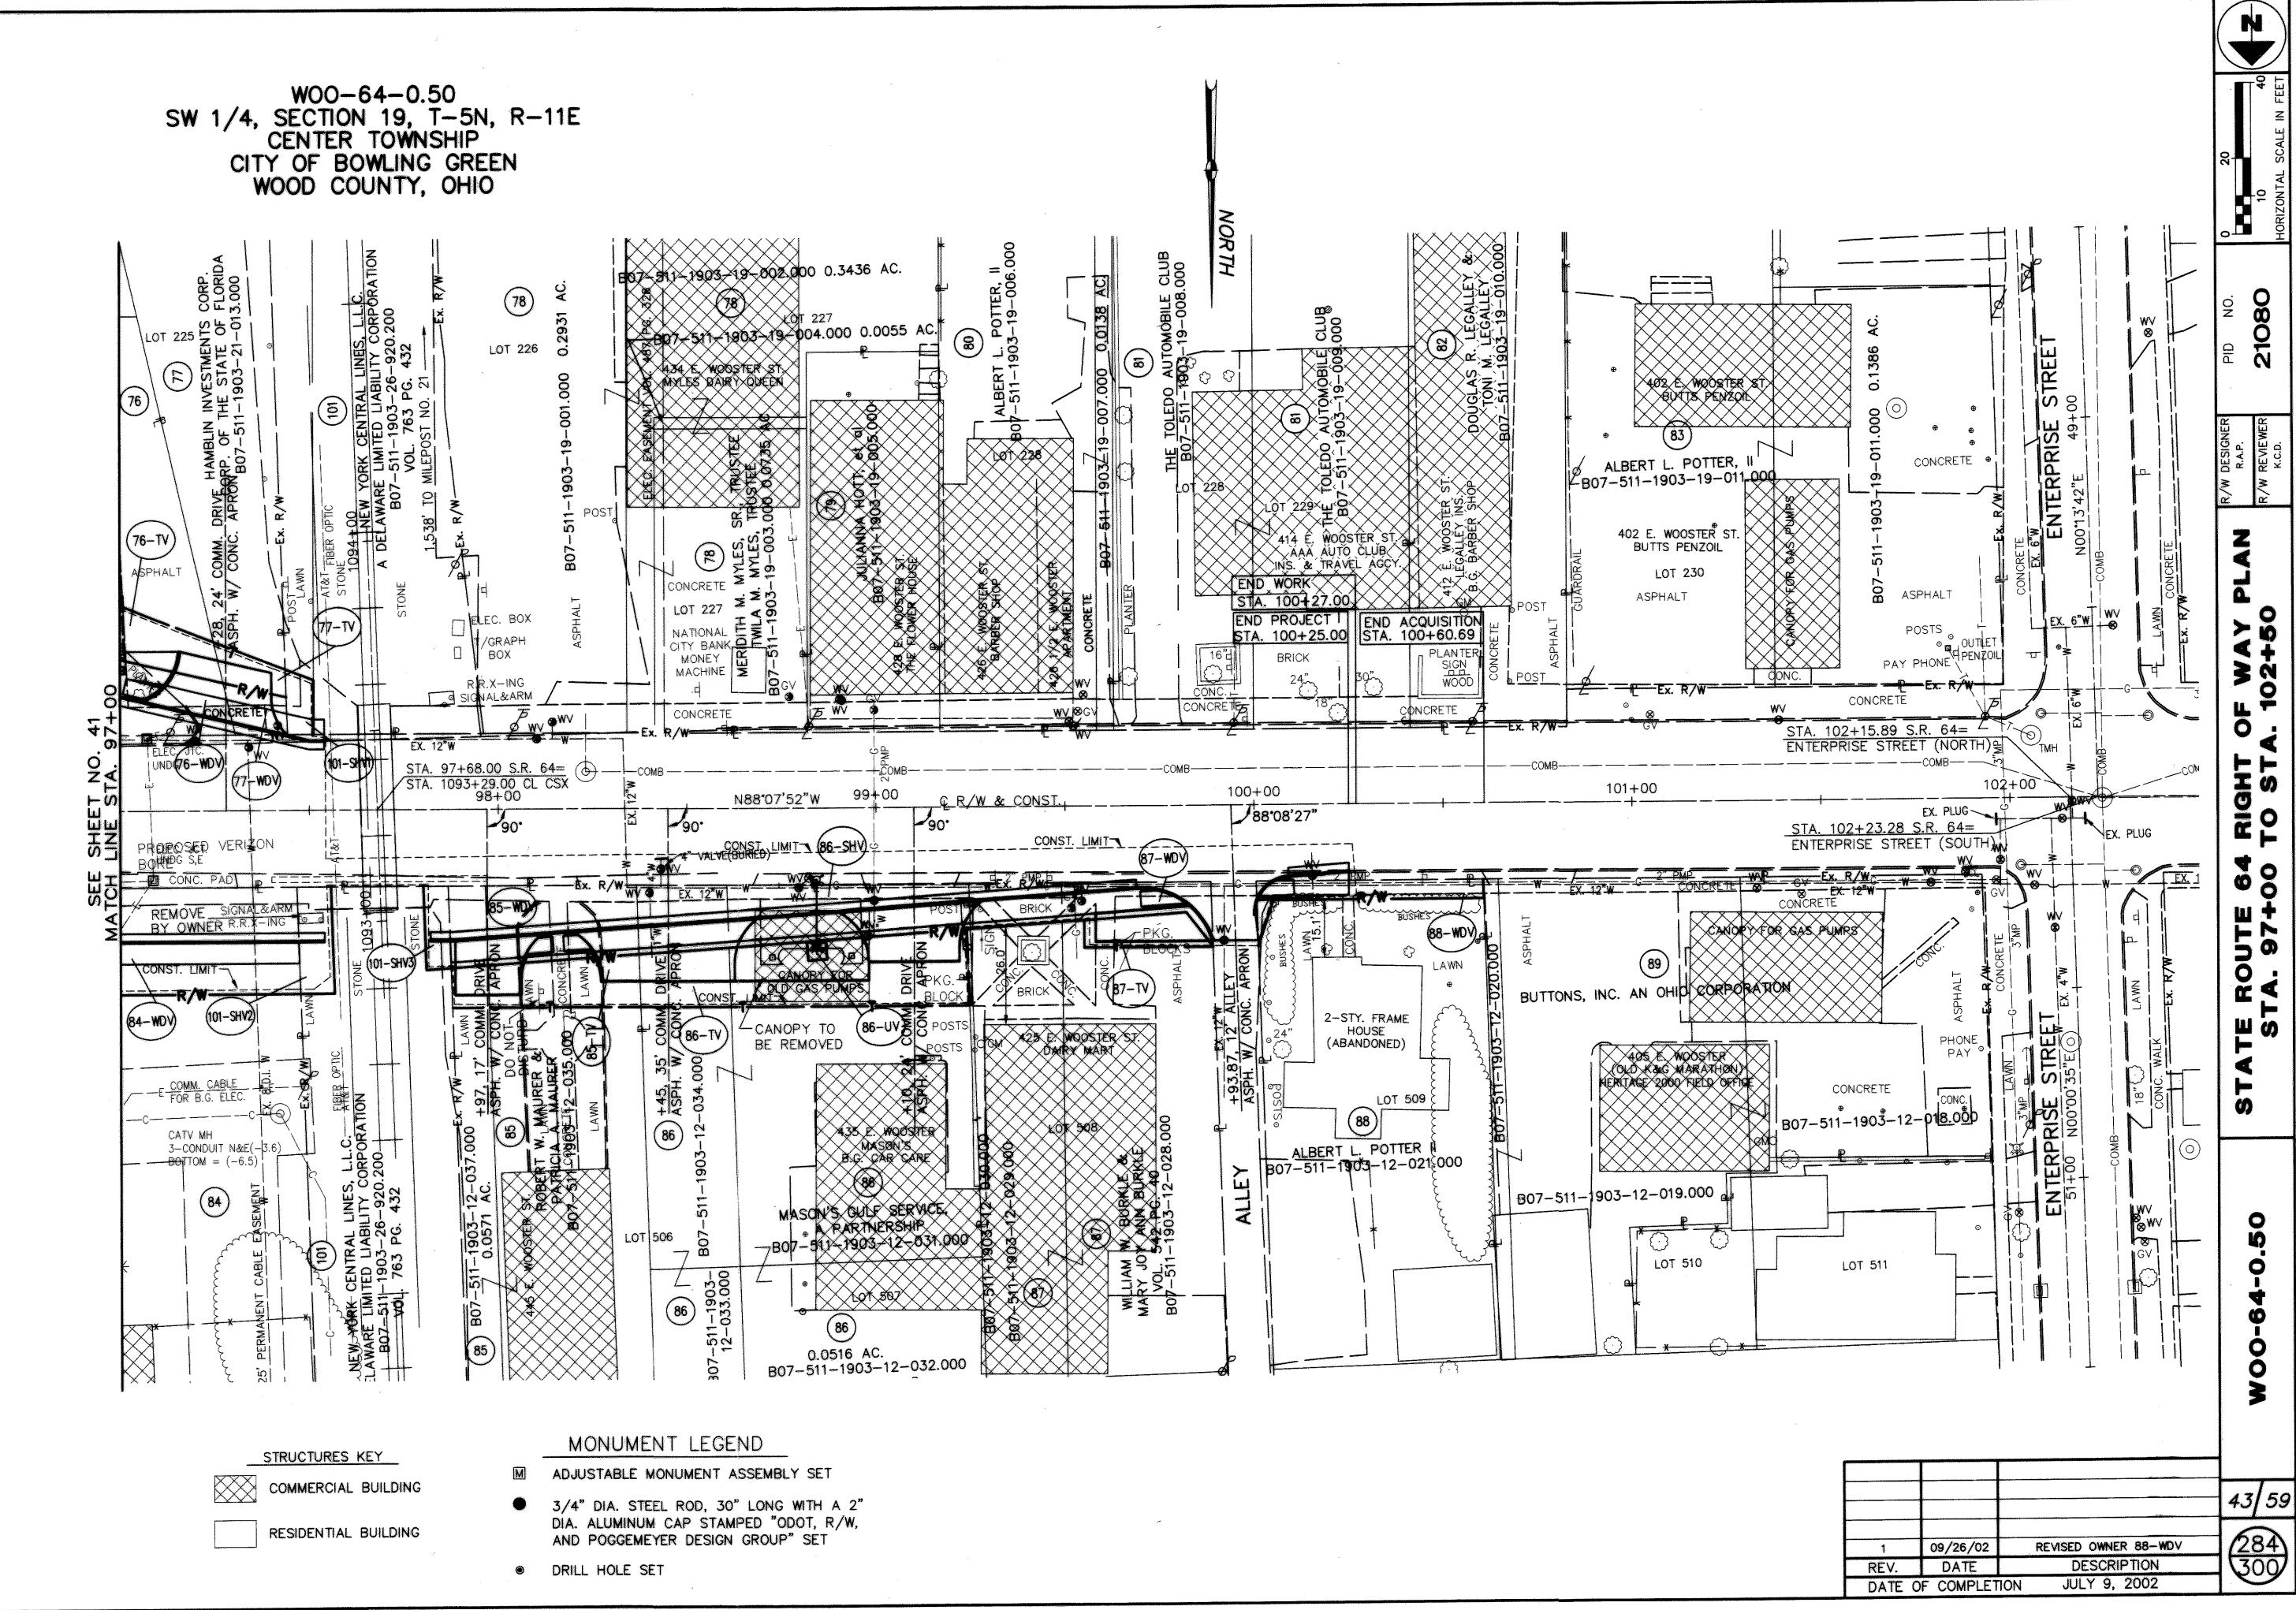


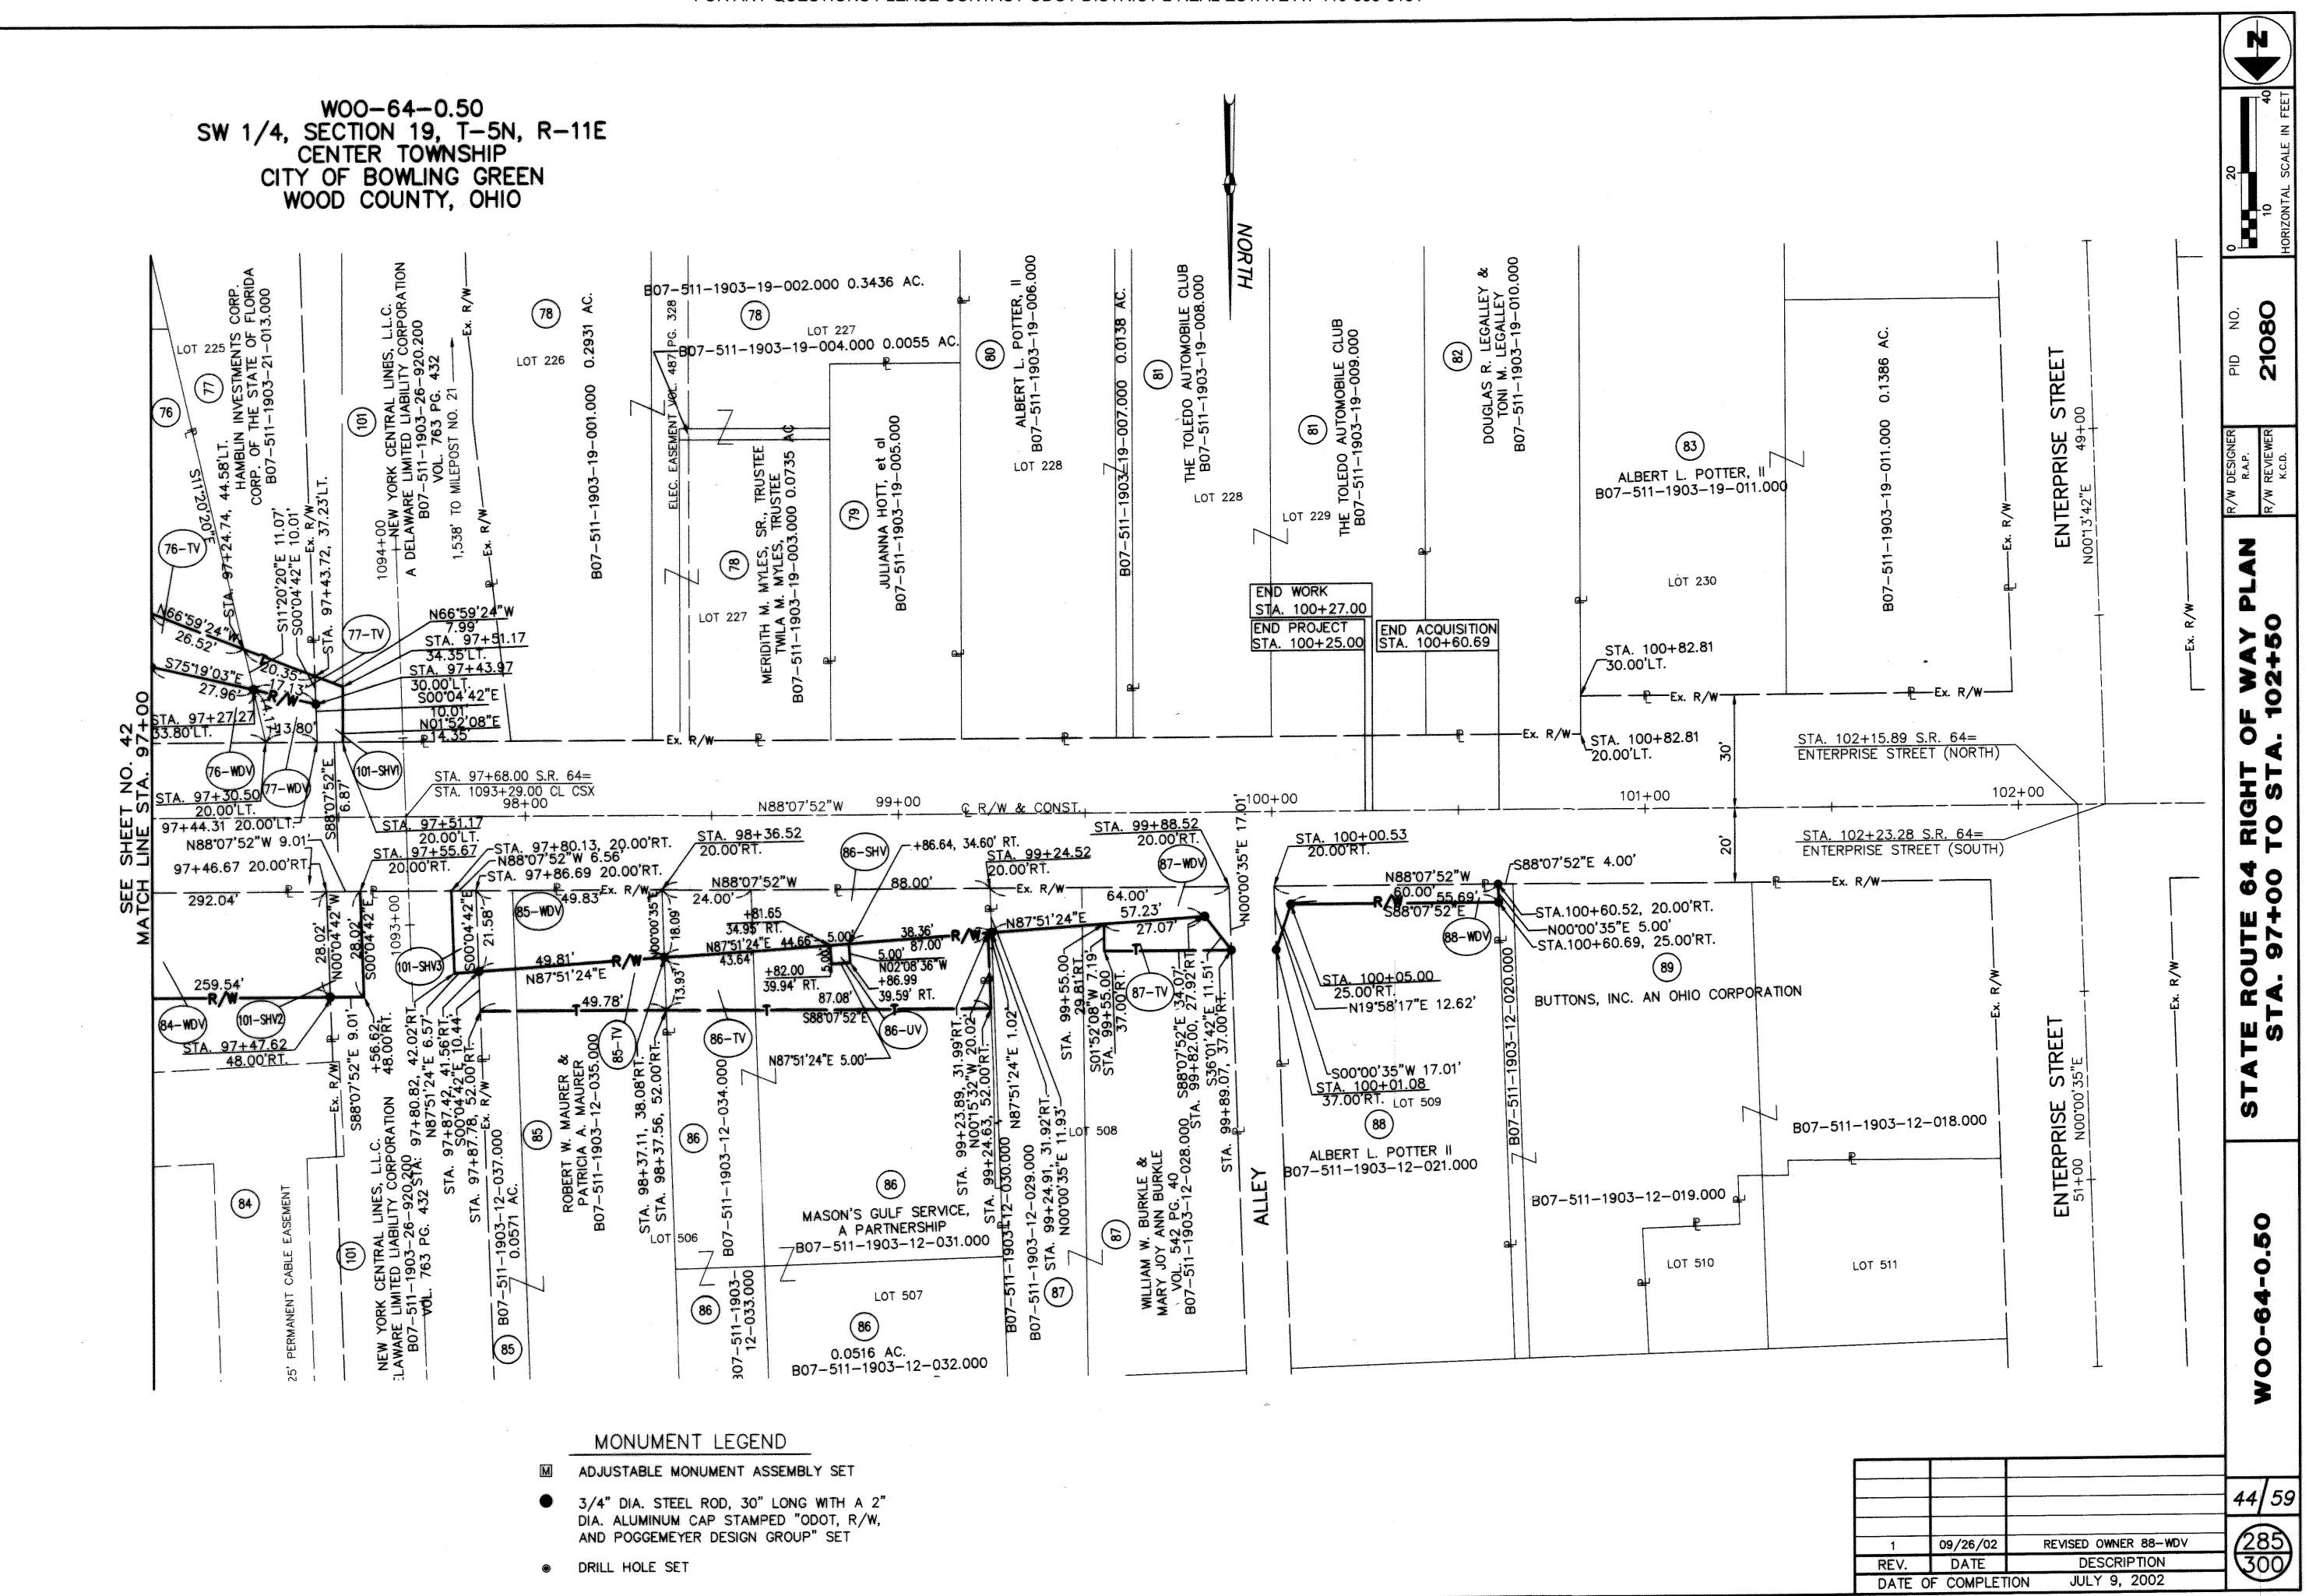


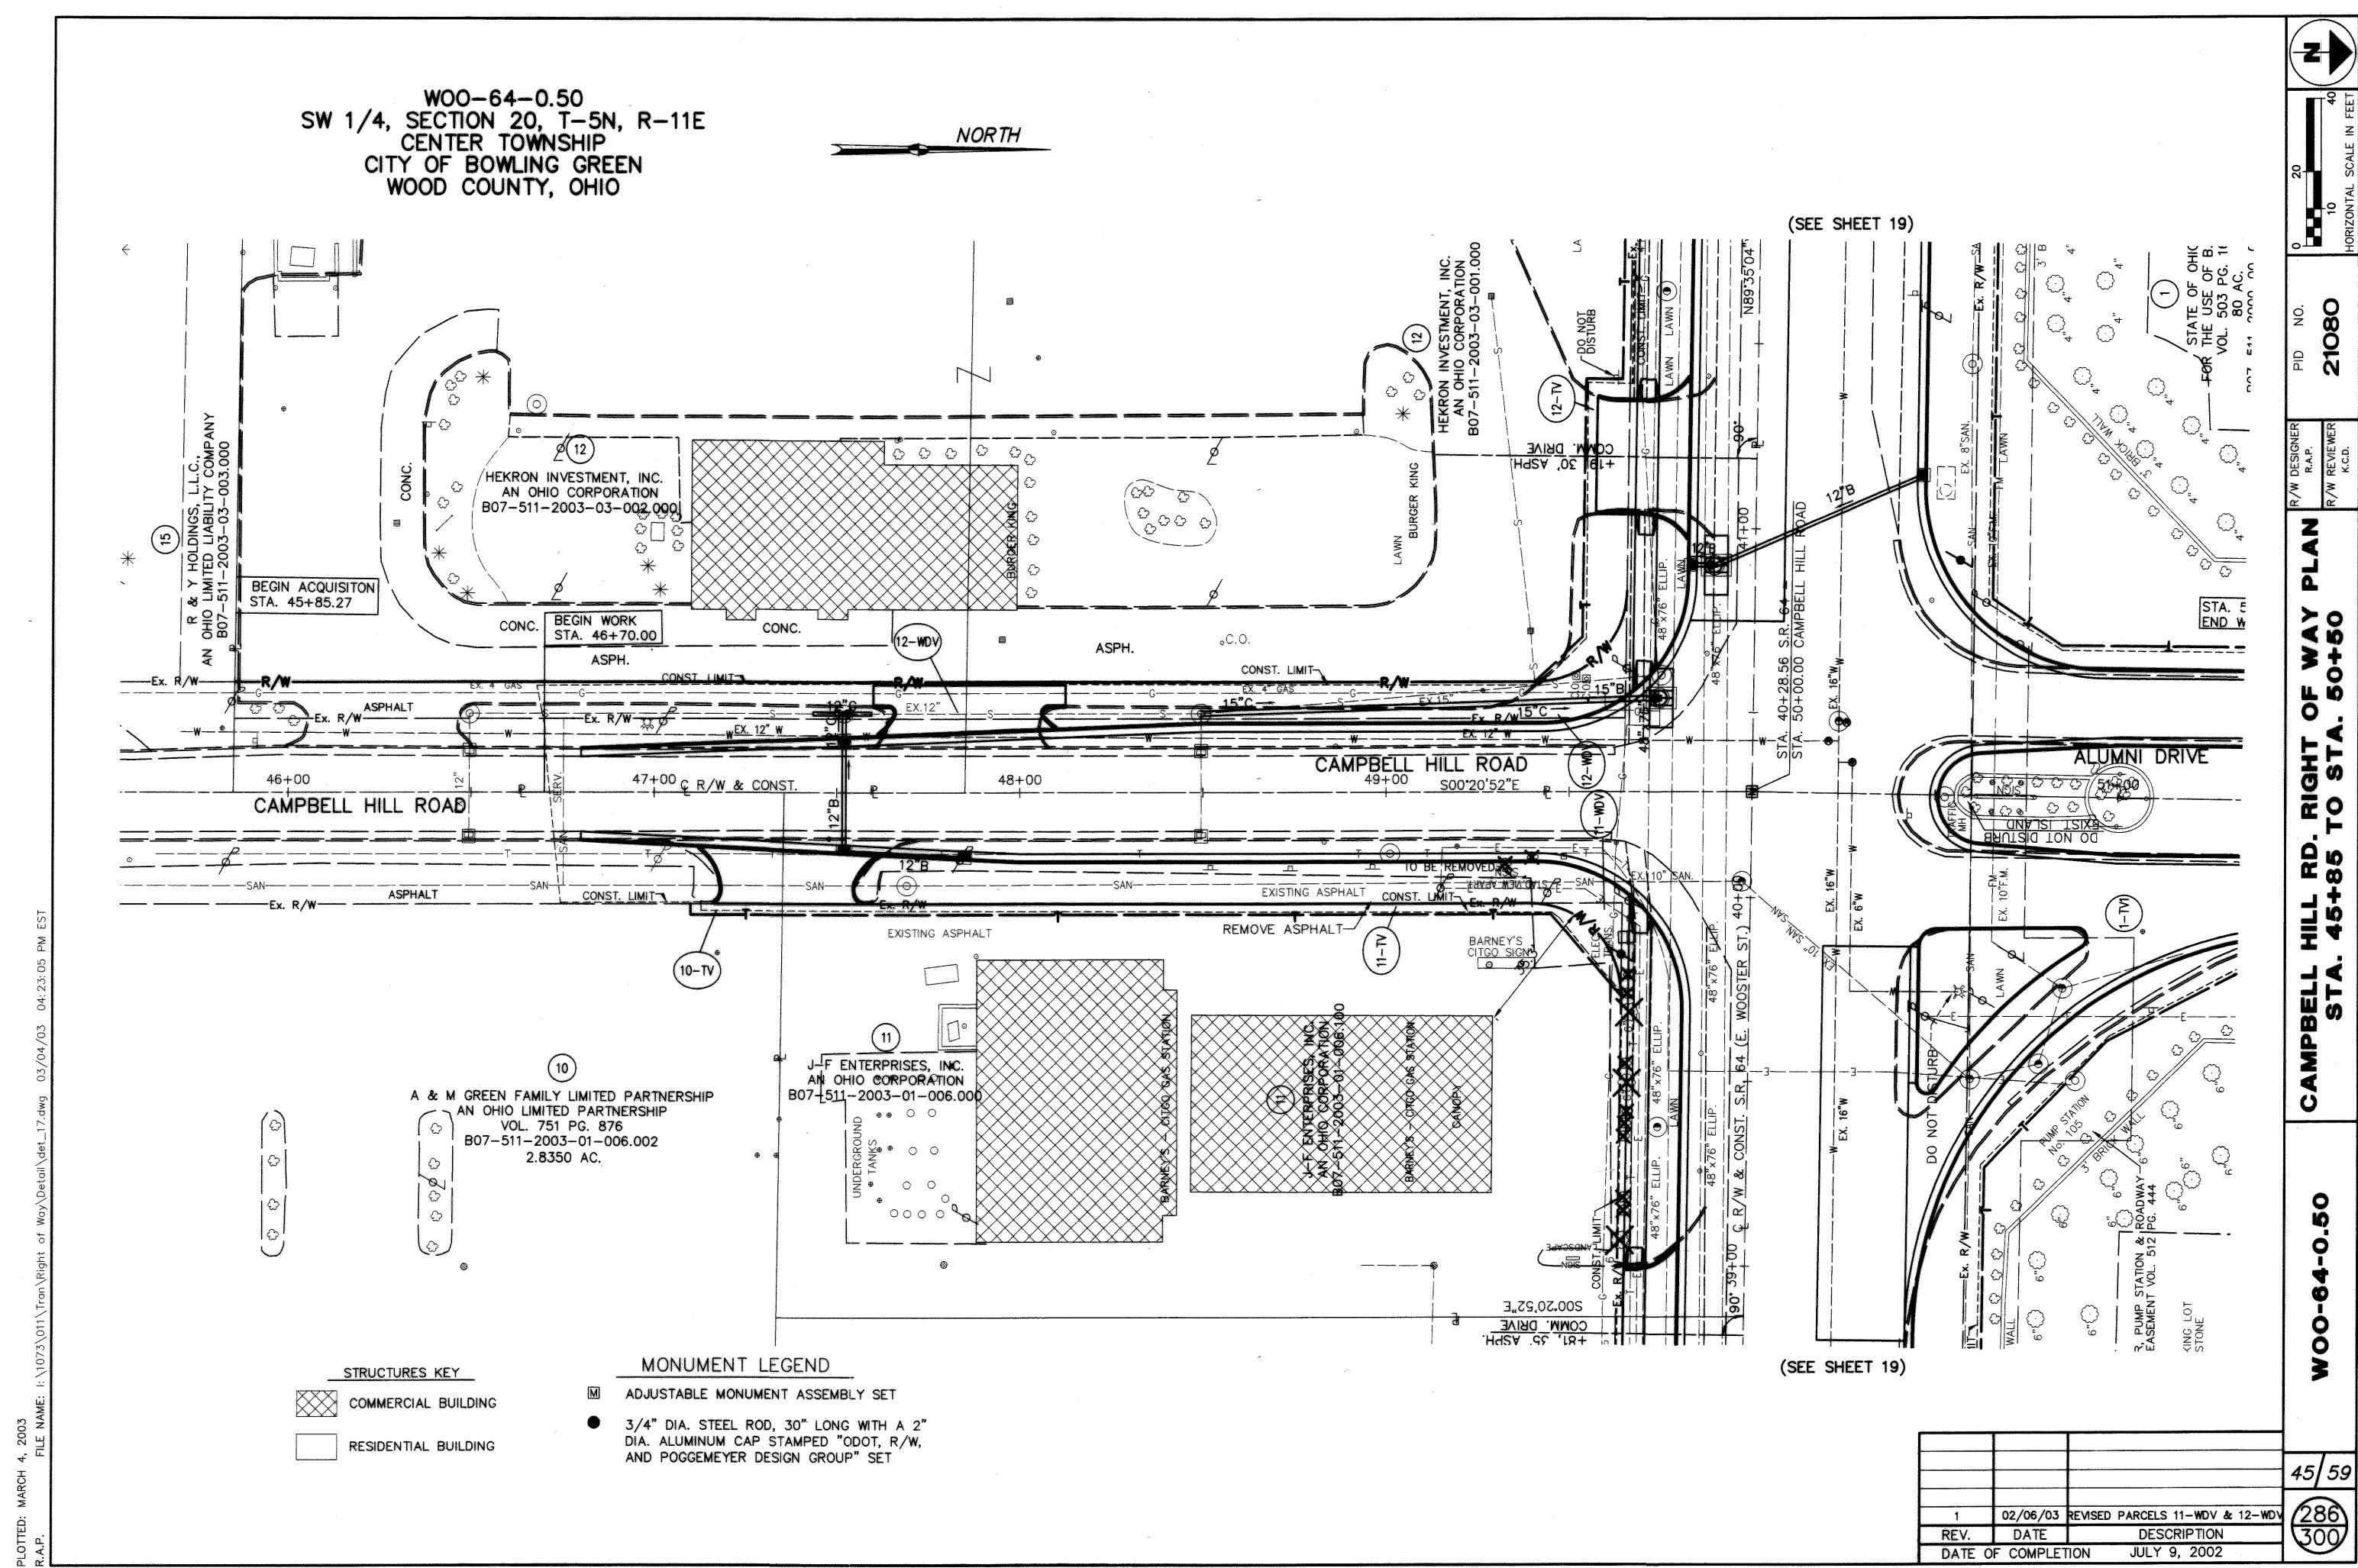


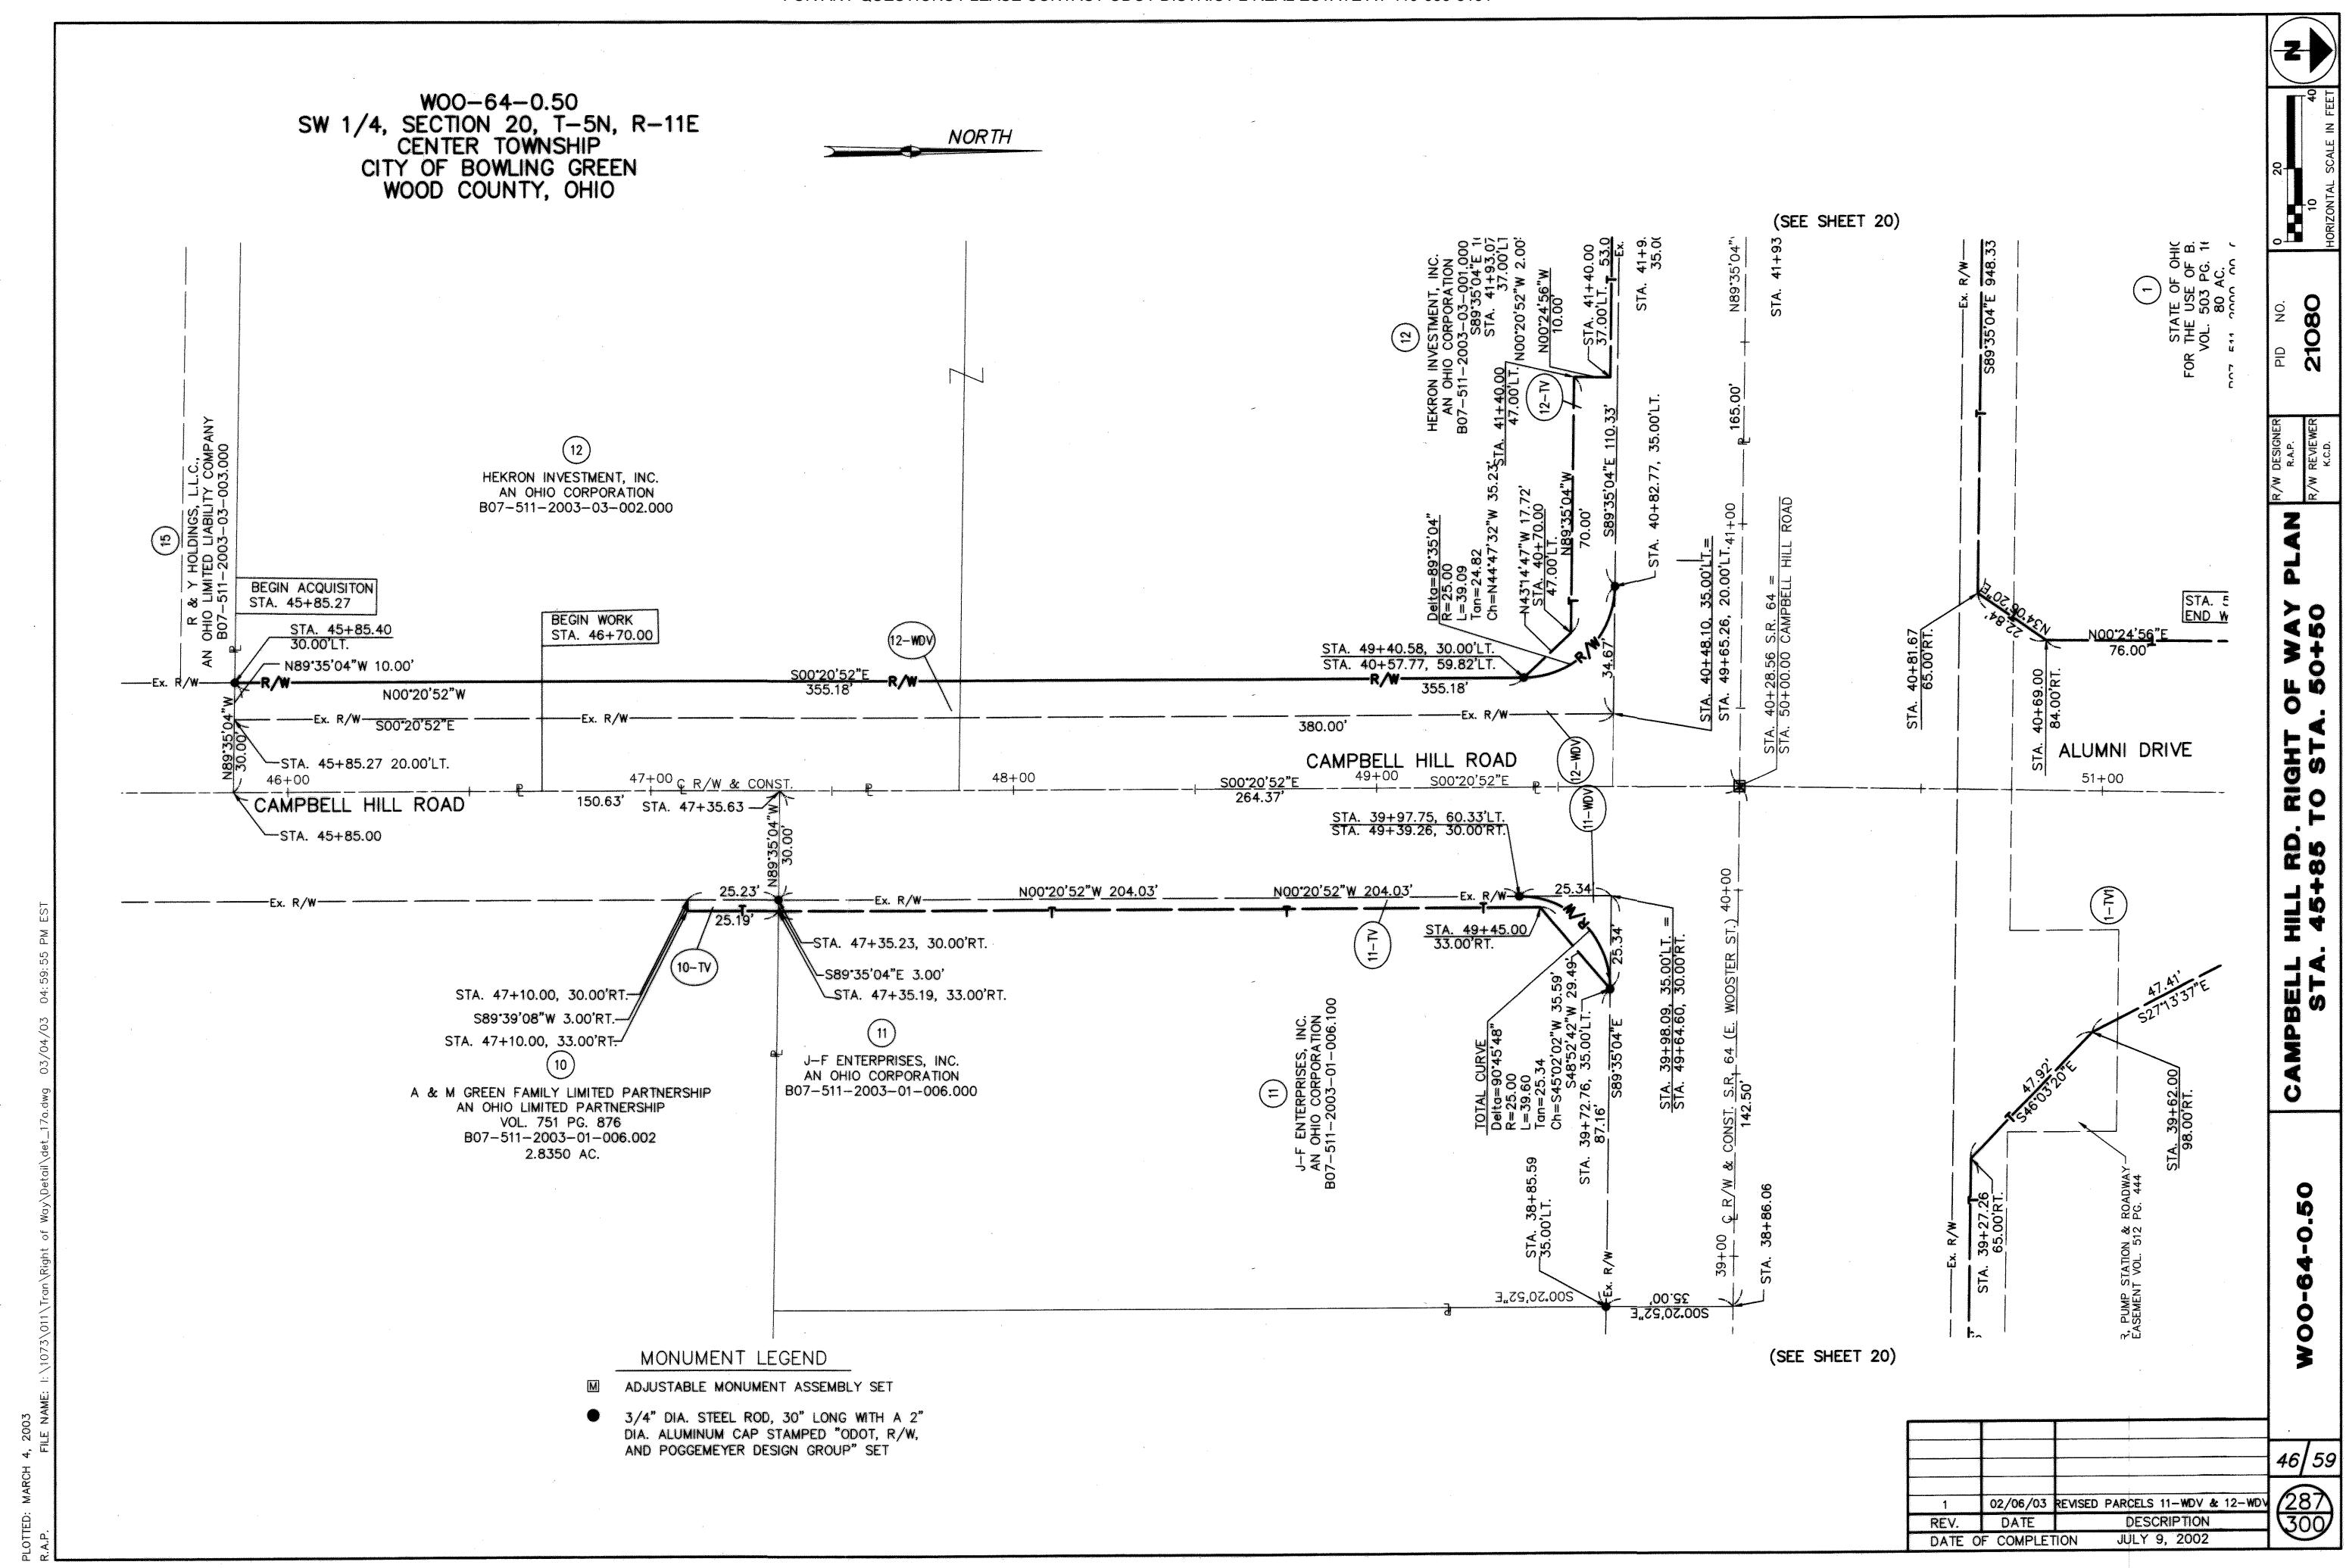



1073\_011 W00\_64\_0 50

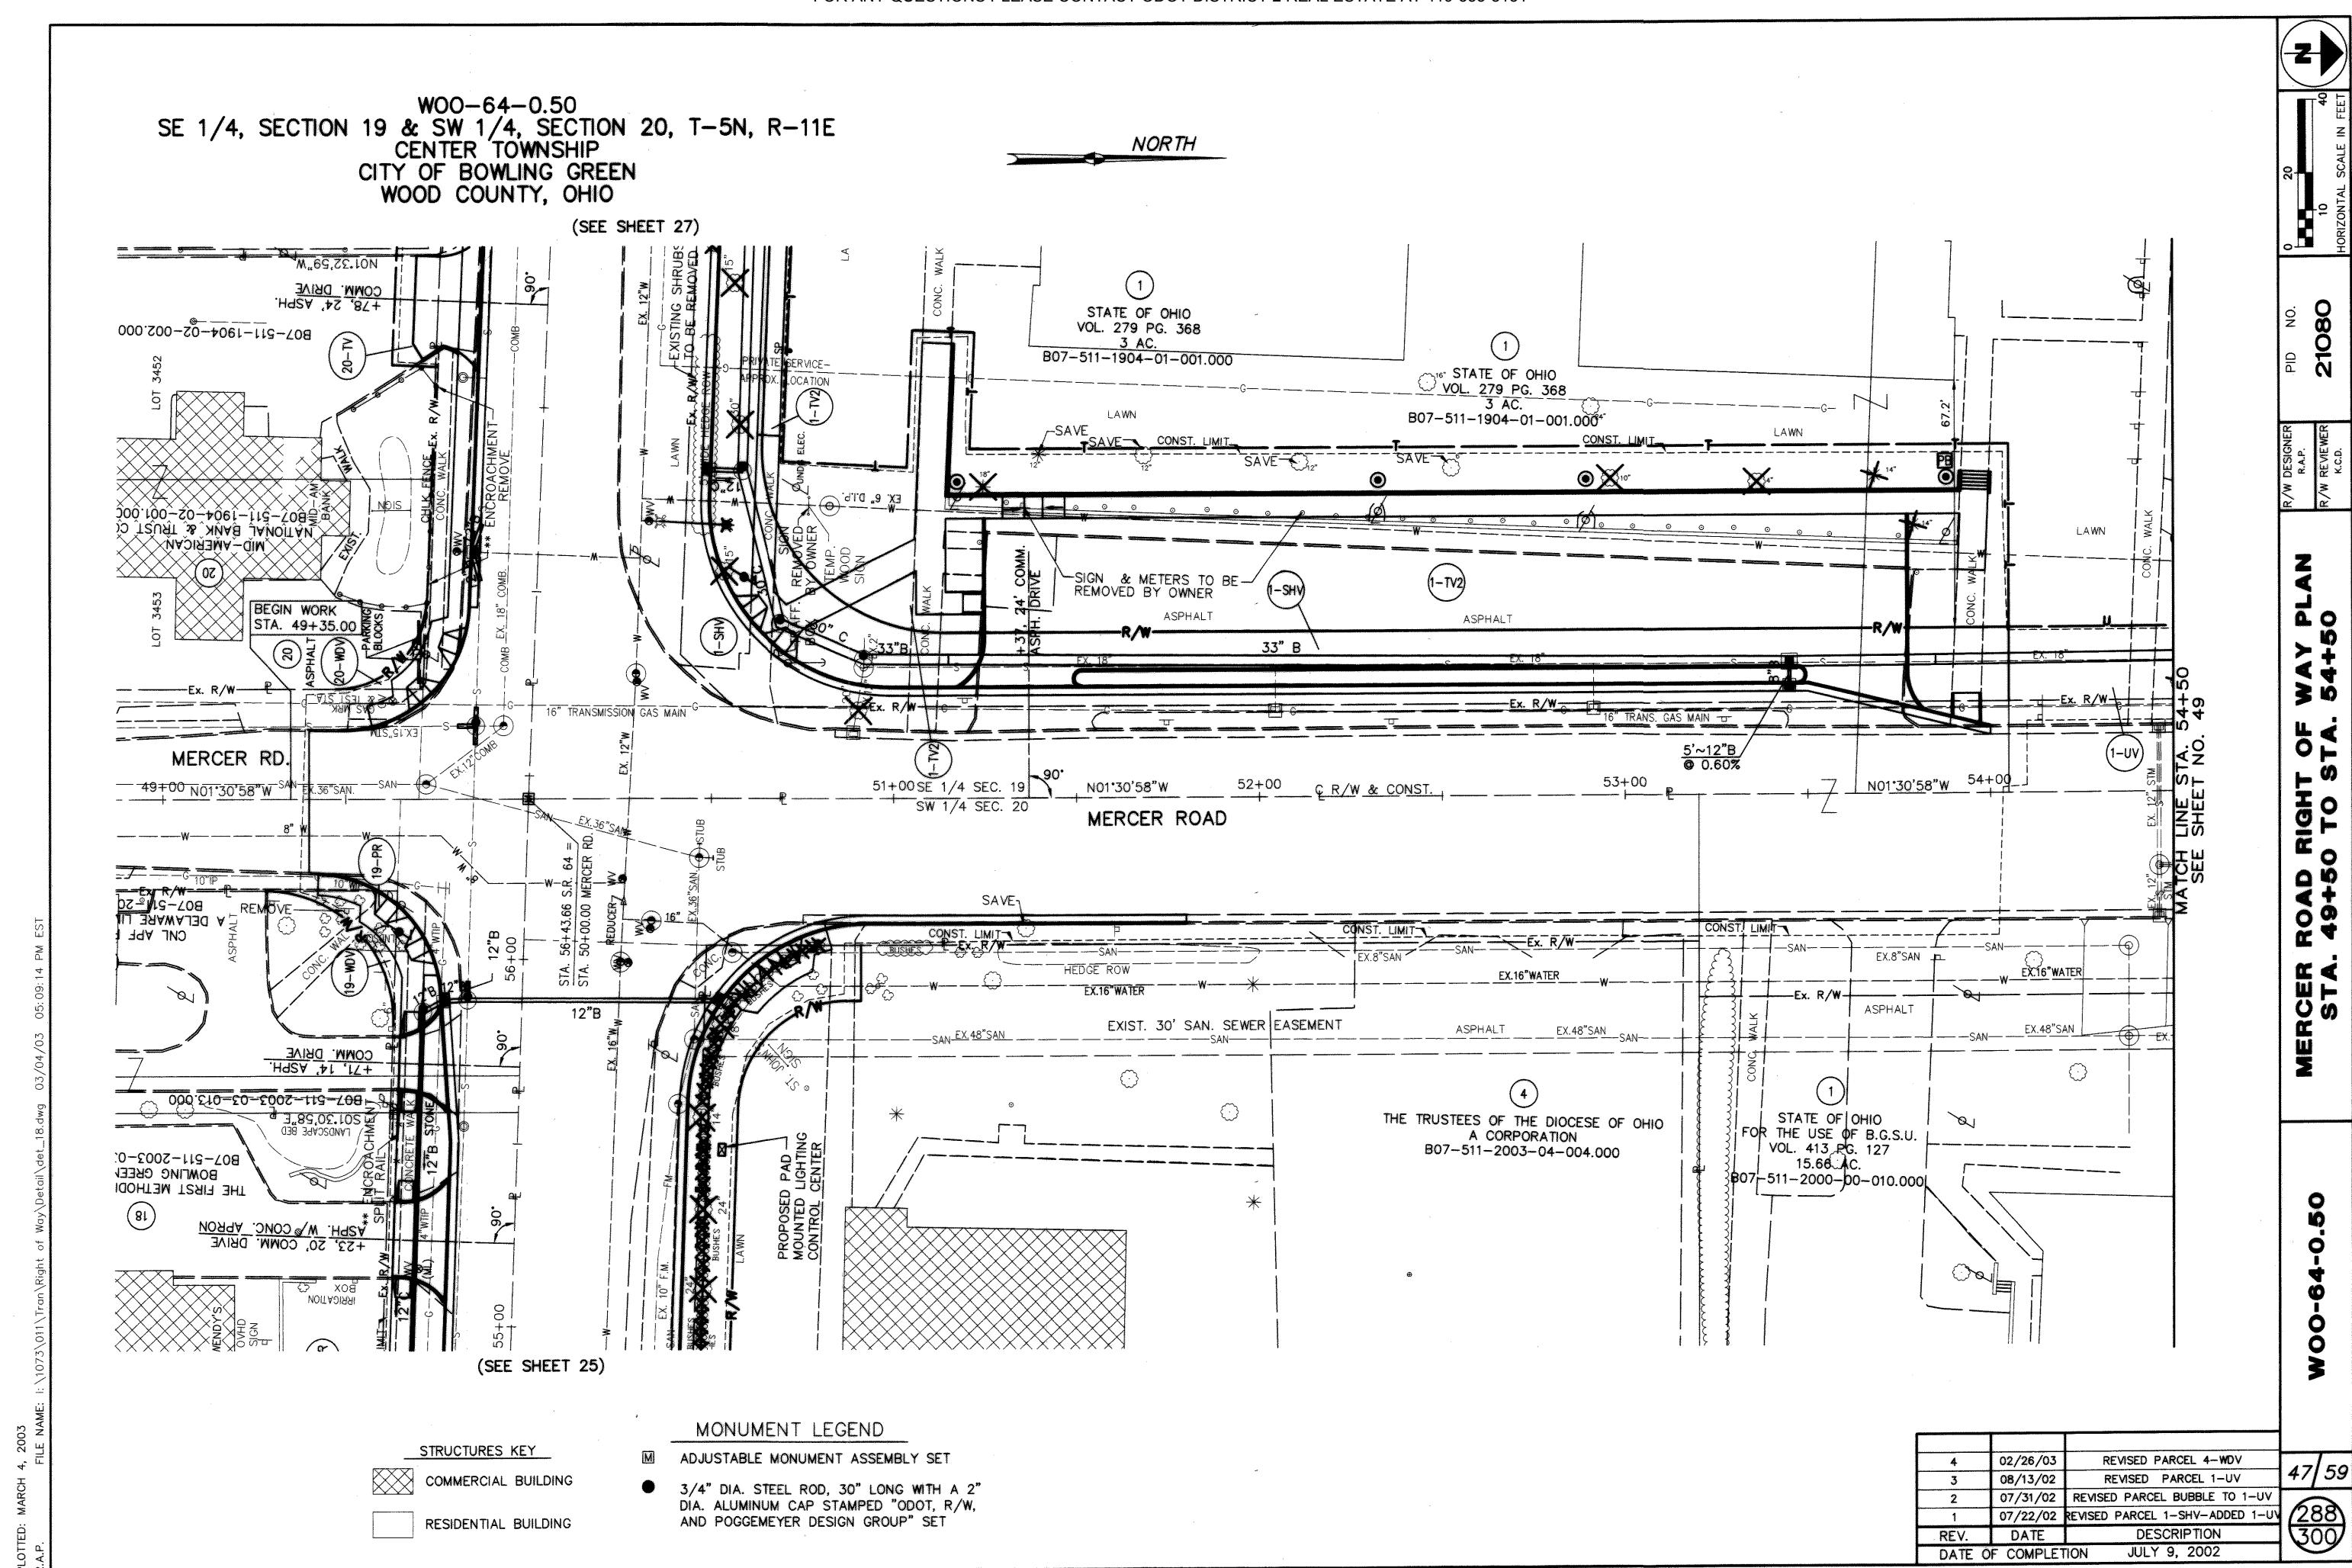


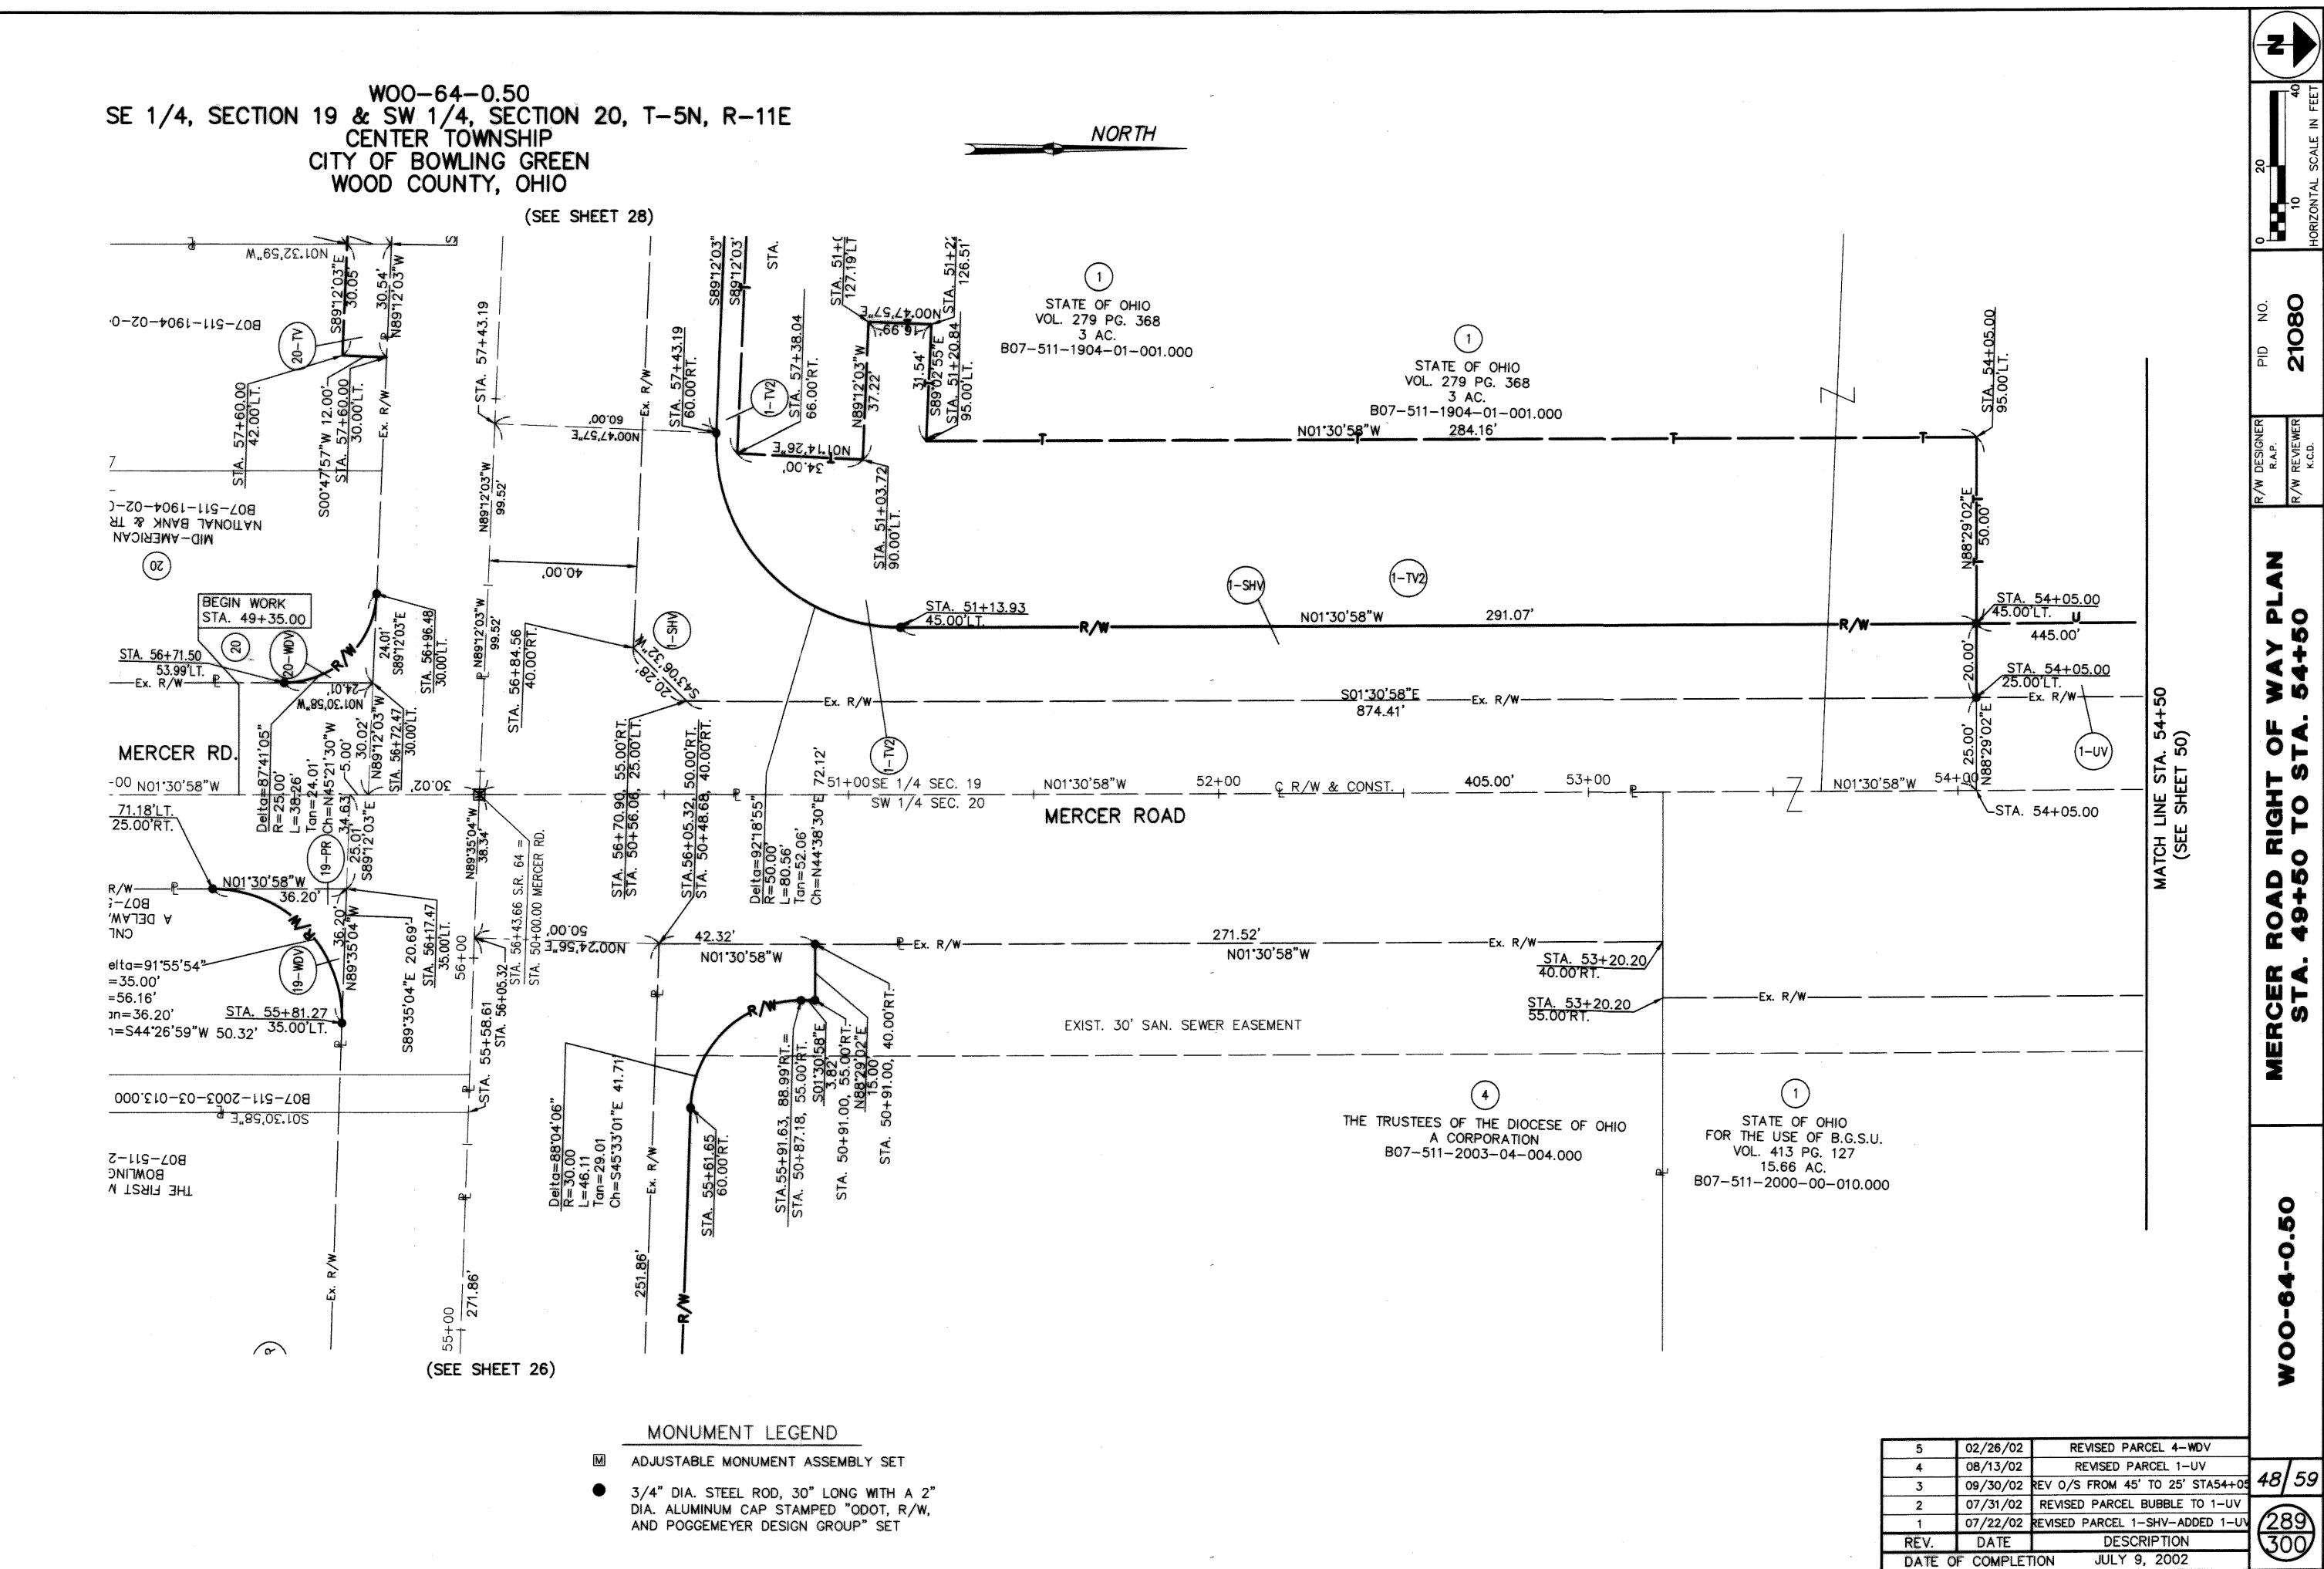


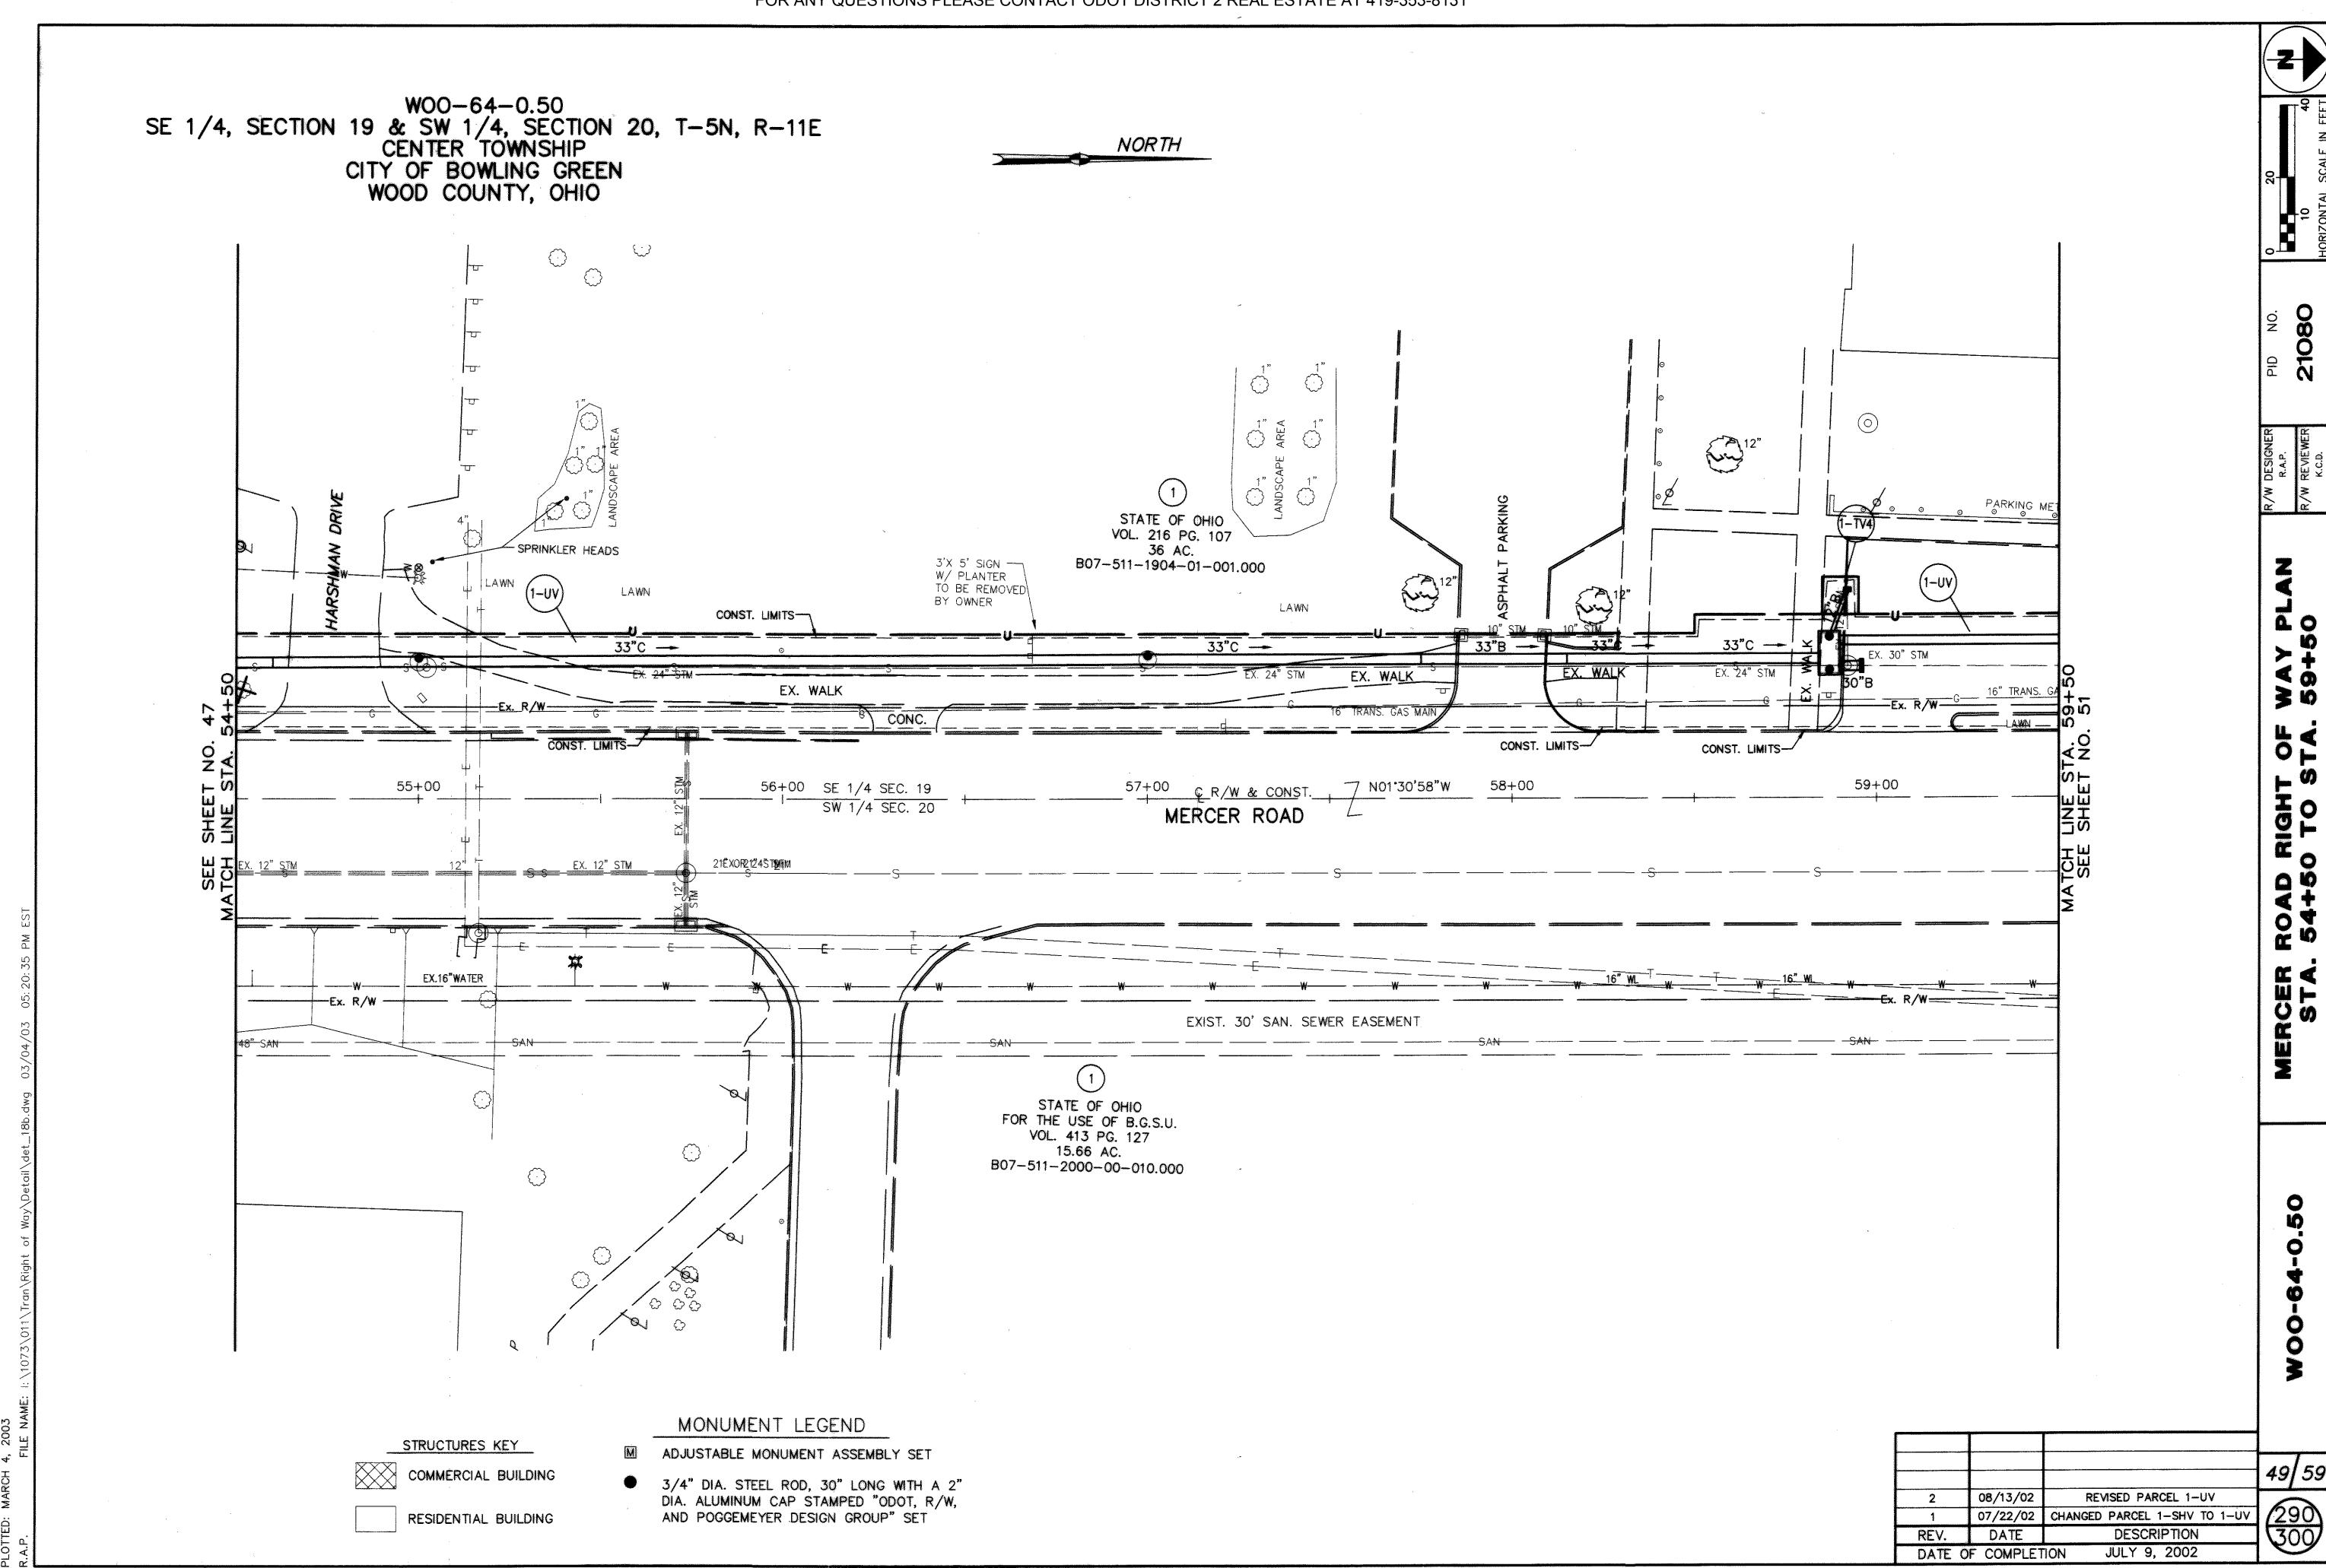


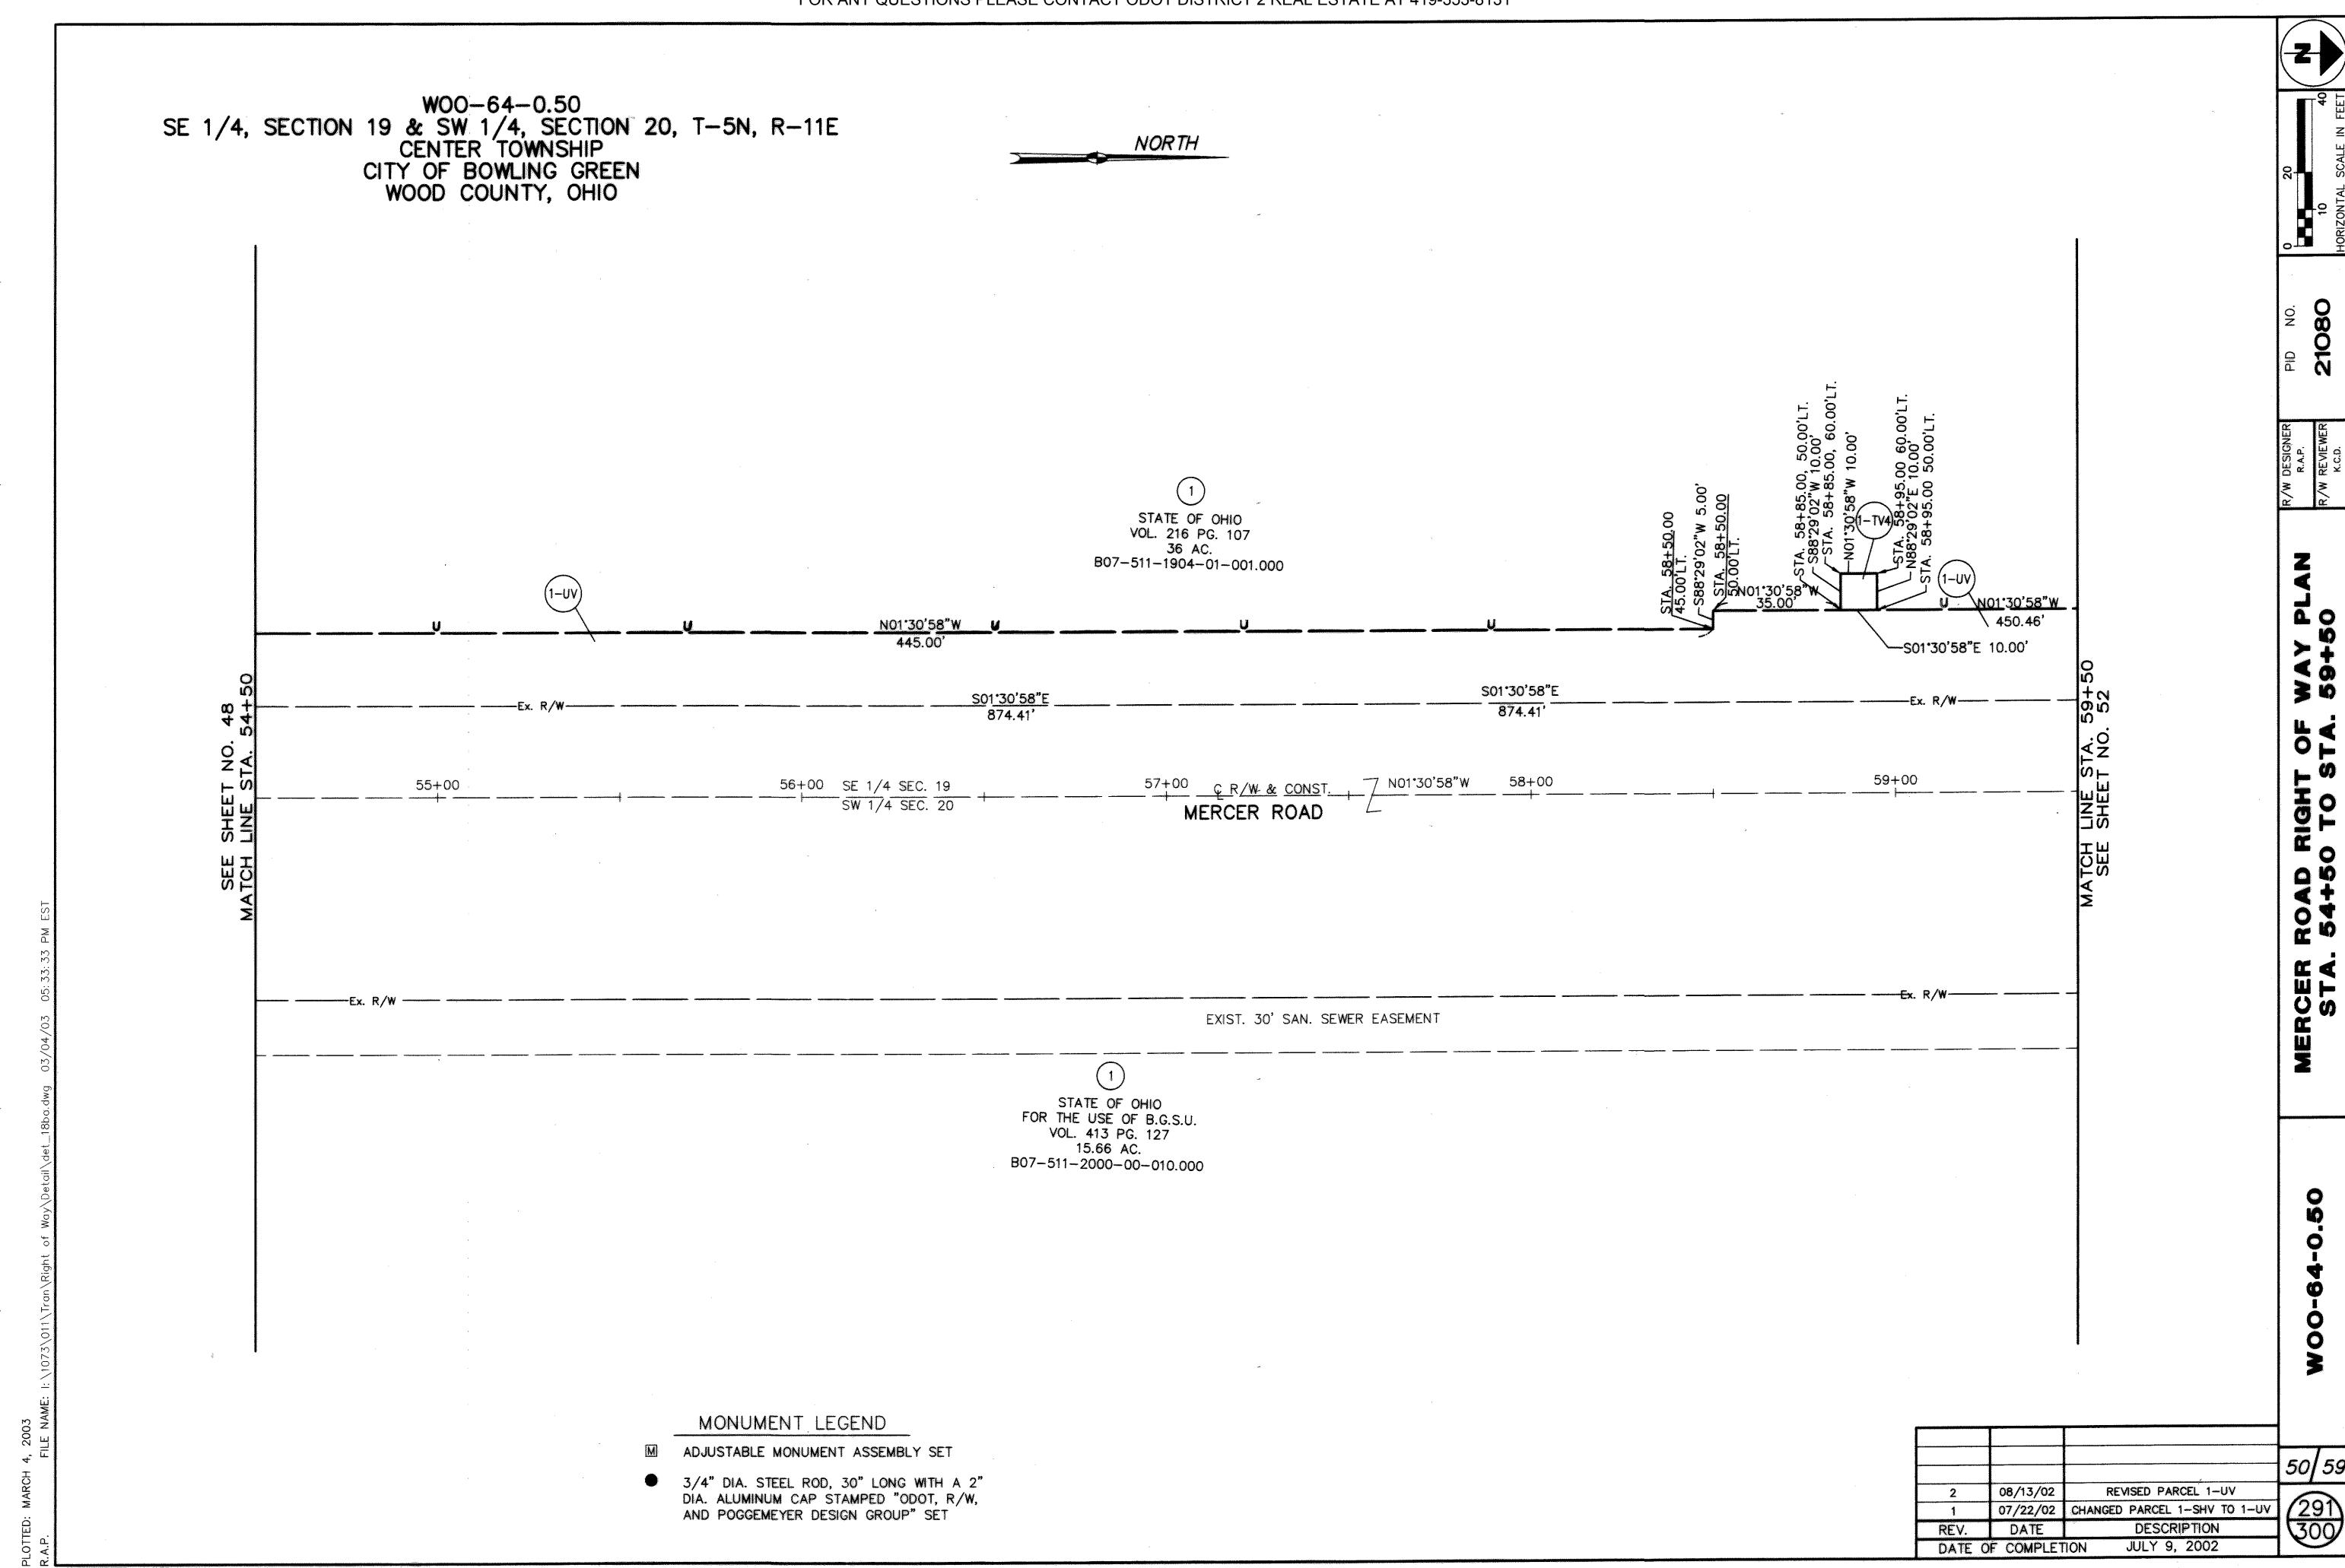


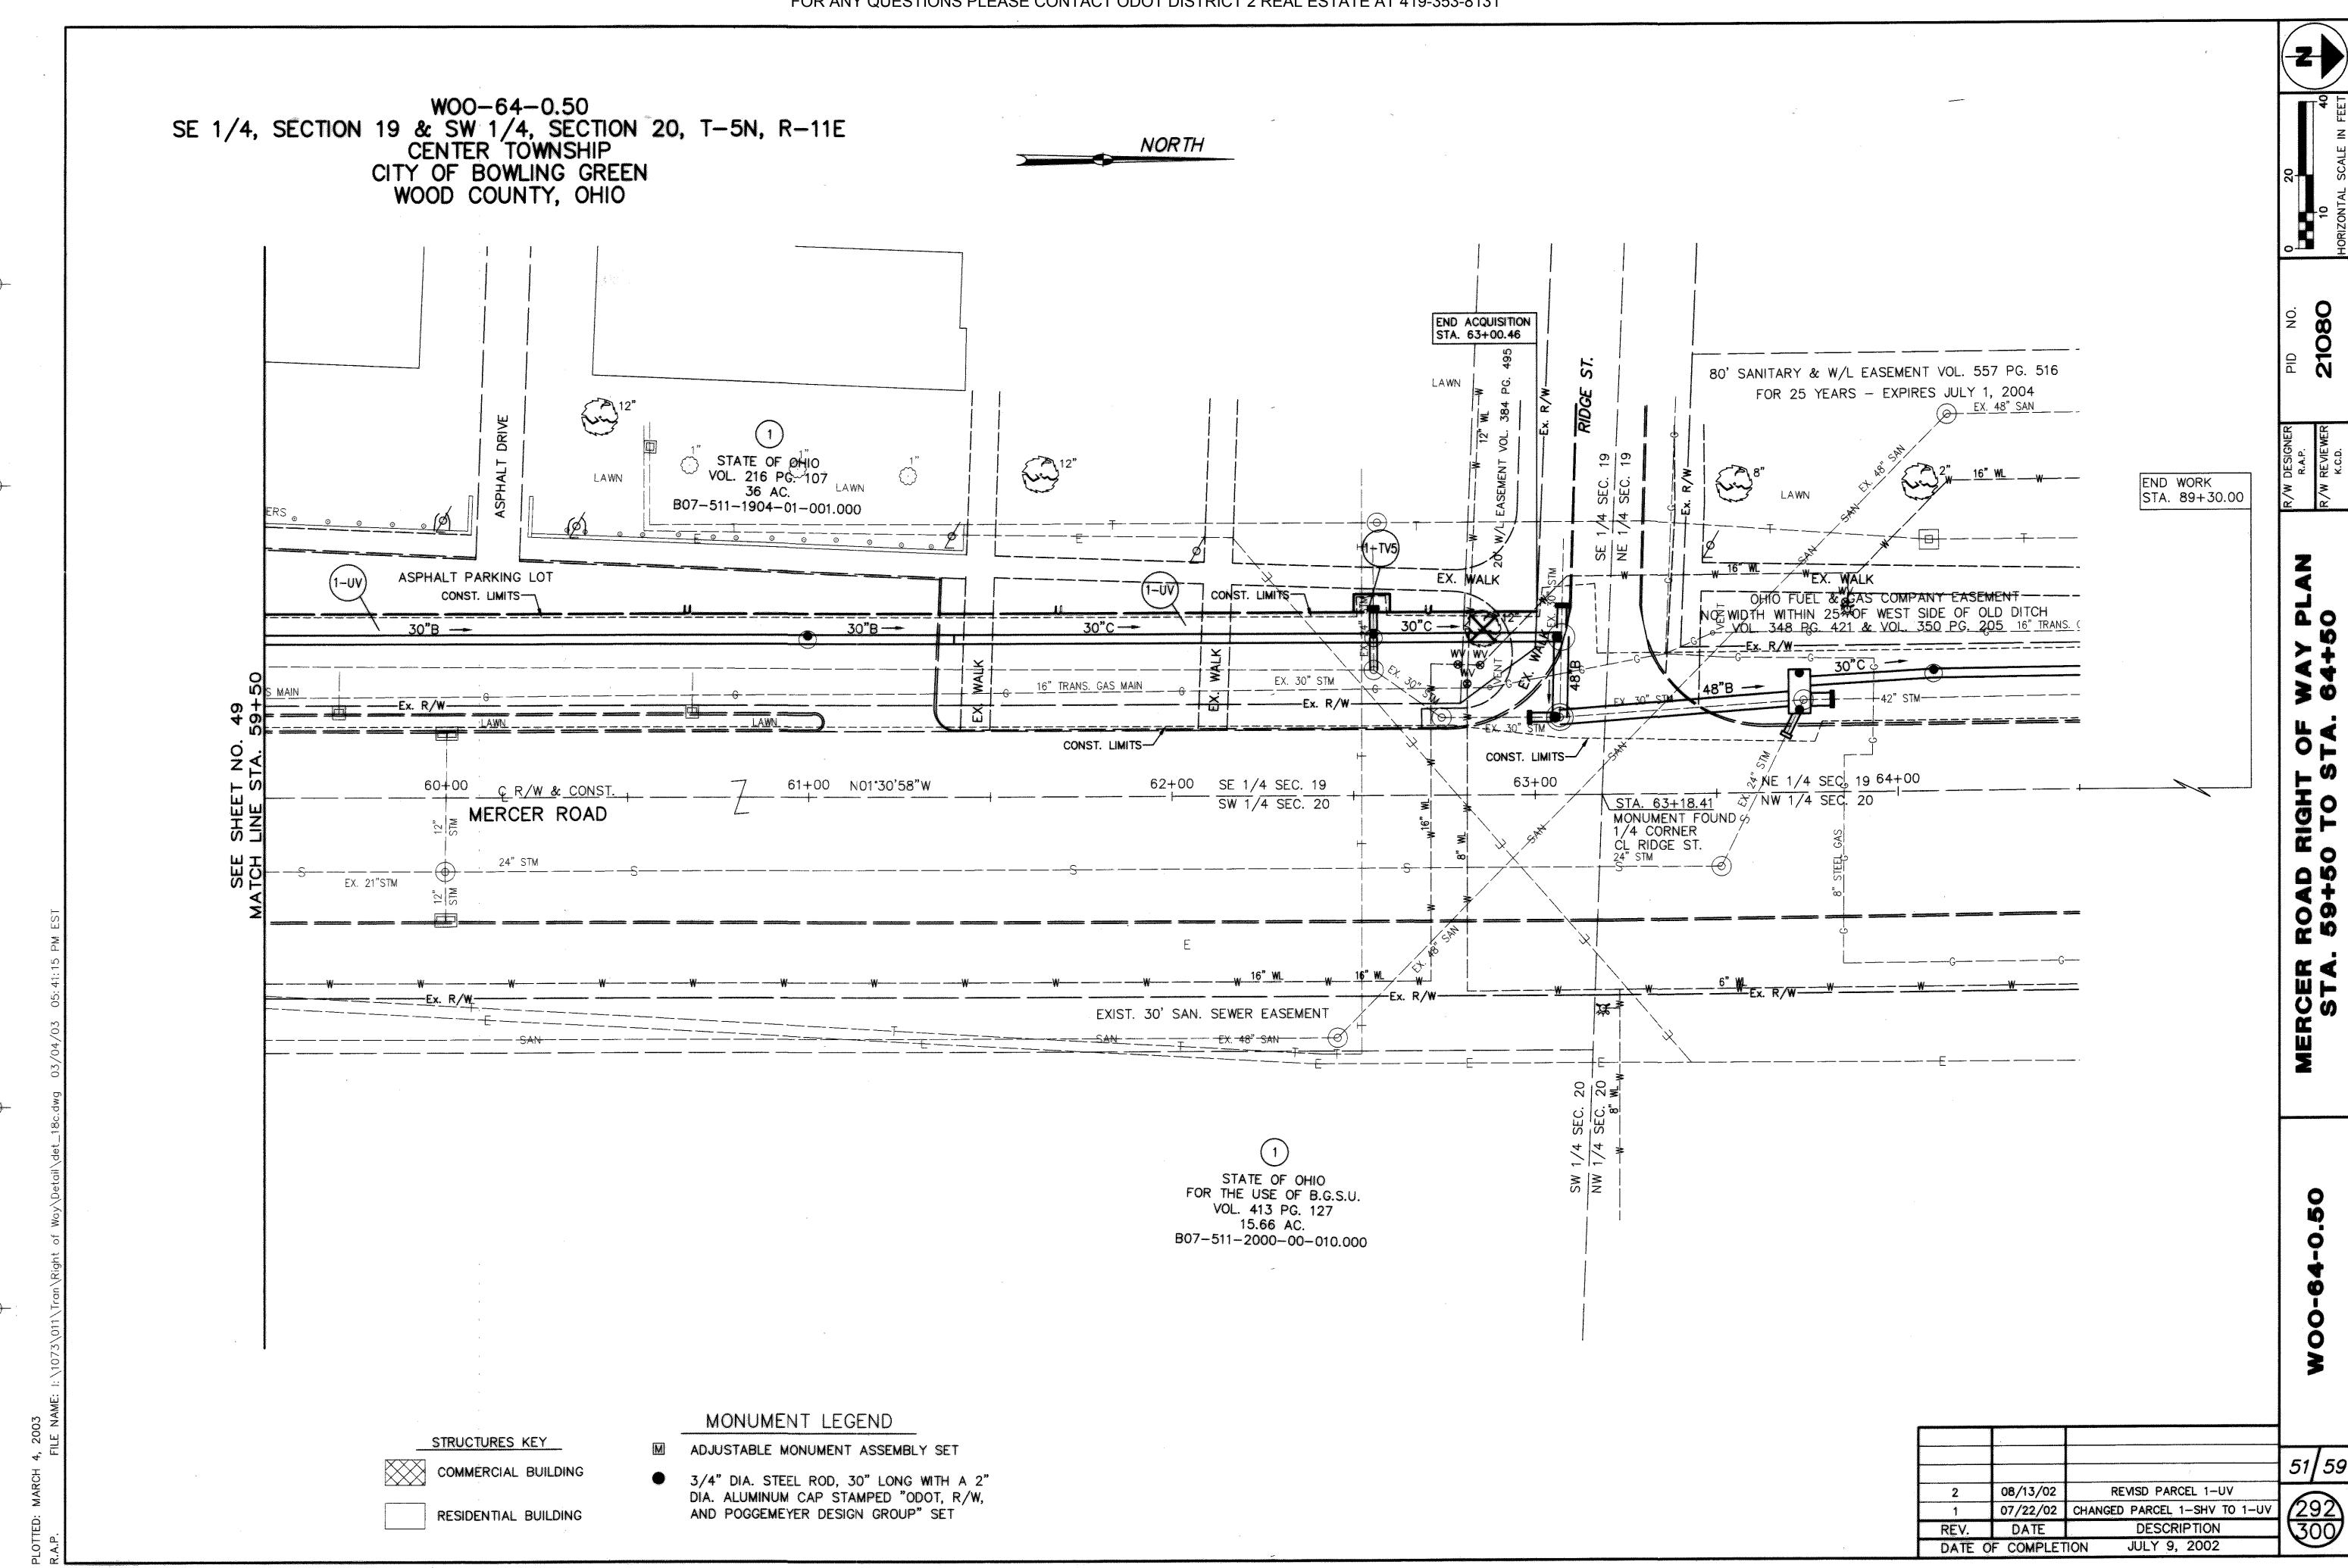


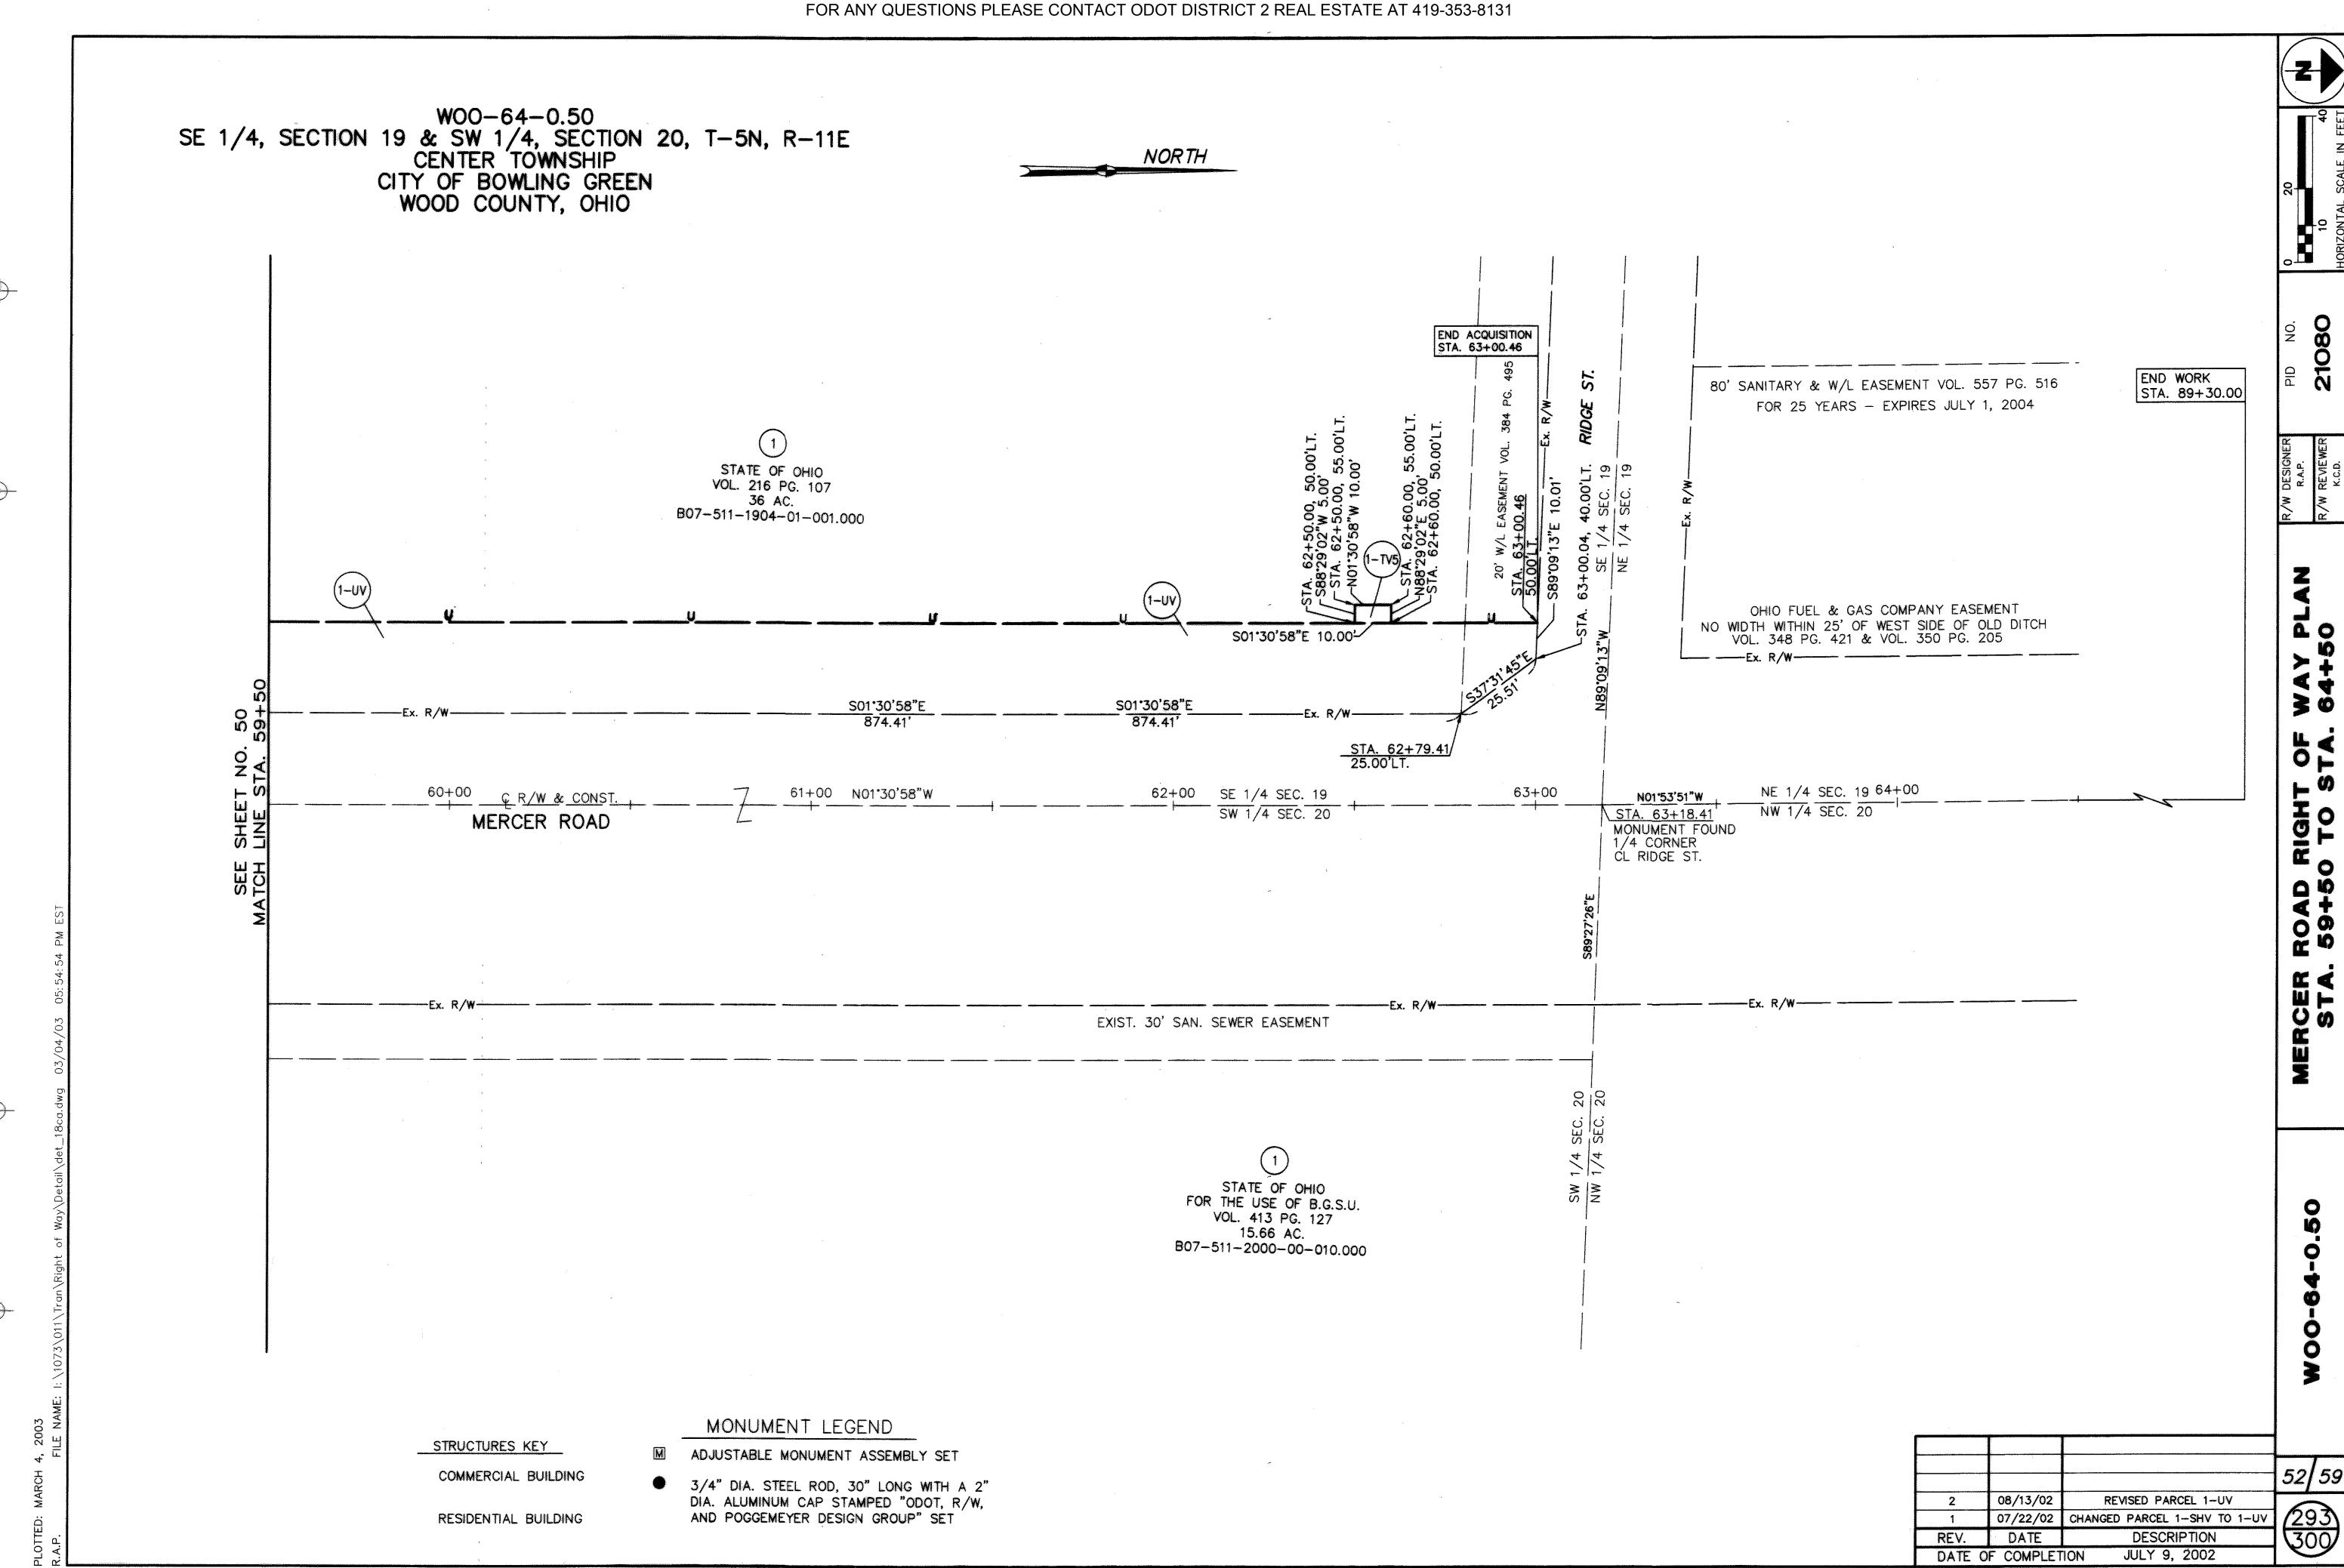


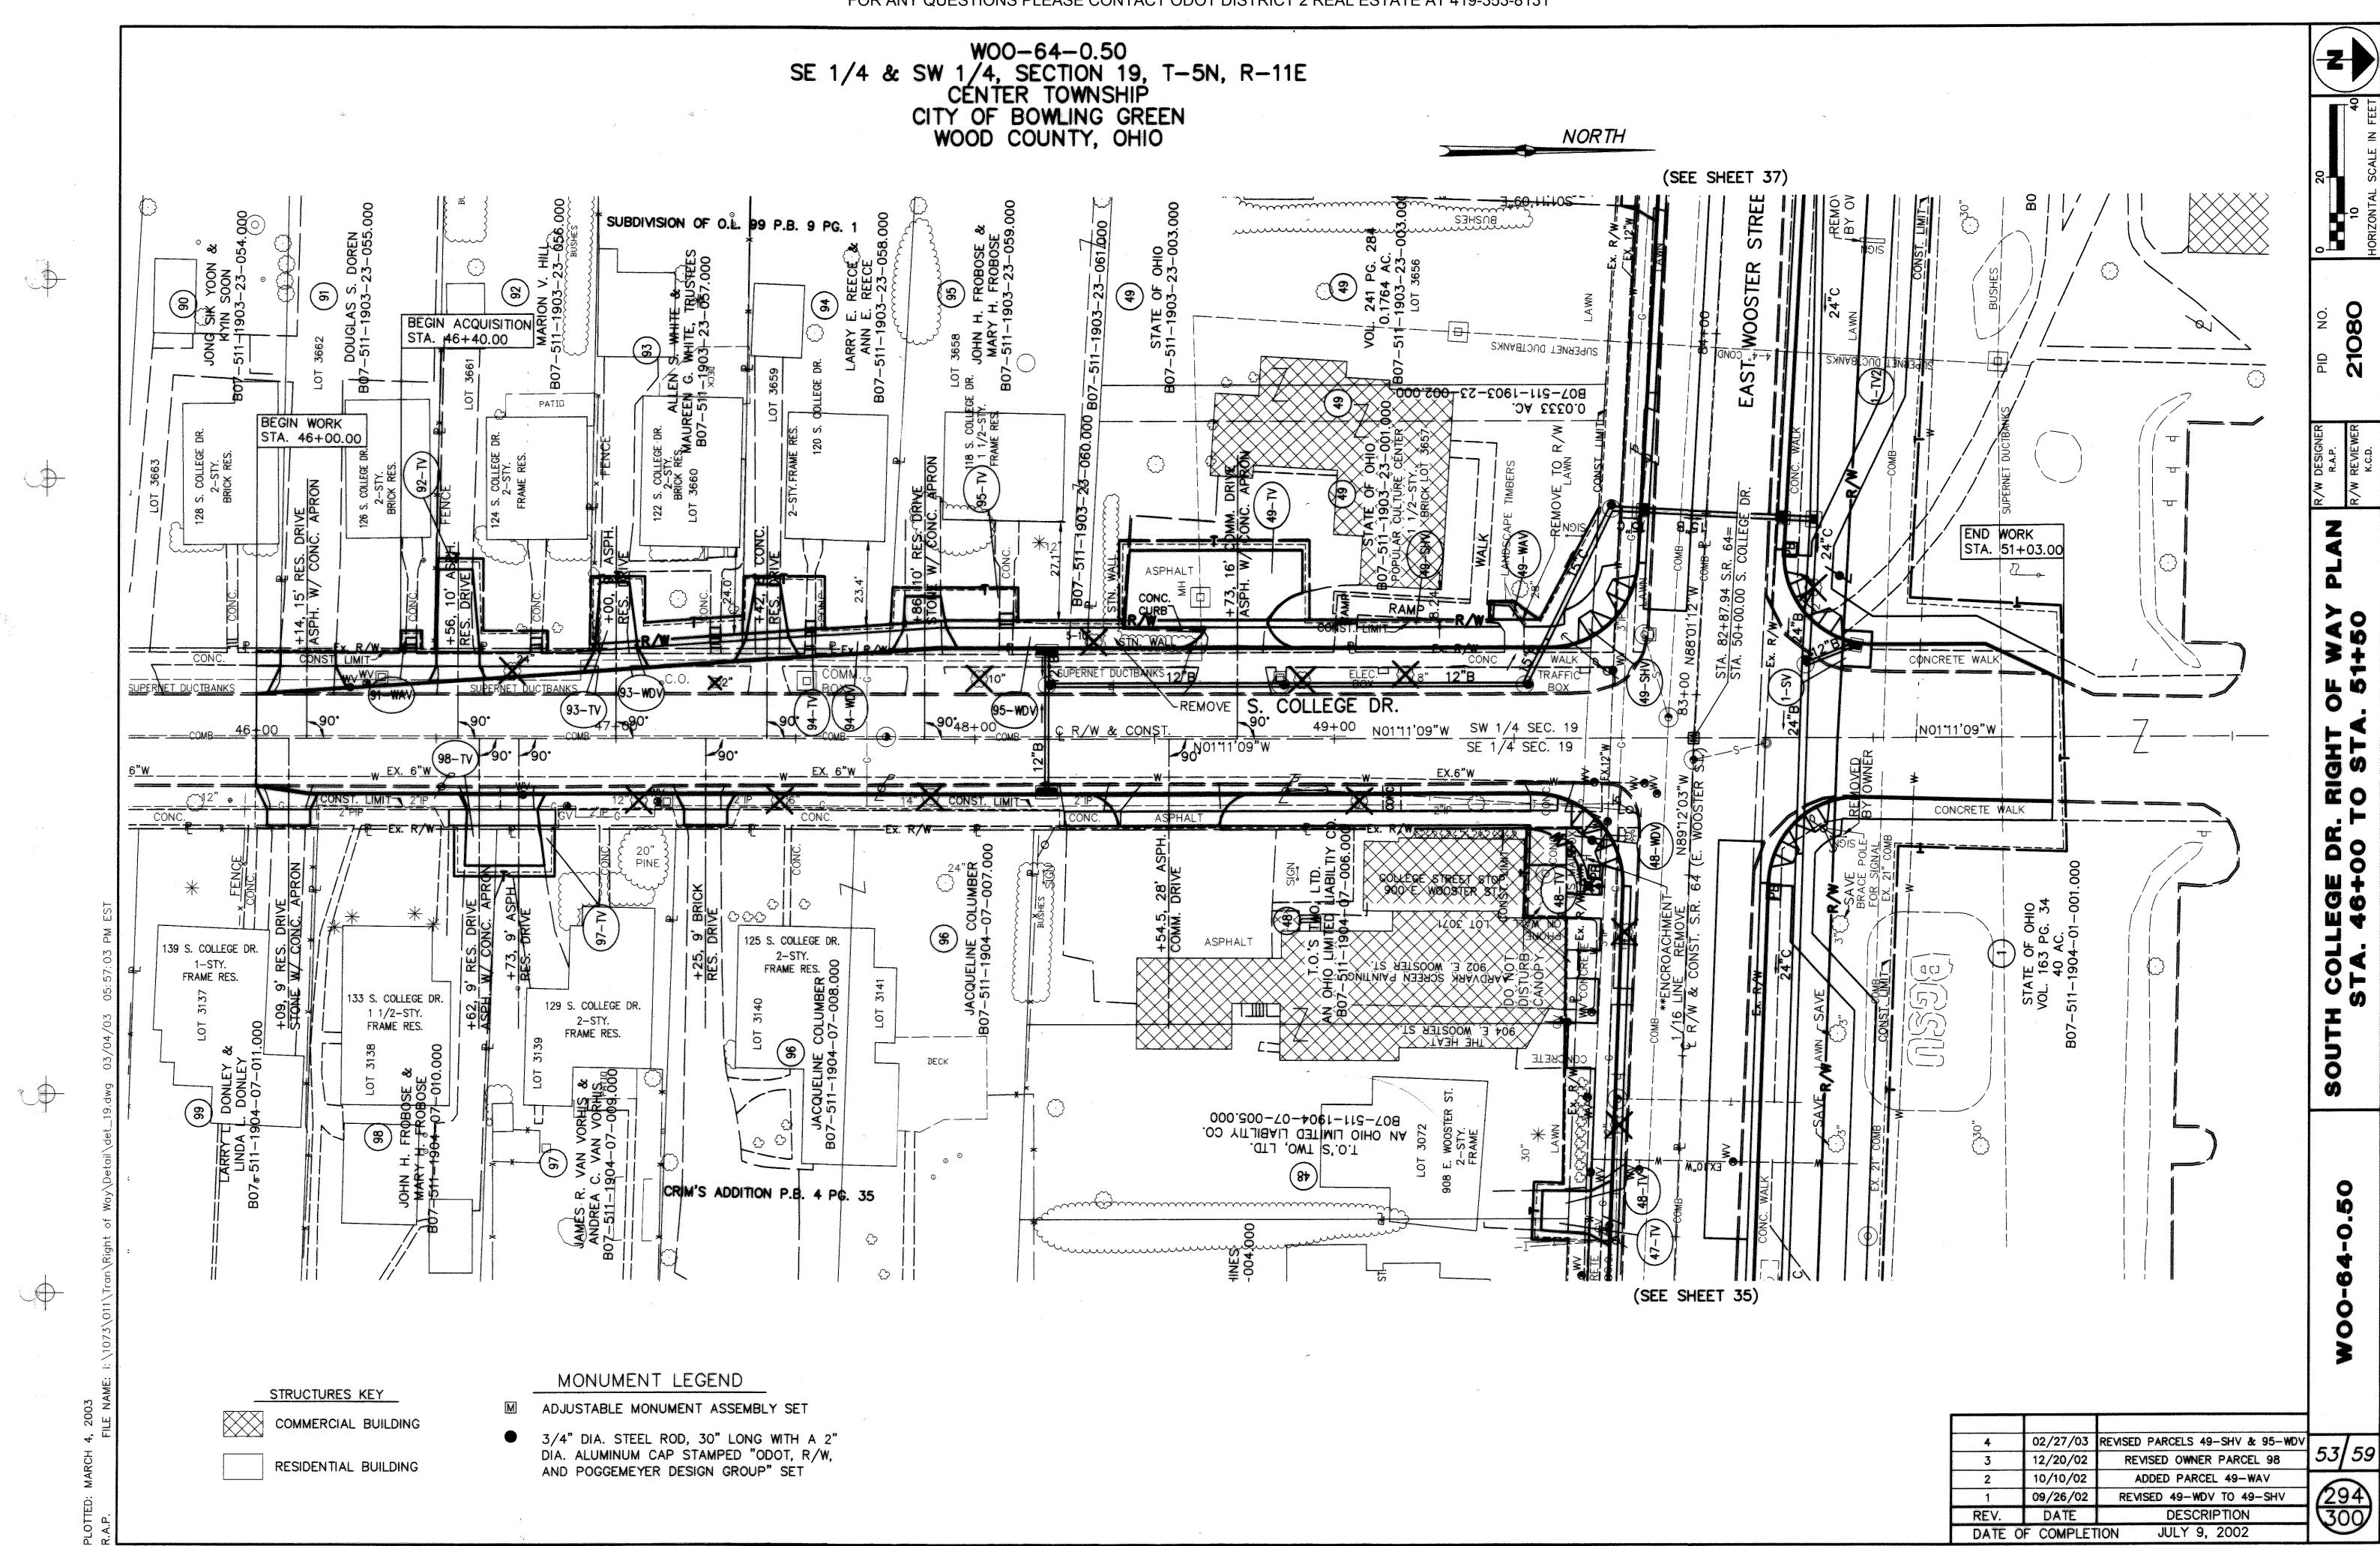

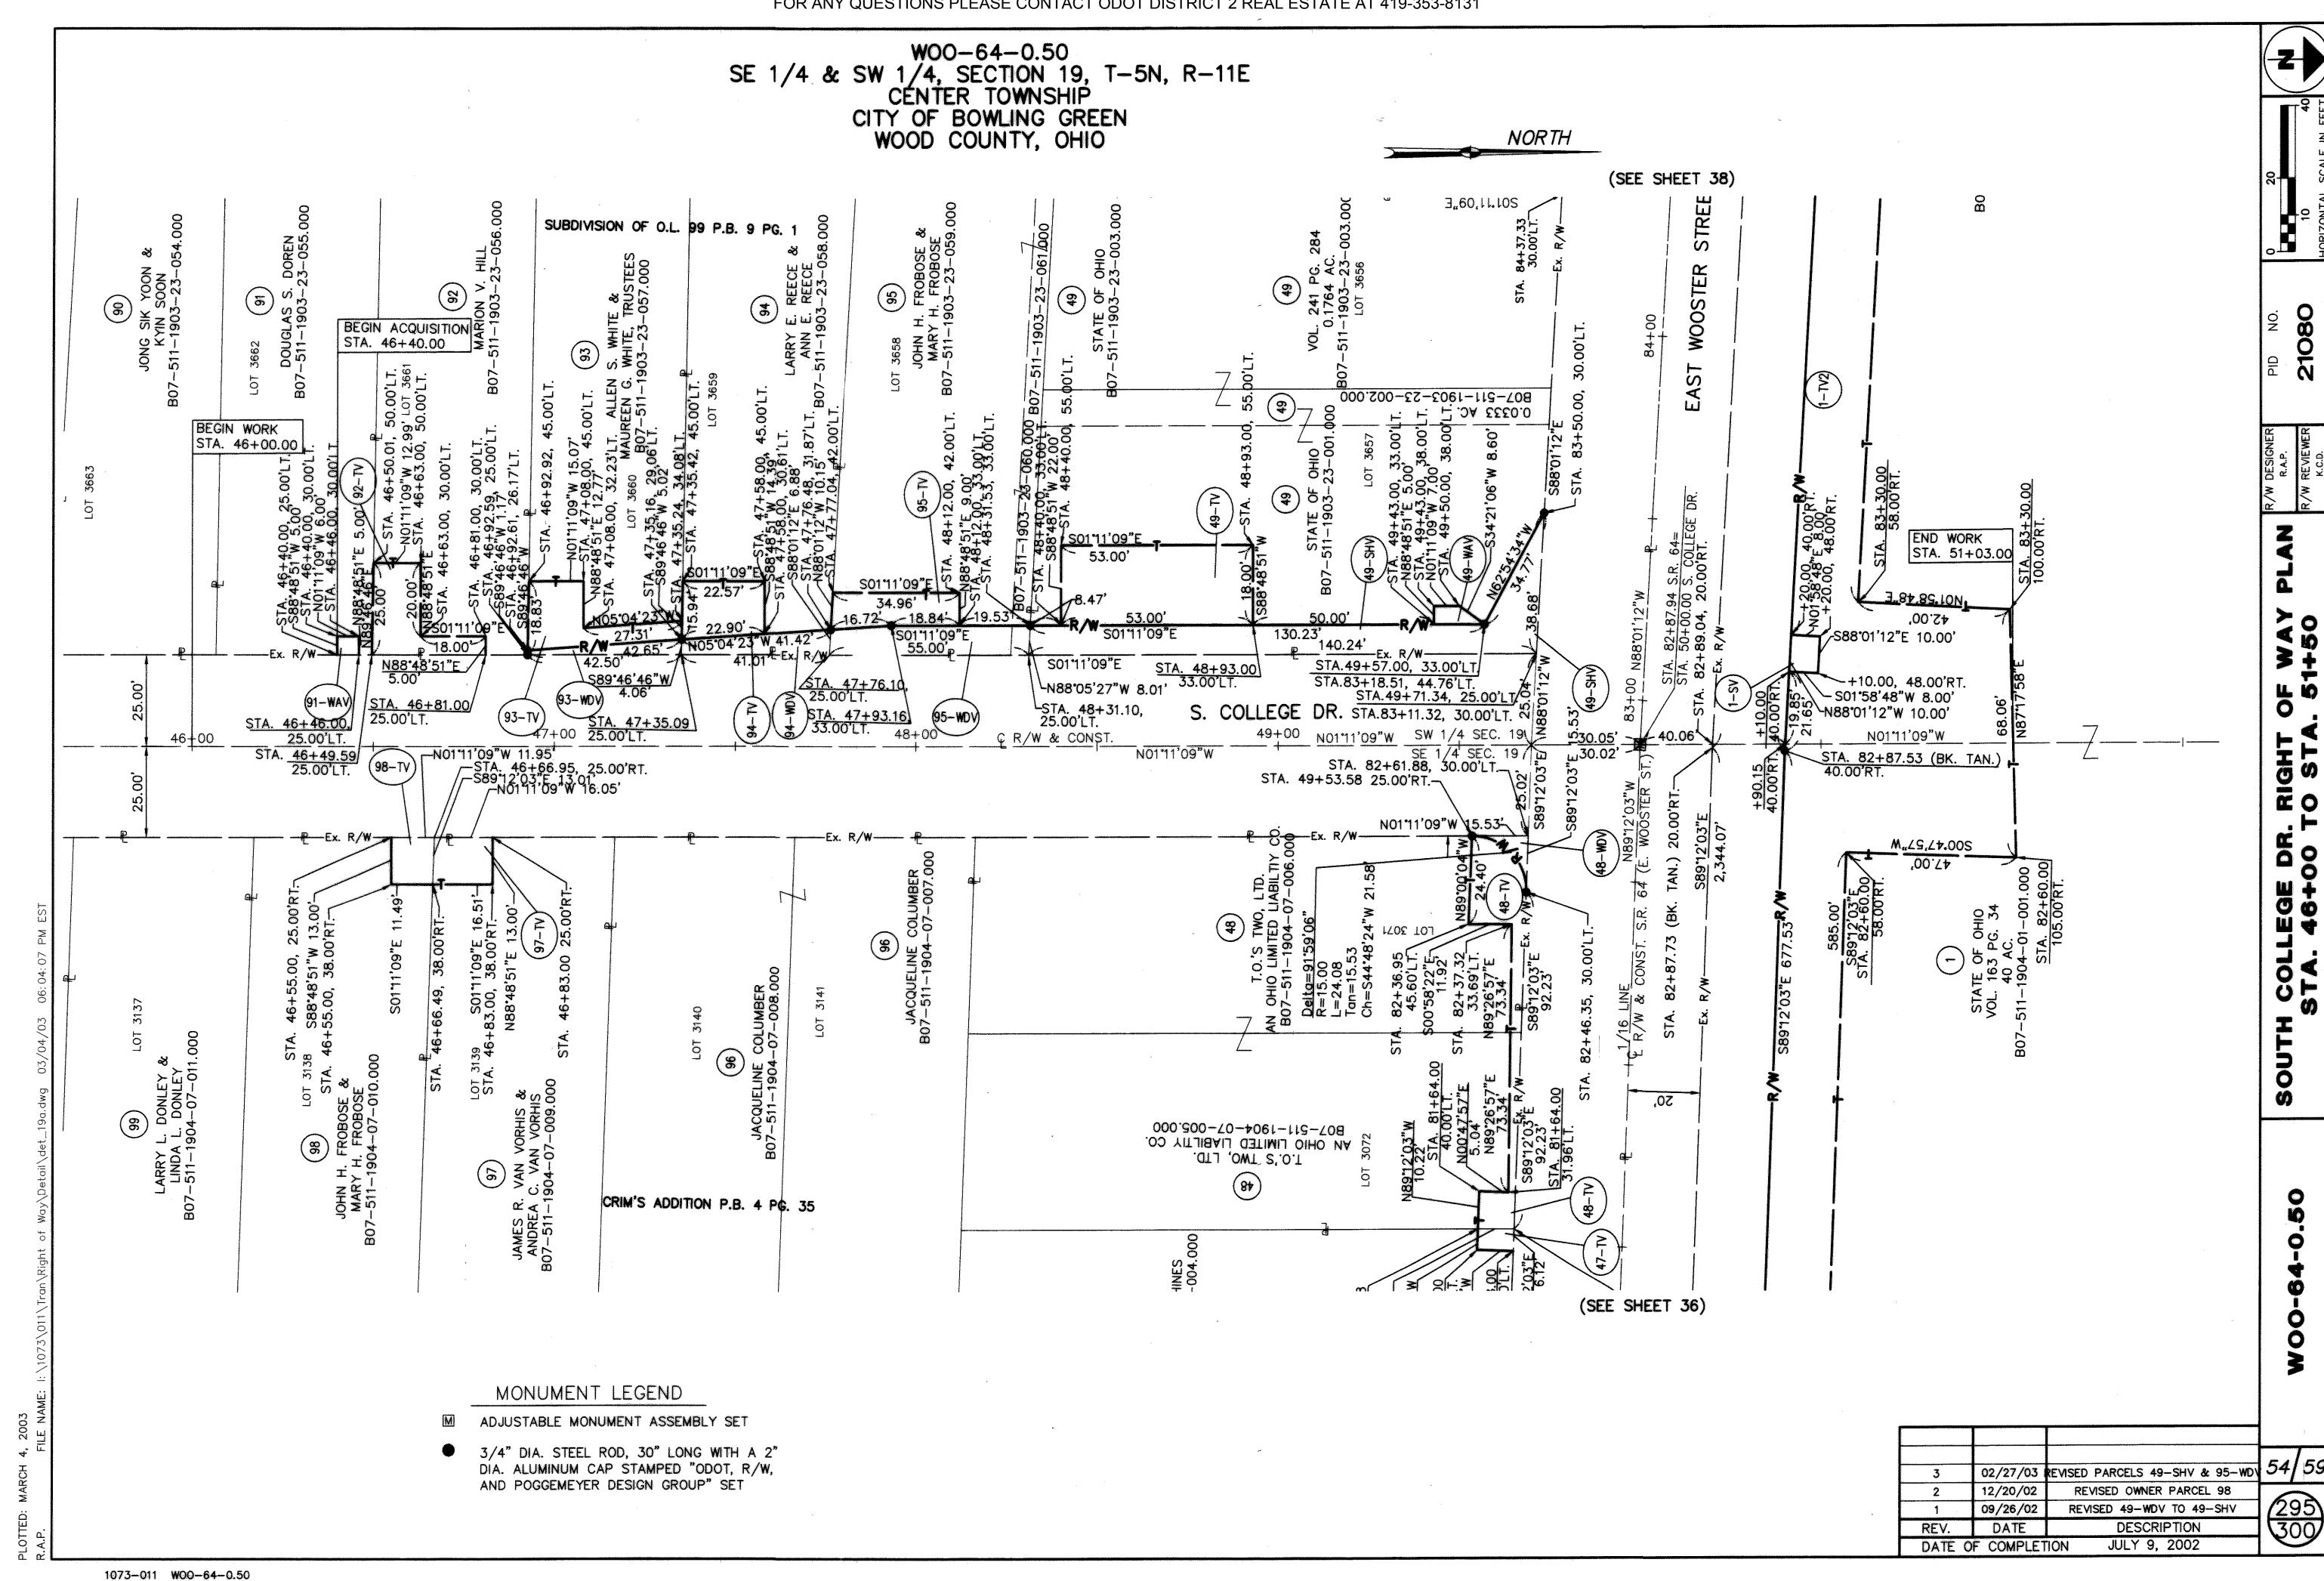

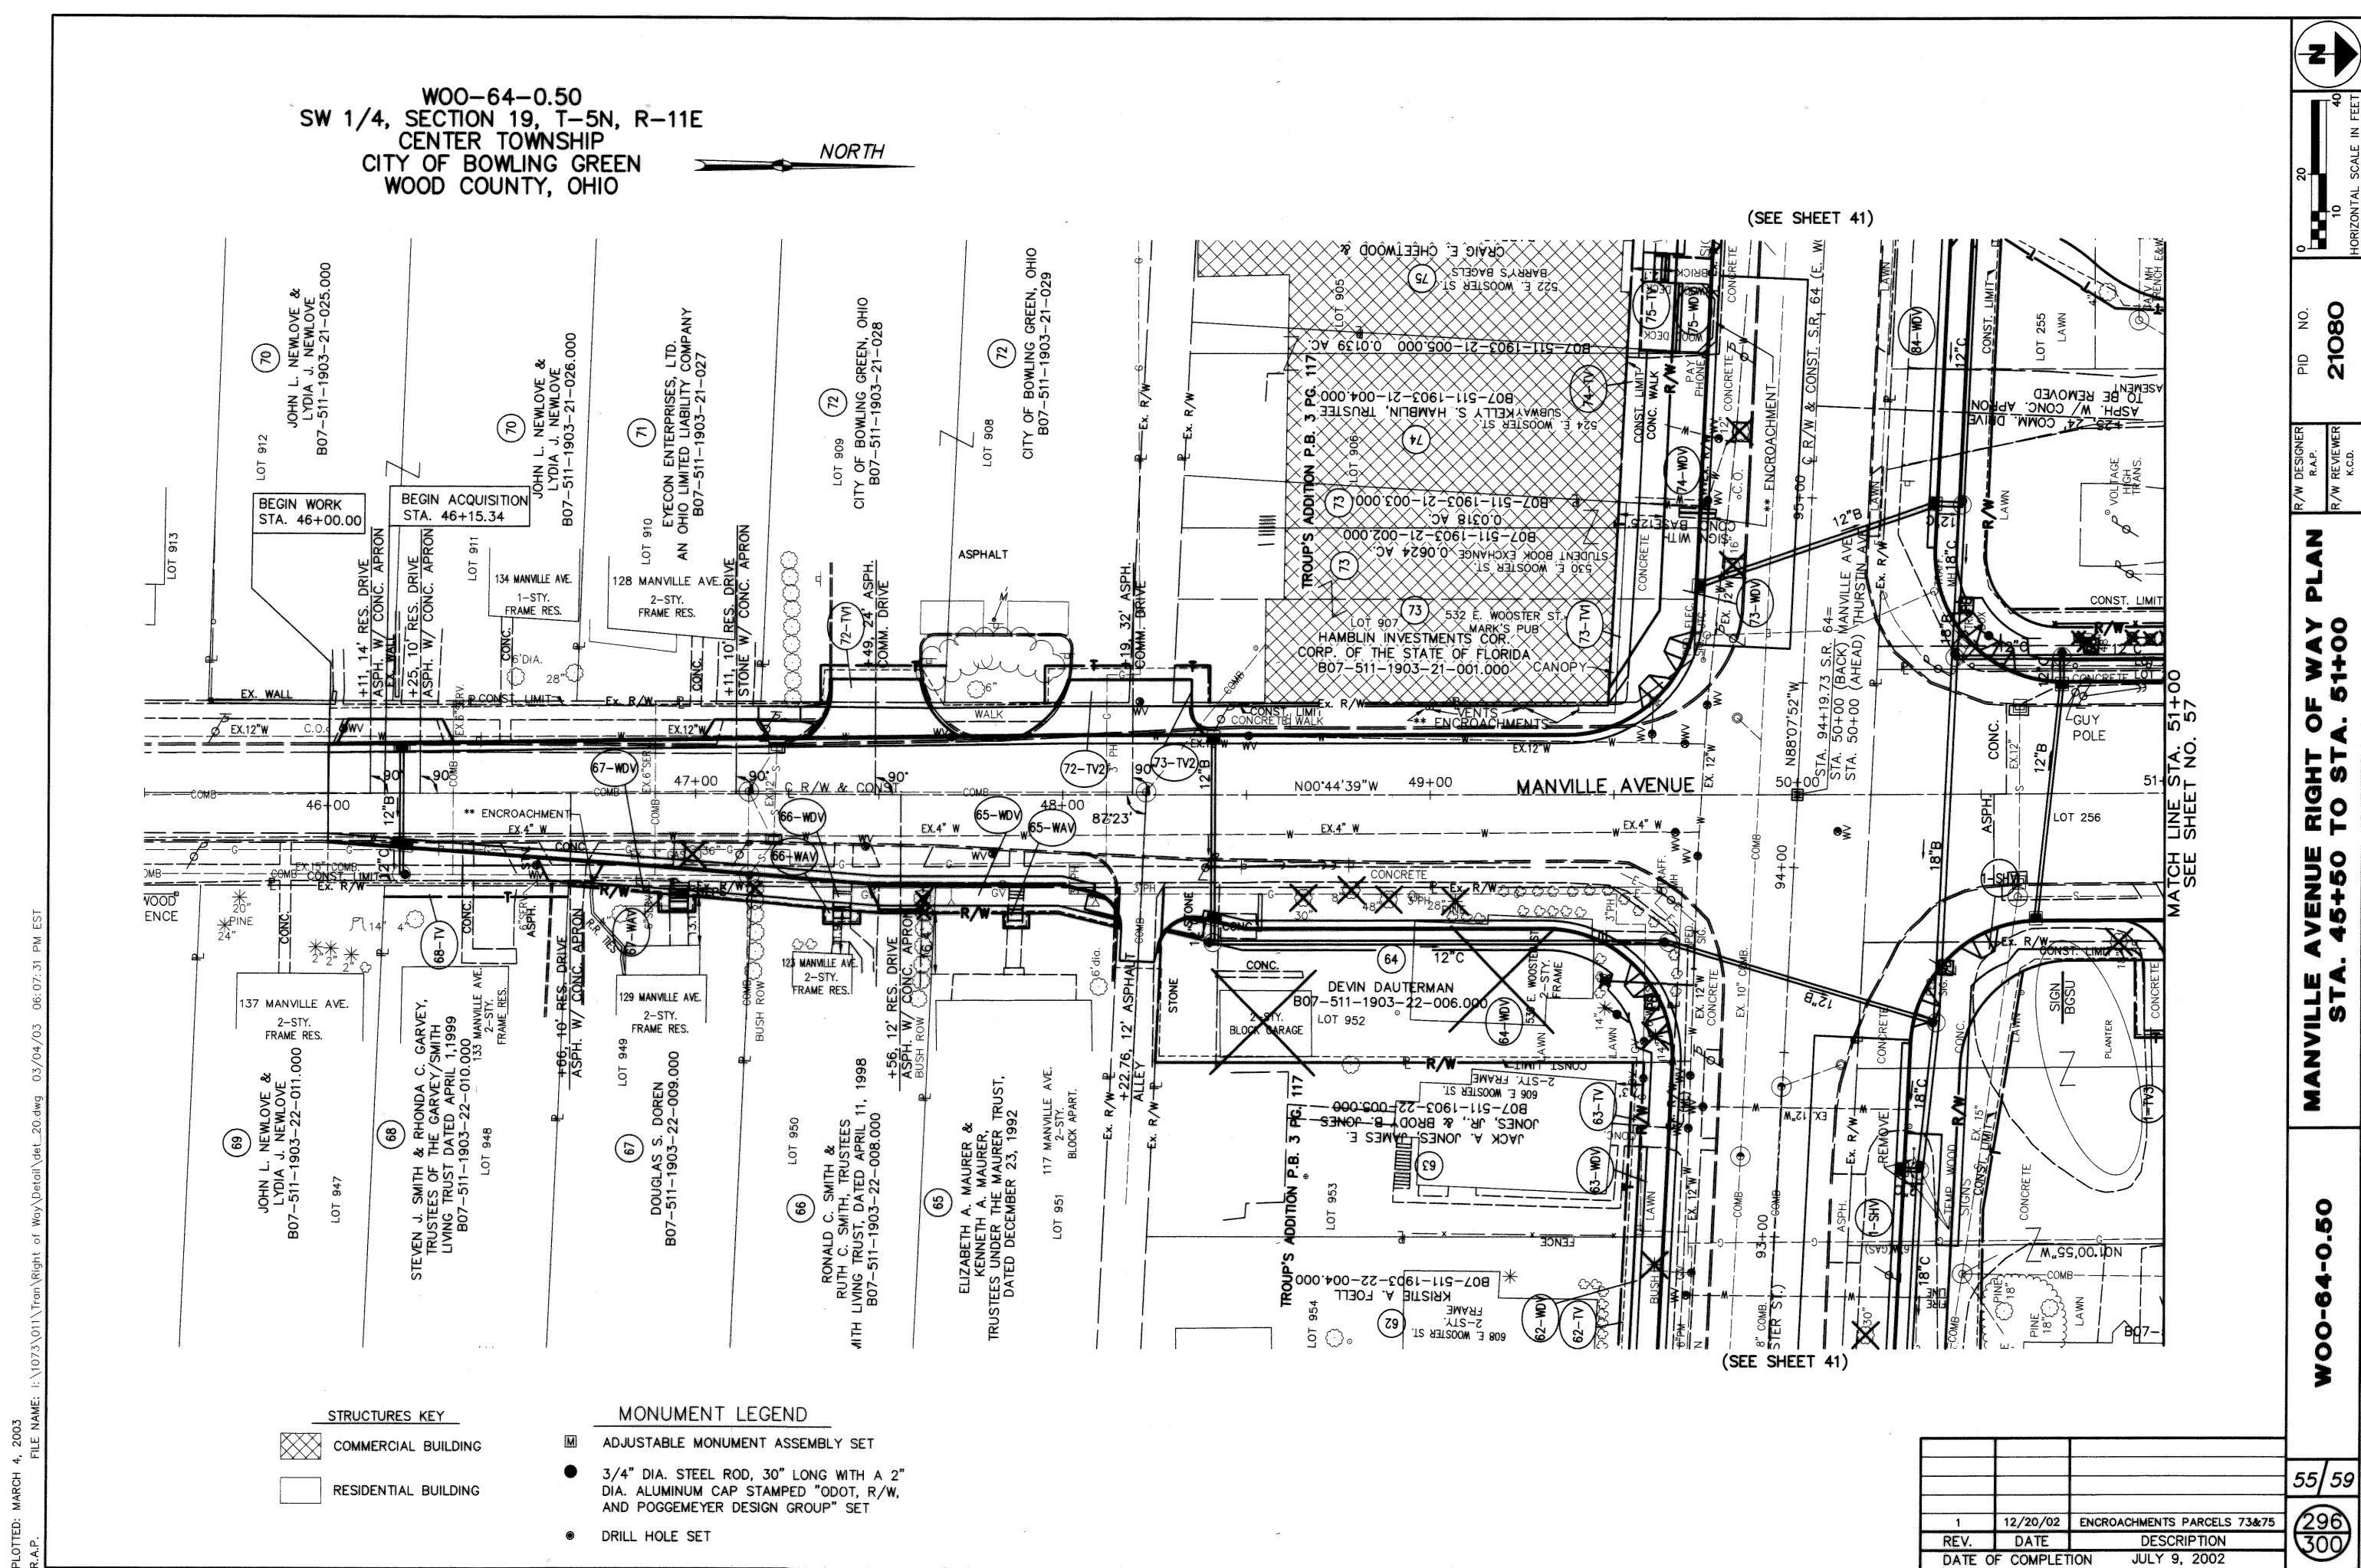


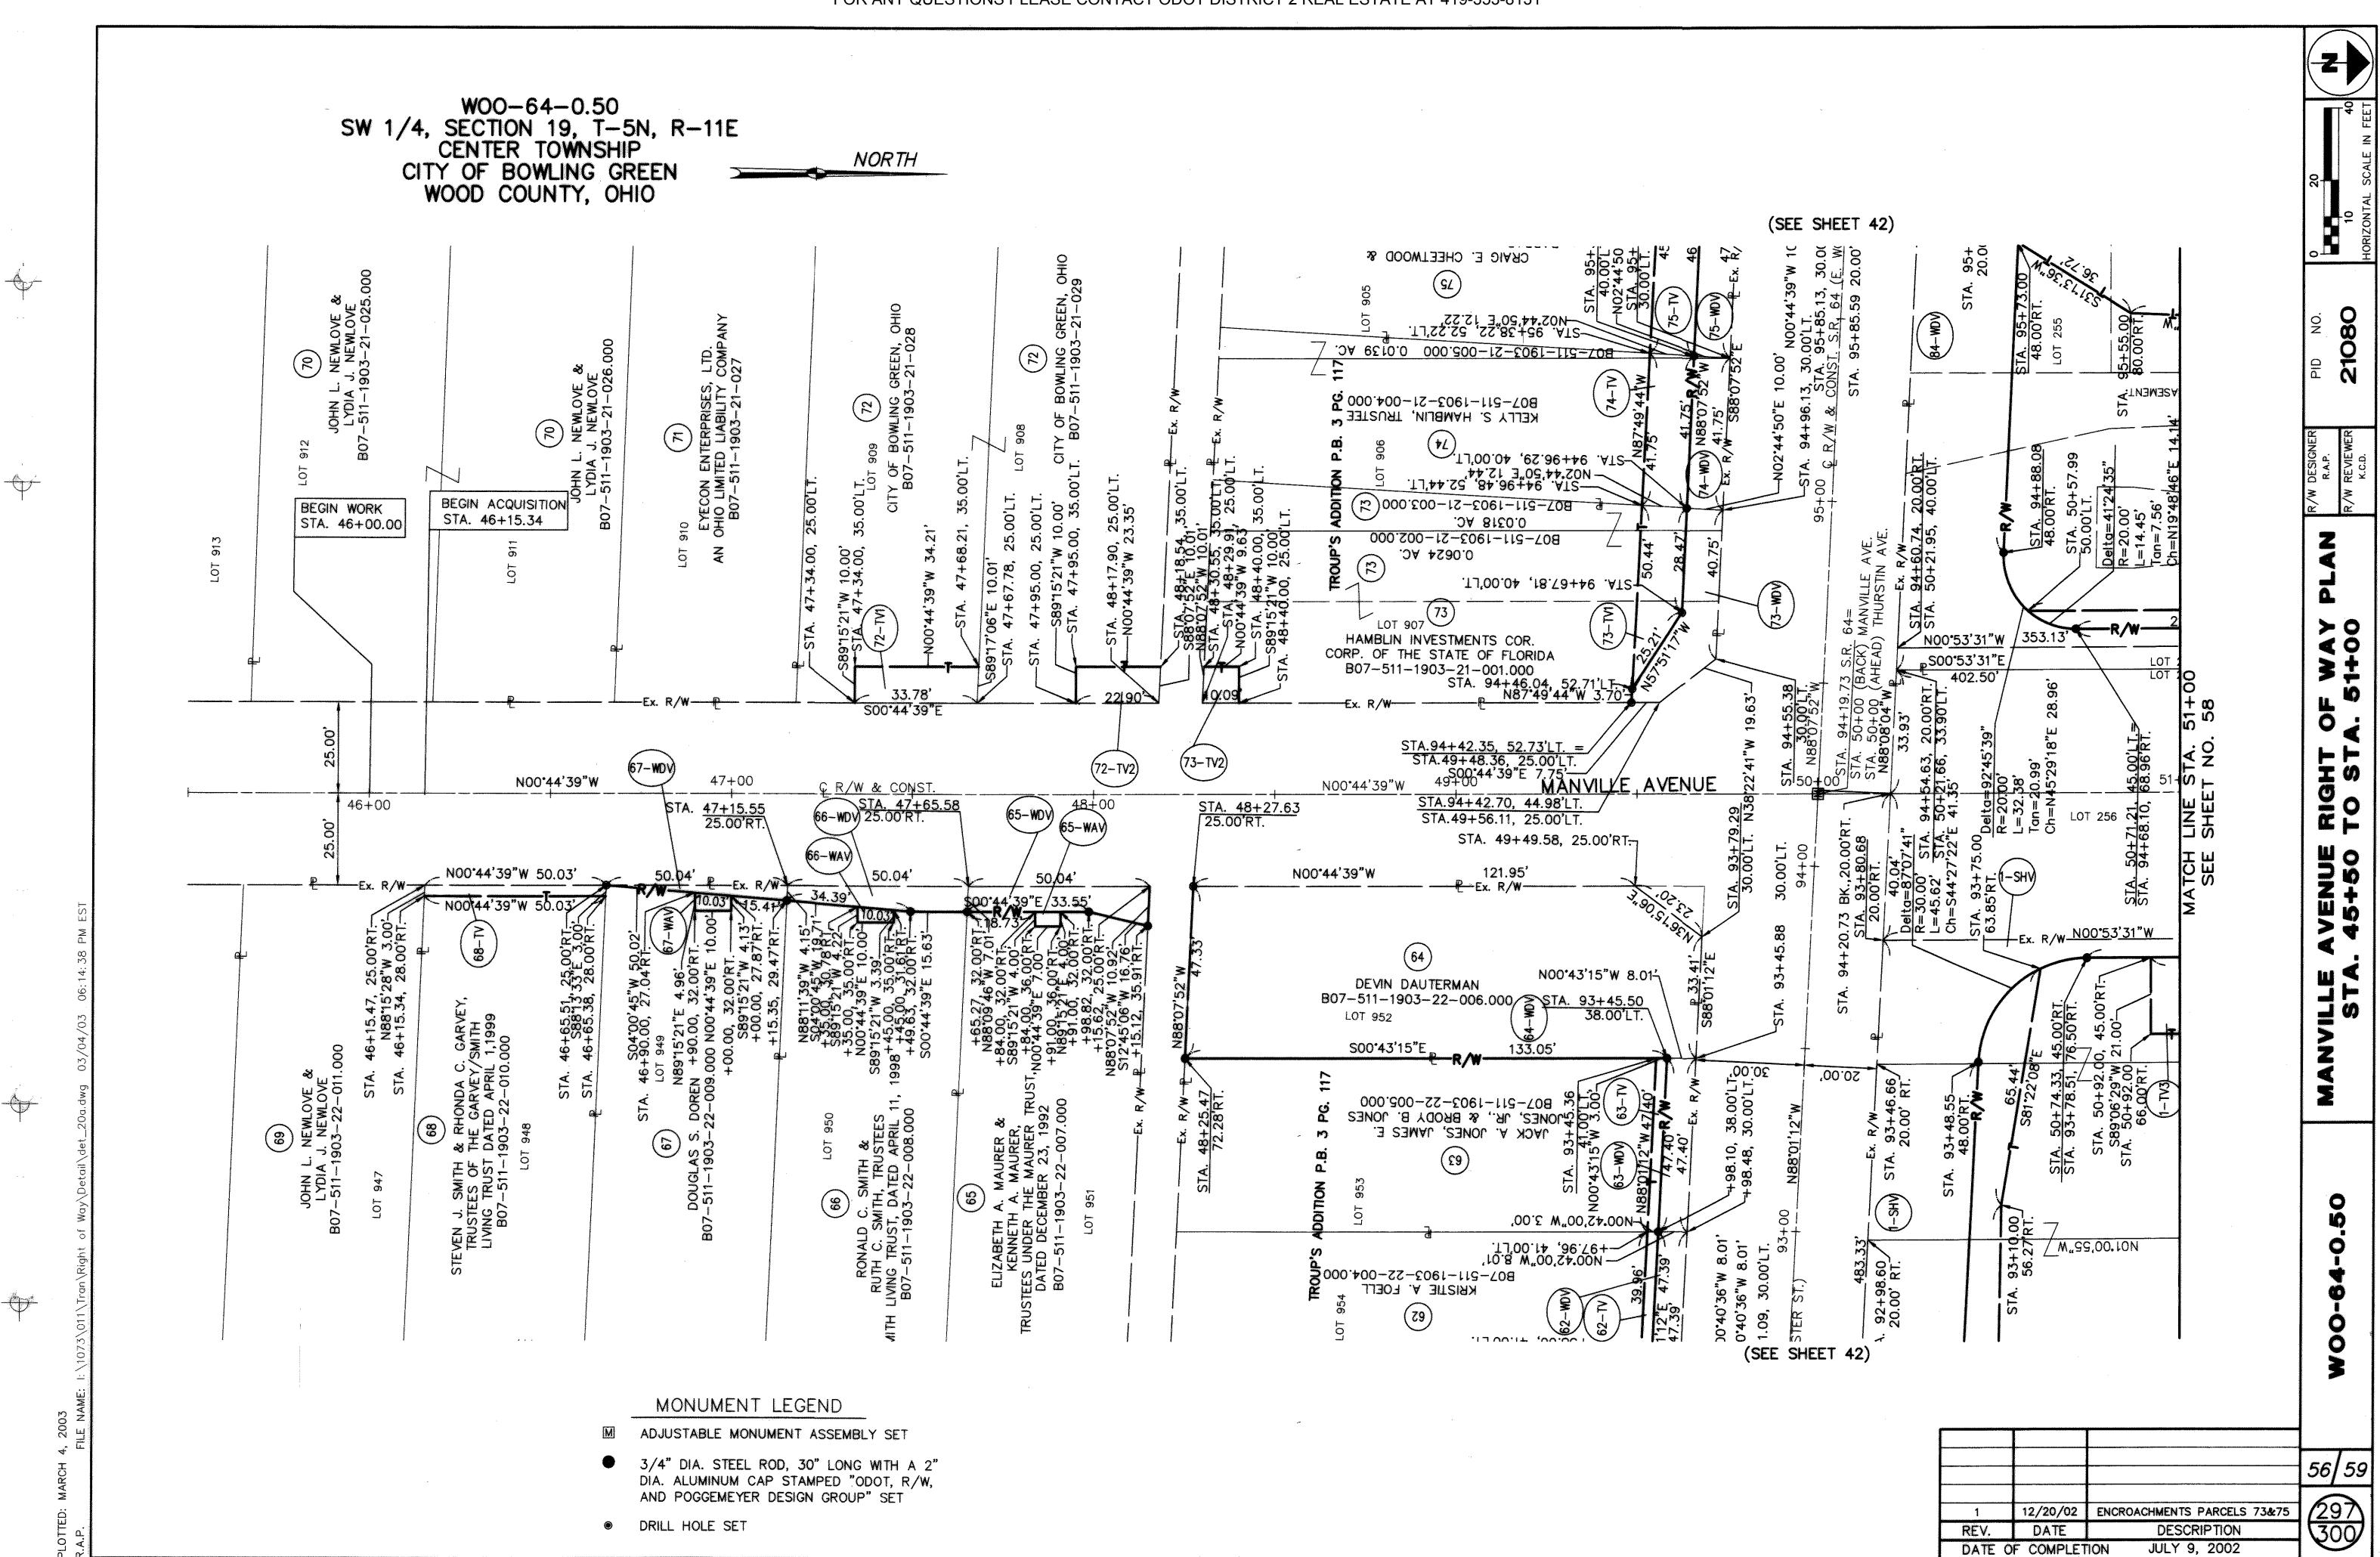

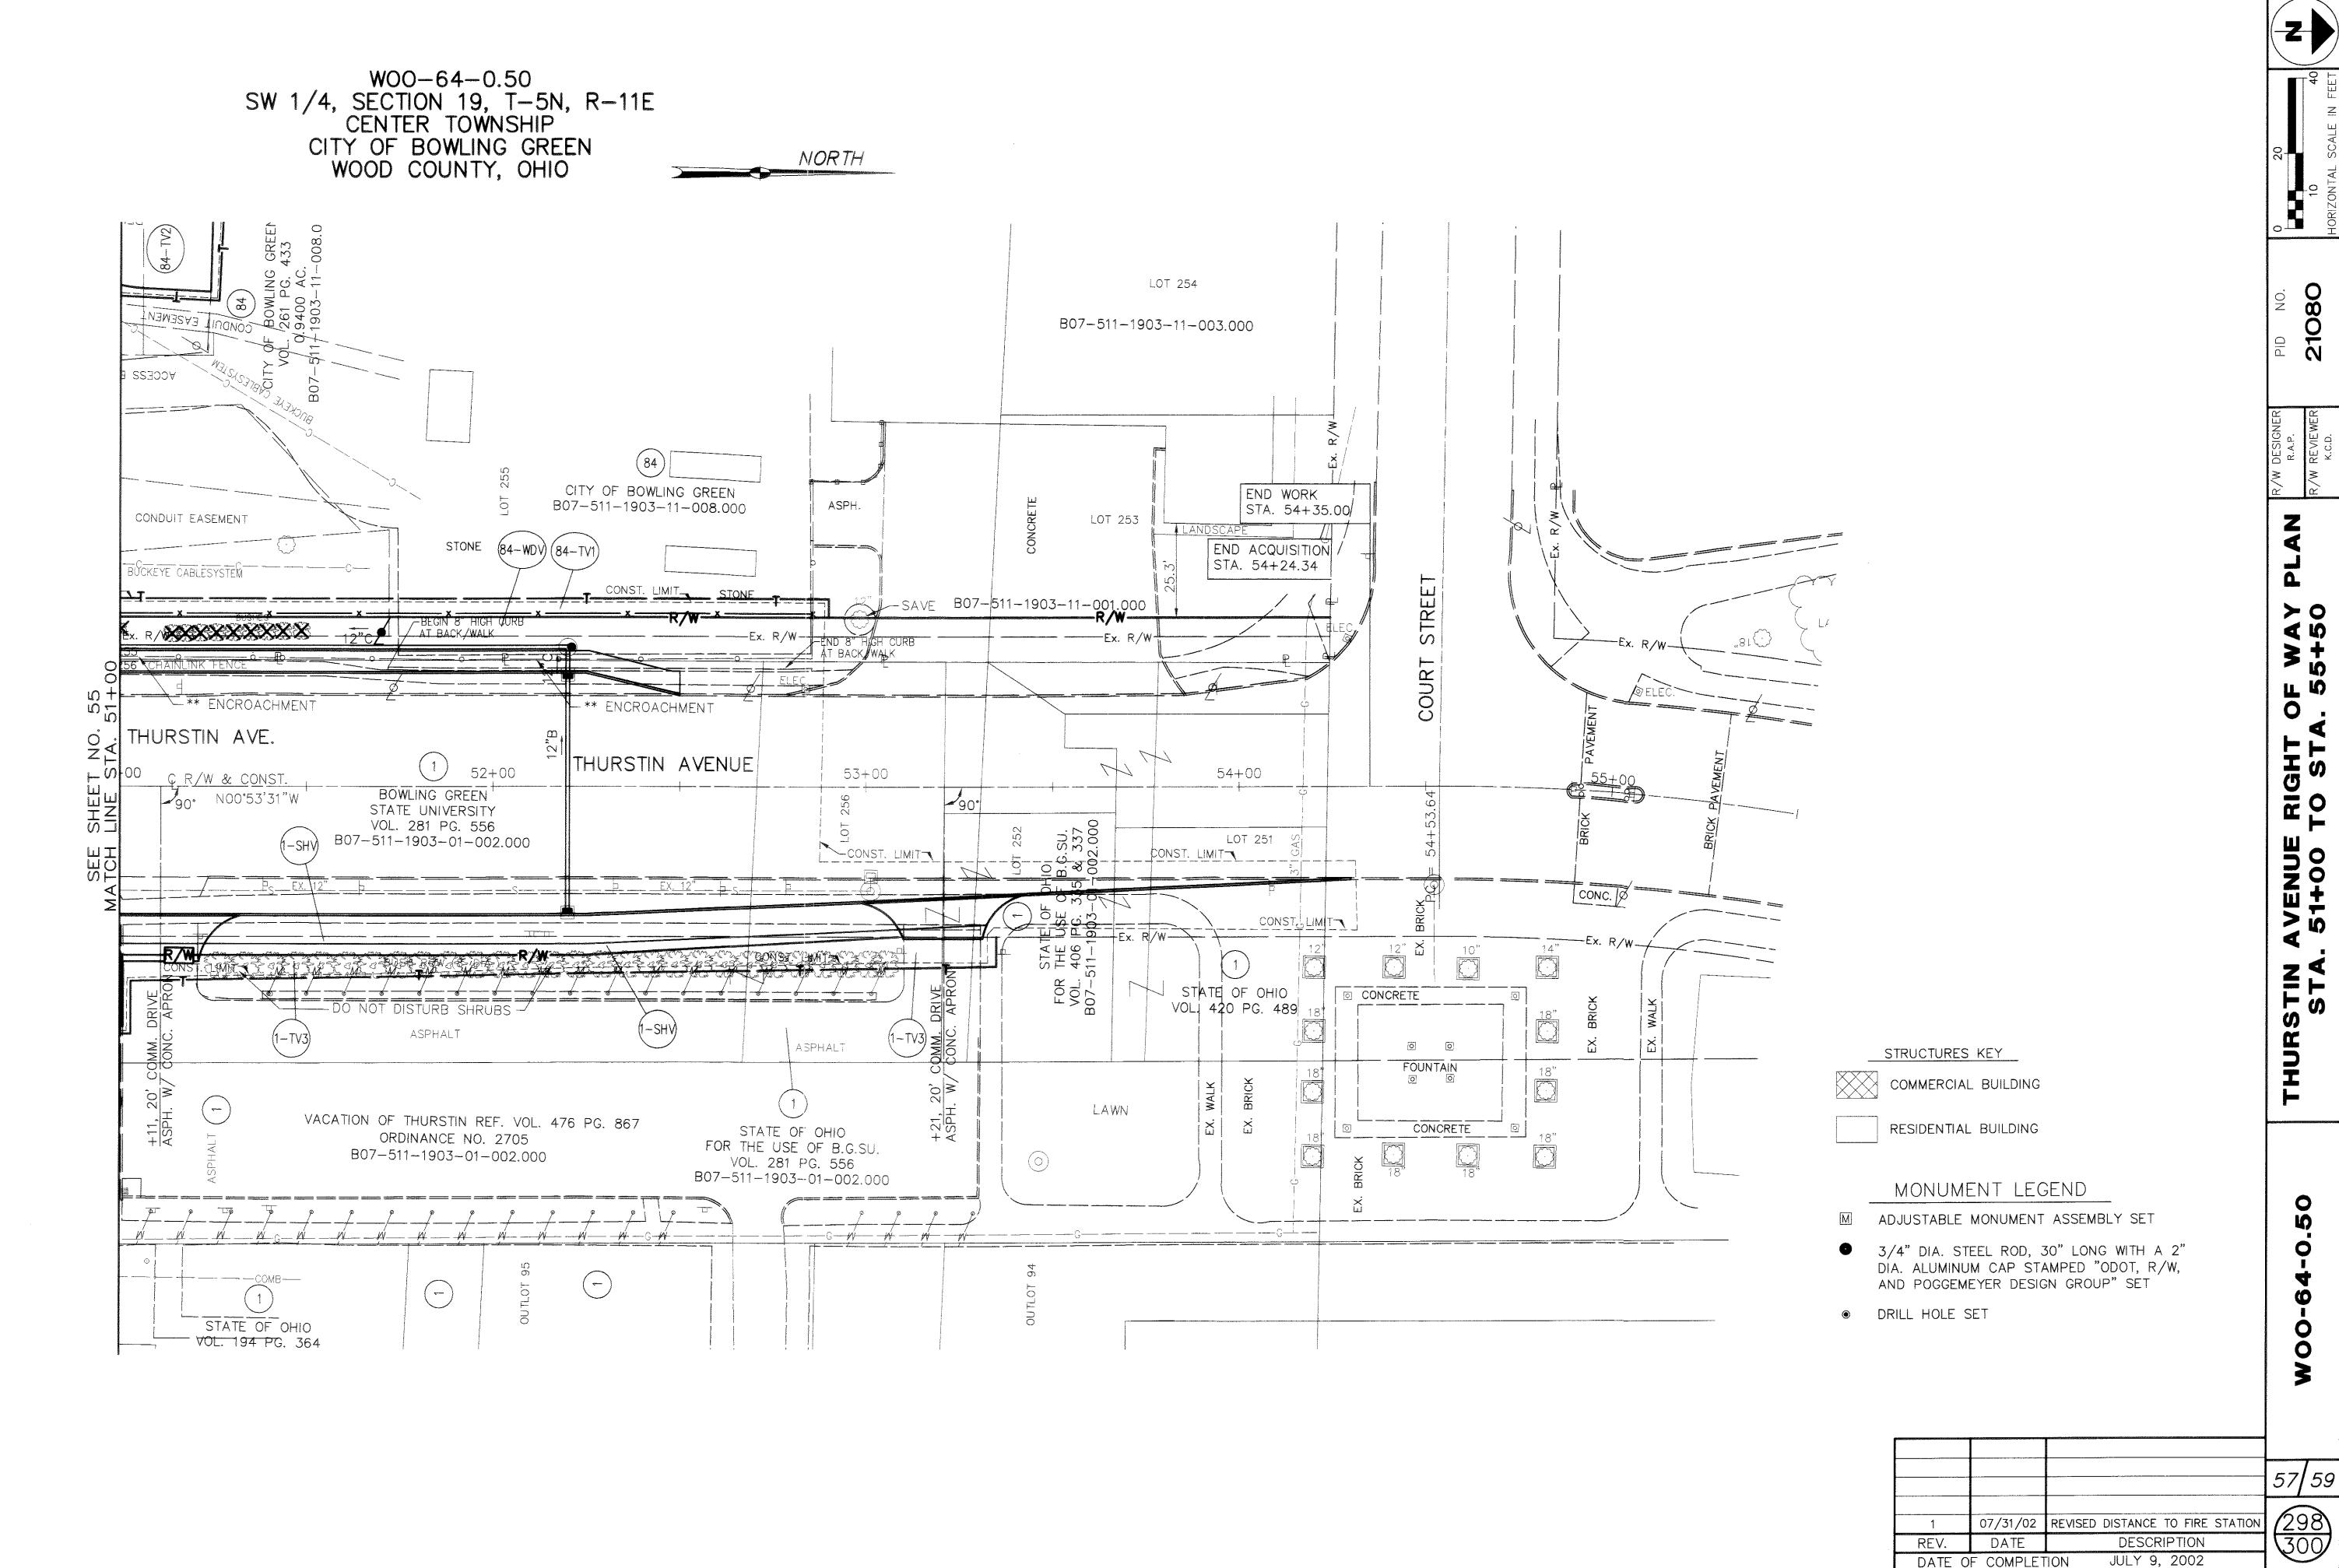


DATE OF COMPLETION

300

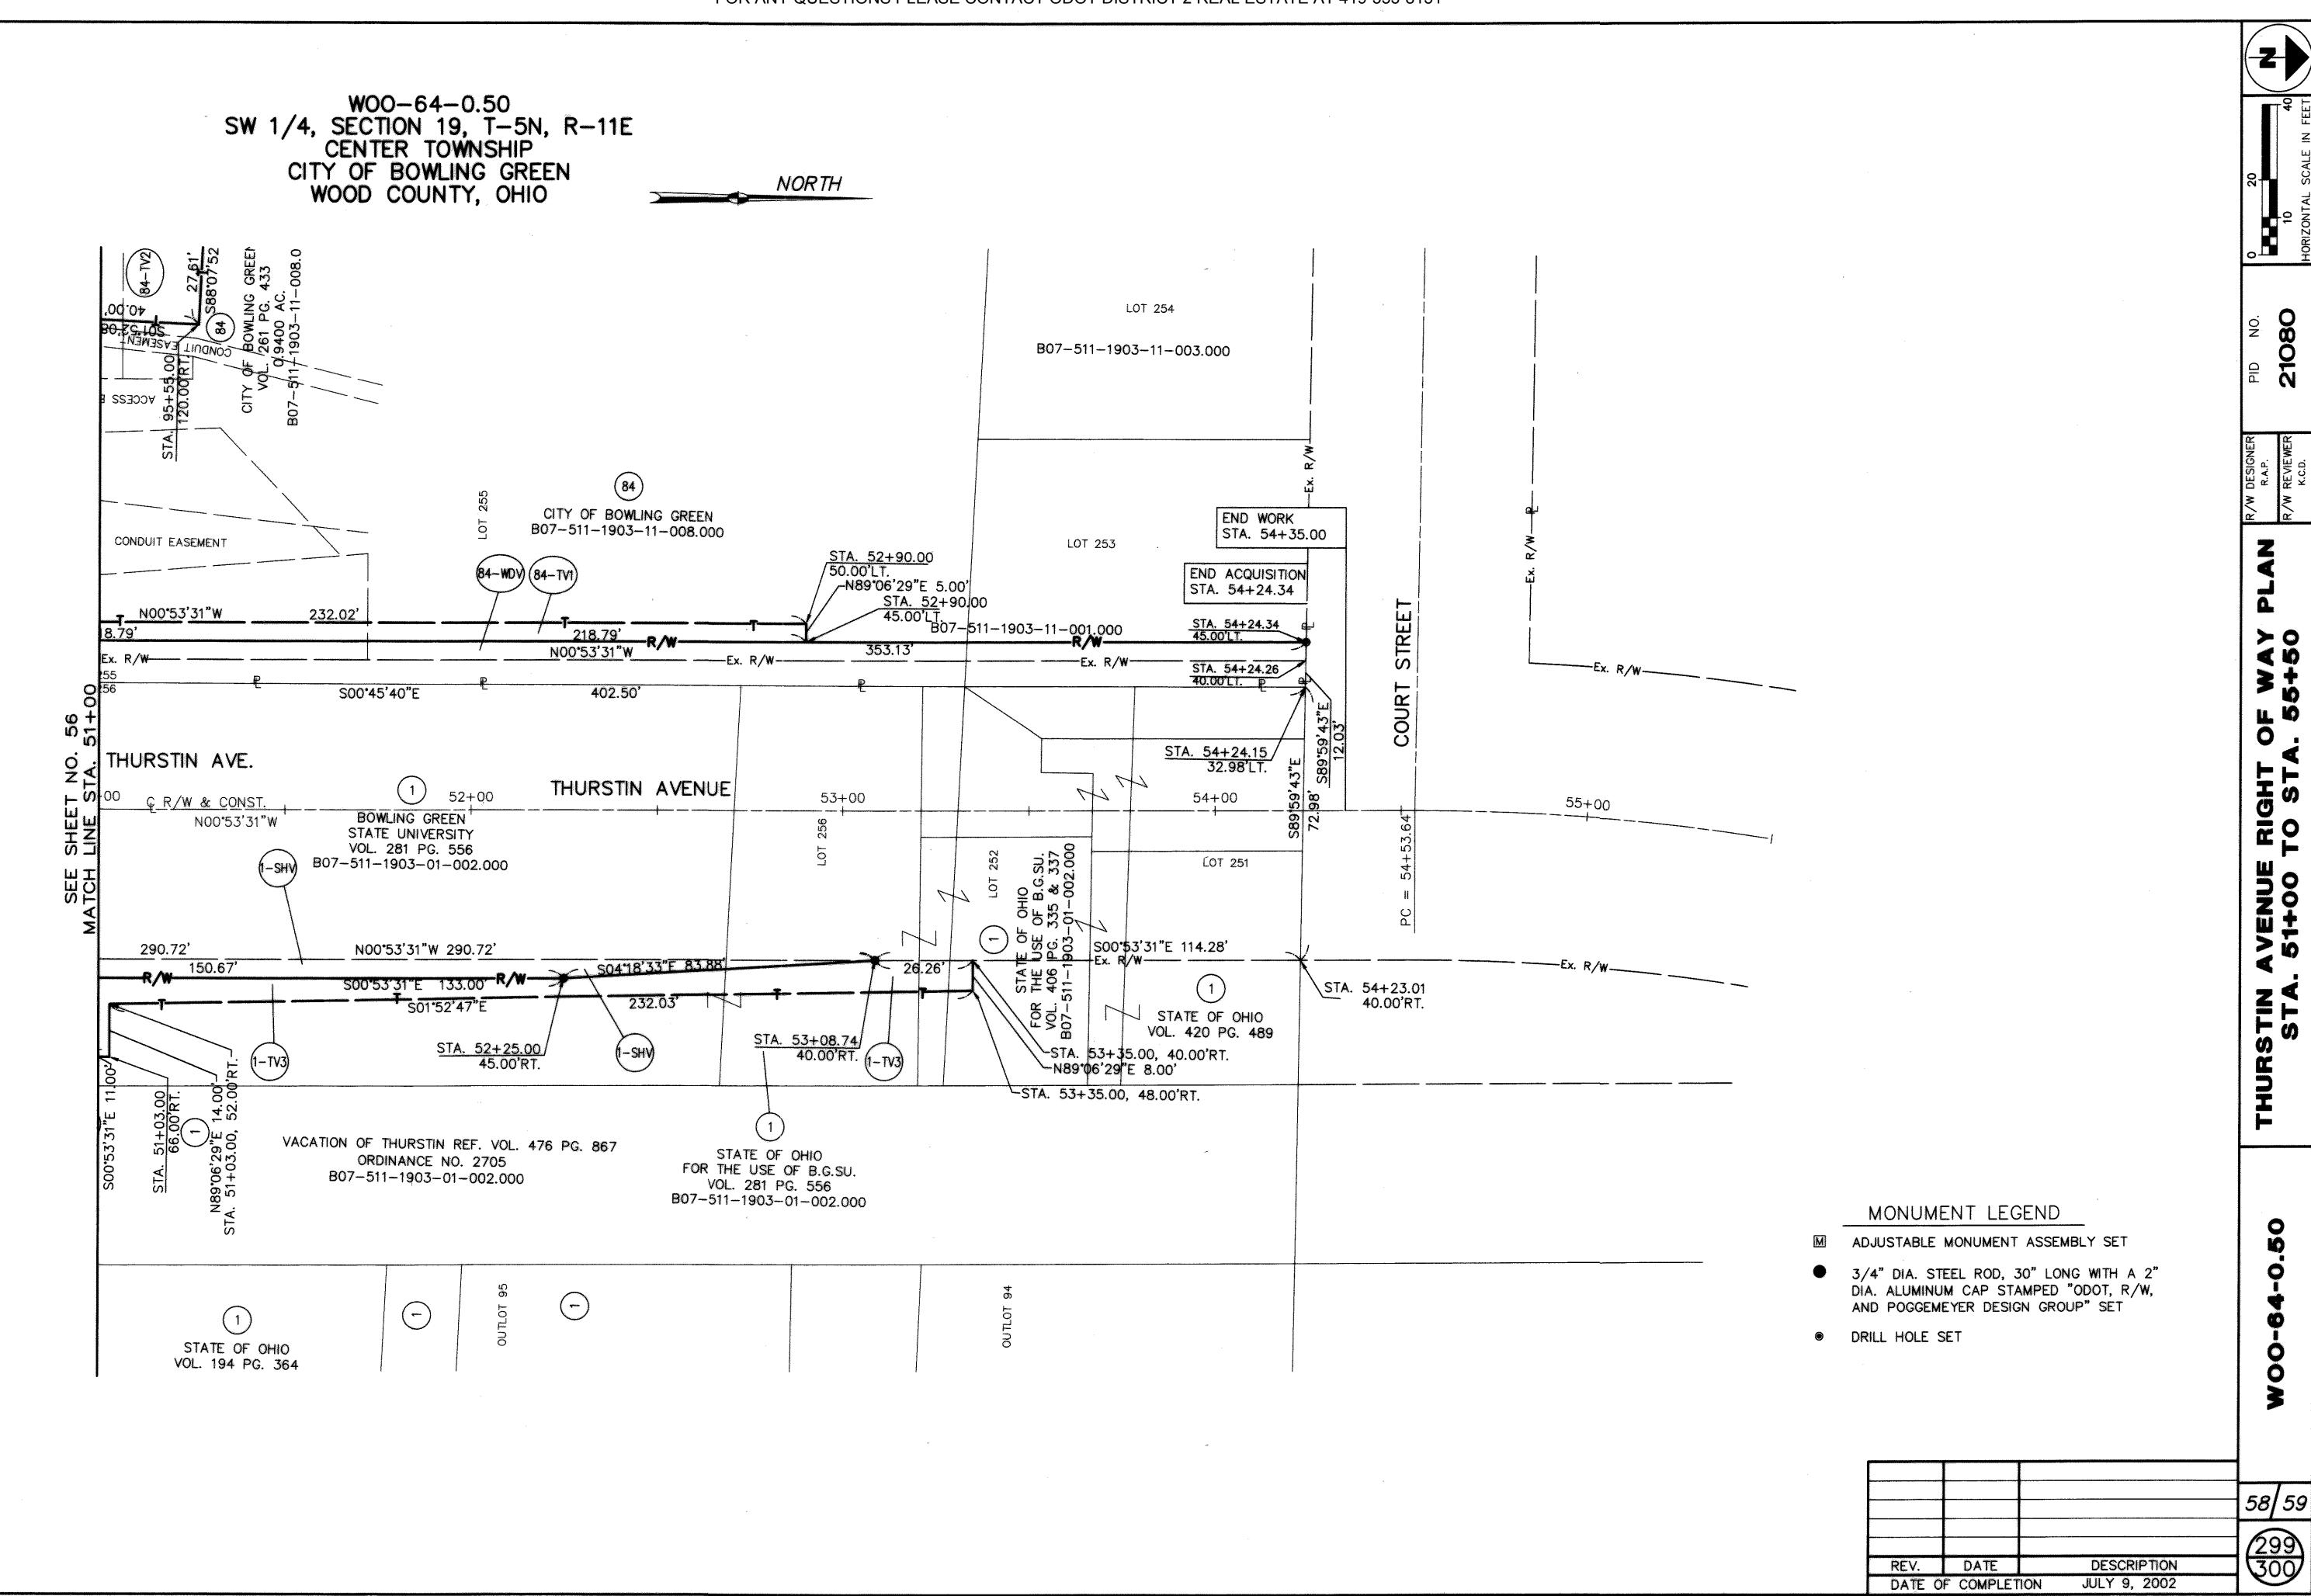


1-25' PERMANENT CABLE EASEMENT

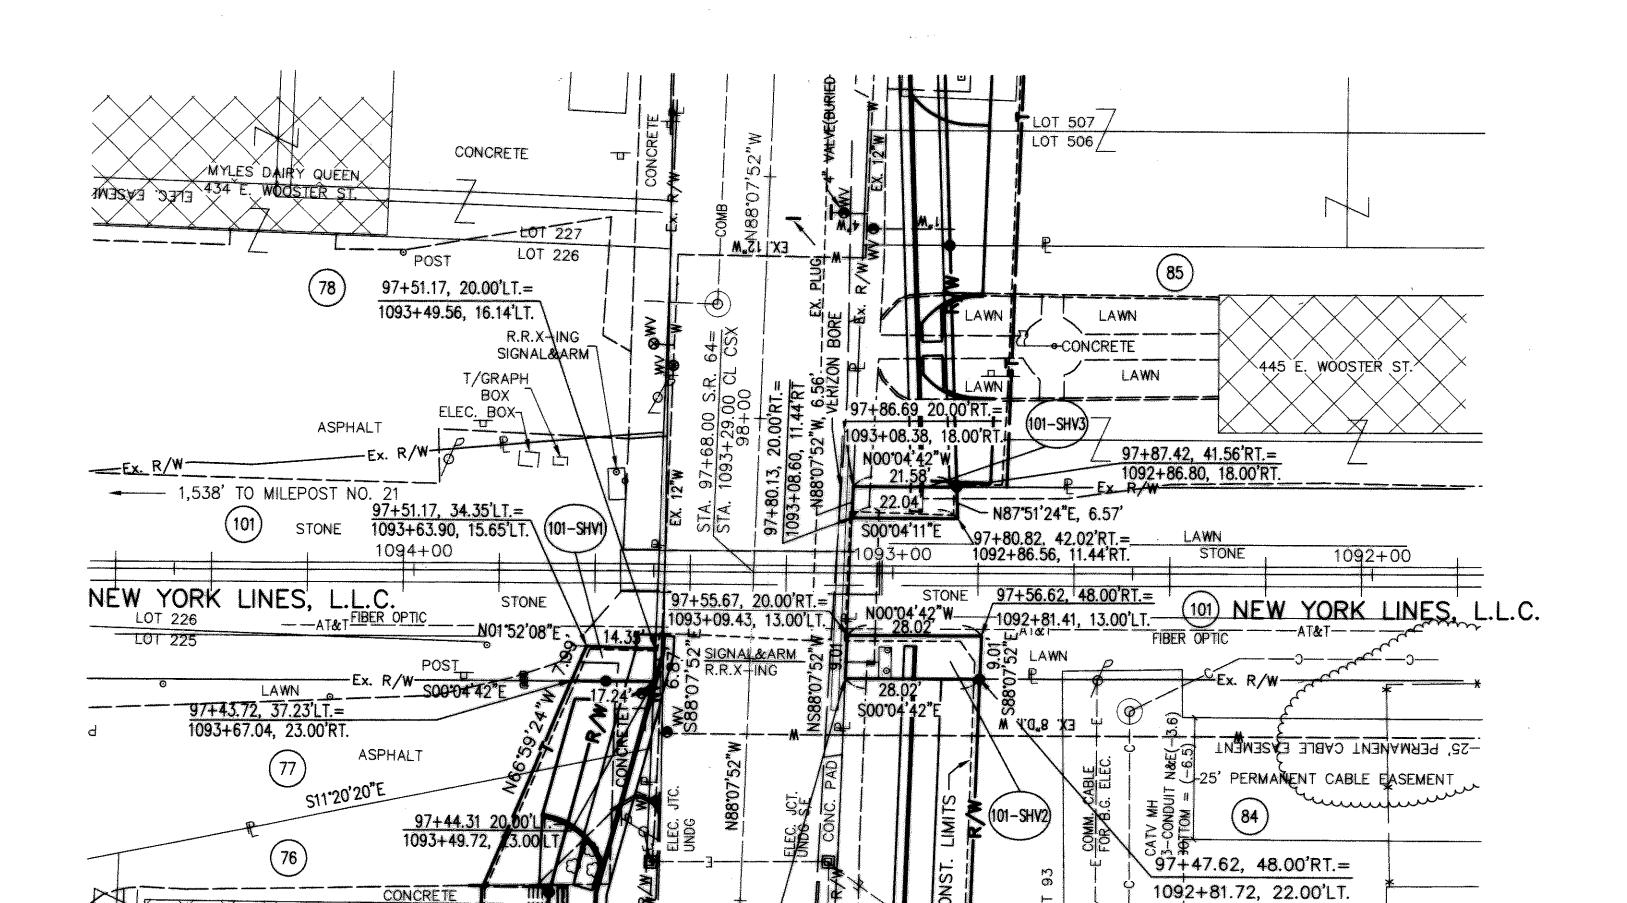

97+46.67, 20.00'RT.=/1093+09.74, 22.00'LT.

Š10 Ě. WOĎSTERŠT. THE SHED.

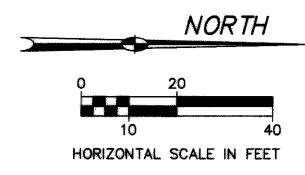

NOTE: RAILROAD STATIONING IS FROM: THE RIGHT OF WAY AND TRACK MAP THE TOLEDO AND OHIO CENTRAL RAILWAY
OPERATED BY THE TOLEDO AND OHIO
CENTRAL RAILWAY COMPANY
STATION 999+95.5 TO STATION 1099+40.4 SHEET V-302/9 (11 OF 115) JUNE 30, 1918

MEREDITH M. MYLES, JR. & BRIDGET A. MYLES

HAMBLIN INVESTMENTS COR. CORP. OF THE STATE OF FLORIDA

MERIDITH M. MYLES, SR., TRUSTEE TWILA M. MYLES, TRUSTEE

CITY OF BOWLING GREEN

ROBERT W. MAURER & PATRICIA A. MAURER

NEW YORK CENTRAL LINES L.L.C., A DELAWARE CORPORATION B07-511-1903-26-920.200 VOL. 763 PG. 432 5.49 AC.

PARCEL NO.	GROSS	P.R.O. IN	AREA OF DUAL USEAGE		NET TAKE AREAS	
	AREA SQ. FT.	TAKE	GROSS SQ. FT.	PRO SQ. FT.	DUAL USAGE	OUTSIDE DUAL USAGE AREA
		SQ. FT.				
101-SHV1	112.65	0.00	0.00	0.00	0.00	112.65 S.F.
101-SHV2	252.15	0.00	0.00	0.00	0.00	252.15 S.F.
101-SHV3	143.06	0.00	0.00	0.00	0.00	143.06 S.F.

59 59 300 300 02/24/03 ADD VERIZON BORE DATE REV. DESCRIPTION DATE OF COMPLETION JULY 9, 2002

1073-011