

DATE 5-31-94
PERSONNEL Van Dyson
DATE 5-26-94
PERSONNEL Van Dyson
DATE 5-26-94
PERSONNEL Van Dyson

PRIORITY NO. 15
COUNTY Wood
BEGIN LOG (SLM) 11.33
END LOG (SLM) 11.89
TOTAL LENGTH 0.56
MUNICIPALITY
MUNICIPALITY
PART 1 OF 3
ROUTE 64
TERMINII SR 65
TERMINII SR 65
MILES
BEGIN LOG (SLM)
END LOG (SLM)
BEGIN LOG (SLM)
END LOG (SLM)

PROPOSED WORK: Minor pavement & shoulder repairs, 1 1/2" 404
PAVEMENT 1 1/2" 404
OTHER 8"-301 part. - 6"-301 shoulder
SHOULDER 1 1/2" 404, 617

STATION ESTABLISHED FROM: FOUND PREVIOUS STATIONING FROM
S.R. 64 RESURFACING JOB AND CARRIED
THROUGH PROJECT.

STRUCTURES:

NUMBER	STATION	WIDTH	LENGTH	PROPOSED WORK
	None			

RAILROAD CROSSING:

NAME None STATION
NAME
NO. TRACKS
LENGTH ALONG C L
(NO WORK)
FT

ODOT (D-2) NOTES TO: B. Rosecrance 5-31-94
1995 TWO-LANE RESURFACING PROGRAM

PRIORITY NO. 15 PART 2 OF 3 SHEET 1-A OF 12
COUNTY Wood ROUTE 65 SECTION 11.96
BEGIN LOG (SLM) 11.96 TERMINII SR 64
END LOG (SLM) 17.69 TERMINII SR 25
TOTAL LENGTH 5.73 MILES
MUNICIPALITY Perrysburg BEGIN LOG (SLM) 16.54 Rt. 16.75 Lt. END LOG (SLM) 17.34 Rt. 17.69 Lt.
MUNICIPALITY BEGIN LOG (SLM) END LOG (SLM)

PROPOSED WORK: Minor pavement & shoulder repairs, 1 1/2" 404, grind along curb line
PAVEMENT 1 1/2" 404 SHOULDER 1 1/2" 404, 617
OTHER 8" 301 part. - 6" 301 shoulder

STATION ESTABLISHED FROM:

STRUCTURES:

NUMBER	STATION	WIDTH	LENGTH	PROPOSED WORK
<u>1527</u>	<u>805+21</u>	<u>43.5</u>	<u>103</u>	<u>ASPHALT</u>
<u>1539</u>	<u>811+33</u>	<u>30.0</u>	<u>292</u>	<u>CONCRETE APPROACHES 32' WIDE</u>

RAILROAD CROSSING: (NO WORK)
NAME Along STATION NO. TRACKS LENGTH ALONG C L FT
LENGTH ALONG C L FT

L - PROP PAVT DEPTH (INJ X 10; W - WIDTH @ MOUTH; W-I - WIDTH @ THROAT

STATION	SIDE	NAME OR NO.	L	W	W-I	ASPH	CONC	REMARKS
600+40	LT	S.R. 65	15'	88'	42'	X		
601+94	LT	S.R. 65	15'	93'	16'	X		measured old joint
602+36	RT	Reitz Rd	15'	79'	28'	X		
629+99	LT	S.R. 64	15'	109'	48'	X		
656+66	RT	FIVE POINT Rd	15'	70'	27'	X		
714+68	RT	Roachton Rd	15'	116'	47'	X		
735+37	RT	BRITTANY Rd	15'	141'	83'	X		
755+06	RT	Willowbend Rd	15'	127'	72'	X		
784+79	RT	CARRINGTON WOODS RD	15'	124'	61'	X		
826+19	LT	HULL PRAIRIE RD	15'	88'	34'	X		
826+23	RT	HULL PRAIRIE RD	15'	52'	24'	X		
853+19	RT	RIVERFORD RD	15'	125'	73'	X		
857+65	RT	OTUSBO RD	15'	104'	41'	X		
861+81	RT	CRANDEN RD	15'	71'	27'	X		
868+96	RT	HOLLY LANE	15'	44'	27'	X		} CIRCLE DRIVE
869+77	RT	"	15'	55'	25'	X		
890+31	LT	FORT MEYER RD	15'	86'	42'	X		DEAD-END ST. TO HOUSES
"	RT	"	15'	95'	45'	X		
904+99	RT	BERKSHIRE RD	15'	74'	32'	X		
906+17	LT	NORTH PRAIRIE RD	15'	89'	33'	X		
011+00	RT	011+00 DANCE RD	15'	15'	30'	X		

DESCRIPTION		LEFT	CENTER LINE	RIGHT	JOB NO.
C.B.	ON LT CURB				
W.V.	13.5' RT OF E			603+43 3'x5' Needs Rebuilt	
W.V.	15.0' RT OF E			656+41	
M.H.	14.5' RT OF E			715+07 894+00	
W.V.	13.5' RT OF E			735+75 26/25.6/3.4	
M.H.	15' RT OF E			755+34	
				785+15	
STRUCTURE WOOD-65-1527				Asphalt	
805+21 = 43.5' WIDTH 108' LENGTH					
STRUCTURE WOOD-65-1539					
WITH CONC. APPROACH					
811+33 = 30.0 WIDTH					
W.V.	23.0 RT OF E			852+88	
W.V.	18.6 RT OF E			856+34	
W.V.	21.0 RT OF E			857+45	
Mon. Box	on E			881+47	
Mon. Box	on E			895+21	

DATE 3-26-11

1995
~~1994~~ TWO-LANE RESURFACING PROGRAM SHEET 3 OF 12
 UTILITIES (CATCH BASIN, MANHOLE, INLET, WATER VALVE, BOX AND MONUMENT BOX)

COUNTY Wood ROUTE 65 SECTION 11.96-17.69

R - RAISE F - FEATHER

STATION	OUT (FT) RT/LT OF C	CATCH BASIN	MAN- HOLE	INLET	W V BOX	MON BOX	CASTING		REMARKS ie: RECONSTRUCT, NO WORK
							R	F	
603+43	ON LT CURB	X					X		3'x5' RECONSTRUCT
656+41	13.5' RT OF C				X		X		
715+07	15.0' " " "				X		X		
735+75	16.5' " " "		WATER X				X		
755+34	16.5' " " "				X		X		
785+15	15.0' " " "		WATER X				X		
852+88	23.0' " " "				X		X		
856+34	18.6' " " "				GAS VALVE		X		
857+45	21.0' " " "				X		X		
881+47	ON C					X	X		
895+21	" " "					X	X		
896+73	" " "					X	X		
910+58	" " "					X	X		
917+67	" RT SIDE " In Curb + Gutter	X					X		NO WORK
917+67	LT SIDE	X					X		NEEDS REMOVED
921+08	RT SIDE	X					X		NO WORK
921+08	LT SIDE	X					X		NO WORK
923+60	RT SIDE	X					X		RECONSTRUCT
924+09	LT SIDE	X					X		RECONSTRUCT
924+58	RT SIDE	X					X		RECONSTRUCT

DATE 3 22 11

SHEET 4 OF 12

1995 TWO-LANE RESURFACING PROGRAM
PAVEMENT DATA

NOTE: LOCATE ALL
CHANGES IN PAVT WIDTH

COUNTY Wood ROUTE 65 SECTION 11.96-17.69

MILE MARKER	STATION	LEFT BERM WIDTH (TYPE)	PAVEMENT WIDTH OUT/OUT WHITE LINES	RIGHT BERM WIDTH (TYPE)
	CONST. JOINT 599+86	3.4 Asph.	22.1 Asph.	4.0 Asph.
13	683+57	2.3 "	21.1 "	1.6 "
14	736+66	2.1 "	20.4	2.6 "
15	789+56	0.3 "	26.9	0.5 "
16	845+15	1.2 "	20.8	1.8 "
PAV'T WIDTH	861+00	2.2 "	20.8	1.9 "
"	857+60	1.5 "	22.5	1.5 "
REYSBURY W. Corp	872+00	2.1 "	20.4	2.1 "
PAV'T WIDENS	880+00	3.3 "	22.4	2.1 "
"	886+00	3.1 "	24.0	3.0 "
"	894+00	3.6 "	25.6	3.4 "
"	910+00	4.0 "	22.3	4.3 "
	END CONST. JOINT 932+23	-	57.0	-

* = STATION LOCATION

STATION	LANE LT/RT	OTHERS (SKETCH)	* ↑	* R/R	*SCHOOL	*ONLY	* ↑	* ↑
785+53	TURN LANE	Sec DRAWING 10512					AT TURN X	
785+82	"	" " 10512				X	AT TURN X	
	"	" " 11612						

DATE

21 OF 9 SHEETS

~~1995~~
1995

COUNTY Wood

[illegible]

DATE 2-24-11

SHEET 7 OF 12


1995 ~~1994~~ TWO-LANE RESURFACING PROGRAM
CENTERLINE PAVEMENT MARKINGS
INSIDE CITY LIMITS ONLY

COUNTY Wood ROUTE 65 SECTION 11.96-17.69

[illegible]

PERSONNEL	TITLE	PERSONNEL	TITLE	COUNTY	WOOD	DATE	5-24-94
VAN DUSEN	HI			S. R.	65	WEATHER	Sunny
BARNHISEL						TEMP.	+ 83°
CORDS					11.96-17.69		

DESCRIPTION	JOB NO.
CURB & INTERSECTION INFO.	

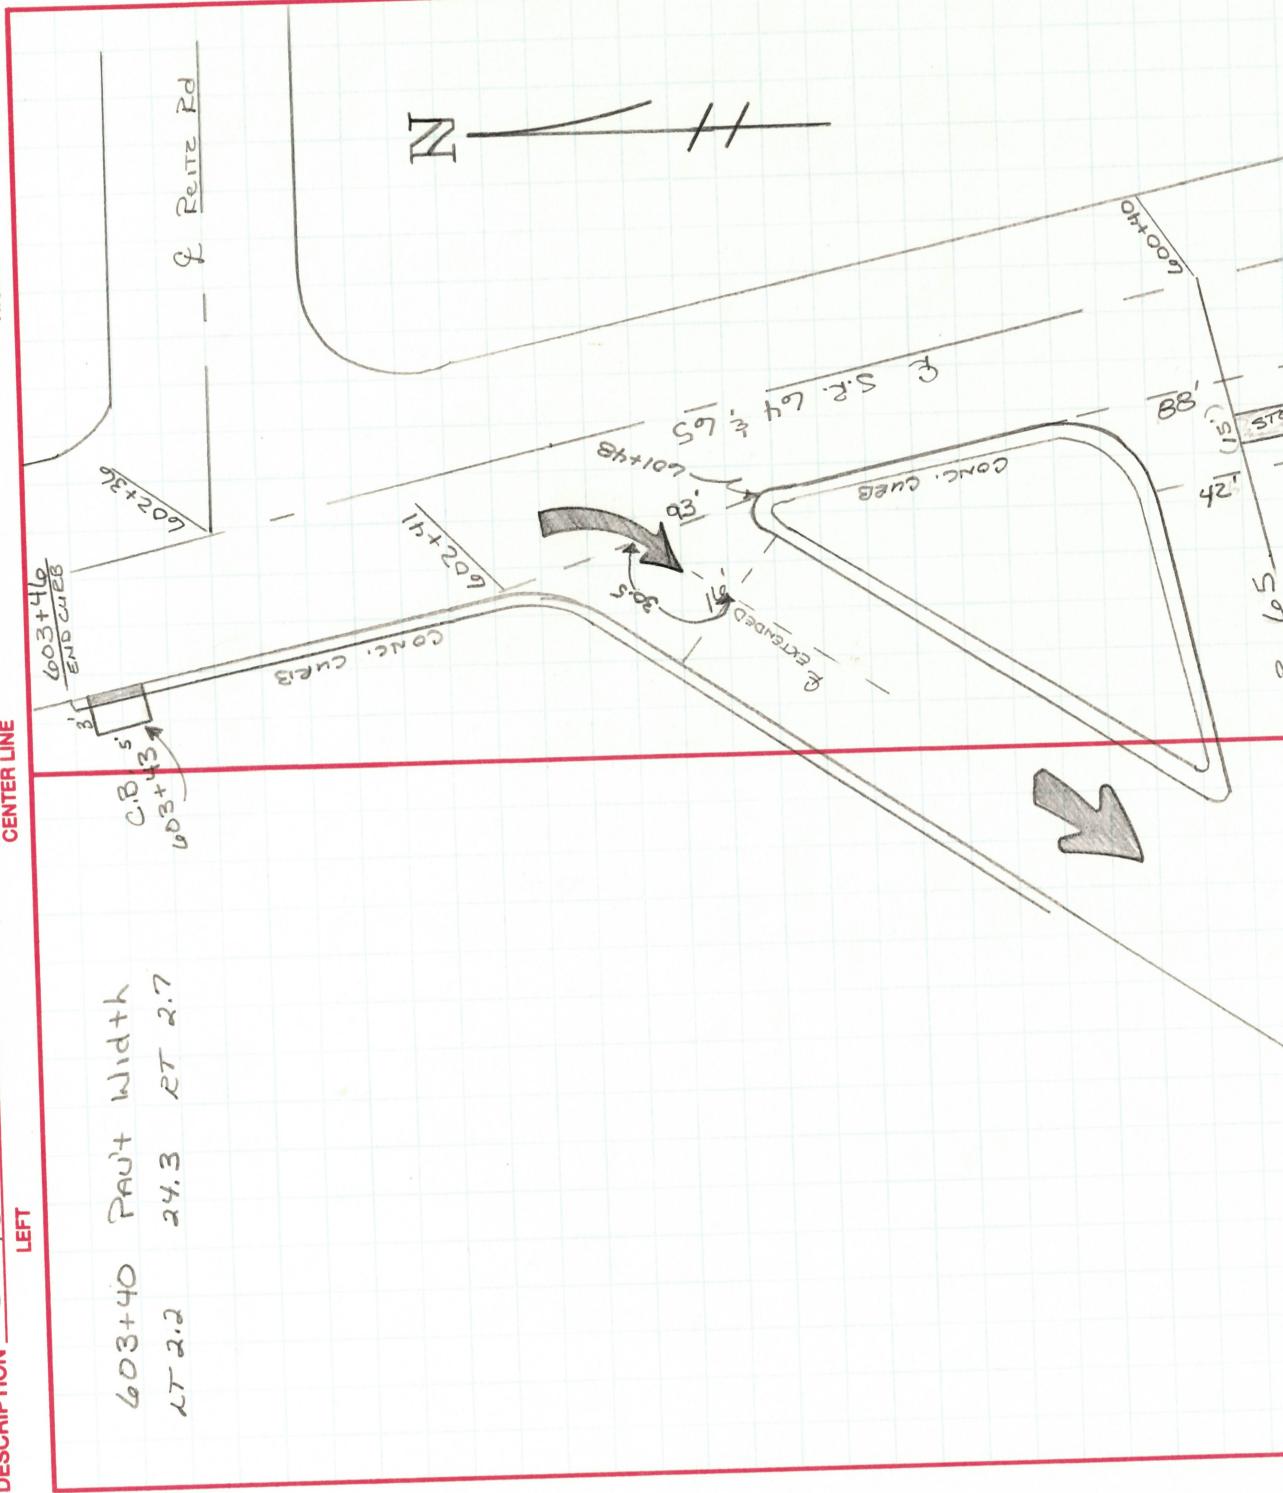

OHIO DEPARTMENT OF TRANSPORTATION

SHEET NO. 98812

PERSONNEL TITLE PERSONNEL TITLE COUNTY WOOD DATE 5-24-94
 VAN DUSEN TITLE
 BARNHISEL
 CORDS
 S. R. 65 WEATHER SUNNY
 SEC. 11.96-17.69 TEMP. +83°

DESCRIPTION CURB INFO. JOB NO. RIGHT



CITY OF PERRYSBURG

914+54 START CURB & 2' GUTTER both sides 24.0 OF ASPHALT (CONC TO CONC)

599+86 CONST. JOINT at S.R. 64 & 65 LT. 3.4 / 22.1 / RT 4.0

932+23 CONST. JOINT at U.S. 25 PAUT WIDTH 57.0


194SWH

OHIO DEPARTMENT OF TRANSPORTATION

SHEET NO. 10812

PERSONNEL TITLE PERSONNEL TITLE COUNTY WOOD DATE 5-24-94
VAN DUSEN TITLE PERSONNEL WEATHER SUNNY
BARNHISEL S. R. 65
CORDES SEC. 11.96-17.69 TEMP. +83°


DESCRIPTION PAUT MARKINGS & WIDE PAUT CENTER LINE JOB NO. RIGHT

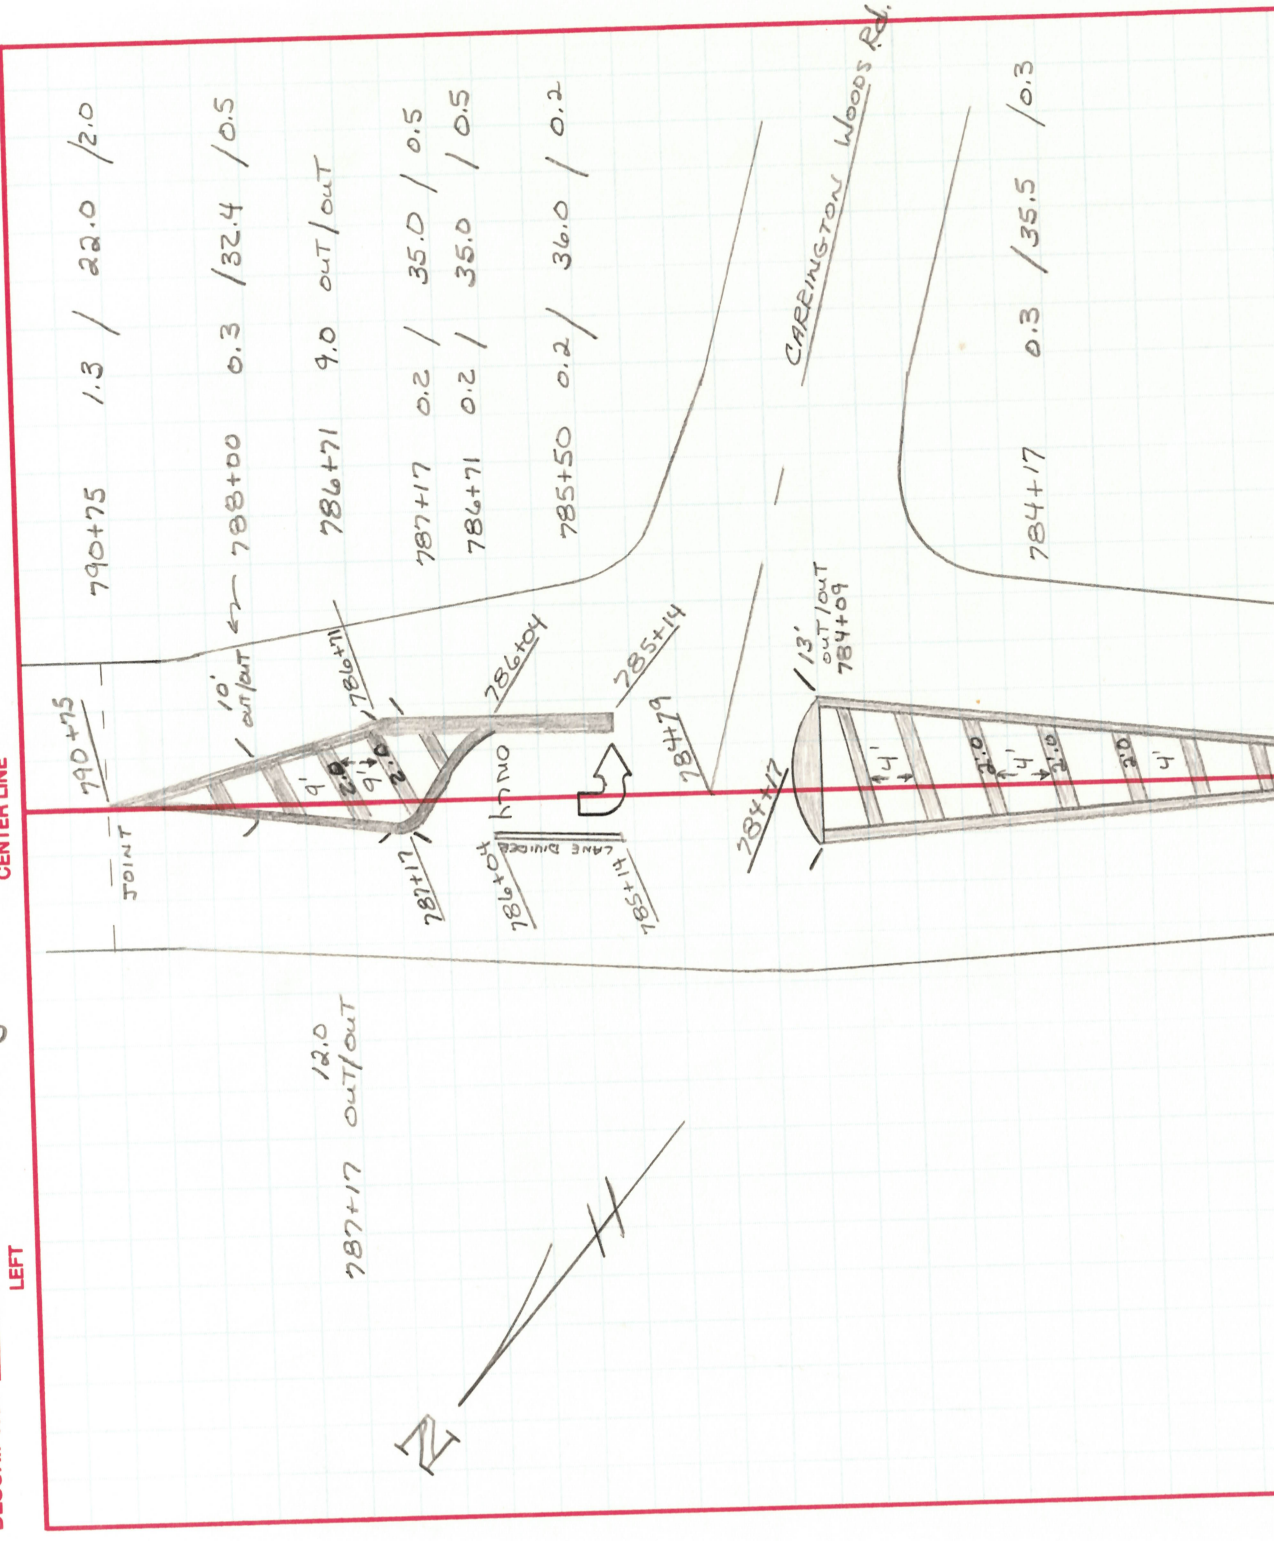

PERSONNEL TITLE PERSONNEL TITLE COUNTY WOOD DATE 5-24-94
 VAN DUSEN TITLE S.R. L65 WEATHER SUNNY
 BARNHISEL
 CORDS


SEC. 11.96-17.69 TEMP. +83°

DESCRIPTION PAUT MARKINGS & WIDE PAUT CENTER LINE LEFT RIGHT JOB NO.

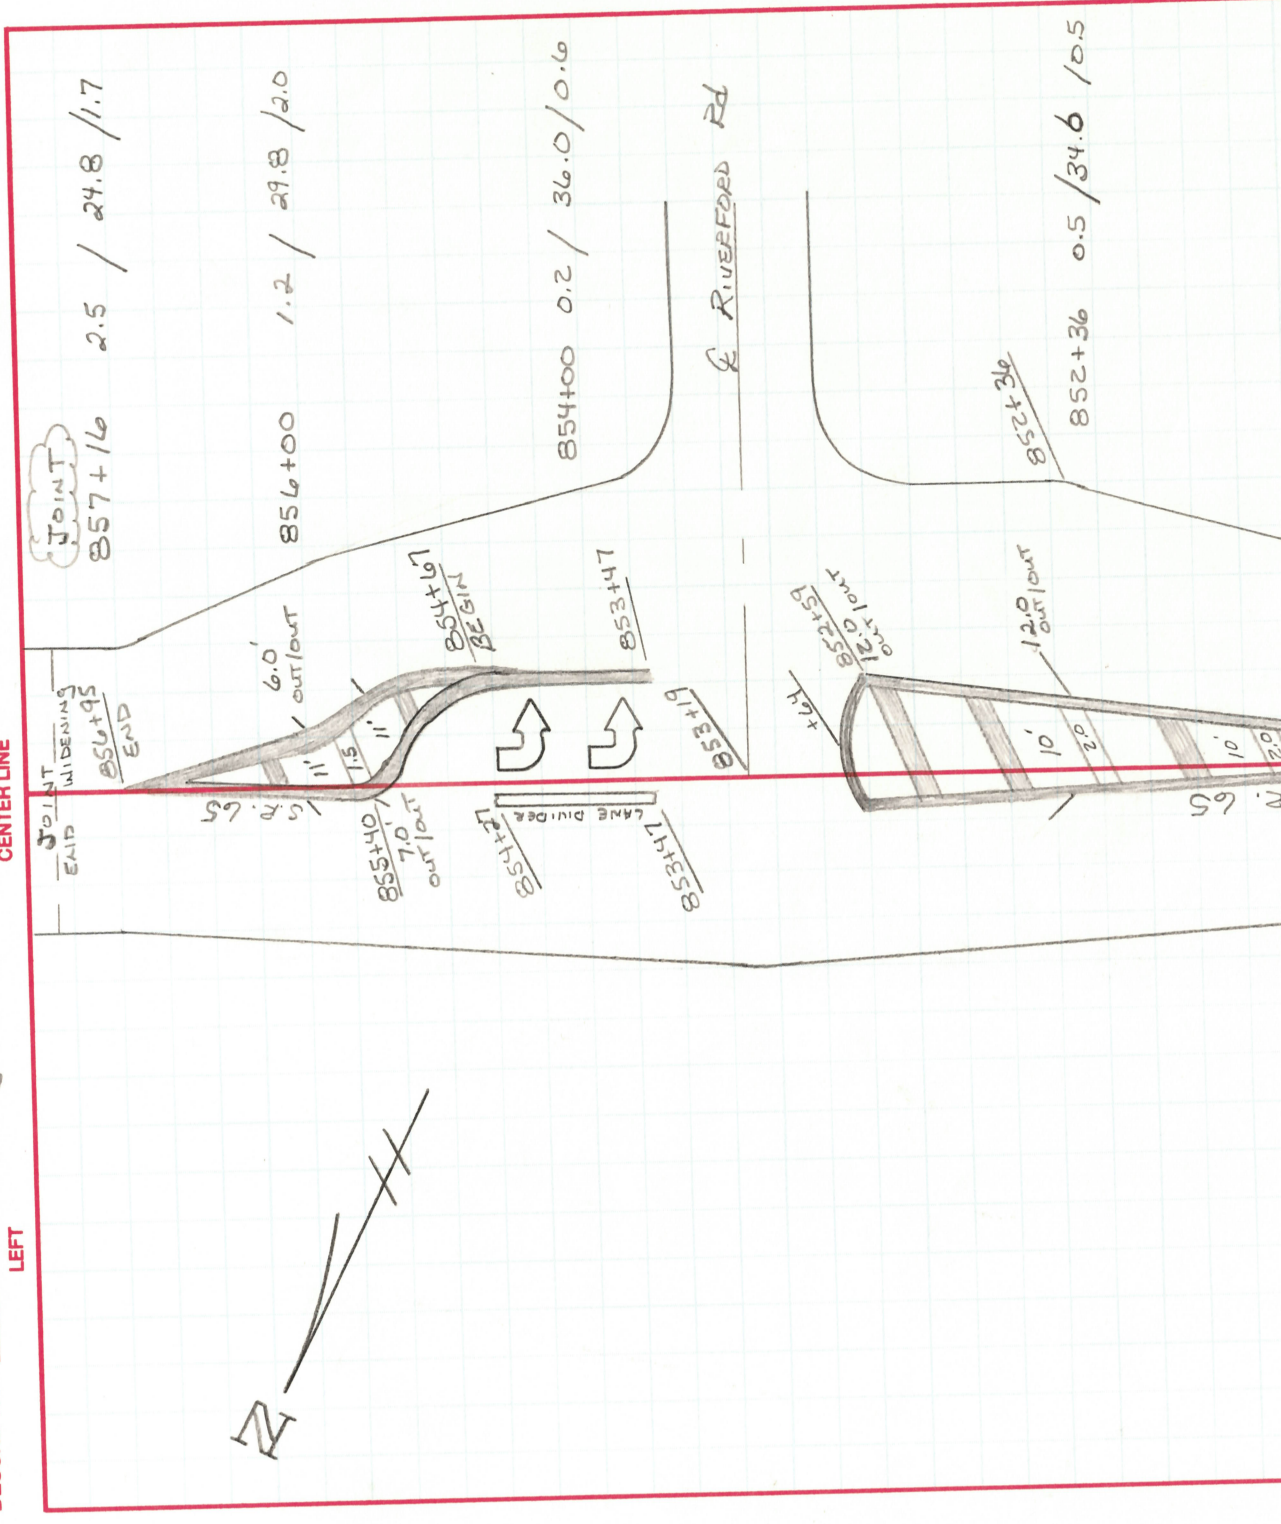

PERSONNEL VAN DUSEN TITLE _____ PERSONNEL WOOD TITLE _____
BARNHISEL III _____ S.R. 65 _____
COEDS _____ SEC. 11.96-17.69 _____
 DATE 5-26-94 WEATHER SUNNY
 TEMP. +70°

DESCRIPTION PAUT MARKINGS & WIDE PAUT JOB NO. _____
 LEFT RIGHT

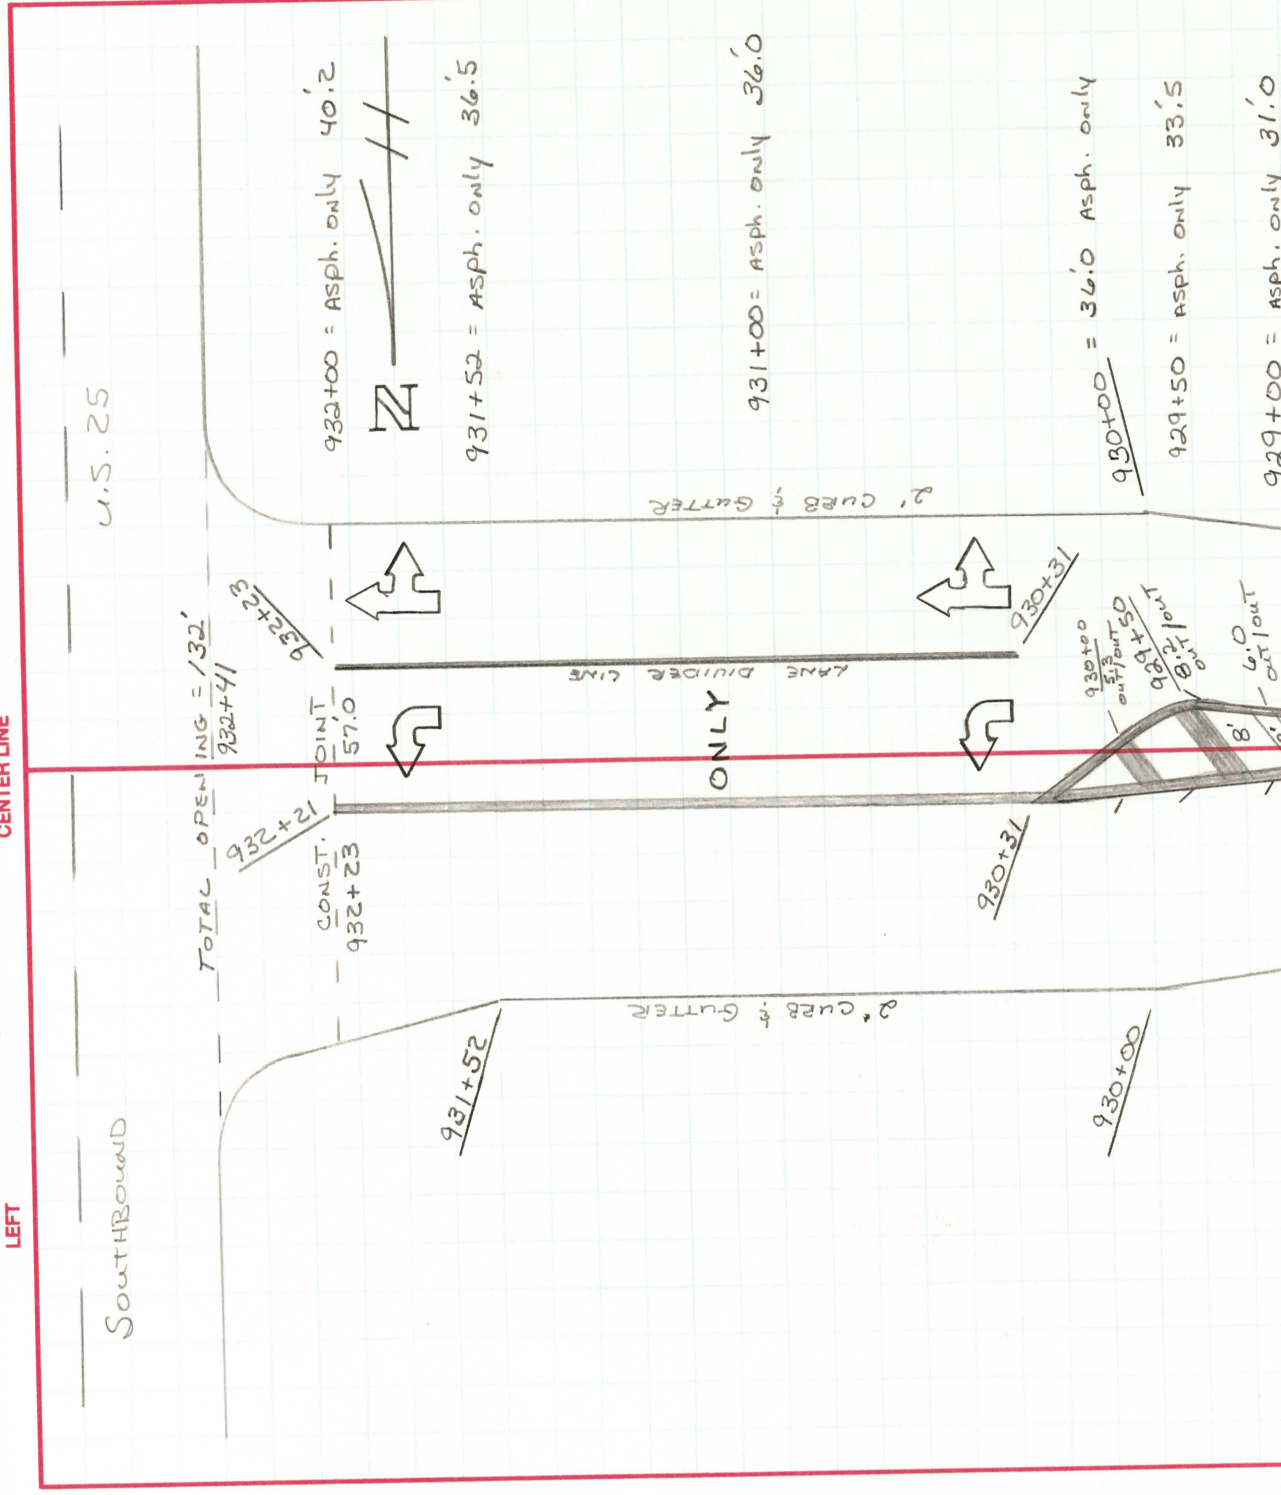

June 27, 1995
Rosebrock
Hoffman

Woo-65-11.96 to 17.69

Project 210-95
Job Number 625019
Resurface S.R. 65

APPROXIMATE LOCATION OF SUPERELEVATION IN CURVES

DATA TAKEN FROM THE 1924 PLAN (folder #8032) AND THE
1971 PLAN (folder #8059) AND CONVERTED TO THE 1995
RESURFACE PLAN STATIONING.

PLAN SHEET	BEGIN SUPERELEVATION	END SUPERELEVATION
1924 plan		
4	681+61	685+18
6	737+88	740+71
6	746+41	749+09
6	752+36	755+05
6	755+52	758+87
7	764+69	768+59
8	791+56	796+66
8	810+48	815+22
9	827+21	830+12
9	831+55	834+70
9	845+97	848+97
10	857+53	860+61
1971 plan		
22, 23, 24	880+63	

OHIO DEPARTMENT OF TRANSPORTATION

SHEET NO. 1 of 11

PERSONNEL

TITLE

PERSONNEL

TITLE

LUCE

T

WOOD

COUNTY

DATE 5-31-95

REED

D

65

S. R.

WEATHER

Nice

PERSONNEL

TITLE

PERSONNEL

TITLE

SEC. 11.96

TEMP.

72°

DESCRIPTION

CHECK FOR INVERTED PAV'T

JOB NO. 625019

LEFT

CENTER LINE

RIGHT

NOTE: ALL EXTRA SAGITS ARE MEASURED FROM ± PAV'T (YELLOW LINE)

WHITE
LINEYELLOW
LINEWHITE
LINE

6.37

5.87

5.59

SUPER

5.22

4.82

4.70

4.76

4.49

4.60

 $\frac{4.61}{80' \text{ RUT}}$

4.40

4.45

4.82

4.97

4.93

5.16

5.51

5.24

5.31

4.47

4.56

4.61

IN
VALLEY

5.63

5.62

5.84

6.43

6.00

6.15

5.10

4.76

4.89

5.54

4.98

5.12

PAV'T REPAIR

5.20

5.22

5.25

END SUPER

4.28

4.62

5.20

SUPER

TRANSIT REPAIR SUPER

OHIO DEPARTMENT OF TRANSPORTATION

SHEET NO. 2911

PERSONNEL <u>LYCE</u>	TITLE <u>DT</u>	PERSONNEL	TITLE	COUNTY <u>WOOD</u>	DATE <u>5-31-95</u>
<u>REED</u>	<u>0</u>			S. R. <u>65</u>	WEATHER <u>NICE</u>
				SEC. <u>11.96</u>	TEMP. <u>72</u>

DESCRIPTION CHECK FOR INVERTED PAV'T JOB NO. 625019

CENTER LINE

LEFT

RIGHT

732+	WHITE LINE 3.70	YELLOW LINE 3.52	WHITE LINE 3.61
734+	3.92	3.73	4.08
736+25	4.57	4.35	4.41
766+	3.30	3.60	3.85
768+	3.42	3.59	3.77
770+	3.60	3.54	3.59
772+	4.55	4.40	4.48
774+	4.03	3.91	3.95
776+	4.28	4.21	4.30
778+	4.27	4.21	4.24
780+	4.47	4.43	4.71
818+	3.21	3.15	3.27

OHIO DEPARTMENT OF TRANSPORTATION

SHEET NO. 3 of 11

PERSONNEL LUKE TITLE TM PERSONNEL WOOD COUNTY WOOD DATE 5-31-95
REED 0 0 S. R. 65 WEATHER NICE
 SEC. 11.96 TEMP. 74°

DESCRIPTION CHECK FOR INVERTED PAVT JOB NO. 625019
 LEFT CENTER LINE RIGHT

DESCRIPTION	WHITE LINE	YELLOW LINE	WHITE LINE
715+19	2.94	2.90	3.06
716	4.16	4.10	4.12
717+	6.57	6.41	6.33
718+	7.74	7.52	7.50
720+	5.11	5.20	5.33
722+	4.06	4.06	4.16
724+	4.52	4.58	4.81
726+	2.71	2.83	2.77
726+21	3.30	3.43	3.25
726+39	3.72	3.83	3.67
726+58	4.01	4.08	4.07
726+78	4.28	4.36	4.40
727+20	11.51	11.71	11.61

OHIO DEPARTMENT OF TRANSPORTATION

SHEET NO.

4 of 11

PERSONNEL LucE TITLE TD PERSONNEL Wood COUNTY Wood DATE 5-31-95

PERSONNEL REED TITLE D PERSONNEL 65 S.R. Nice WEATHER Nice

SEC. 11.96 TEMP. 74°

DESCRIPTION ADDITIONAL CHECKS FOR INVERTED PAVT JOB NO. 625019

LEFT

CENTER LINE

RIGHT

	WHITE LINE	YELLOW LINE	WHITE LINE
838+	5.02	4.66	4.42
+36	5.08	4.92	4.74
+95	5.10	4.85	4.78
839+16	5.01	4.80	4.78
+39	5.04	4.80	4.80
84	4.66	4.70	4.60
840+39	4.26	4.15	3.94
+73	3.85	3.67	3.66
841+0	3.22	3.05	3.12
+50	1.96	1.75	1.78
716+43	5.40	5.33	5.27
711+13			

$$\frac{3.78}{3}$$

$$\frac{5.32}{3}$$

$$\frac{5.17}{3}$$

OHIO DEPARTMENT OF TRANSPORTATION

SHEET NO. 59/11

PERSONNEL	TITLE	PERSONNEL	TITLE	COUNTY	DATE	WEATHER	TEMP.
LUCE	TD			WOOD	5-31-95	Nice	75°
REED	A			S. R.	65		
				SEC.	11.96		

DESCRIPTION	CHECK FOR INVERTED PAVT	JOB NO.
		625019

LEFT

CENTER LINE

RIGHT

	WHITE LINE	YELLOW LINE	WHITE LINE
706+	4.36	4.24	4.22
706+40	5.88	5.84	5.78
706+65	6.75	6.56	6.54
707	7.16	6.87	6.90
707+30	7.13	6.92	6.88
707+50	6.71	6.69	6.96
707+01	1.07	1.11	1.27

PERSONNEL	TITLE	PERSONNEL	TITLE	COUNTY	DATE
LUCE	TR			WOOD	5-31-95
REED				S. R.	65
				WEATHER	Nice
				TEMP.	81°

DESCRIPTION	CHECK FOR INVERTED	PAV'T	JOB NO. 625019
	LEFT	CENTER LINE	RIGHT

	WHITE LINE	YELLOW LINE	WHITE LINE
678+00	4.00	4.09	4.05
678+32	4.24	4.35	4.39
678+64	4.45	4.54	4.51
680+	4.86	4.69	4.82
682+	3.43	3.61	3.75
684+	3.15	3.56	3.88 SUPER
686+	4.32	4.07	4.17
688+	4.39	4.22	4.20
690+	3.58	3.51	3.65
692+	4.60	4.45	4.51
694+	4.81	4.11	4.74

PERSONNEL LUCE TITLE TM PERSONNEL WOOD COUNTY WOOD DATE 5-31-95
 PERSONNEL REED TITLE R PERSONNEL 65 S. R. 65 WEATHER NICE
 SEC. 11.96 TEMP. 81°

DESCRIPTION CHECK FOR INVERTED PAVT JOB NO. 625019
 LEFT CENTER LINE RIGHT

DESCRIPTION	WHITE LINE	YELLOW LINE	WHITE LINE
668.00	2.83	2.83	2.95
670+00	3.12	3.08	3.19
672+00	3.91	3.86	3.92
674+00	6.04	5.99	6.00
675+00	6.49	6.50	6.49
675+45	6.41	6.42	6.40
675+63	6.37	6.49	6.30
675+83	6.40	6.45	6.29
676+00	5.13	5.22	5.03
676+17	5.10	5.19	5.01
676+48	5.12	5.22	5.01

OHIO DEPARTMENT OF TRANSPORTATION

SHEET NO. 8 of 11

PERSONNEL LUKE REED TITLE TR PERSONNEL WOOD TITLE WOOD COUNTY WOOD DATE 6-1-95

S. R. 65 WEATHER CLOUDY

SEC. 11.96 TEMP. 64

DESCRIPTION CHECK FOR INVERTED PAV'T JOB NO. 625019

LEFT CENTER LINE RIGHT

	WHITE LINE	YELLOW LINE	WHITE LINE
648+	4.35	4.12	$\frac{4.18}{3.0}$ 4.22
650+	5.469	4.49	$\frac{4.53}{5.5}$ 4.58
652+	4.77	4.78	5.05
654+	5.25	5.19	5.29
656+	6.73	6.54	6.53
658+	7.05	7.03	7.07
658+50	7.45	7.45	7.44
658+75	8.07	8.09	8.05
659+	8.36	8.22	8.19
659+23	8.48	8.25	8.22
659+47	8.25	8.09	8.20
660+	7.57	7.60	7.65
660+79	1.57		

1945WH

OHIO DEPARTMENT OF TRANSPORTATION

SHEET NO. 9 of 11

PERSONNEL

TITLE

PERSONNEL

TITLE

LUCAS
REEDT D
RCOUNTY WOODDATE 6-1-95

S. R.

65

WEATHER

LIGHT RAIN

SEC.

11.96

TEMP.

66°

DESCRIPTION

CHECK FOR INVERTEDPav'tJOB NO. 625019

LEFT

CENTER LINE

RIGHT

WHITE
LINEYELLOW
LINEWHITE
LINE

634+00

5.07

5.10

5.35

635+00

4.70

4.81

4.95

635+50

4.58

4.56

4.71

635+93

4.30

4.35

4.35

636+39

4.12

4.15

4.06

636+55

4.03

4.09

4.06

636+80

3.97

4.00

3.93

637+0

3.96

3.90

3.85

637+17

3.93

3.88

3.85

637+55

3.95

3.91

3.86

638+

4.33

4.28

4.31

4.29

TITLE

下

RED

COUNTY Wood

எஸ்

59

SEC.

11,96

TEMP.

660

CHECK FOR INVERTED PAV'T

CENTER LINE

RIGHT

JOB NO. 625019

[illegible]

OHIO DEPARTMENT OF TRANSPORTATION

SHEET NO. 11 of 11

PERSONNEL TITLE PERSONNEL TITLE
LUCIE REED π ϕ COUNTY Wood DATE 6-1-95
S. R. 65 WEATHER Cloudy
SEC. 11.96 TEMP. 63°

DESCRIPTION CHECK FOR INVERTED Pav't CENTER LINE RIGHT
LEFT

	WHITE LINE	YELLOW LINE	WHITE LINE
603+92	5.00	4.71	4.63
605+08	4.75	4.59	4.55
605+58	5.35	4.80	4.47
606+00	5.41	4.82	4.37
608+00	5.30	5.11	4.83
608+70	5.09	5.08	4.99
610+00	5.65	5.50	5.63
612+00	6.23	6.17	6.39
614+00	2.45	2.33	2.58
616+00	6.42	6.36	6.56
618+00	2.60	2.42	2.67
620+0	5.51	5.37	5.55