

O.D.O.T. DISTRICT 2 SURVEY OFFICE

PERSONNEL _____

REFERENCE NO. 1.A

SHEET _____ OF _____

NOTES _____

H.C. _____

DATE _____

ROUTE SR 64

R.C. _____

WEATHER _____

COUNTY WOOD

TEMP. _____

TOWNSHIP Center

SECTION 20

T S N R 11 E


TYPE MONUMENT Monument Box

ON SURFACE - BELOW 2"


LEFT- & PAV'T. - RIGHT _____

4.5 TO RT. EDGE PAVEMENT (White Line)

S.L.M. 30+94

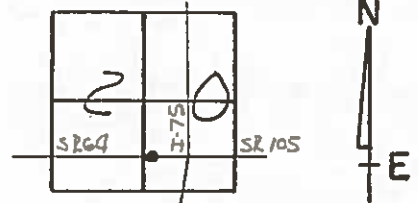

Notes: DID NOT OPEN MON. BOX

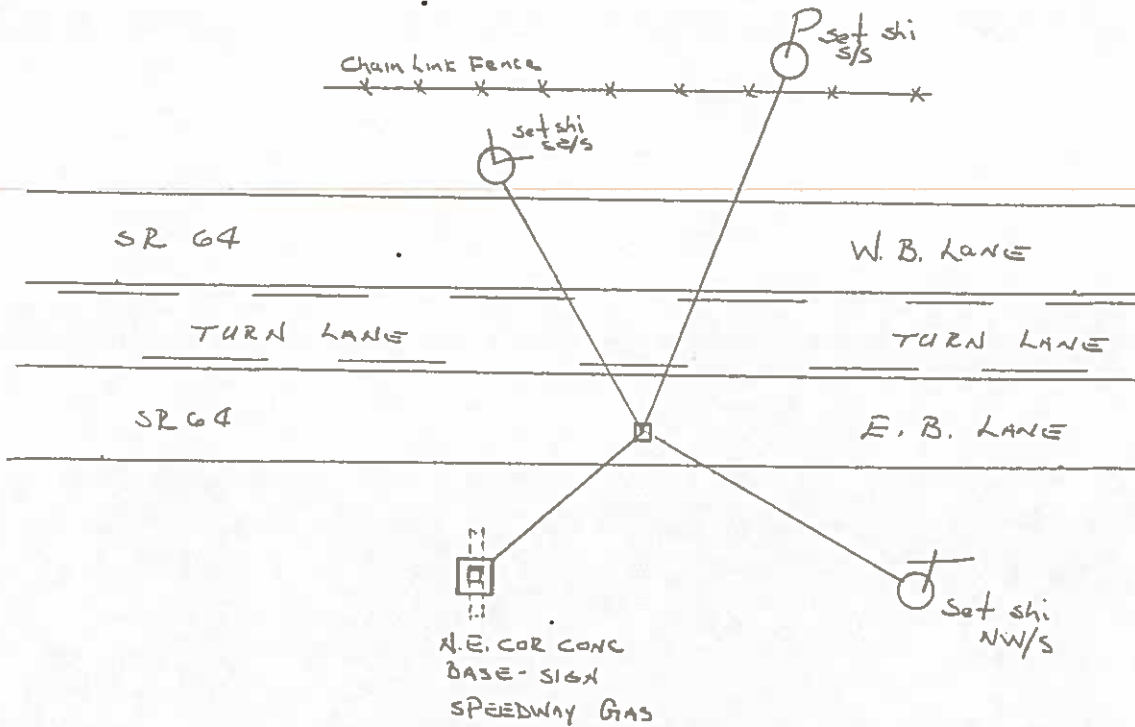

O.D.O.T. DISTRICT 2 SURVEY OFFICE

SHEET _____ OF _____

County WOOD S.R. 64

Date 6-14-71

Township CENTER

Weather CLOUDY

Section 20

Temp. 70°

T5N, R1E


Personnel BURNSIDE

SMITH

BOWERS

HOLCOMBE

ROCCHINI

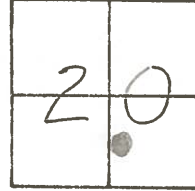

#1-A

