

O.D.O.T. DISTRICT 2 SURVEY OFFICE (USE ONLY)

PERSONNEL

REFERENCE NO. 3 H

SHEET 13 OF 24

NOTES HOFFMAN

DATE 4/6/88

ROUTE SR 64

H.C. LOEHRKE

WEATHER OVERCAST

COUNTY WOOD

R.C. BARNHISEL

TEMP. 60°

TOWNSHIP CENTER

SECTION 19

DWG BY NIESE

PID _____

T 5 N R 11 E

TYPE MONUMENT P.K.

ON SURFACE - ~~BELOW~~ ON

OFFSET CL PAVEMENT ON LT : RT

- TO - EDGE PAVEMENT


STATION: 75+27

HORZ. DATUM: _____

GEOID: _____


GRID: NORTHING: _____

EASTING: _____

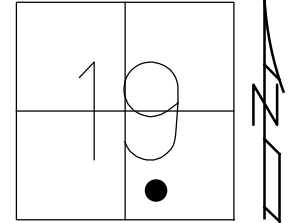

RECORD:
P.K.NAIL
SET BY CITY
4/26/84
FD P.K.NAIL
4/6/88, CL
SET P.K./WASHER
6/10/88, SWN

ROGERS QUADRANGLE

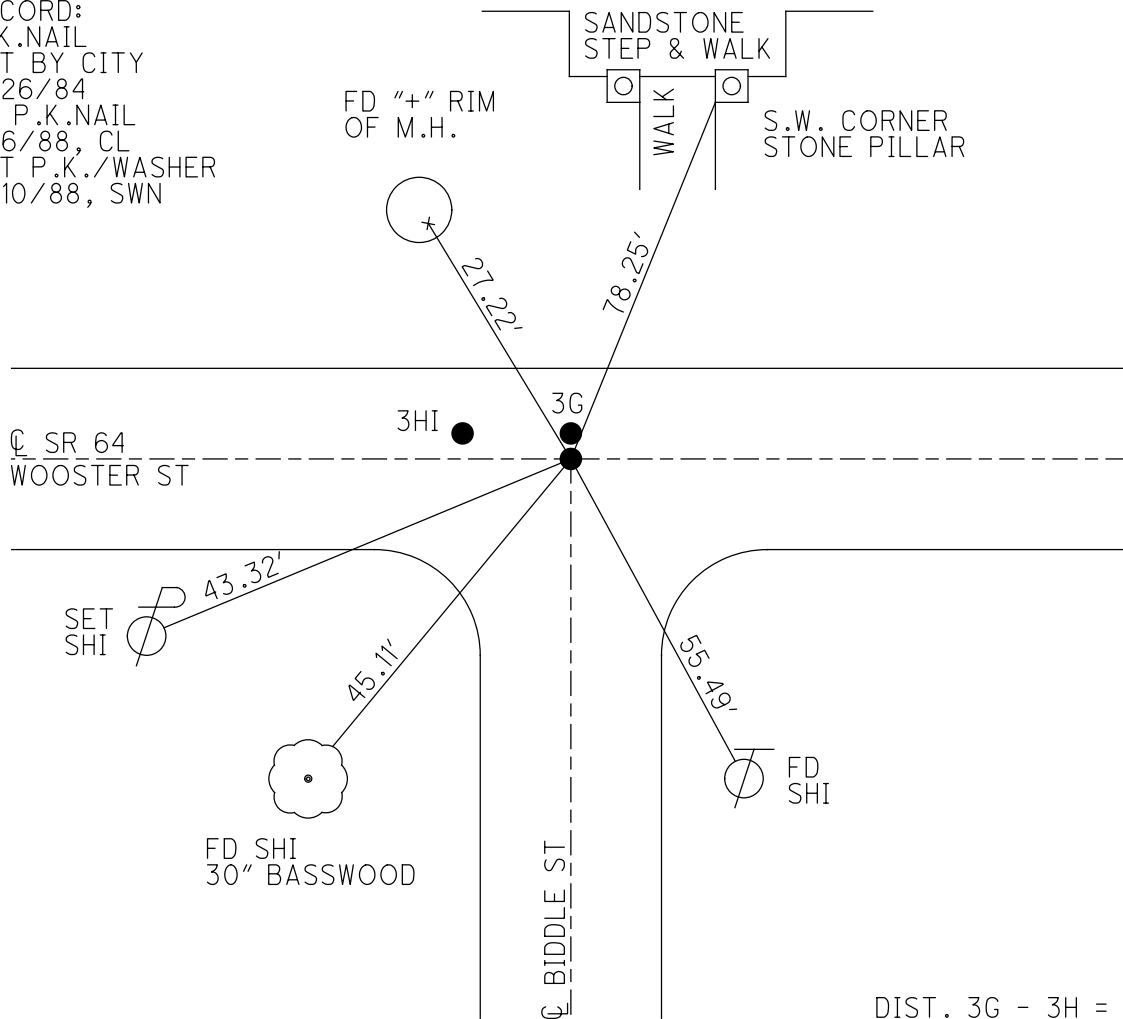

O.D.O.T. DISTRICT 2 SURVEY OFFICE

PERSONNEL

REFERENCE NO. 36, 3H, 3HI SHEET OF

NOTES HOFFMAN

H.C. LOEHRKE

R.G. BARNHISEL

DATE 4-6-88

WEATHER OVERCAST

TEMP. 60°

ROUTE SR 64

COUNTY Wood

TOWNSHIP Center

SECTION 19

T 5 N R 11 E

TYPE MONUMENT P.K.'s
 ON SURFACE - BELOW
~~LEFT~~ & PAV'T. - ~~RIGHT~~ Both Points
 TO EDGE PAVEMENT
 S.L.M. 75+27 (EAST POINTS)


Set P.K./WASHER
 6-10-88 SWK

1	9
SR	64



NOTE: P.K. set by city
 ON & WOOSTER
 Ref. TIES 4-26-84

Set P.K./WASHER
 AT SOUTH EAST
 POINT ONLY

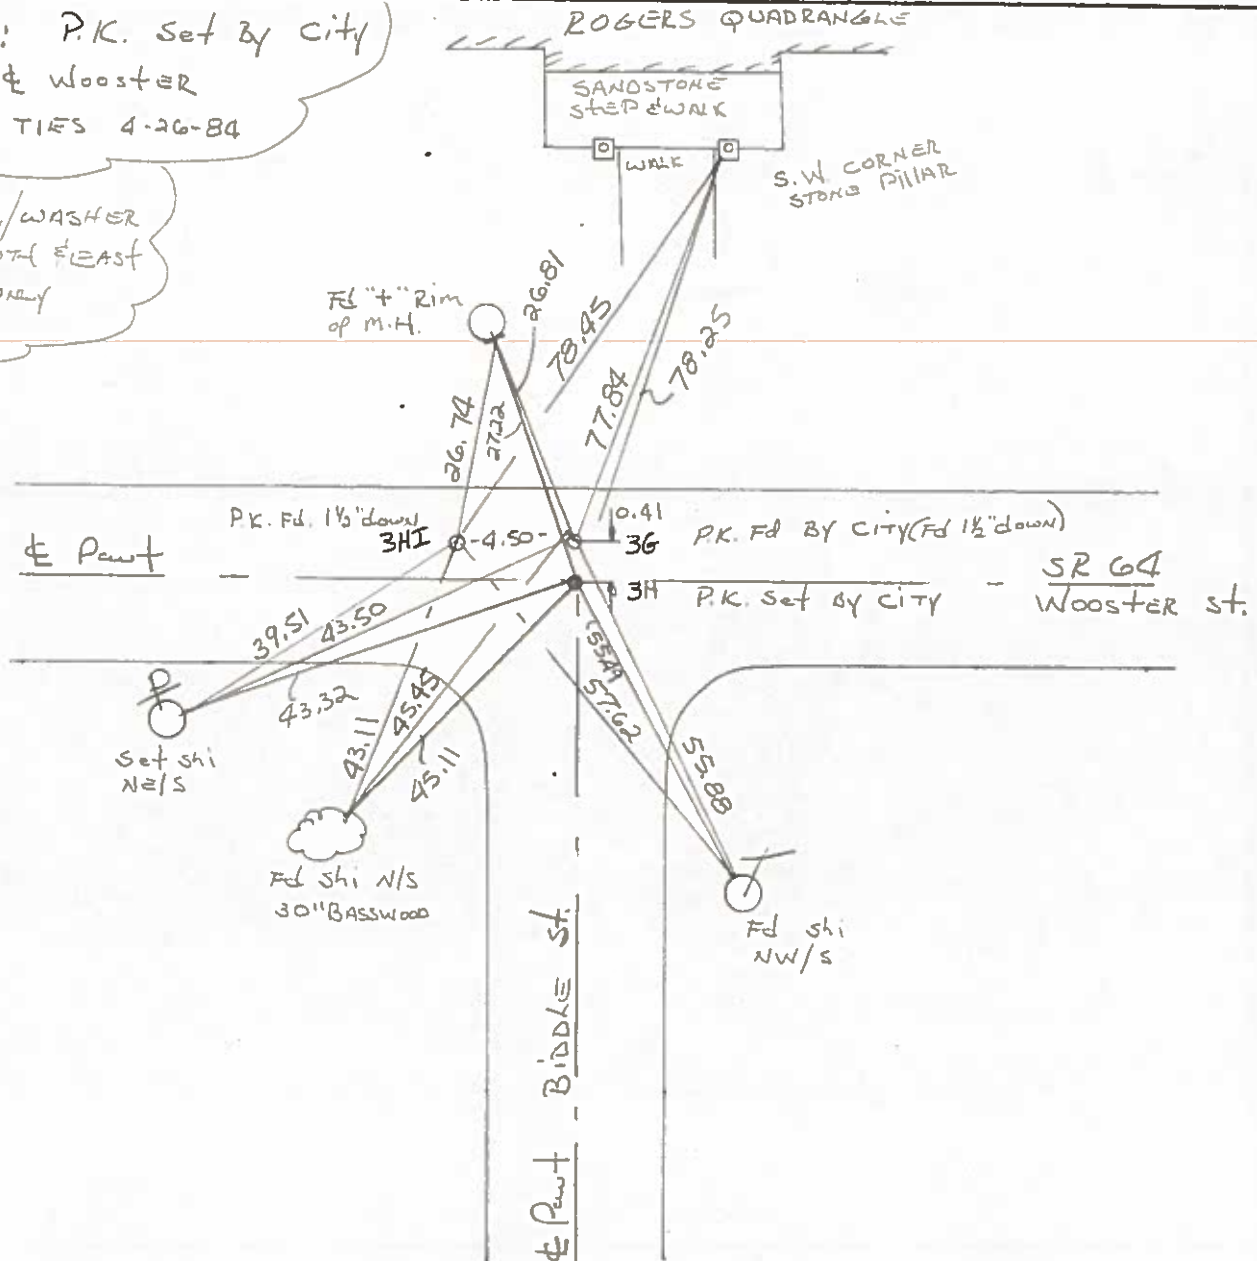

County WOOD S.R. 64

Date 9-13-79

Township CENTER B.G. CORP.


Weather CLOUDY

Section 19

Temp. +78°

T5N, R11E

Personnel BURNSIDE
SMITH
BOWERS
MEAD

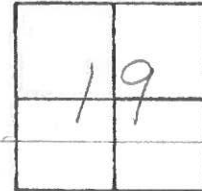

ED. P.K. NAILS
SURFACE

