

O.D.O.T. DISTRICT 2 SURVEY OFFICE (USE ONLY)

PERSONNEL

REFERENCE NO. 3 I

SHEET 15 OF 24

NOTES HOFFMAN

DATE 4/6/88

ROUTE SR 64

H.C. LOEHRKE

WEATHER OVERCAST

COUNTY WOOD

R.C. BARNHISEL

TEMP. 60°

TOWNSHIP CENTER

SECTION 19

DWG BY NIESE PID _____

T 5 N R 11 E

TYPE MONUMENT R.R. SPIKE W/ "+"

ON SURFACE - ~~BELOW~~ ON


OFFSET CL PAVEMENT ON LT : RT

15.8' TO RT EDGE PAVEMENT


STATION: 78+91

HORZ.DATUM: _____ GEOID: _____

GRID: NORTHING: _____ EASTING: _____

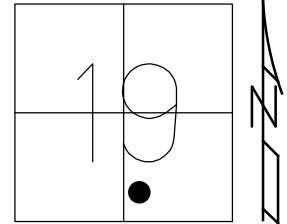

RECORD:
FD R.R. SPIKE W/ "+"
SET BY D. LAIRD
4/6/88, CL
SET P.K./WASHER
6/10/88, SWN

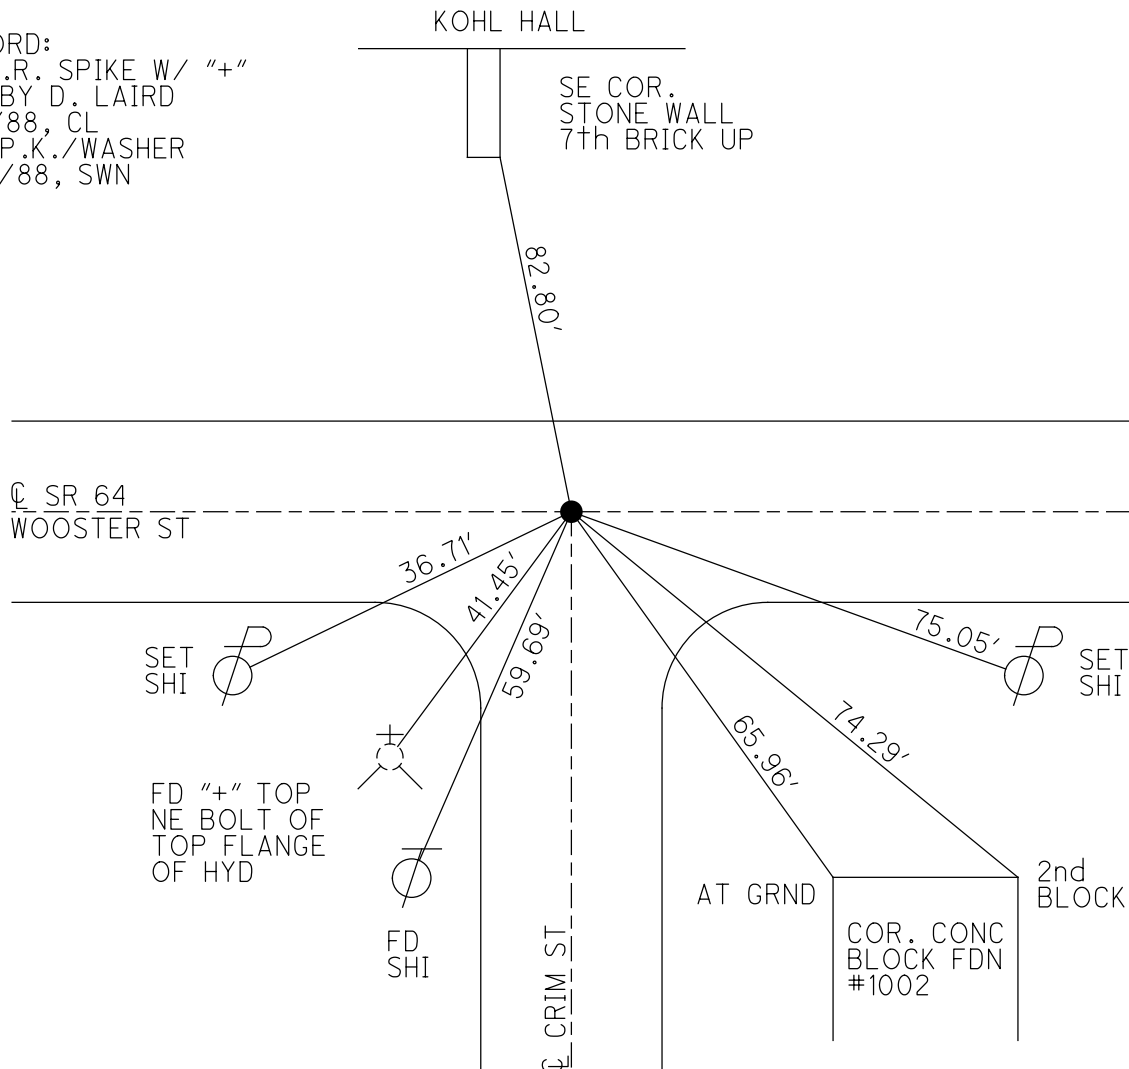

O.D.O.T. DISTRICT 2 SURVEY OFFICE

PERSONNEL

REFERENCE NO. 3T

SHEET _____ OF _____

NOTES HOFFMAN

H.C. LOEHLICE

DATE 4-6-88

ROUTE SR 64

R.C. BARHISEL

WEATHER OVERCAST

COUNTY Wood

TEMP. 60°

TOWNSHIP Center

SECTION 19

T. 5 N. R. 11 E

TYPE MONUMENT P.P. SPIKE / " + "


Set P.K. / washer?
6-10-88 SWM

ON SURFACE - ~~BELOW~~ YES


~~LEFT - & PAW'T. - RIGHT~~ Both Part's

15.8 TO RT EDGE PAVEMENT

S.L.M. 78 + 91

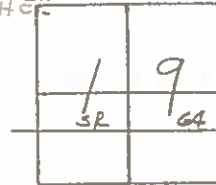

Set By D. LAIRD.

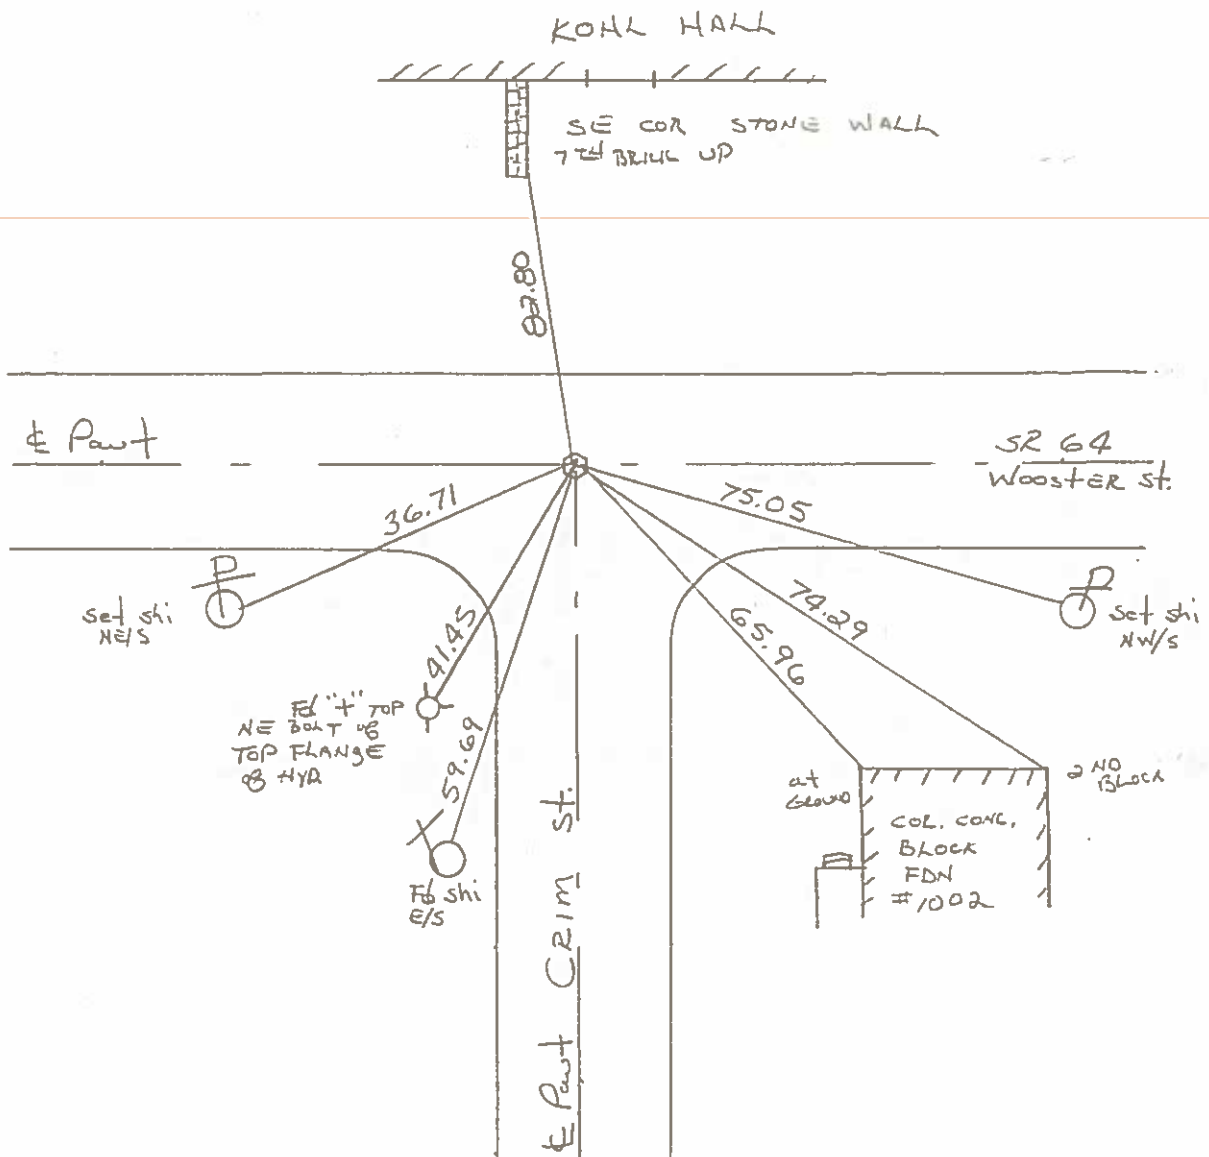

County WOOD S.R. 64

Date 9-13-79

Township CENTER B.G. CO. PA.

Weather CLOUDY

Section 19

Temp. +78°

T5N, R11E


Personnel BURNSIDE

SMITH


BOWERS

MEAD

3I

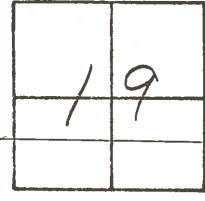

FD. P.K. NAIL
@ SURFACE

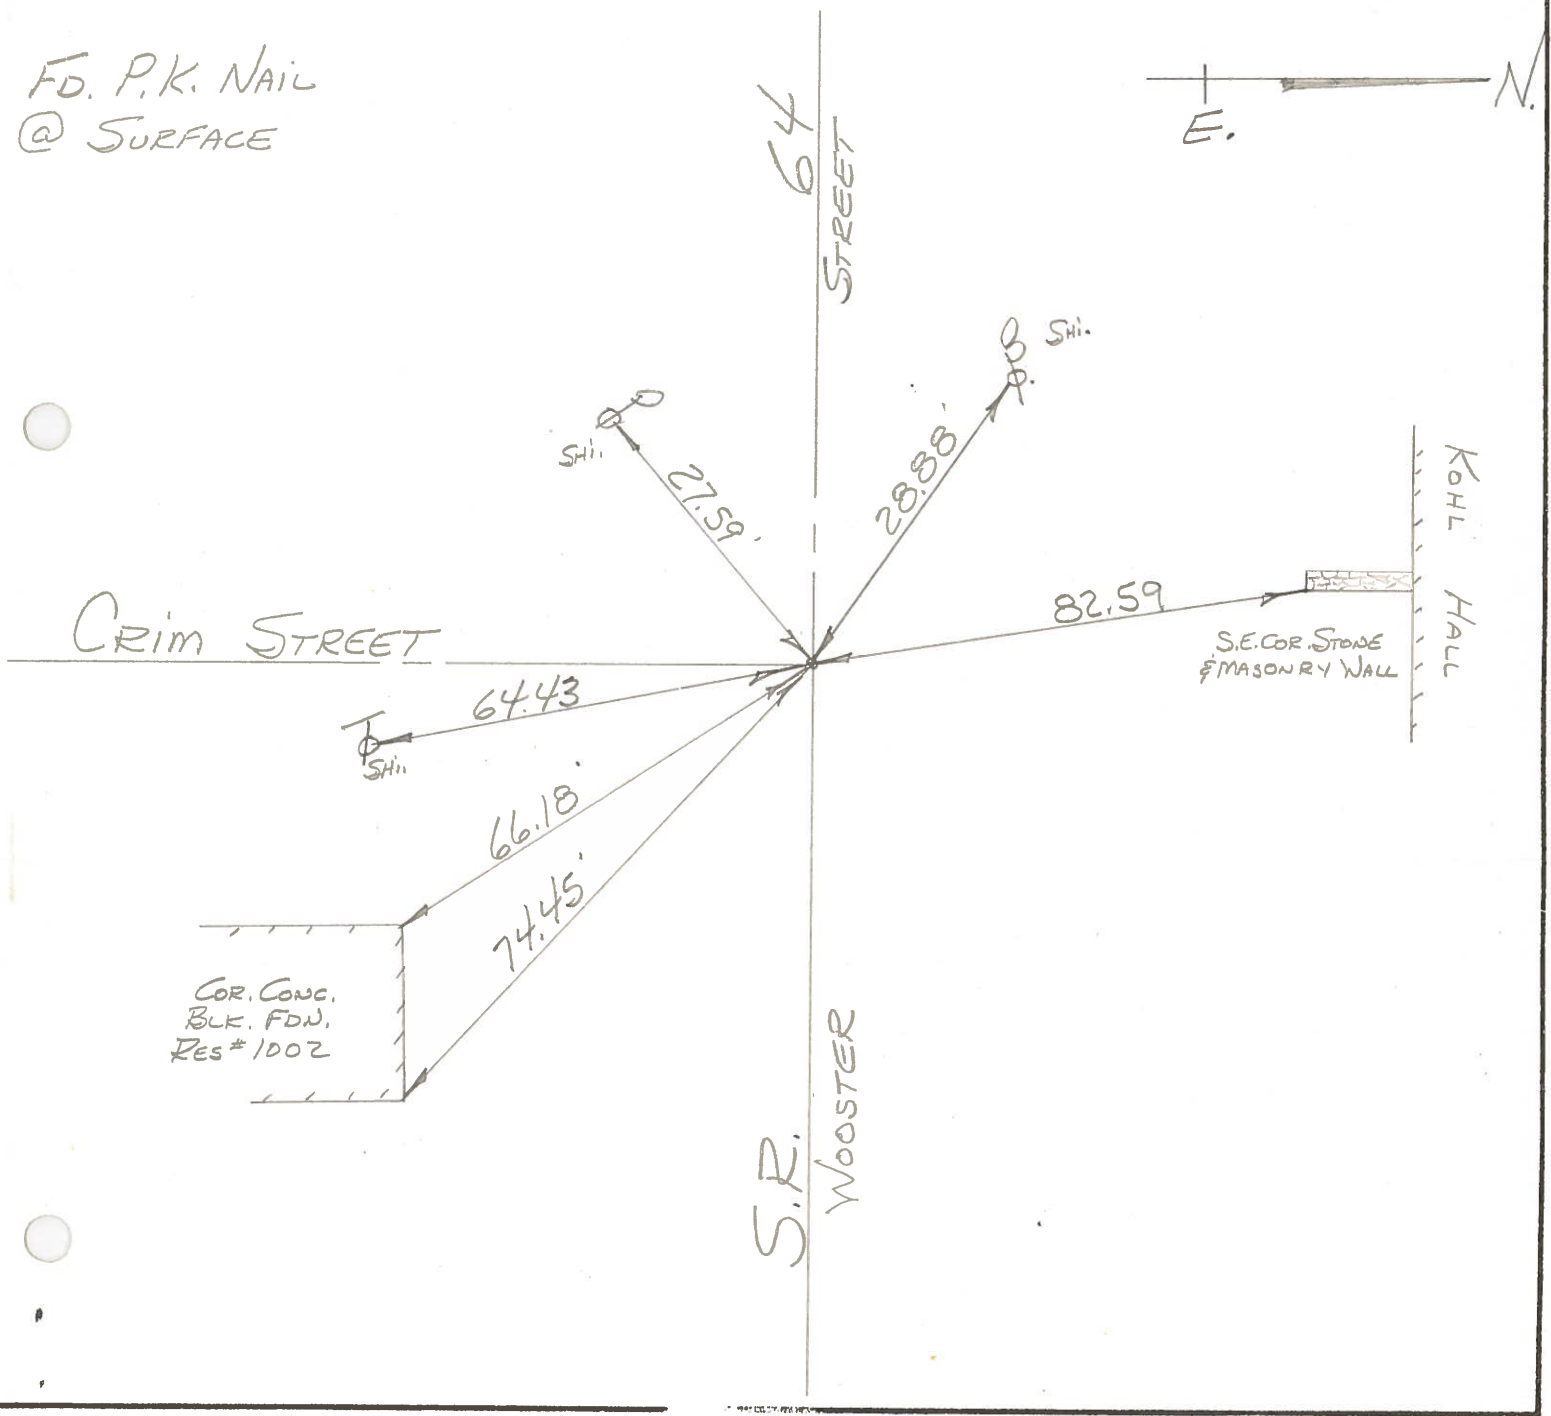

PERSONNEL	TITLE	PERSONNEL	TITLE	COUNTY	DATE	WEATHER	TEMP.
BURNSIDE		Rocchini	E.I.T.	WOOD	6-11-71	Pt. Cloudy	+75°
SMITH				S. R. 64 (OLD U.S. 6)			
BOWERS				SEC. BOWLING GREEN			
HOLCOMBE							

DESCRIPTION _____ LEFT _____ CENTER LINE _____ RIGHT _____ JOB NO. _____

