



O.D.O.T. DISTRICT 2 SURVEY OFFICE (USE ONLY)

PERSONNEL	REFERENCE NO. <u>3 J</u>	SHEET <u>16</u> OF <u>24</u>
NOTES <u>HOFFMAN</u>	DATE <u>4/6/88</u>	ROUTE <u>SR 64</u>
H.C. <u>LOEHRKE</u>	WEATHER <u>OVERCAST</u>	COUNTY <u>WOOD</u>
R.C. <u>BARNHISEL</u>	TEMP. <u>60°</u>	TOWNSHIP <u>CENTER</u>
		SECTION <u>19</u>
DWG BY <u>NIESE</u>	PID _____	T <u>5</u> N R <u>11</u> E

TYPE MONUMENT P.K. NAIL  
 ON SURFACE - ~~BELOW~~ ON  
 OFFSET  $\odot$  PAVEMENT 0.2' LT : ~~RT~~  
- TO - EDGE PAVEMENT  
 STATION: 82+74  
 HORZ. DATUM: \_\_\_\_\_ GEOID: \_\_\_\_\_  
 GRID: NORTHING: \_\_\_\_\_ EASTING: \_\_\_\_\_

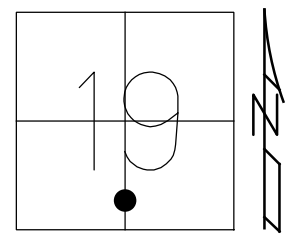

RECORD: P.I.  
 CONSTRUCTION P.I.  
 $\Delta = 00^{\circ}35'00''$  LT  
 OLD STA = 673+36.90  
 SET BY D LAIRD  
 11/82  
 FD P.K. NAIL  
 4/6/88, CL  
 SET P.K./WASHER  
 6/10/88, SWN

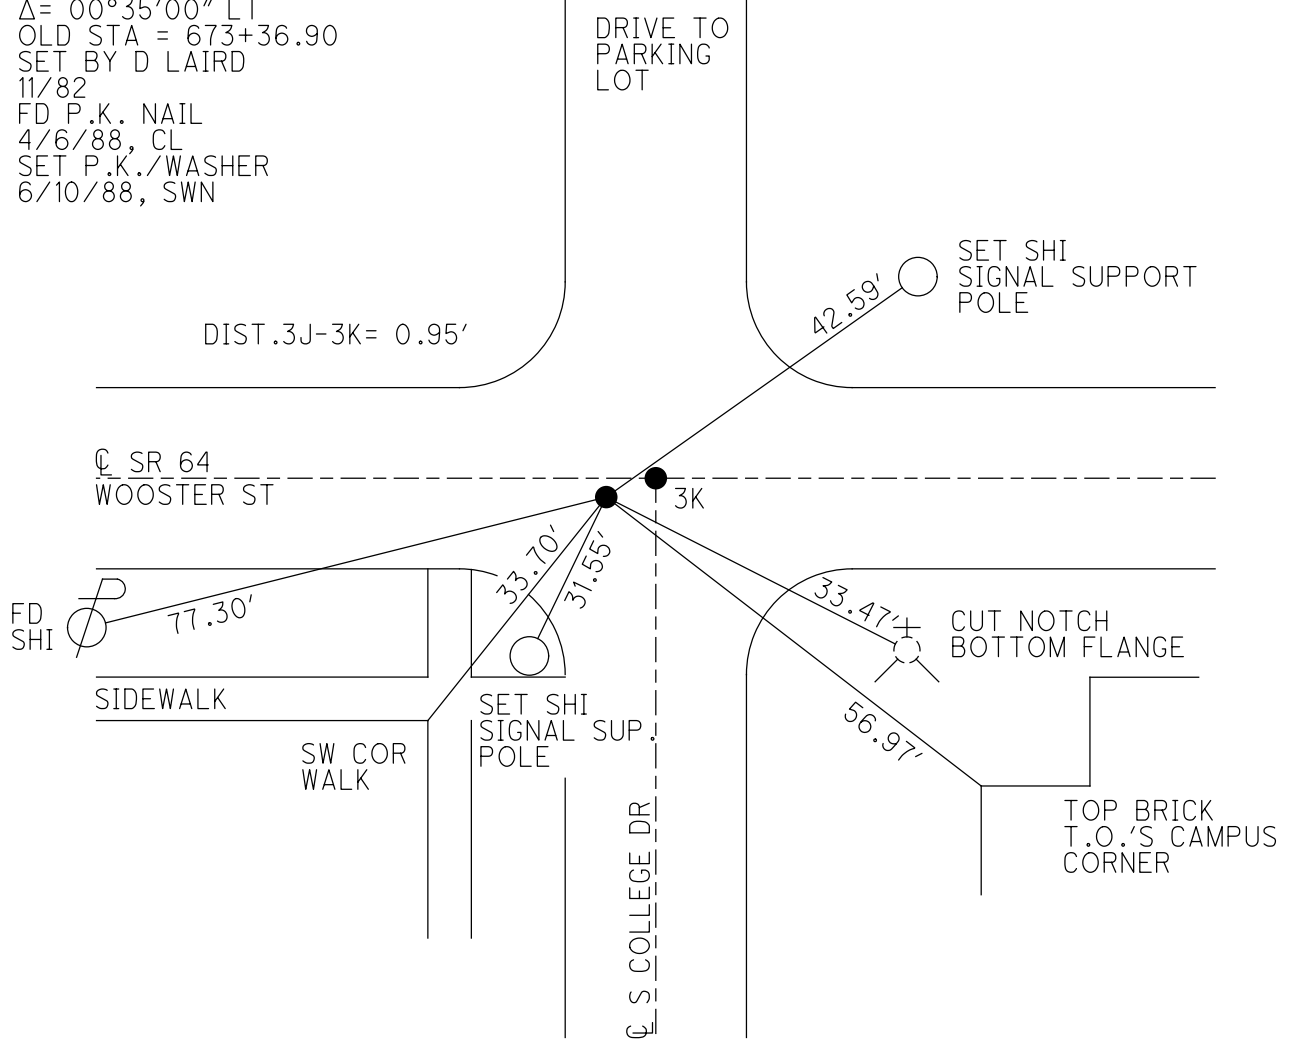

# O.D.O.T. DISTRICT 2 SURVEY OFFICE

PERSONNEL

REFERENCE NO. 3J

SHEET \_\_\_\_\_ OF \_\_\_\_\_

NOTES HOFFMAN

H.C. LOEBERS

R.G. BARNHISEL

DATE 4-6-88

WEATHER OVERCAST

TEMP. 60°

ROUTE SR 64

COUNTY WOOD

TOWNSHIP Center

SECTION 19

TS N R 11 E

TYPE MONUMENT P.K. Nail

ON SURFACE - BELOW YES

~~LEFT~~ - & PAV'T. - RIGHT 0.2

TO EDGE PAVEMENT

S.L.M. 82+74


Set P.K. WASHER  
6-10-88 SWK

1	9
SR	64



Record!  
CONSTRUCTION P.I.  
 $\Delta = 0^\circ - 35' \text{ Lt}$   
OLD STA. = 673+36.90

Set BY D. LAIRD 11-82

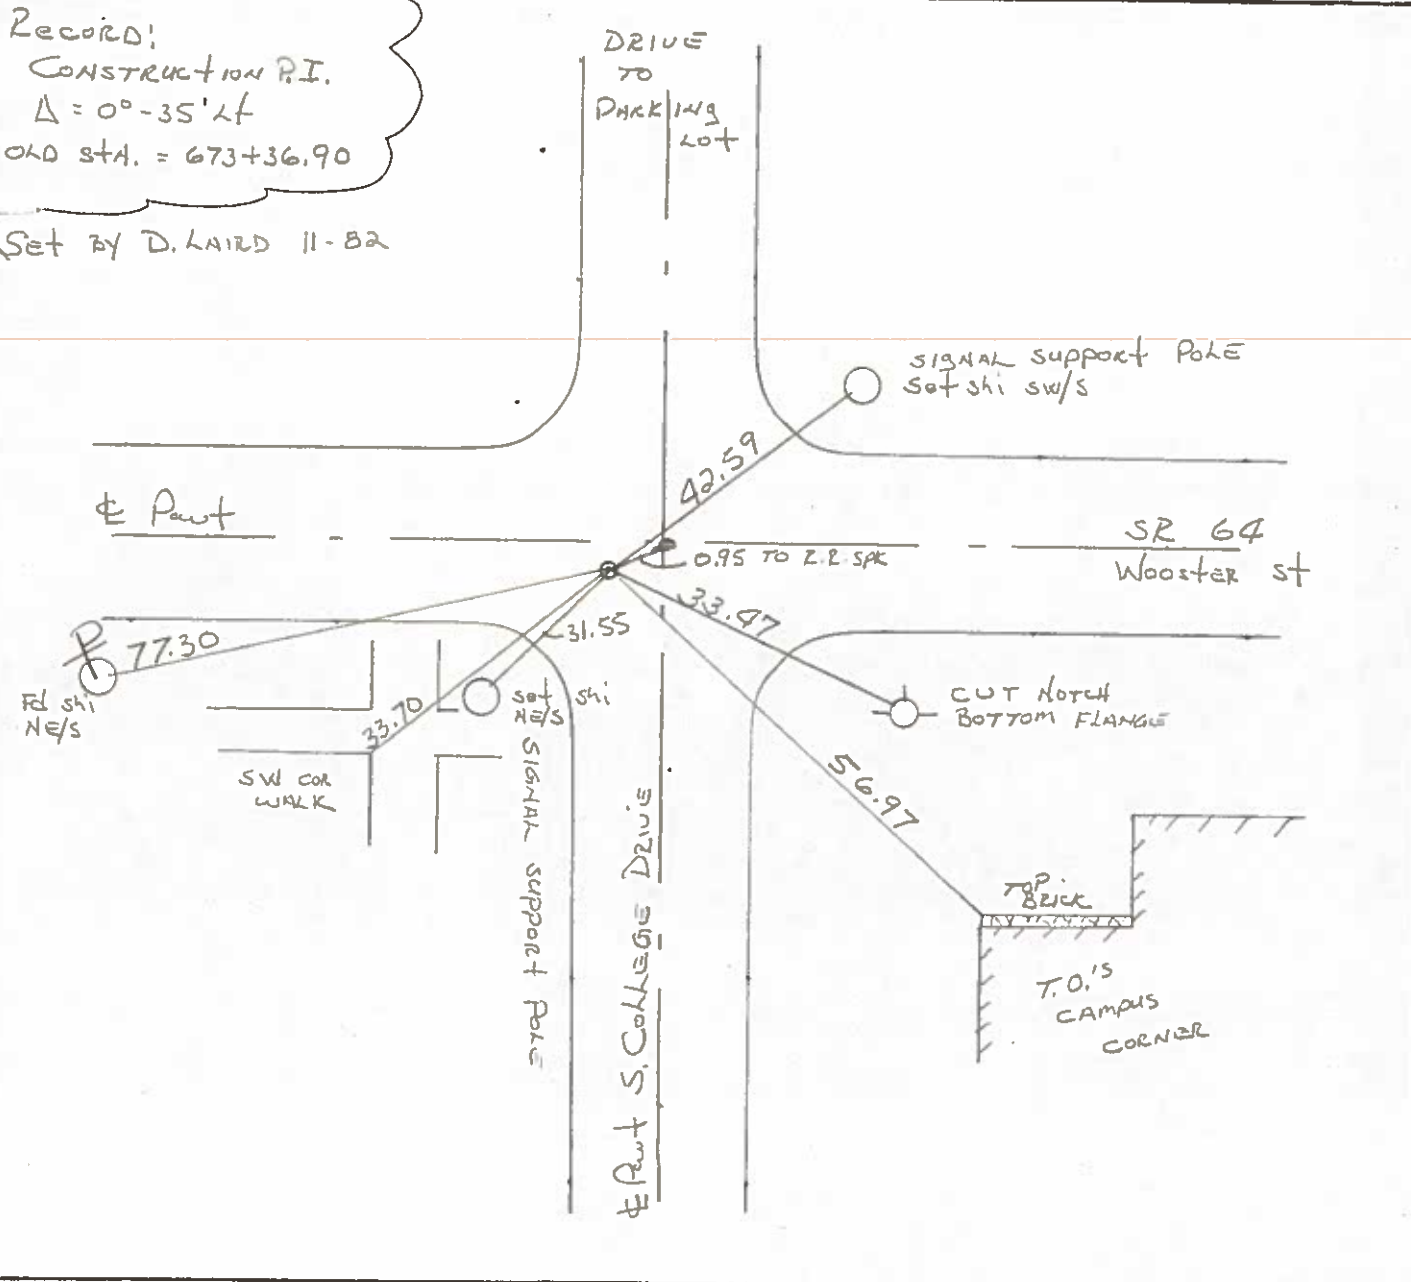

County WOOD S.R. 64

Date 9-13-79

Township CENTER (B.G. CORP.)

Weather CLOUDY

Section 19


Temp. +78°

T5N, R11E

Personnel BURNSIDE  
SMITH  
BOWERS  
MEAD

~~3K~~  
3J

19	
S.R.	64

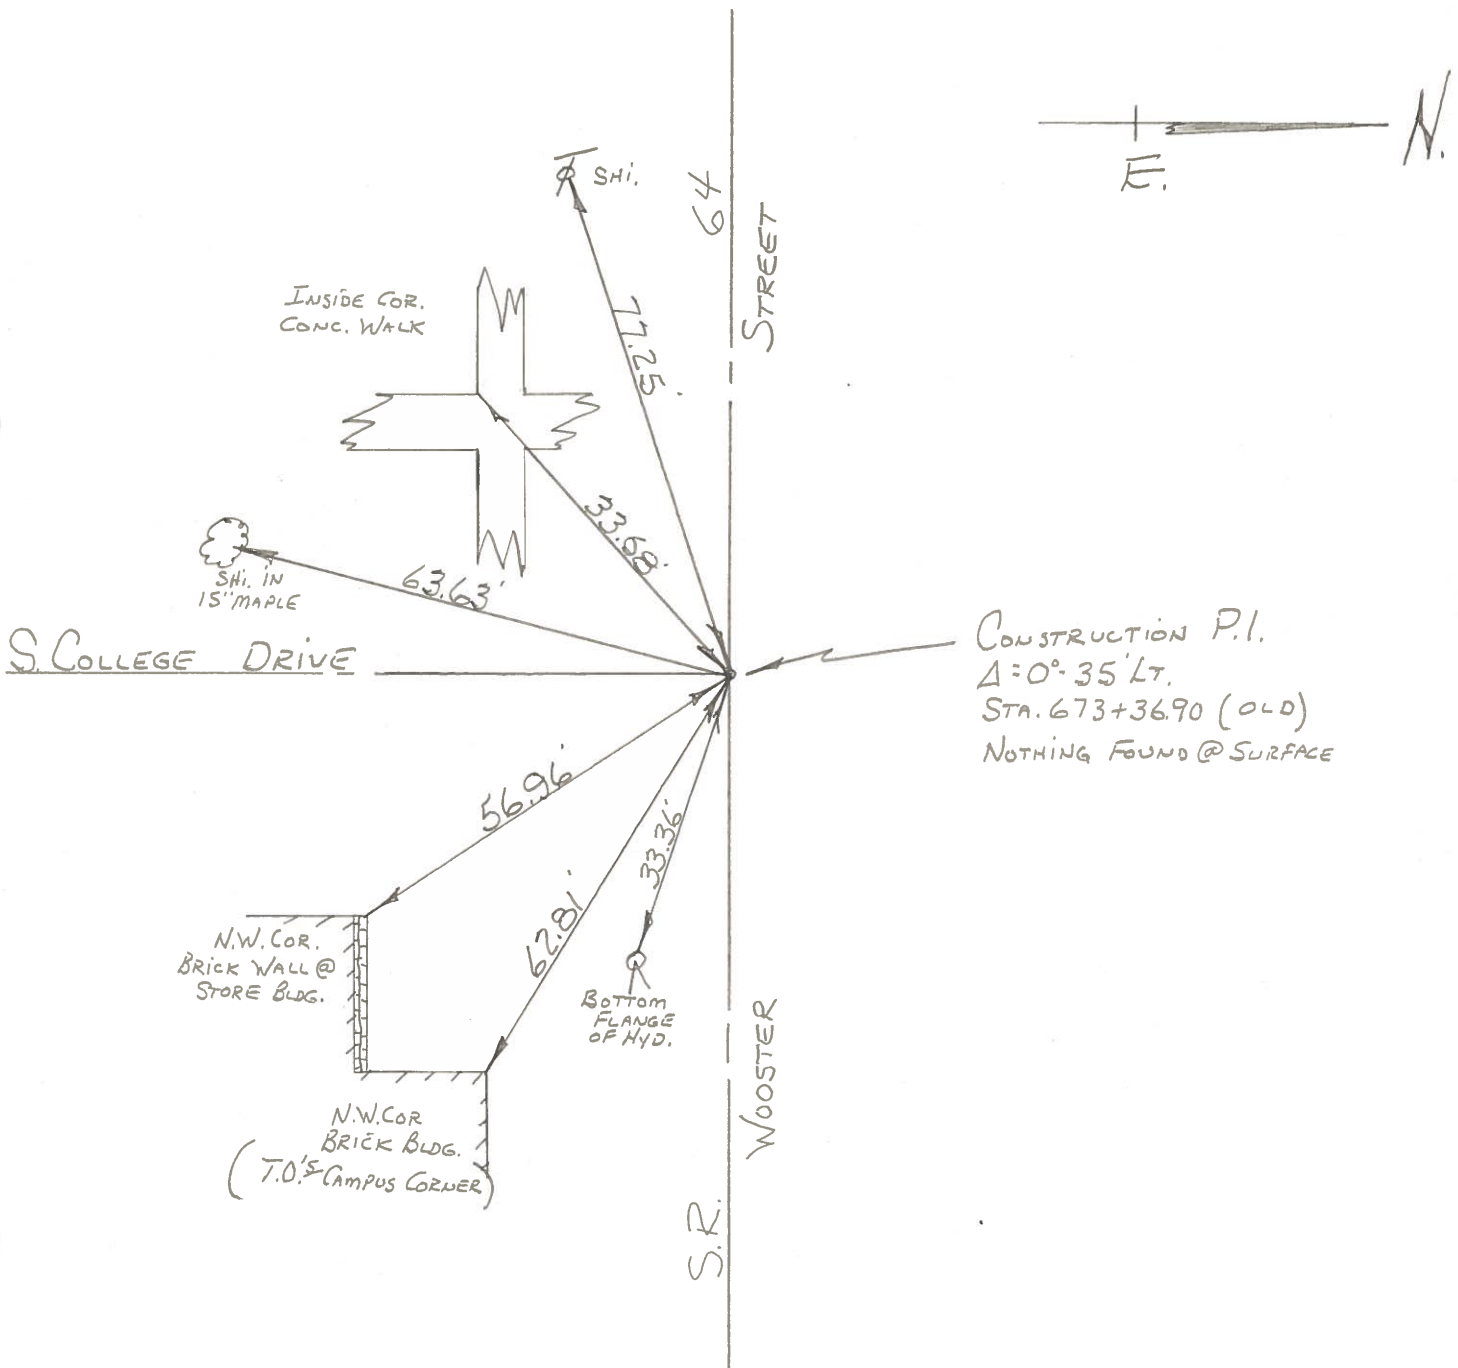

PERSONNEL	TITLE	PERSONNEL	TITLE

COUNTY WOOD DATE 6-11-71  
 S. R. 64 (OLD U.S.6) WEATHER CLEAR  
 SEC. BOWLING GREEN TEMP. +75°

DESCRIPTION \_\_\_\_\_ LEFT \_\_\_\_\_ CENTER LINE \_\_\_\_\_ RIGHT \_\_\_\_\_ JOB NO. \_\_\_\_\_

