

O.D.O.T. DISTRICT 2 SURVEY OFFICE (USE ONLY)

PERSONNEL

REFERENCE NO. 3 K

SHEET 17 OF 24

NOTES HOFFMAN

DATE 4/6/88

ROUTE SR 64

H.C. LOEHRKE

WEATHER OVERCAST

COUNTY WOOD

R.C. BARNHISEL

TEMP. 60°

TOWNSHIP CENTER

SECTION 19

DWG BY NIESE

PID _____

T 5 N R 11 E

TYPE MONUMENT R.R. SPIKE W/ "+"

ON SURFACE - ~~BELOW~~ ON

OFFSET Q PAVEMENT ON LT : RT

- TO - EDGE PAVEMENT


STATION: 82+73

HORZ. DATUM: _____

GEOID: _____

GRID: NORTHING: _____

EASTING: _____

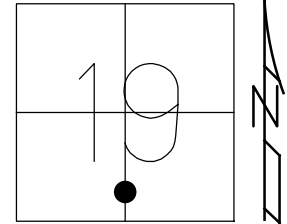

RECORD:
 SET BY D LAIRD
 11/82
 FD R.R. SPIKE W/ "+"
 4/6/88, CL
 SET P.K./WASHER
 6/10/88, SWN

DRIVE TO
 PARKING
 LOT

DIST. 3J-3K= 0.95'

41.81' SET SHI
 SIGNAL SUPPORT
 POLE

Q SR 64
 WOOSTER ST

78.25'

3J

34.55'

32.30'

32.91'

FD
 SHI

SIDEWALK

SW COR
 WALK

SET SHI
 SIGNAL SUP.
 POLE

Q S COLLEGE DR

CUT NOTCH
 BOTTOM FLANGE

56.77'

TOP BRICK
 T.O.'S CAMPUS
 CORNER

O.D.O.T. DISTRICT 2 SURVEY OFFICE

PERSONNEL

REFERENCE NO. 3K

SHEET _____ OF _____

NOTES HOFFMAN

H.C. LOEHRKE

DATE 4-6-88

ROUTE SR 64

R.C. BARNHISEL

WEATHER OVERCAST

COUNTY WOOD

TEMP. 60°

TOWNSHIP Center

SECTION 19

T S N R I L E

TYPE MONUMENT P.I. SPIKE / "+"

ON SURFACE - BELOW yes

Set P.K. / WASHER
6-10-88 SWR

~~LEFT~~ & PAV'T. - RIGHT Both Points


TO EDGE PAVEMENT

S.L.M. 82+73

1	9
SR	64



Set BY D. LAIRD 11-82

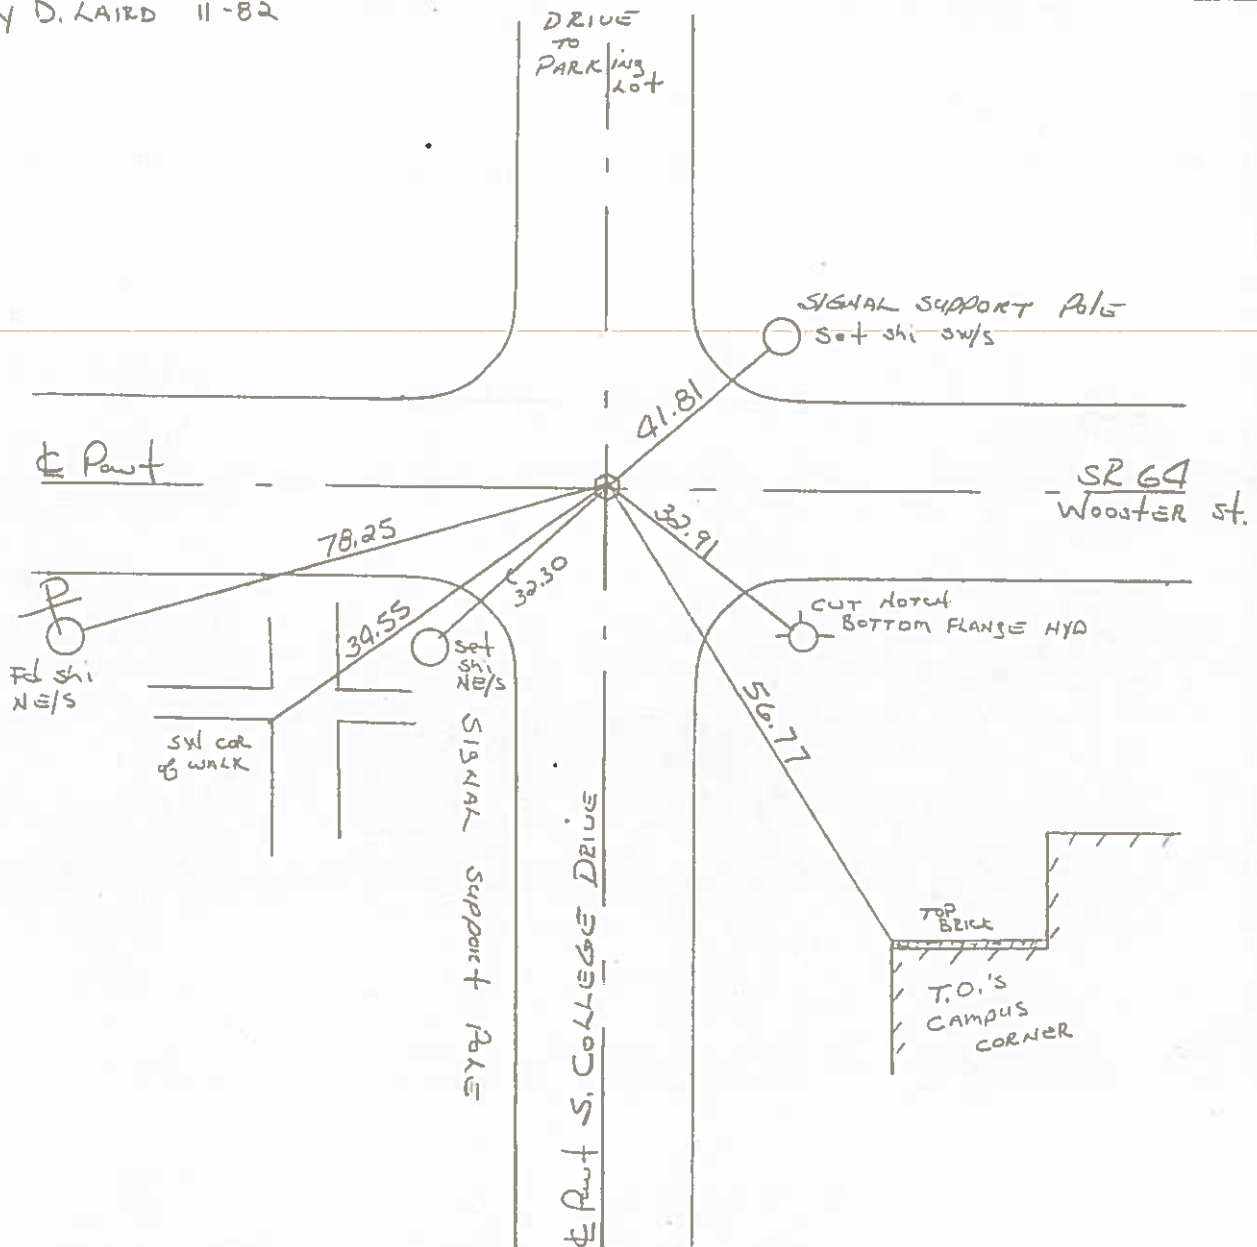

County WOOD S.R. 64

Date 9-13-79

Township CENTER B.G. CORP.

Weather CLOUDY

Section 19

Temp. +78°

T5N, R11E


Personnel BURNSIDE

SMITH


BOWERS

MEAD

3K

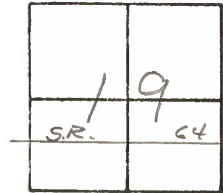


FD. P.K. NAIL
@ SURFACE

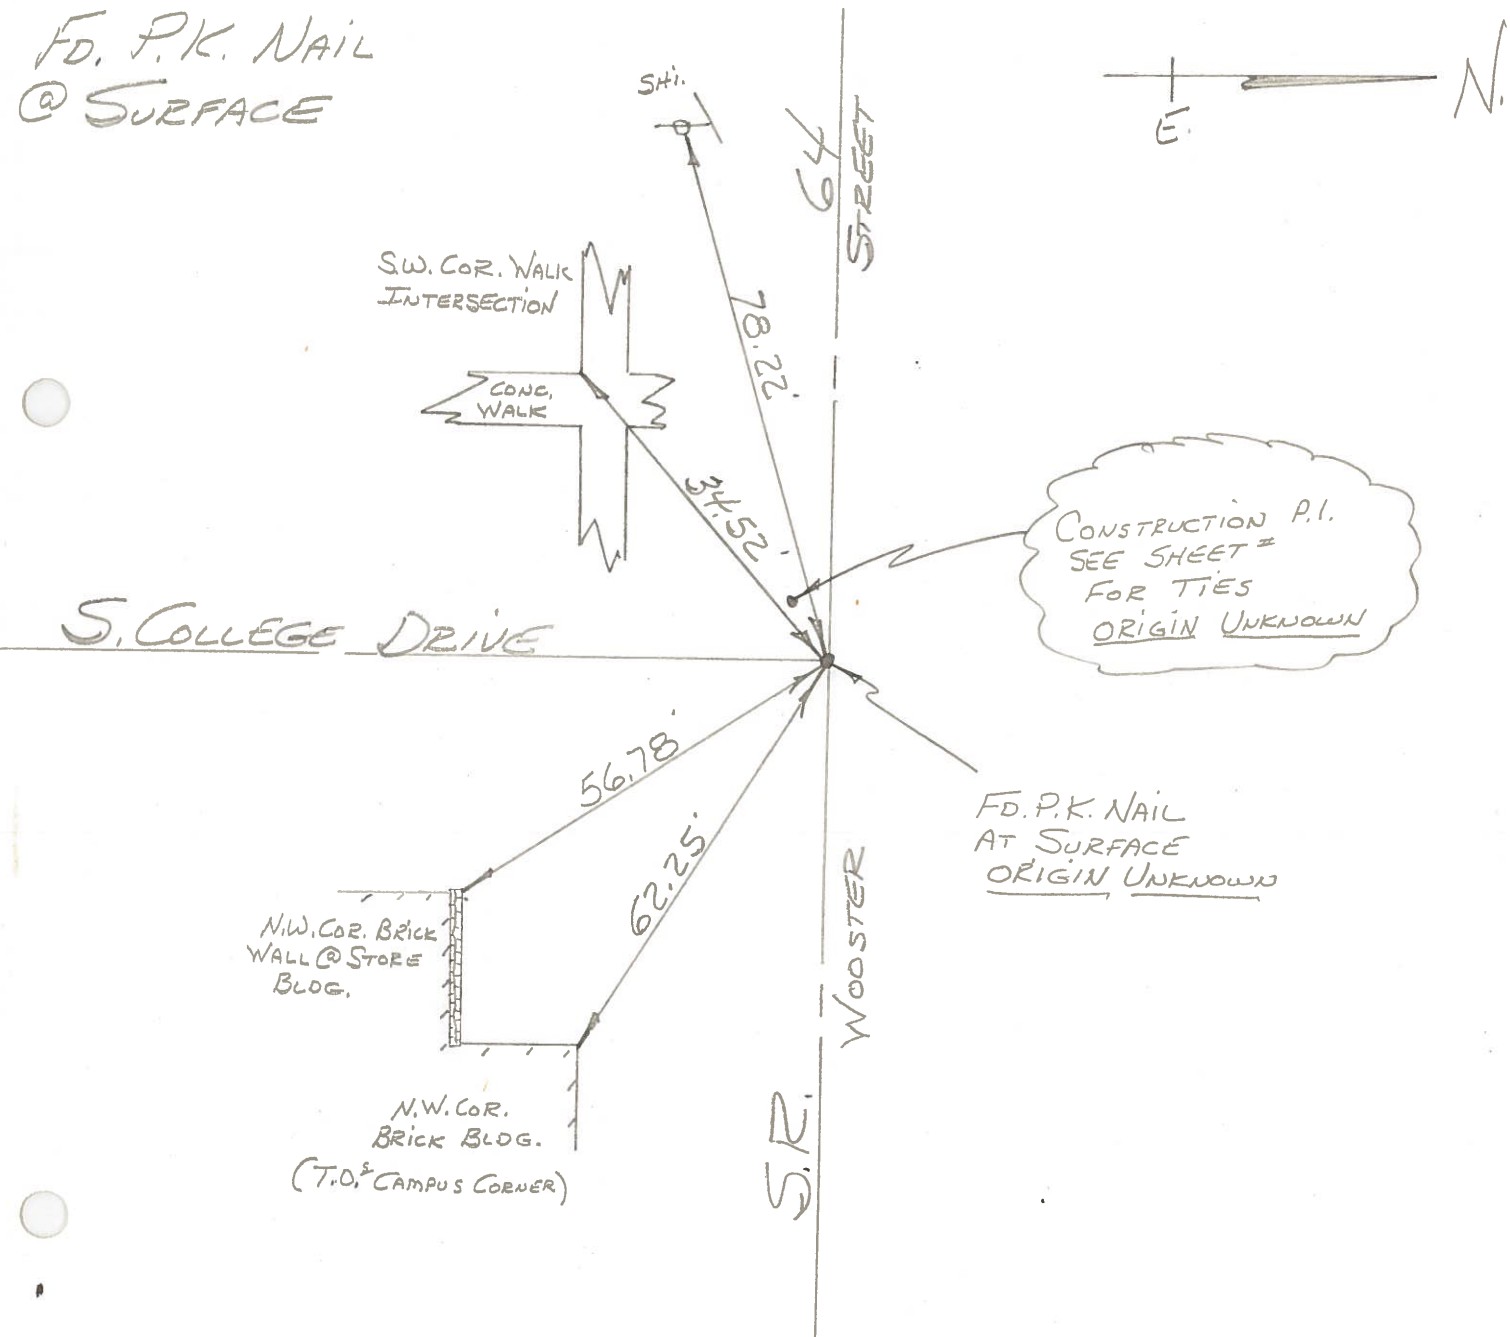

PERSONNEL	TITLE	PERSONNEL	TITLE
BURNSIDE		ROCCHINI	
SMITH			
BOWERS			
HOLCOMBE			

COUNTY Wood DATE CHECKED 6-14-71
 S. R. 64 (OLD U.S. 6) WEATHER Cloudy
 SEC. BOWLING GREEN TEMP. +75°

DESCRIPTION POINTS FOUND & TIED BY M. MORRISON (FOR BLK. TOP JOB) JOB NO. _____

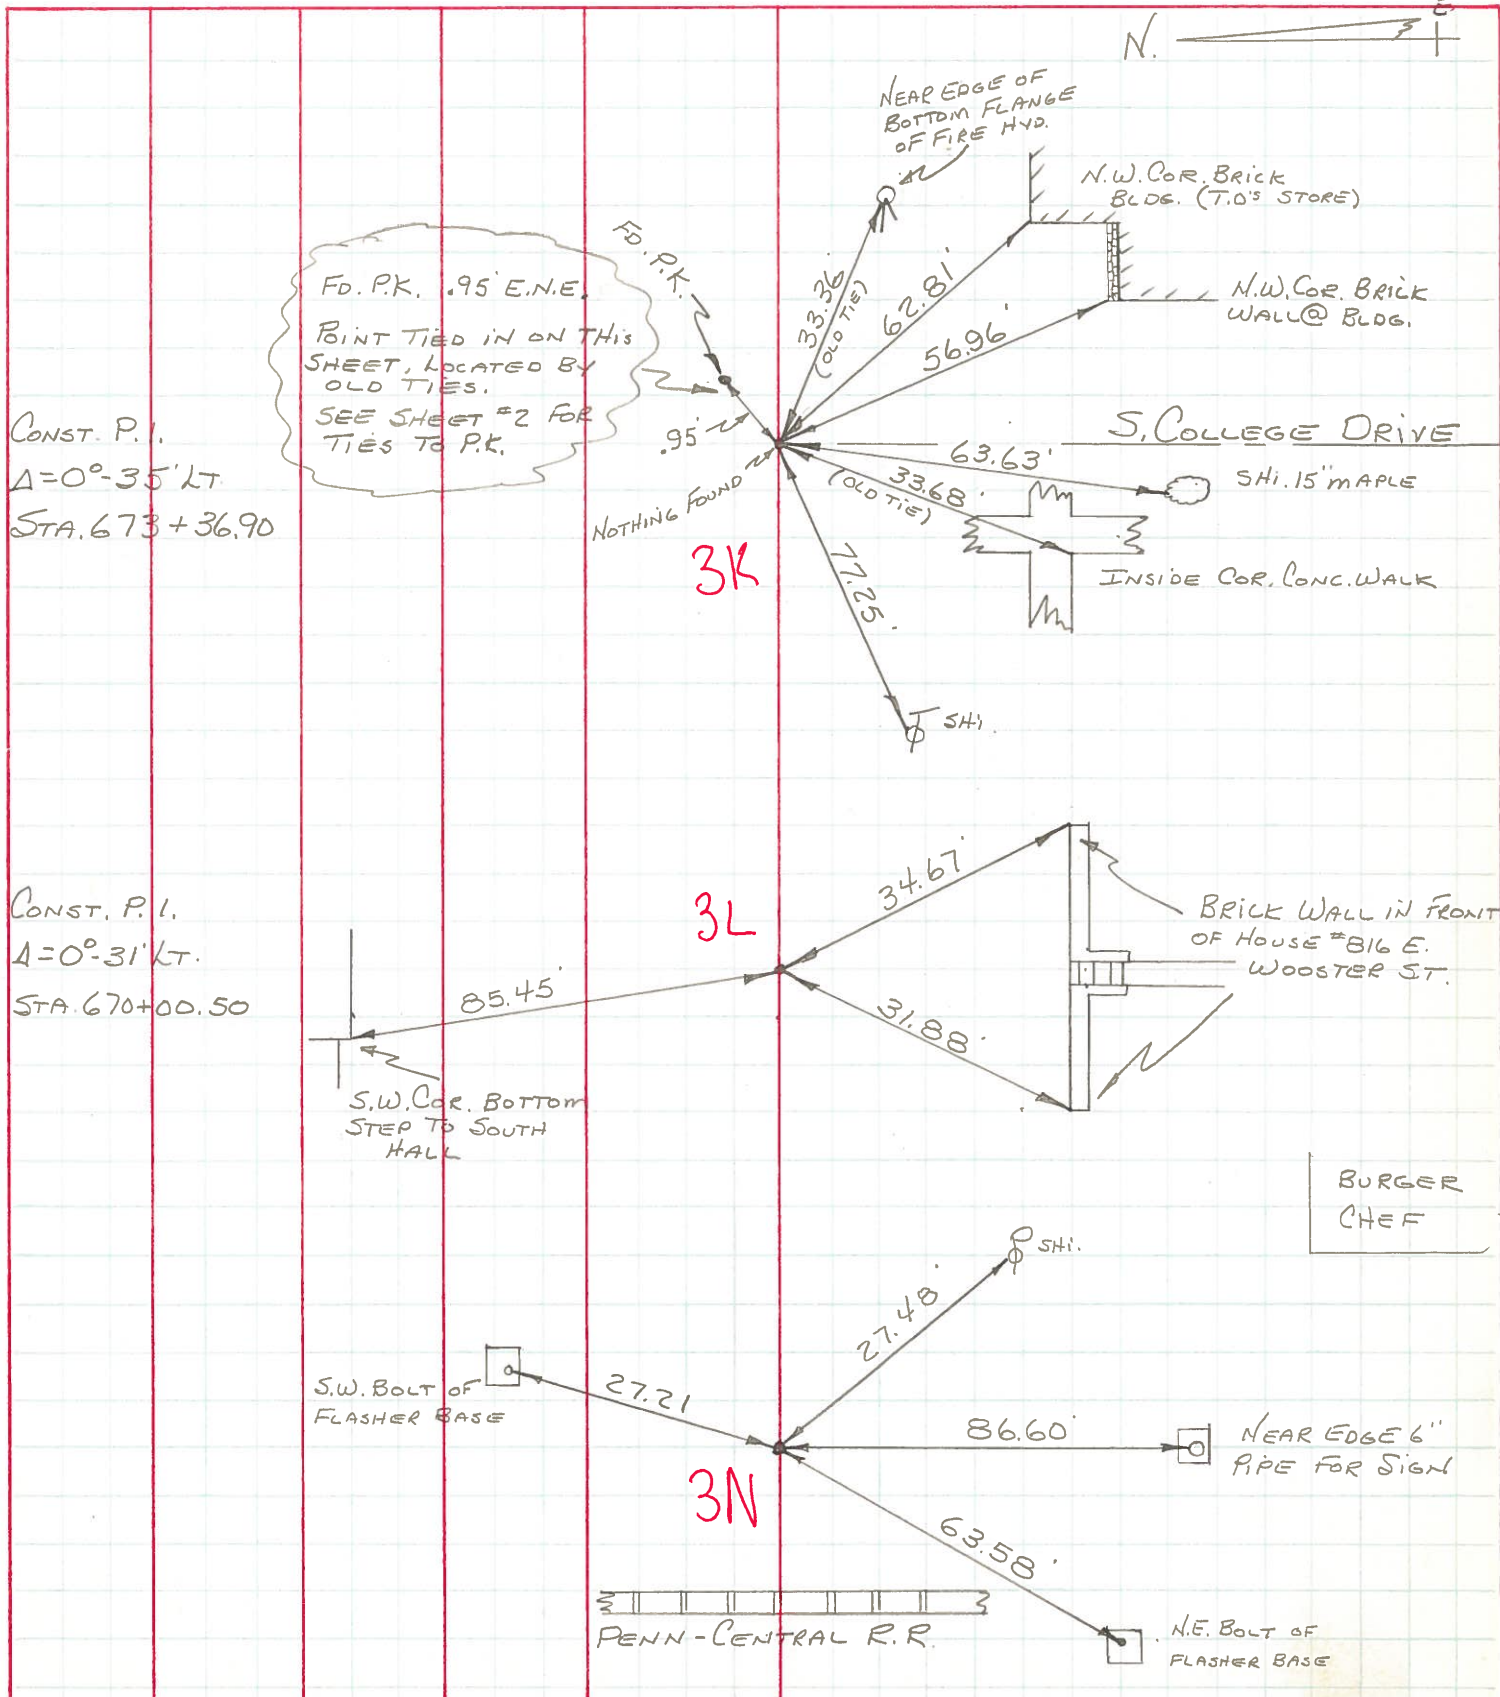

CONST. P. 1.
 $\Delta = 0^\circ - 35' \text{ LT}$
 STA. 673 + 36.90

CONST. P. 1.
 $\Delta = 0^\circ - 31' \text{ LT}$
 STA. 670 + 00.50

BURGER
 CHEF

PENN-CENTRAL R.R.