

O.D.O.T. DISTRICT 2 SURVEY OFFICE (USE ONLY)

PERSONNEL

REFERENCE NO. 3 N

SHEET 21 OF 24

NOTES HOFFMAN

DATE 4/7/88

ROUTE SR 64

H.C. LOEHRKE

WEATHER OVERCAST

COUNTY WOOD

R.C. BARNHISEL

TEMP. 43°

TOWNSHIP CENTER

REED

SECTION 19

DWG BY NIESE PID _____

T 5 N R 11 E

TYPE MONUMENT 1/2" IPIN

ON SURFACE - ~~BELOW~~ ON


OFFSET ☐ PAVEMENT ON LT : RT

16.1' TO RT EDGE PAVEMENT


STATION: 97+19

HORIZ.DATUM: _____ GEOID: _____

GRID: NORTHING: _____ EASTING: _____

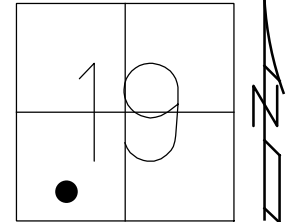

RECORD:
 FD 1/2" IPIN
 4/7/88, CL
 SET P.K./WASHER
 6/10/88, SWN

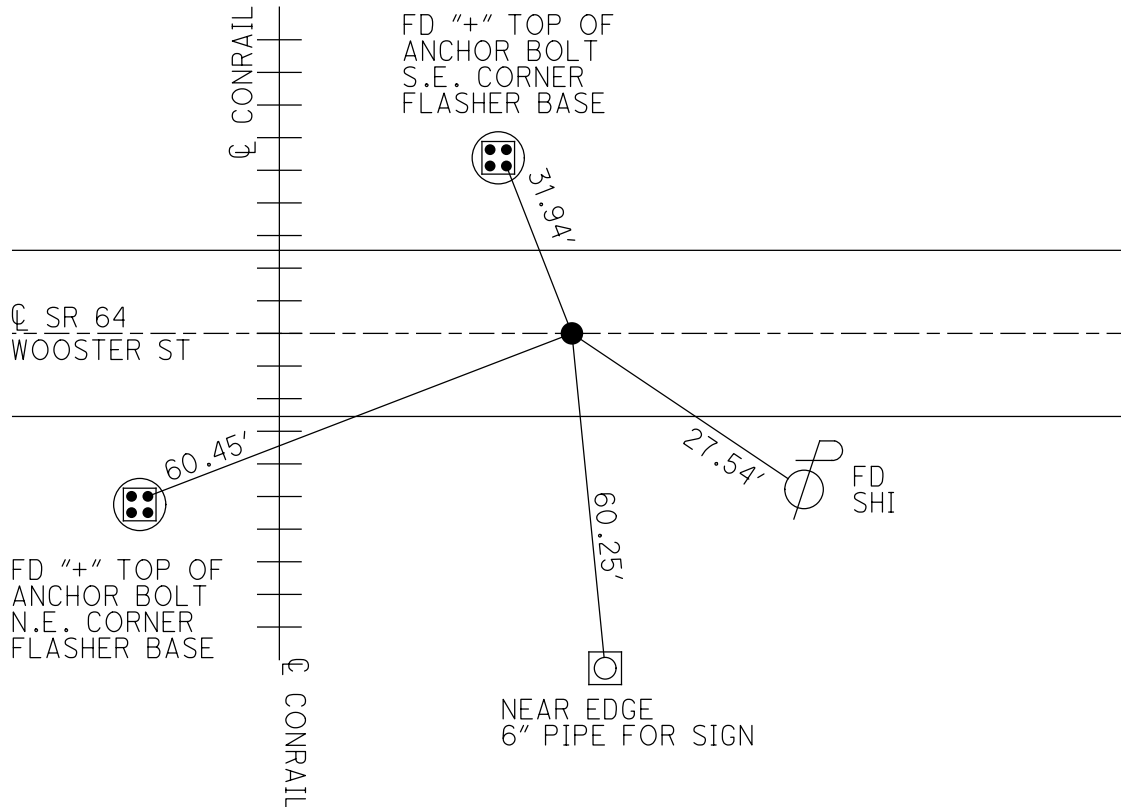

O.D.O.T. DISTRICT 2 SURVEY OFFICE

PERSONNEL

REFERENCE NO. 3N

SHEET _____ OF _____

NOTES HOFFMAN

H.C. LOEHLER

DATE 4-7-88

ROUTE SR 64

R.C. BARNHISEL

WEATHER OVERCAST

COUNTY WOOD

REED

TEMP. 43°

TOWNSHIP Center

SECTION 19

T S N R 11 E

TYPE MONUMENT 1/2" ROD

*Set PK/WASHER
6-10-88 SWK*


ON SURFACE - BELOW yes

LEFT- & PAV'T. - RIGHT yes

16.1 TO RT. EDGE PAVEMENT

S.L.M. 97+19

1	9
SR	64

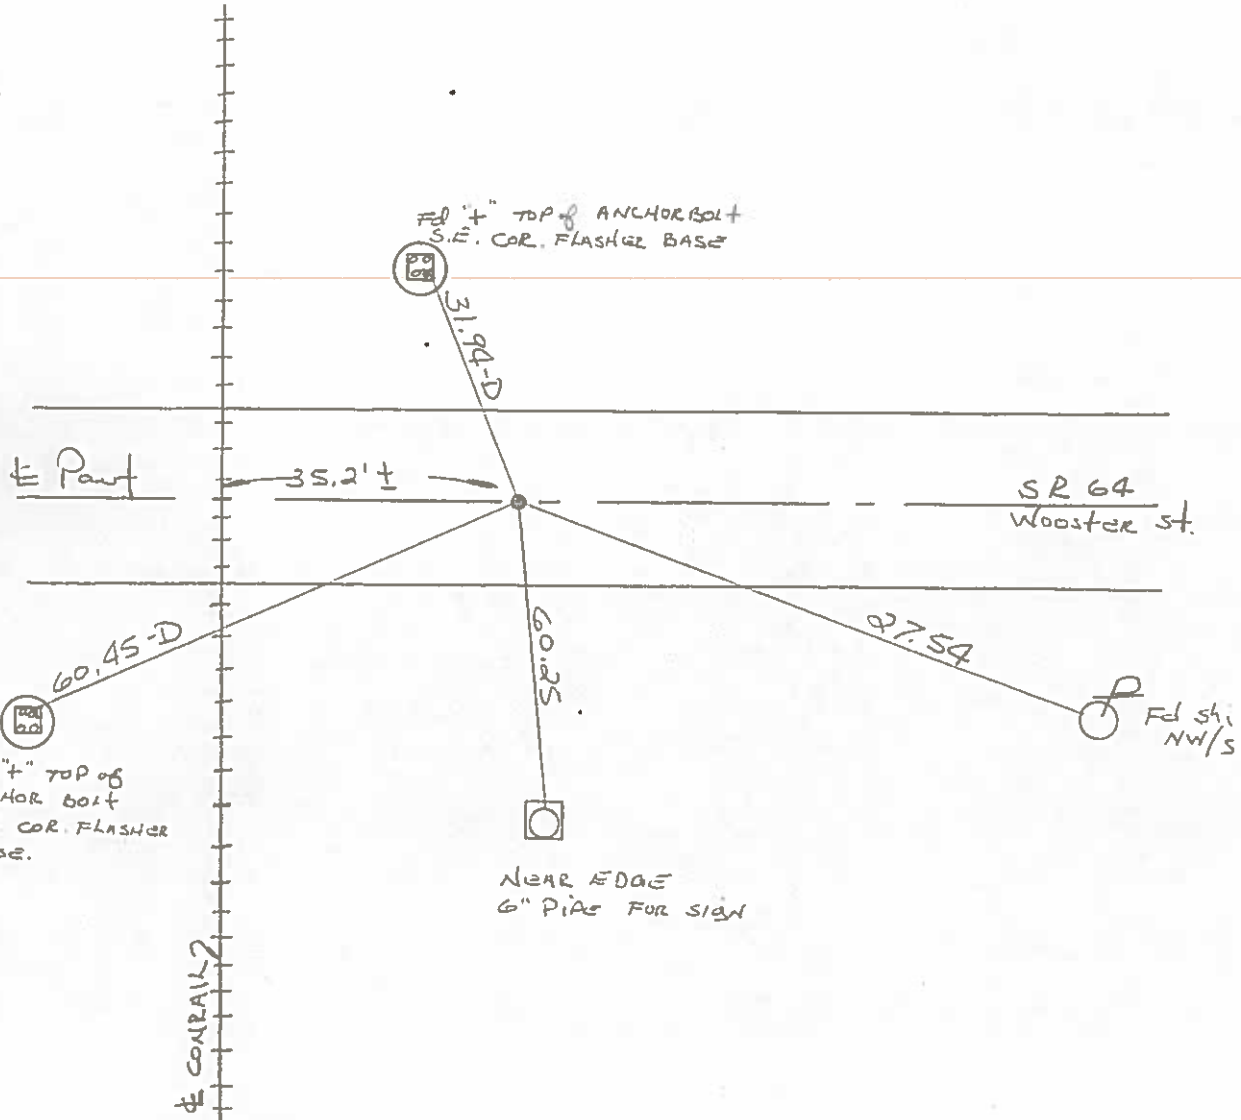

County WOOD S.R. 64

Date 6-14-71

Township CENTER (B.G. CORP.)

Weather CLOUDY

Section 19

Temp. +75°

T5N, R1E

Personnel BURNSIDE



SMITH

BOWERS

HOLCOMBE

ROCCHINI

3N

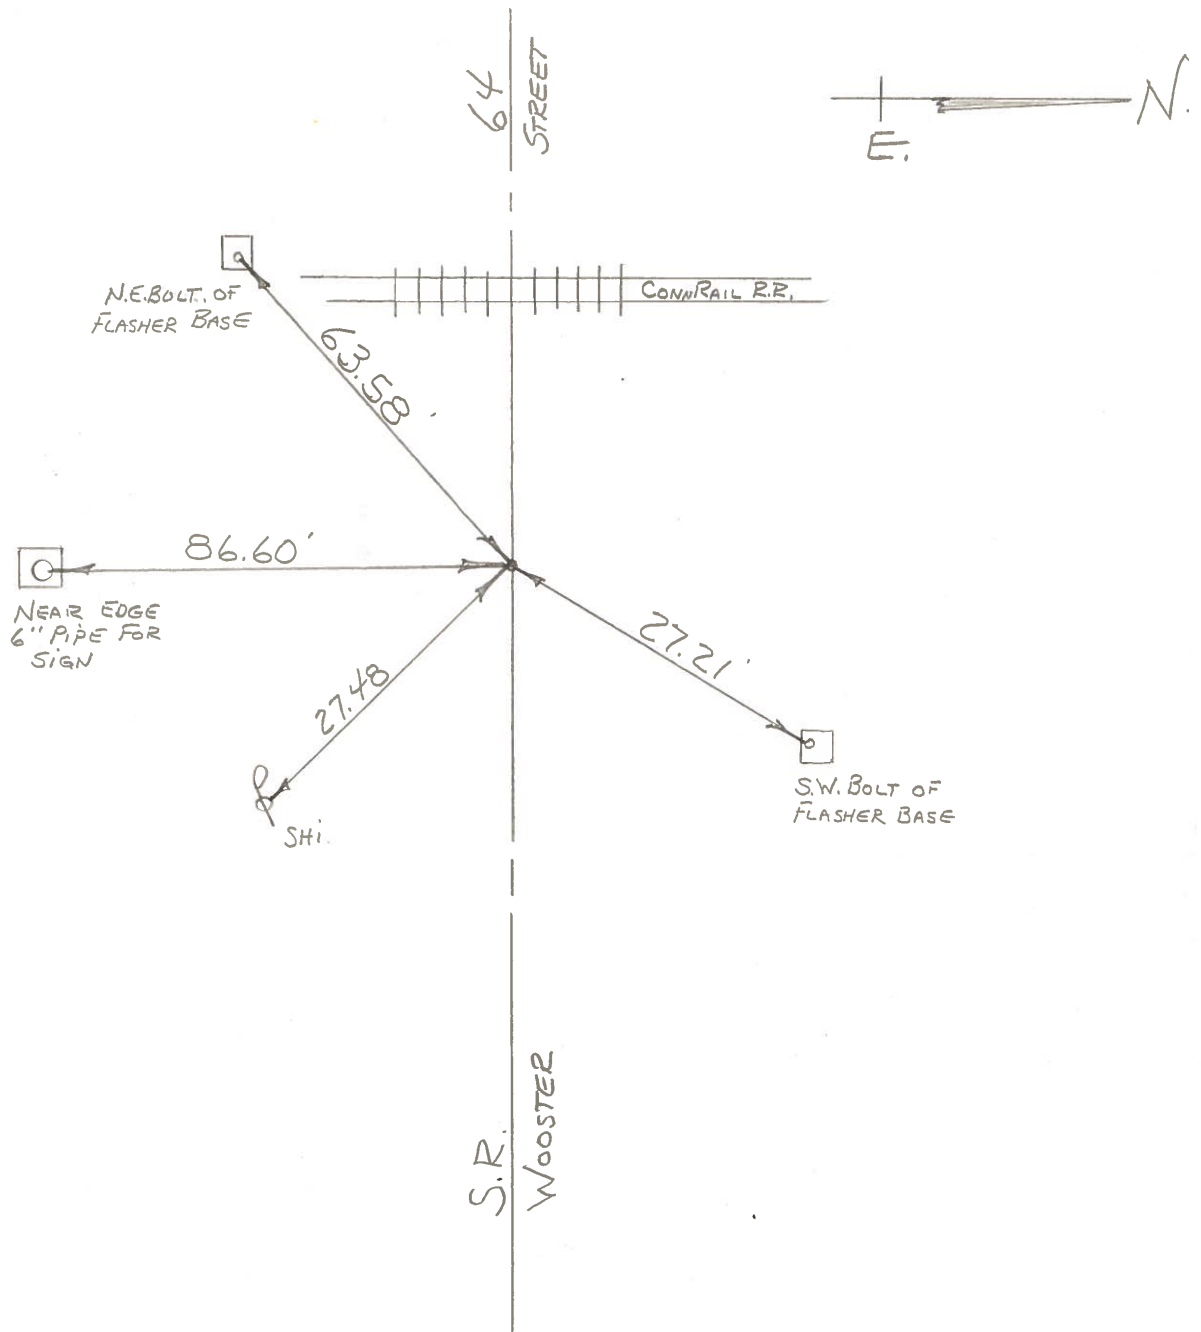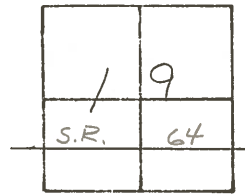

PERSONNEL	TITLE	PERSONNEL	TITLE	COUNTY	DATE
Morrison				Wood	
Jamison				S. R. US#6	
Barrett				SEC. Bowling Green.	

DESCRIPTION E. Wooster Street (E of pavement) JOB NO. _____

Points used for Survey for Black Top resurficing

