

O.D.O.T. DISTRICT 2 SURVEY OFFICE (USE ONLY)

PERSONNEL

REFERENCE NO. 3P

SHEET 23 OF 24

NOTES HOFFMAN DATE 4/7/88
 H.C. LOEHRKE WEATHER OVERCAST
 R.C. BARNHISEL TEMP. 44°

ROUTE SR 64
 COUNTY WOOD
 TOWNSHIP CENTER
 SECTION 19

DWG BY NIESE PID _____

T 5 N R 11 E

TYPE MONUMENT R.R. SPIKE W/ "+"

ON SURFACE - ~~BELOW~~ ON


OFFSET Q PAVEMENT ON LT : RT

- TO - EDGE PAVEMENT


STATION: 102+09

HORIZ.DATUM: _____ GEOID: _____

GRID: NORTHING: _____ EASTING: _____

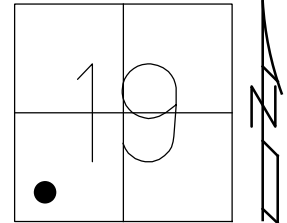

RECORD:
 R.R. SPIKE W/ "+"
 4/7/88, CL
 SET P.K./WASHER
 6/20/88, SWN

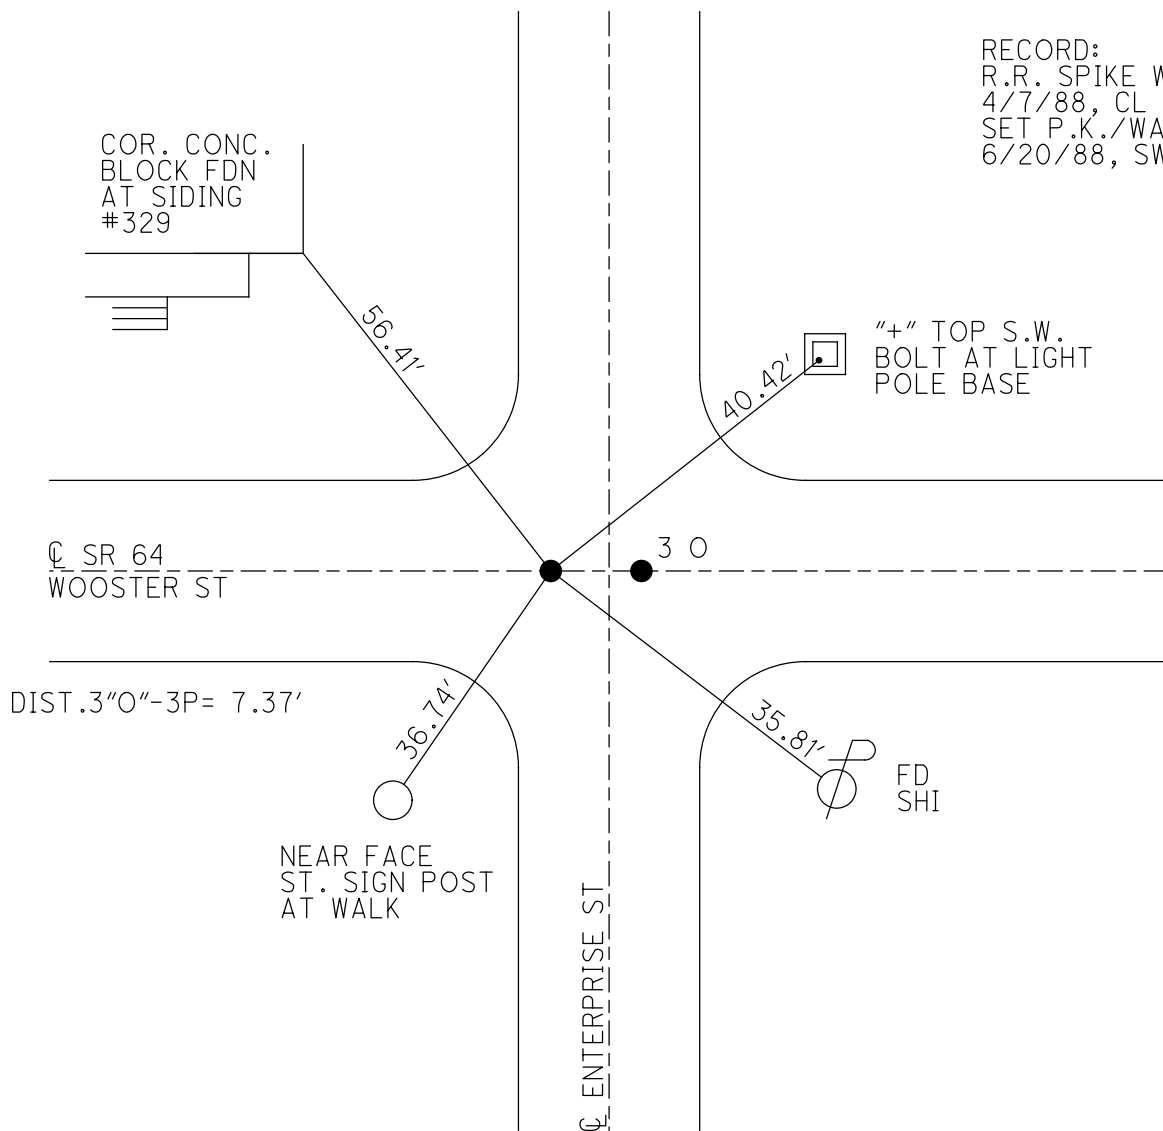

O.D.O.T. DISTRICT 2 SURVEY OFFICE

PERSONNEL

REFERENCE NO. 30", 3P

SHEET OF

NOTES Hoffman

H.C. Loehrke

DATE 4-7-88

ROUTE SR 64

R.C. BARNHISEL

WEATHER OVERCAST

COUNTY WOOD

REED

TEMP. 44°

TOWNSHIP Center

SECTION 19

T.5. N. R. 11 E

TYPE MONUMENT R.R. SPIKES / "T"

ON SURFACE - BELOW yes

LEFT- & PAV'T. - RIGHT yes - ALL 3 Pnts

TO EDGE PAVEMENT

S.L.M. 102 + 02

Set PK/WASHER
at BOTH Points
6-20-88 SWK

1	9
SR	64

