


O.D.O.T. DISTRICT 2 SURVEY OFFICE (USE ONLY)

PERSONNEL _____ REFERENCE NO. 3 U SHEET 4 OF 31


NOTES CANTERBURY DATE 04/29/04 ROUTE SR 64
 H.C. BARNHISEL WEATHER CLEAR COUNTY WOOD
 R.C. HUSS TEMP. 65° TOWNSHIP PLAIN
 SECTION 24
T 5 N R 10 E

TYPE MONUMENT _____ P.K.NAIL _____
~~ON SURFACE~~ - BELOW 2.5"
 LEFT - ☉ PAV'T - RIGHT ON
- TO - EDGE PAVEMENT
 S.L.M. 129+42

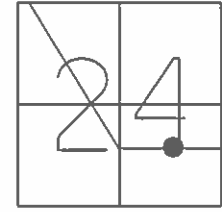

GRID: NORTHING: _____ EASTING: _____

RECORD:
 SET MAG/WASHER
 6/29/04, MC

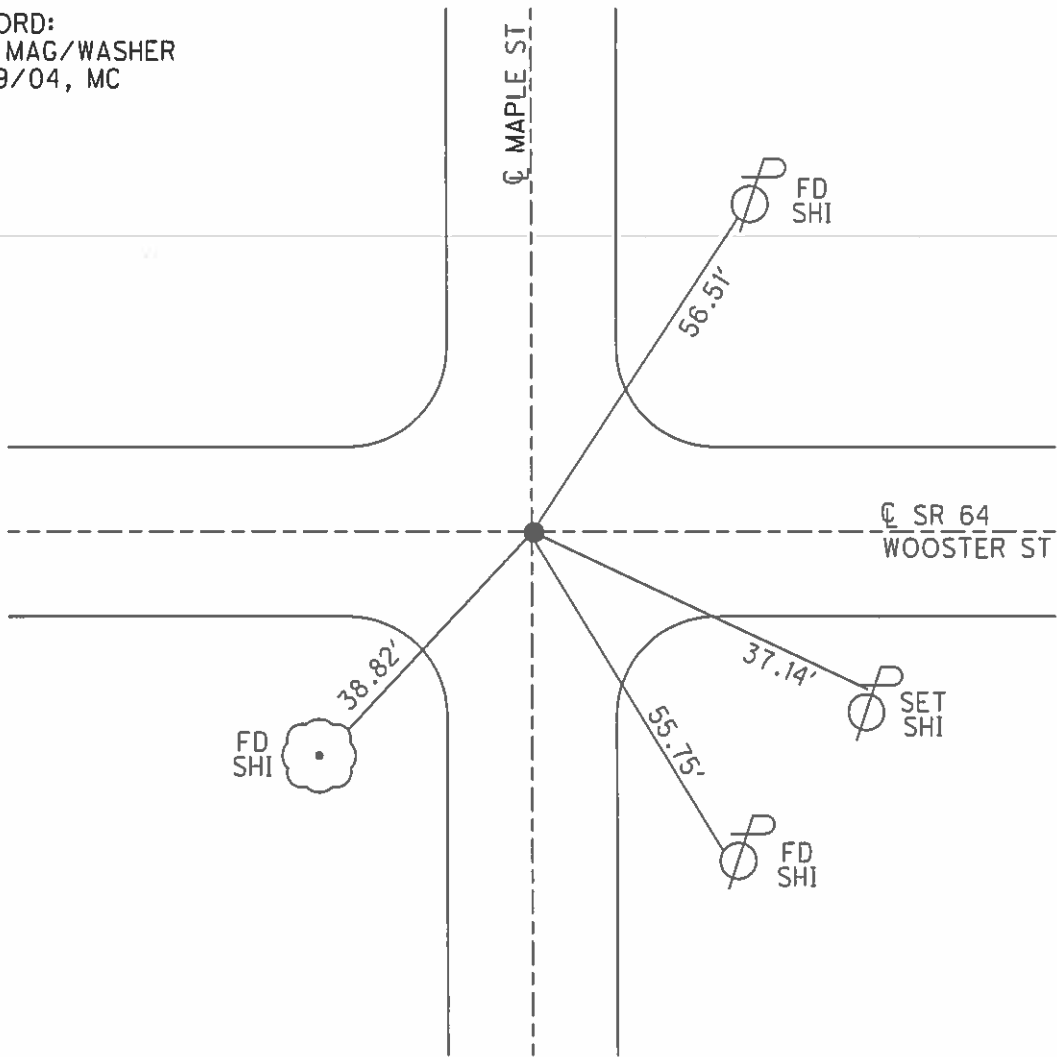

Resurfaced 2004

O.D.O.T. DISTRICT 2 SURVEY OFFICE

PERSONNEL

REFERENCE NO. 30

SHEET OF

NOTES HOFFMAN

H.C. LOEHRKE

DATE 4-7-88

ROUTE SR 64

R.C. BARNHISEL

WEATHER OVERCAST

COUNTY WOOD

ROAD

TEMP. 46°

TOWNSHIP PLAIN

SECTION 24

T. 5 N. R 10 E

TYPE MONUMENT P.K. Nail

Set P.K. / WASTER
6-20-88 SWOK

ON SURFACE - BELOW yes

LEFT - & PAV'T. - RIGHT yes Both Pav'ts

 TO EDGE PAVEMENT

S.L.M. 129 + 42

