


**O.D.O.T. DISTRICT 2 SURVEY OFFICE (USE ONLY)**

PERSONNEL \_\_\_\_\_ REFERENCE NO. 5 SHEET 7 OF 31


NOTES CANTERBURY DATE 04/29/04 ROUTE SR 64  
 H.C. BARNHISEL WEATHER CLEAR COUNTY WOOD  
 R.C. HUSS TEMP. 70° TOWNSHIP PLAIN  
 SECTION 24  
 T 5 N R 10 E

TYPE MONUMENT P.K./WASHER  
 ON SURFACE - ~~BELOW~~ ON  
 LEFT - ☉ PAV'T - RIGHT -  
16.6' TO RT CURB  
 S.L.M. 140+14

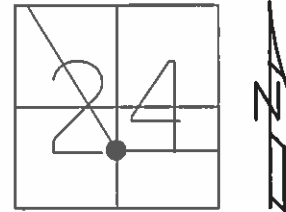

GRID: NORTHING: \_\_\_\_\_ EASTING: \_\_\_\_\_

RECORD: P.I.  
 DEF = 19° 19' LT  
 SET MAG/WASHER  
 6/29/04, MC

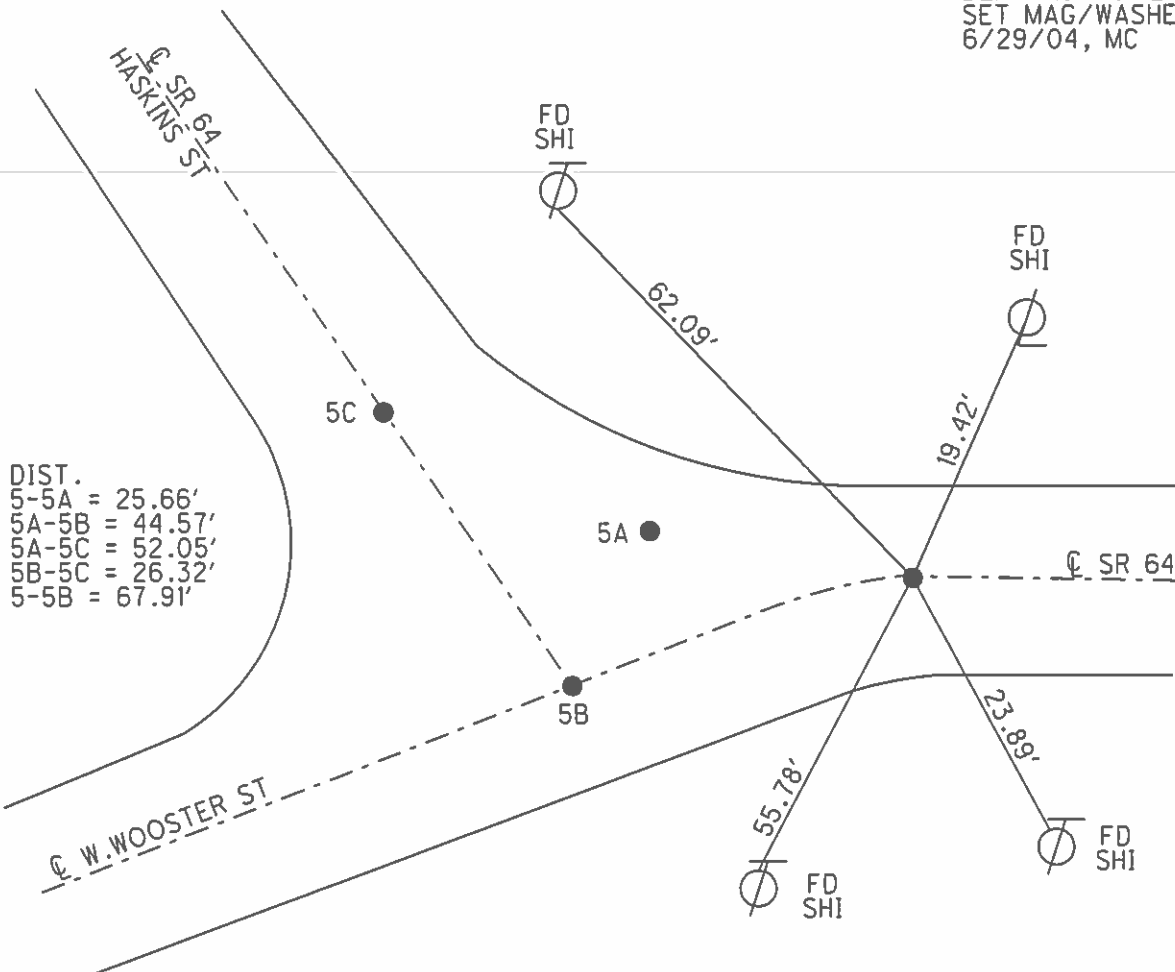

DIST.  
 5-5A = 25.66'  
 5A-5B = 44.57'  
 5A-5C = 52.05'  
 5B-5C = 26.32'  
 5-5B = 67.91'

# O.D.O.T. DISTRICT 2 SURVEY OFFICE

PERSONNEL

REFERENCE NO. 5

SHEET      OF     

NOTES HOFFMAN

H.C. LOEHRLE

DATE 4-7-88

ROUTE SR 64

R.C. BARNHISEL

WEATHER OVER

COUNTY WOOD

R3ED

TEMP. 48°

TOWNSHIP PLAIN

SECTION 24

Set P.K./WASHER AT ALL FOUR POINTS <sup>6.20.88 SWX</sup>

T 5 N R 10 E


TYPE MONUMENT P.K. Nails A, B & C; D = Steel Pin

ON SURFACE - BELOW A, B & C yes; D 6" down


LEFT - ☒ PAV'T. - RIGHT     

     TO      EDGE PAVEMENT

S.L.M. A = 140 + 14

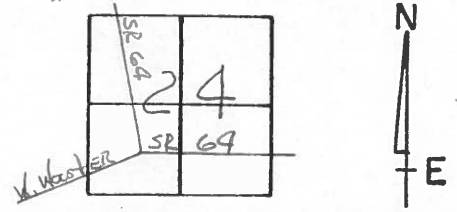

- Ⓐ = P.I. Δ 19°-19' LT
- Ⓑ = W 1/4 of the SE 1/4 sec. 24
- Ⓒ = ☒ HASKINS st. (APPEARS TO BE)
- Ⓓ = ☒ W. Wooster st

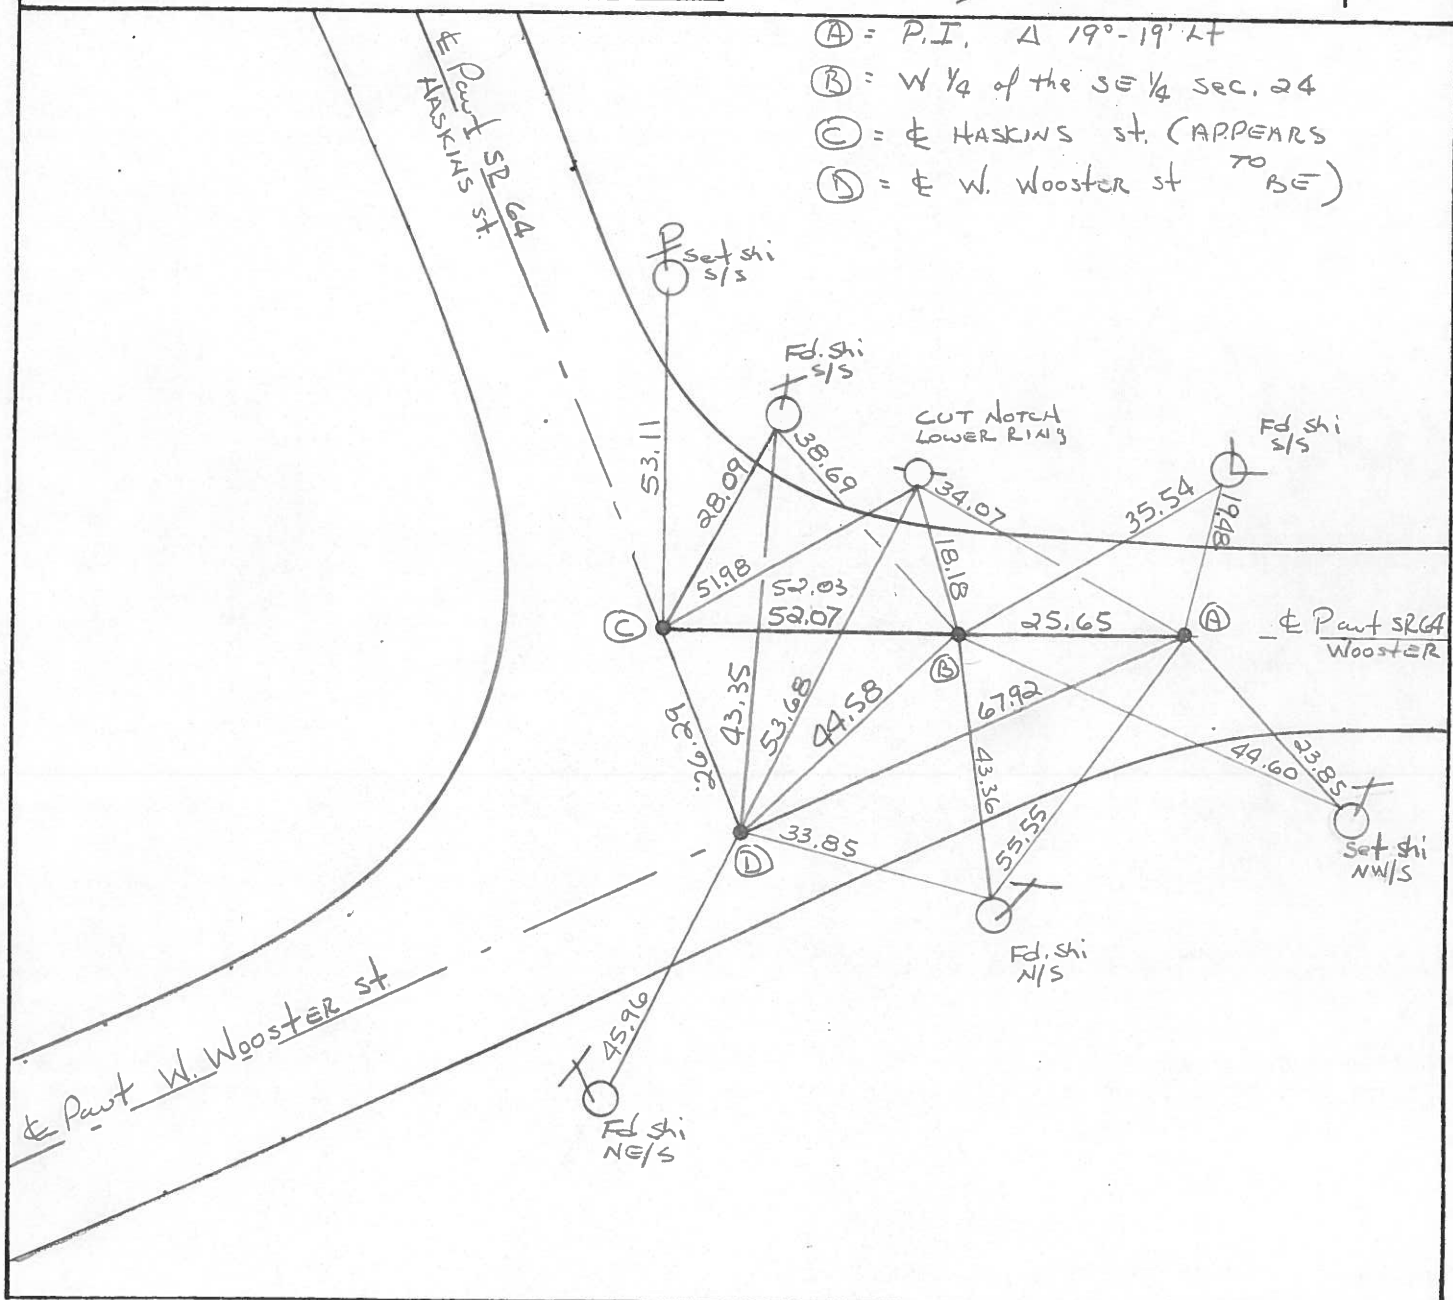

O.D.O.T. DISTRICT 2 SURVEY OFFICE

SHEET \_\_\_\_\_ OF \_\_\_\_\_

County WOOD S.R. 64

Date 2-22-77

Township PLAIN

Weather CLEAR

Section 24


Temp. 50°

T-5-N, R-10-E

Personnel BURNSIDE

SMITH

MEAD

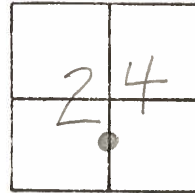

~~#4~~ 5

