



O.D.O.T. DISTRICT 2 SURVEY OFFICE (USE ONLY)

PERSONNEL _____ REFERENCE NO. 5 A SHEET 8 OF 31
 NOTES CANTERBURY DATE 04/29/04 ROUTE SR 64
 H.C. BARNHISEL WEATHER CLEAR COUNTY WOOD
 R.C. HUSS TEMP. 70° TOWNSHIP PLAIN
 SECTION 24
 T 5 N R 10 E

TYPE MONUMENT P.K./WASHER
 ON SURFACE - ~~BELOW~~ ON
 LEFT - ☉ PAV'T - RIGHT -
16.3' TO RT CURB
 S.L.M. 140+40
 GRID: NORTHING: _____ EASTING: _____

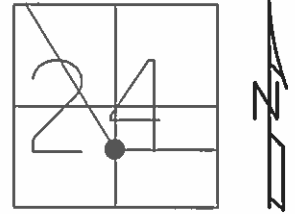

RECORD:
 W 1/4 OF THE SE 1/4, SEC 24
 SET MAG/WASHER
 6/29/04, MC

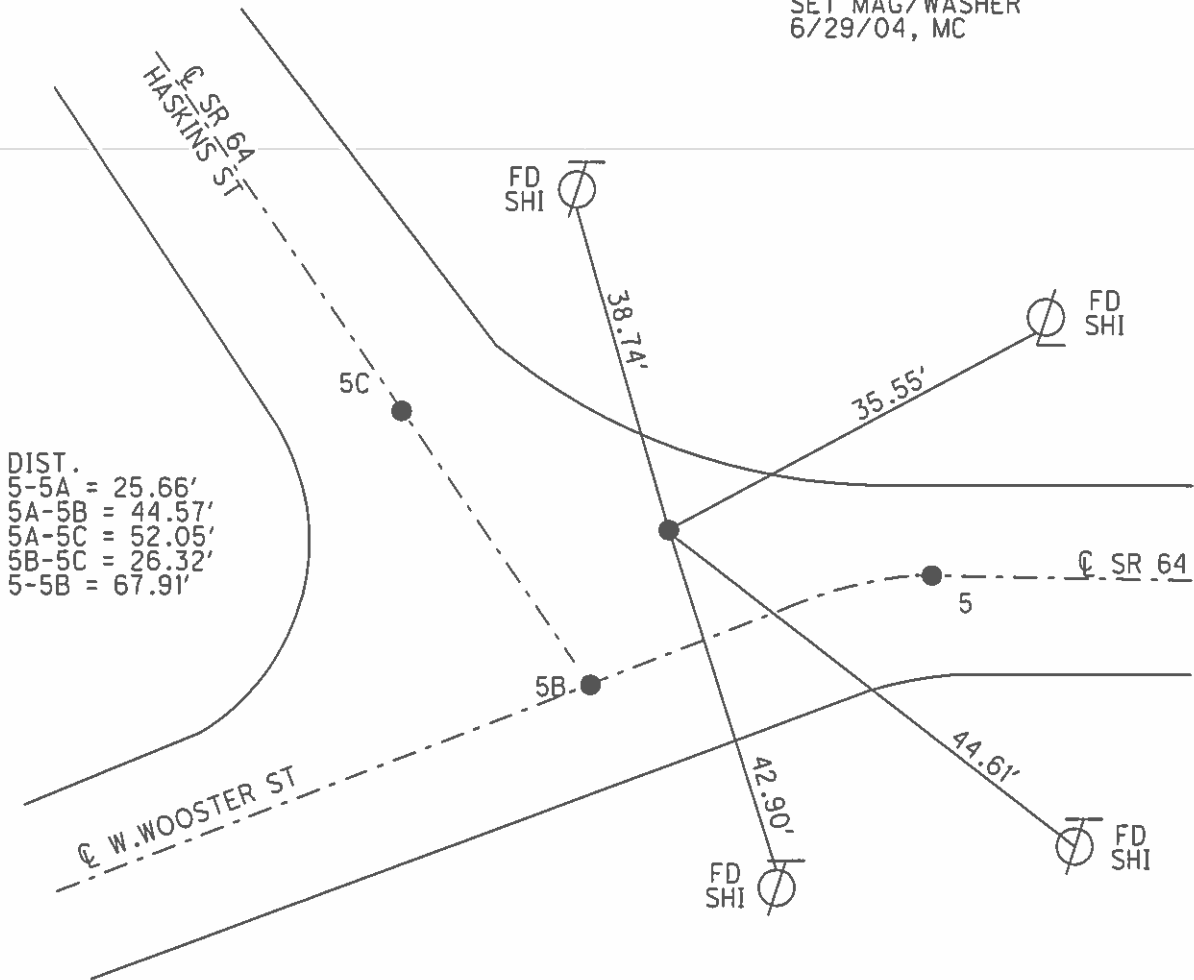

DIST.
 5-5A = 25.66'
 5A-5B = 44.57'
 5A-5C = 52.05'
 5B-5C = 26.32'
 5-5B = 67.91'

O.D.O.T. DISTRICT 2 SURVEY OFFICE

PERSONNEL _____

REFERENCE NO. 5

SHEET _____ OF _____

NOTES HOFFMAN

H.C. LOEHRLE

DATE 4-7-88

ROUTE SR 64

R.C. BARNHISEL

WEATHER OVER

COUNTY WOOD

R3ED

TEMP. 48°

TOWNSHIP PLAIN

SECTION 24

Set P.K./WASHER AT ALL FOUR POINTS ^{6.20.88 SWX}

T 5 N R 10 E


TYPE MONUMENT P.K. Nails A, B & C; D = Steel Pin

ON SURFACE - BELOW A, B & C yes; D 6" down


LEFT - ☐ PAV'T. - RIGHT _____

_____ TO _____ EDGE PAVEMENT

S.L.M. A = 140 + 14

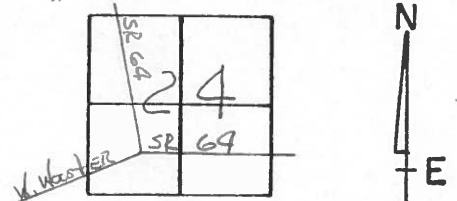

- Ⓐ = P.I. Δ 19°-19' LT
- Ⓑ = W 1/4 of the SE 1/4 sec. 24
- Ⓒ = ☐ HASKINS st. (APPEARS TO BE)
- Ⓓ = ☐ W. Wooster st

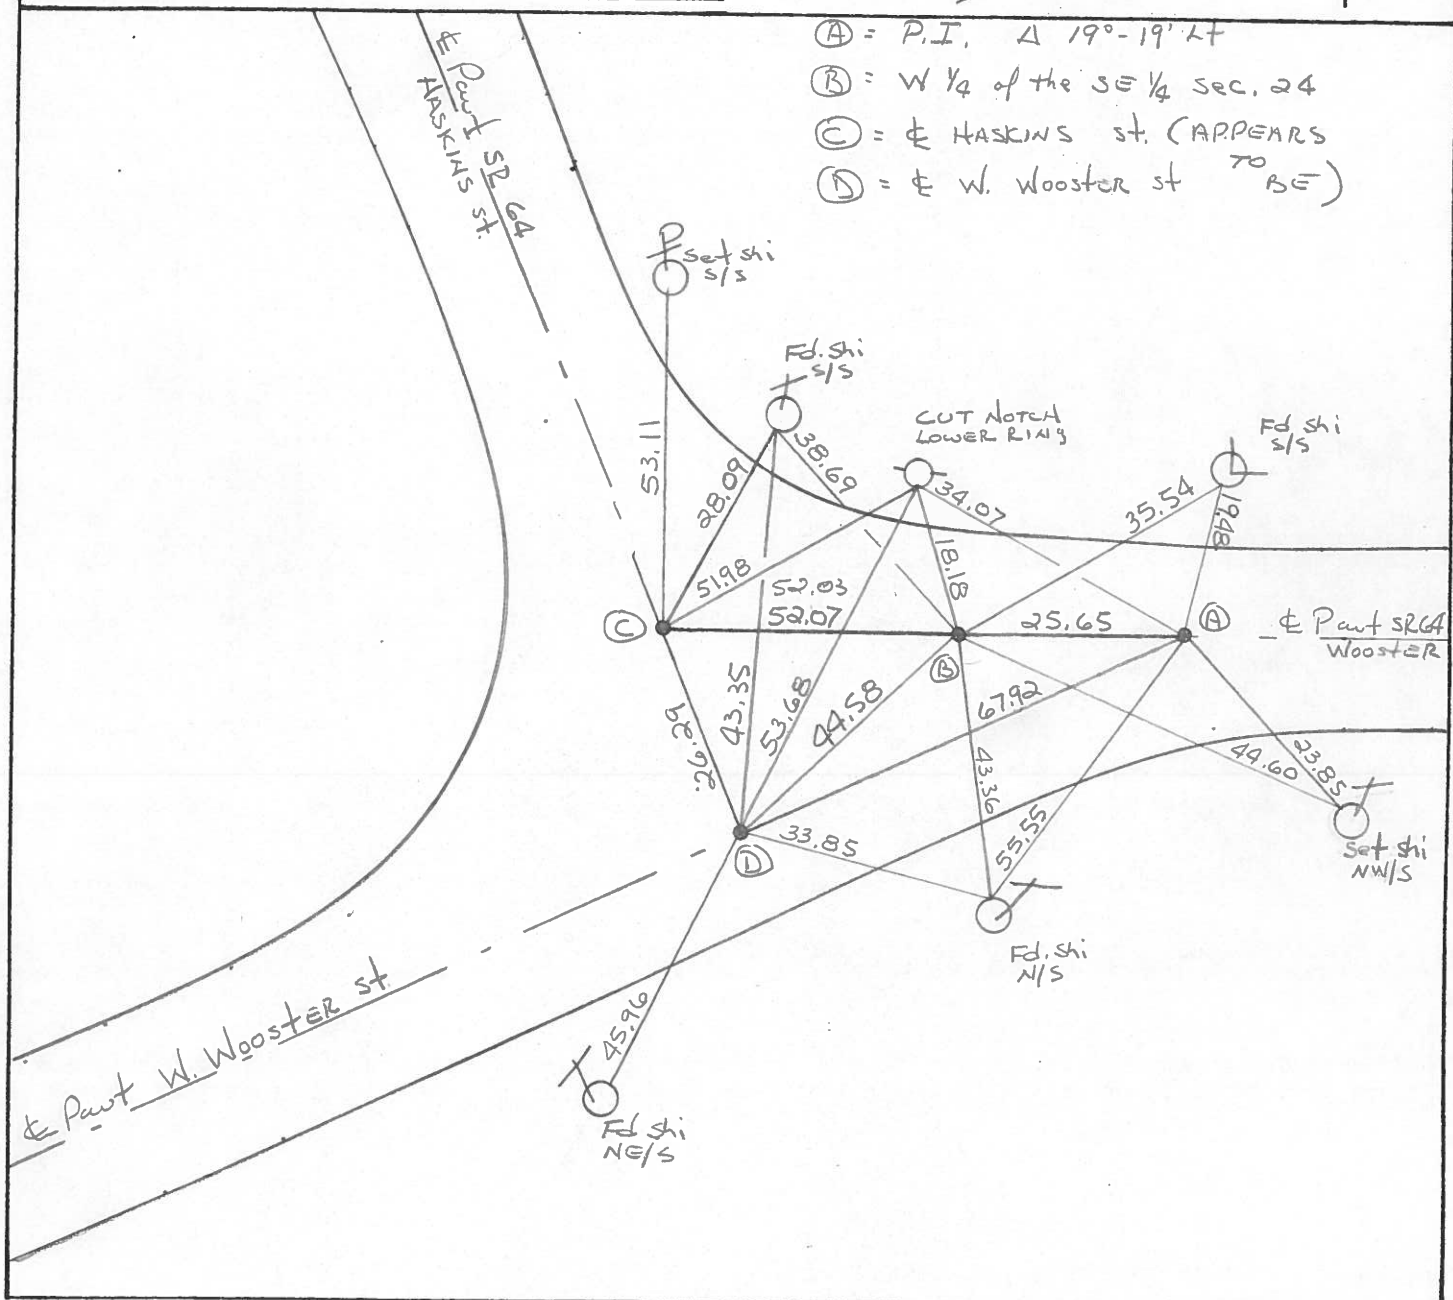

O.D.O.T. DISTRICT 2 SURVEY OFFICE

SHEET _____ OF _____

County WOOD S.R. 64

Date 2-22-77

Township PLAIN


Weather CLEAR

Section 24

Temp. 50°

T-5-N, R-10-E

Personnel BURNSIDE

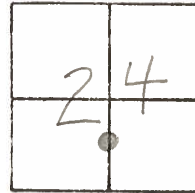

~~#4~~ 5

