



O.D.O.T. DISTRICT 2 SURVEY OFFICE (USE ONLY)

PERSONNEL _____ REFERENCE NO. 5 E SHEET 12 OF 31
 NOTES CANTERBURY DATE 04/29/04 ROUTE SR 64
 H.C. BARNHESEL WEATHER CLEAR COUNTY WOOD
 R.C. HUSS TEMP. 70° TOWNSHIP PLAIN
 SECTION 24
 T 5 N R 10 E

TYPE MONUMENT LG R.R. SPIKE
~~ON SURFACE~~ - BELOW 2"
 LEFT - ☉ PAV'T - ~~RIGHT~~ 8.7'
1.2' TO LT EDGE PAVEMENT
 S.L.M. 153+18
 GRID: NORTHING: _____ EASTING: _____

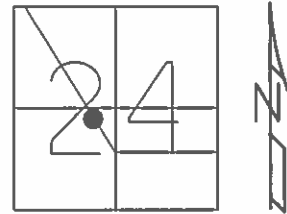

RECORD:
 UNKNOW ORIGIN
 SET MAG/WASHER
 6/29/04, MC

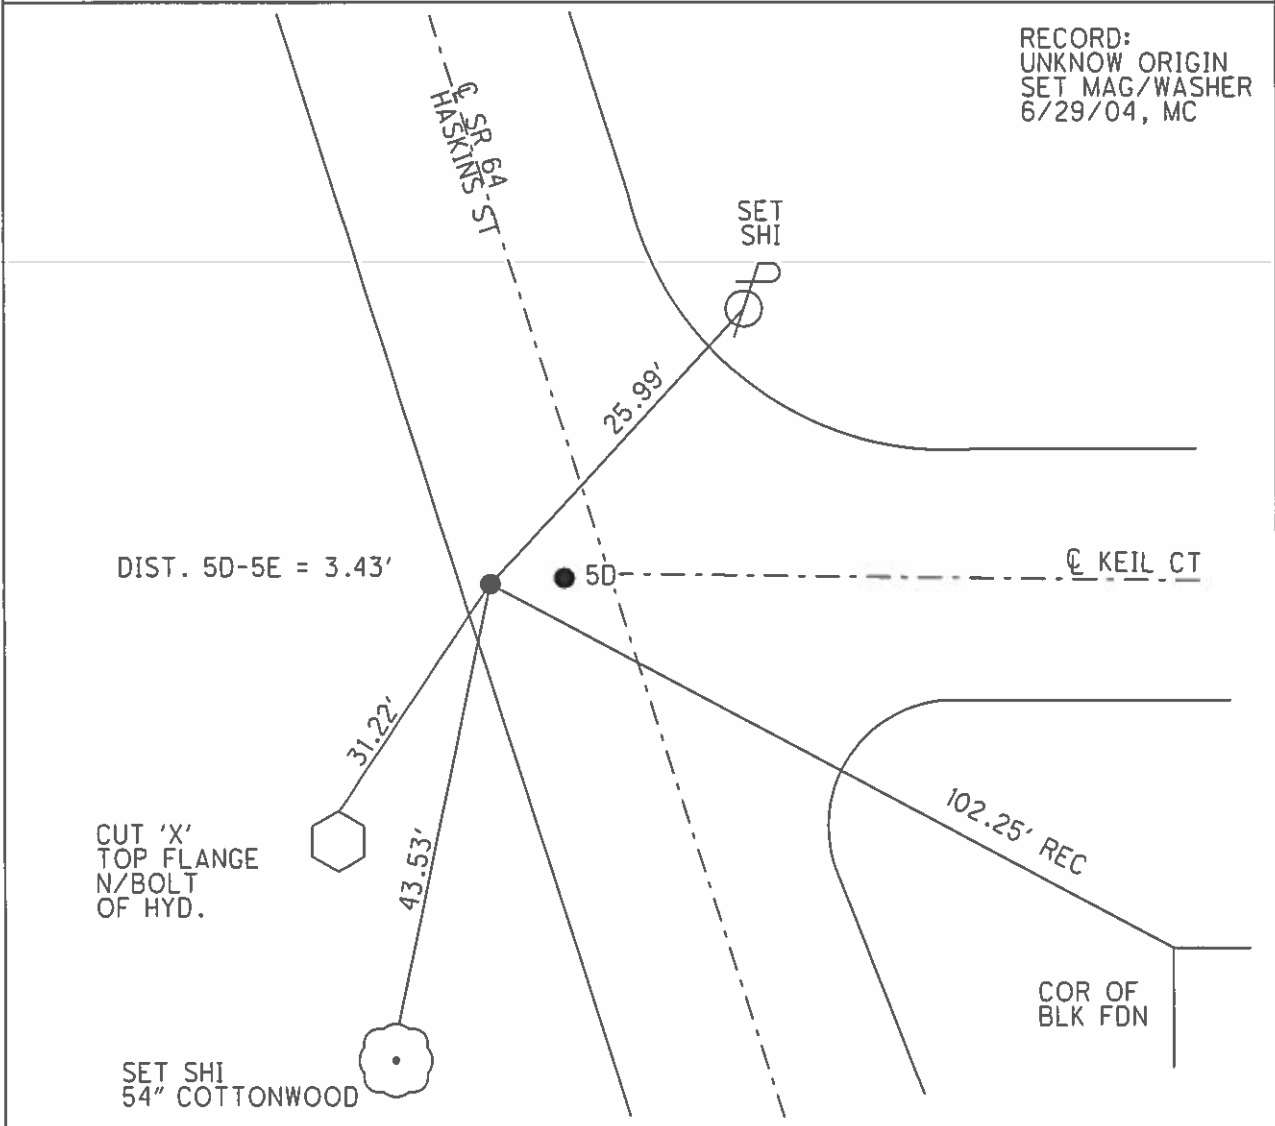

O.D.O.T. DISTRICT 2 SURVEY OFFICE

PERSONNEL _____ REFERENCE NO. _____ SHEET _____ OF _____

NOTES HOFFMAN

H.C. LOEHRKE

R.C. REED

DATE 4-14-88

WEATHER CLEAR-WINDY

TEMP. 49°

ROUTE SR 64

COUNTY WOOD

TOWNSHIP PLAIN

SECTION 24

T. 5 N. R. 10 E

TYPE MONUMENT P.K.


ON SURFACE BELOW YES

LEFT-~~C~~ PAV'T. - RIGHT 5.3

5.6 TO LT EDGE PAVEMENT

S.L.M. 154+18


50 ± 5E

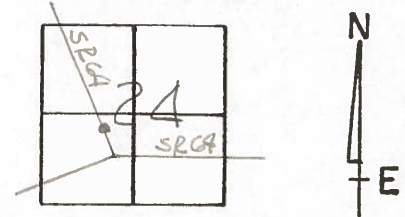

3.42' BTW Points
 Fd R.R. SPK @ surface
 8.9' Lt & Pavt SR64
 2.5' TO Lt. EP.
 ORIGINAL UNKNOWN

CUT "+" NEAR.
 SIDE OF BODY OF
 HYD.

Set shi
 NE/S
 54" willow

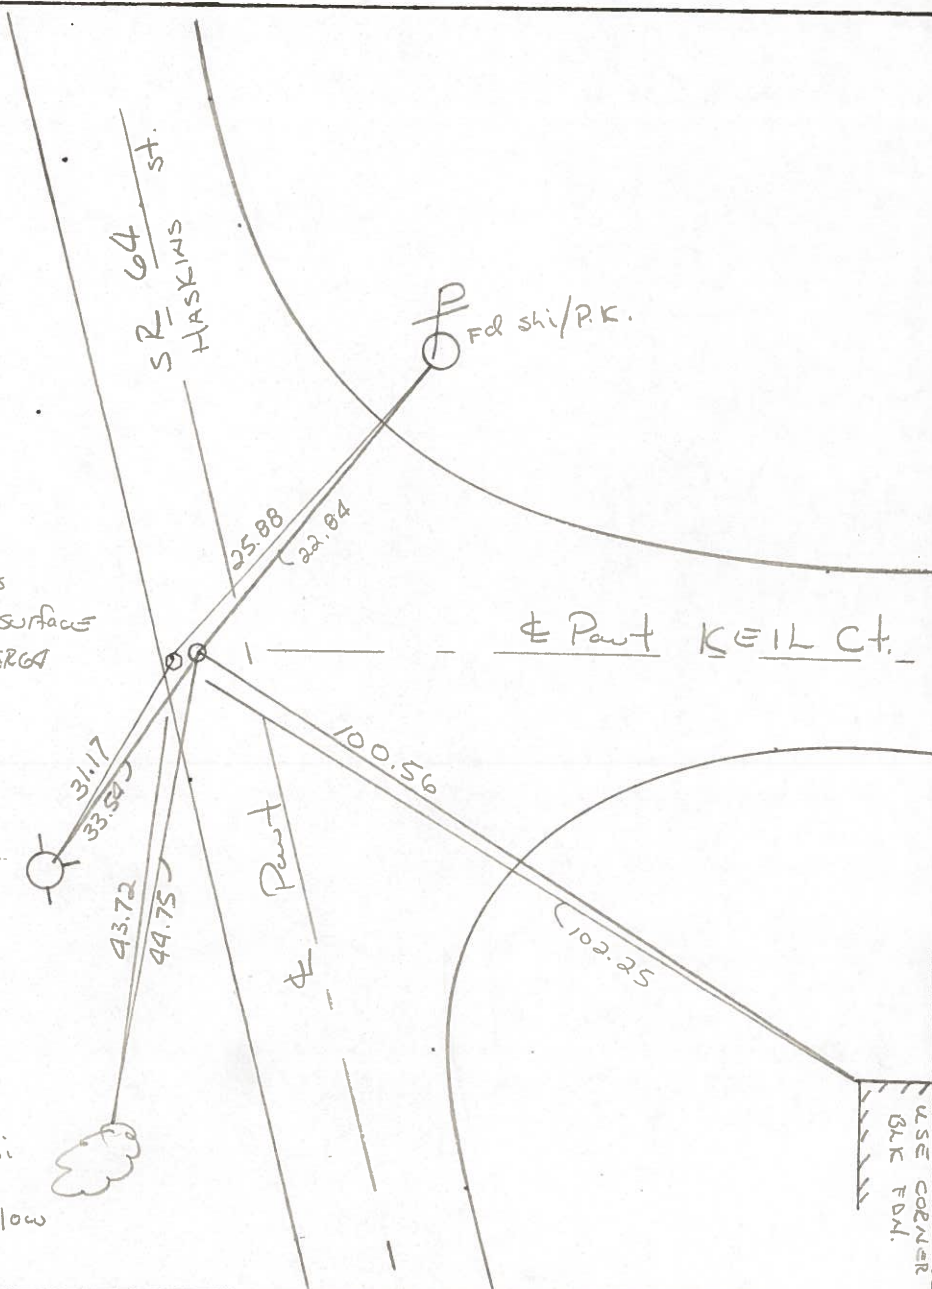

O.D.O.T. DISTRICT 2 SURVEY OFFICE

PERSONNEL _____ REFERENCE NO. _____ SHEET _____ OF _____

NOTES HOFFMAN

H.C. LOEHKE

R.C. REED

DATE 4-14-88

WEATHER CLEAR-WINDY

TEMP. 49°

ROUTE SR 64

COUNTY WOOD

TOWNSHIP PLAIN

SECTION 24

T 5 N R 10 E

TYPE MONUMENT P.K.

50 ± 5E

ON SURFACE - BELOW YES

LEFT - PAV'T. - RIGHT 5, 3

5.6 TO LT EDGE PAVEMENT

S.L.M. 154 + 18



3.42' BTW Points
 Fd R.R. SRK @ surface
 8.9' Lt & Paut SR 64
 2.5' TO Lt. EP.
 ORIGINAL UNKNOWN

CUT "+" NEAR
 SIDE OF BODY OF
 HYD.

Set shi
 NE/S
 54" willow

