


O.D.O.T. DISTRICT 2 SURVEY OFFICE (USE ONLY)


PERSONNEL \_\_\_\_\_ REFERENCE NO. 5 "0" SHEET 22 OF 31  
 NOTES CANTERBURY DATE 05/03/04 ROUTE SR 64  
 H.C. BARNHISEL WEATHER CLOUDY COUNTY WOOD  
 R.C. ARMS TEMP. 42° TOWNSHIP PLAIN  
 SECTION 24  
T 5 N R 10 E

TYPE MONUMENT P.K./WASHER  
 ON SURFACE - ~~BELOW~~ ON  
~~LEFT~~ - ☉ PAV'T - RIGHT 2'  
7.0' TO RT EDGE PAVEMENT  
 S.L.M. 169+69  
 GRID: NORTHING: \_\_\_\_\_ EASTING: \_\_\_\_\_

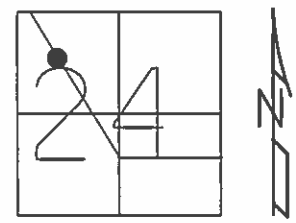

RES #667

RECORD:  
 SET MAG/WASHER  
 06/29/04, MC

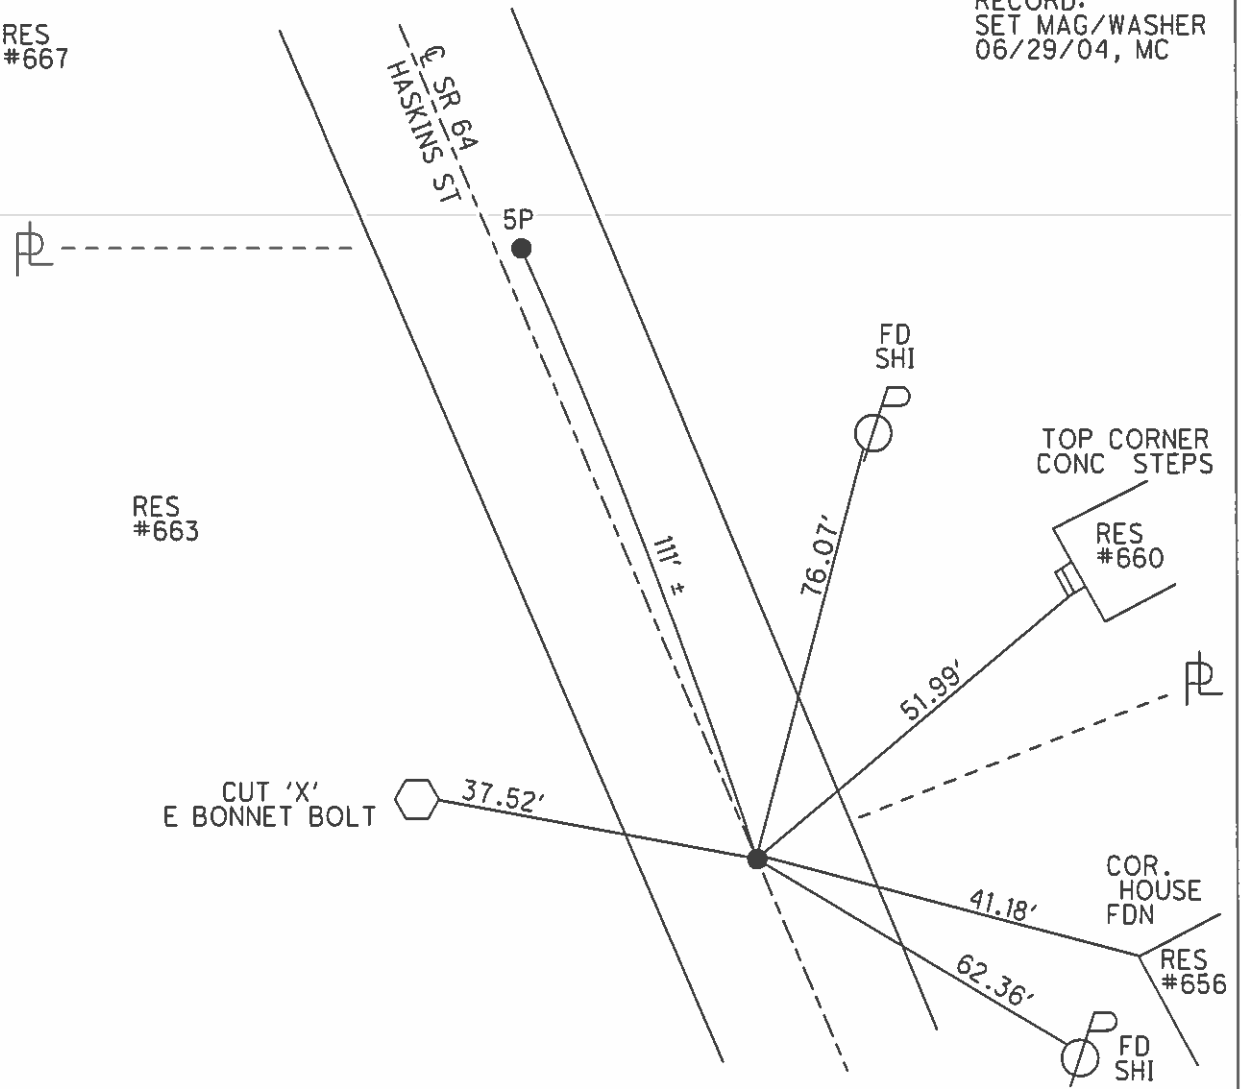

# O.D.O.T. DISTRICT 2 SURVEY OFFICE

PERSONNEL \_\_\_\_\_ REFERENCE NO. \_\_\_\_\_ SHEET \_\_\_\_\_ OF \_\_\_\_\_

NOTES LOFFMAN

H.C. LOSHRKE

R.C. REED

DATE 4-14-88

WEATHER windy - P. CLEAR

TEMP. 49°

ROUTE SR 64

COUNTY WOOD

TOWNSHIP PLAIN

SECTION 24

T 5 N R 10 E

TYPE MONUMENT "A" = SMALL RR SPK / "B" = P.K.

ON SURFACE - BELOW 2" Below / surface

LEFT - ~~C~~ PART - RIGHT 2.4 / 1.2

8.0' TO 1.4' / 9.0' TO 2.7' EDGE PAVEMENT

S.L.M. 166+00 / 166+77

Set P.K. / washer  
at all points  
6-9-88 SWH

