



O.D.O.T. DISTRICT 2 SURVEY OFFICE (USE ONLY)

PERSONNEL _____ REFERENCE NO. 6 D SHEET 28 OF 31
 NOTES CANTERBURY DATE 05/03/04 ROUTE SR 64
 H.C. BARNHISEL WEATHER CLOUDY COUNTY WOOD
 R.C. ARMS TEMP. 45° TOWNSHIP PLAIN
 _____ SECTION 24
 _____ T 5 N R 10 E

TYPE MONUMENT LG.R.R.SPIKE
~~ON SURFACE~~ - BELOW 4"
~~LEFT~~ - ℄ PAV'T - RIGHT 3.0'
13' TO LT EDGE PAVEMENT
 S.L.M. 173+57
 GRID: NORTHING: _____ EASTING: _____

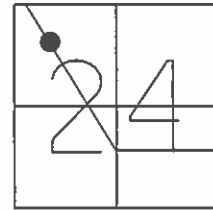

RECORD:
 SET MAG/WASHER
 06/29/04, MC

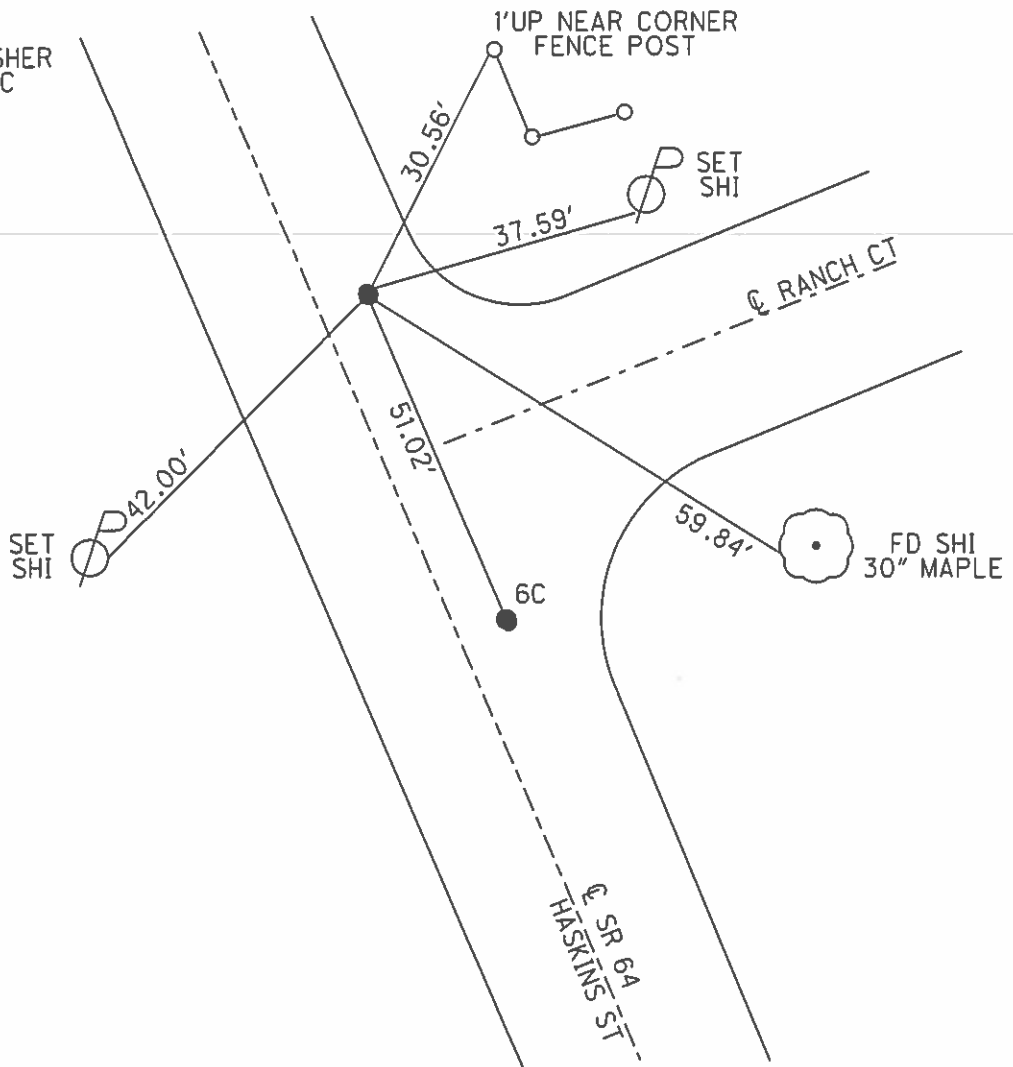

O.D.O.T. DISTRICT 2 SURVEY OFFICE

PERSONNEL _____

REFERENCE NO. _____

SHEET _____ OF _____

NOTES Hoffman

H.C. LOEHRLE

DATE 4-19-88

ROUTE SR 64

R.C. BARNAISEL

WEATHER CLEAR

COUNTY WOOD

TEMP. 48°

TOWNSHIP PLAIN

SECTION 24

T S N R 10 E

TYPE MONUMENT P.K. - R.R. SPK.

ON SURFACE - BELOW YES - 2" Below

~~LEFT - C. PAVT.~~ - RIGHT 2.0' - 3.0'

7.9-7.5 TO RT. EDGE PAVEMENT

S.L.M. 174+06 - 174+57

Set P.K./w/aster
at Both Points
6-9-88 swfs

