

O.D.O.T. DISTRICT 2 SURVEY OFFICE (USE ONLY)

PERSONNEL _____ REFERENCE NO. 6 F SHEET 30 OF 31

NOTES	<u>CANTERBURY</u>	DATE	<u>05/03/04</u>	ROUTE	<u>SR 64</u>
H.C.	<u>BARNHISEL</u>	WEATHER	<u>CLOUDY</u>	COUNTY	<u>WOOD</u>
R.C.	<u>ARMS</u>	TEMP.	<u>45°</u>	TOWNSHIP	<u>PLAIN</u>
				SECTION	<u>24</u>
				T	<u>5 N</u>
				R	<u>10 E</u>

TYPE MONUMENT P.K.NAIL


~~ON SURFACE~~ - BELOW 3.5"

~~LEFT~~ - Q PAV'T - RIGHT 3.2'

6.4' TO RT. EDGE PAVEMENT


S.L.M. 175+84

GRID: NORTHING: _____ EASTING: _____

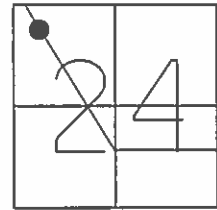

RECORD:
SET MAG/WASHER
06/29/04, MC

DIST.
6E-6F = 57.64'
6F-6G = 42.33'

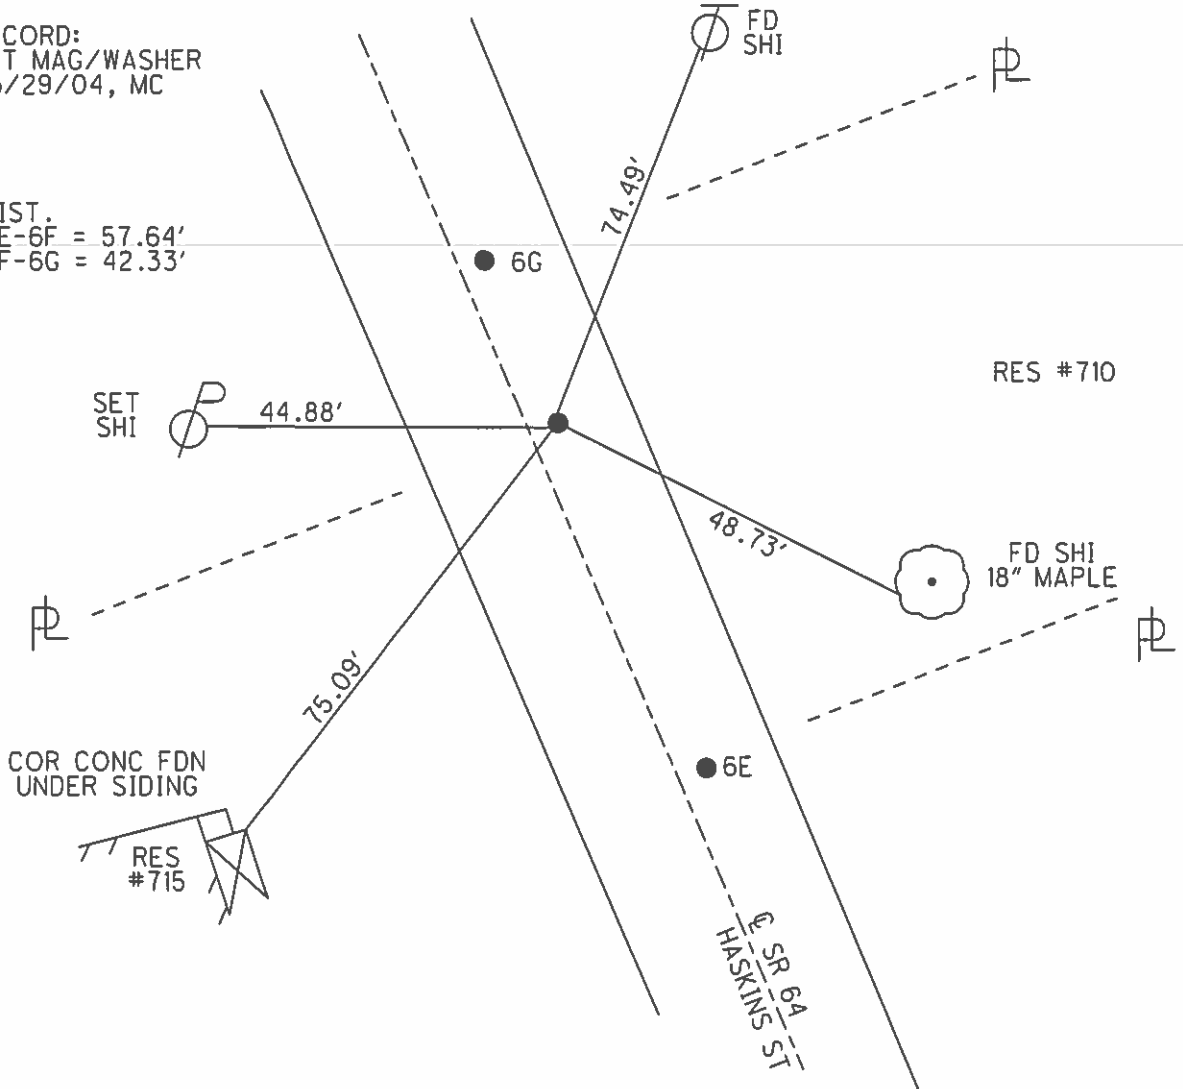

O.D.O.T. DISTRICT 2 SURVEY OFFICE

PERSONNEL _____

REFERENCE NO. _____

SHEET _____ OF _____

NOTES Hoffman

H.C. Loehrer

R.C. Barnhisel

DATE 4-19-88

WEATHER Clear

TEMP. 48°

ROUTE SR 64

COUNTY Wood

TOWNSHIP PLAIN

SECTION 24

T 5 N R 10 E

TYPE MONUMENT P.K. - P.K. - small R.R. spike

ON SURFACE - BELOW yes - yes - 2" below

LEFT - C PAVT. - RIGHT 3.5' - 2.8' - 2.7'

7.0 TO RT EDGE PAVEMENT

S.L.M. 176+26 - 176+84 - 177+26

Set P.K. washer
6-9-88 small

