

O.D.O.T. DISTRICT 2 SURVEY OFFICE USE ONLY

PERSONNEL _____ REFERENCE NO. 7 A SHEET 2 OF 32

NOTES WESTFALL DATE 06-05-13 ROUTE SR 64
 H.C. ROUSOS WEATHER CLEAR COUNTY WOOD
 R.C. RHOADES TEMP. 68° F TOWNSHIP PLAIN
 SECTION 145
 T 5 N R 10 E


TYPE MONUMENT MAG NAIL & WASHER

ON SURFACE - ~~BELOW~~ YES


~~LEFT~~ - C PAV'T - RIGHT 0.5'

9.1' TO RT EDGE PAVEMENT
 S.L.M. 217+27

Grid: Northing: 631,298.985 Easting: 1,646,501.035

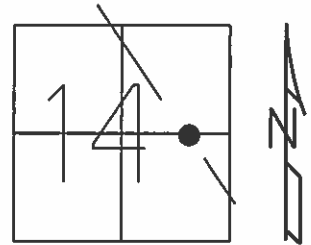

NOTE:
 GRID COORDINATES ARE
 FROM WHEN POINT WAS
 REFERENCED NOT WHEN
 POINT WAS RESET

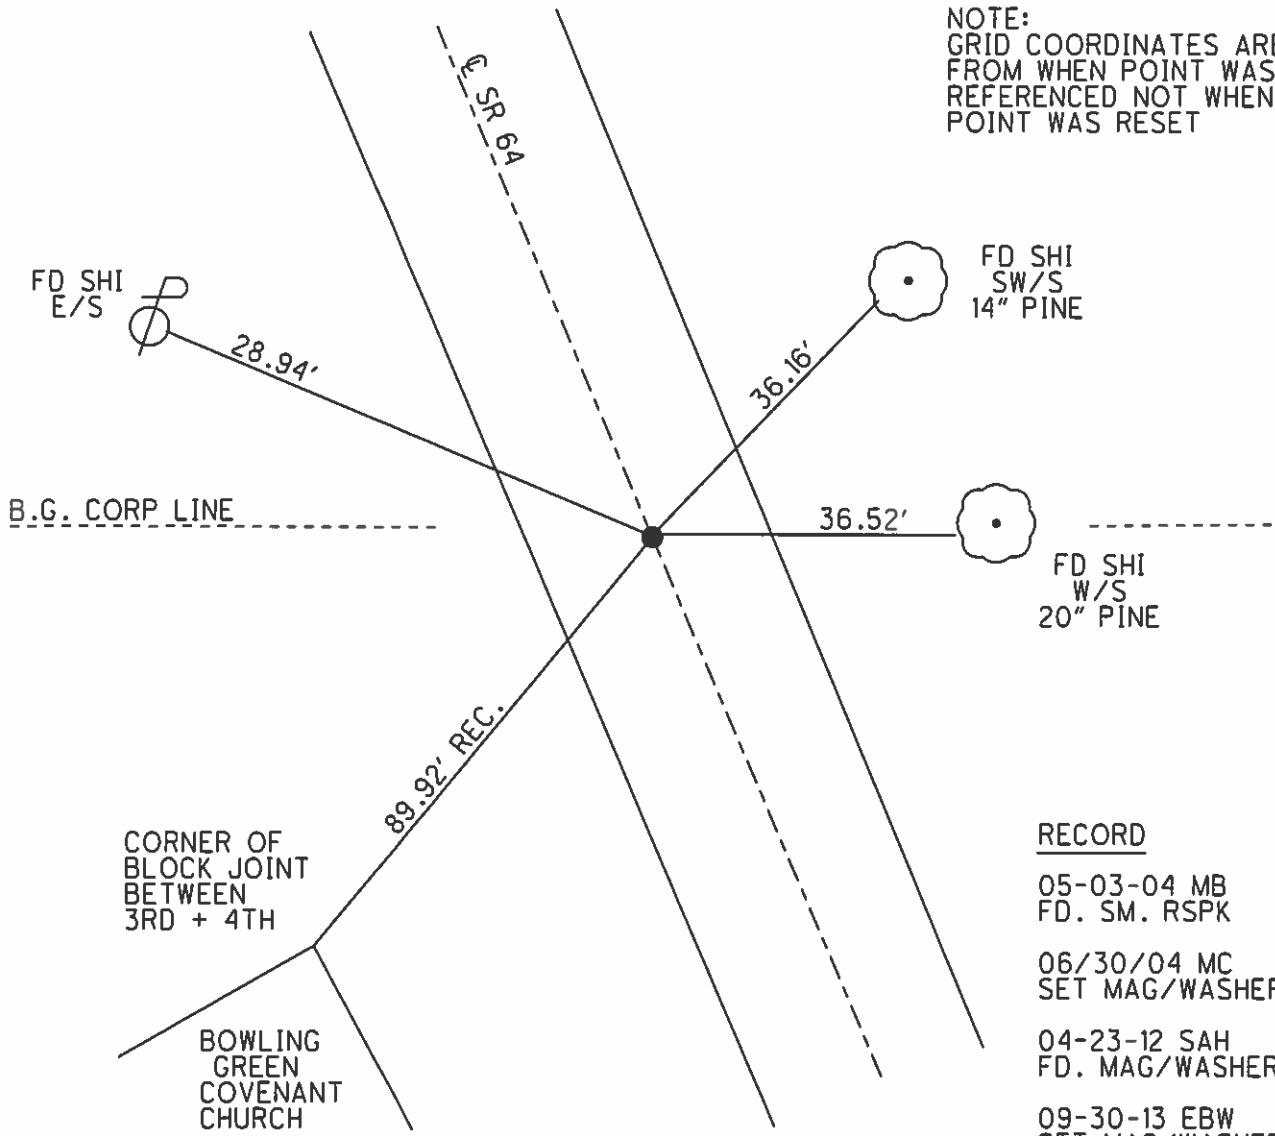

RECORD

- 05-03-04 MB
FD. SM. RSPK
- 06/30/04 MC
SET MAG/WASHER
- 04-23-12 SAH
FD. MAG/WASHER
- 09-30-13 EBW
SET MAG/WASHER

O.D.O.T. DISTRICT 2 SURVEY OFFICE

PERSONNEL _____

REFERENCE NO. _____

SHEET 19 OF 19

NOTES CANTERBURY

DATE 05/03/04

ROUTE S.R. 64

H.C. BARNHISEL

WEATHER CLOUDY

COUNTY WOOD

R.C. ARMS

TEMP. +48°

TOWNSHIP PLAIN

SECTION 14

T 5 N R 10 E


TYPE MONUMENT _____ PK/WASHER _____

ON SURFACE ~~-BELOW~~ _____ YES _____

~~LEFT~~ - Q PAV'T - RIGHT _____ 0.5' _____


9.1' TO RT EDGE PAVEMENT

S.L.M. _____ 217+27 _____

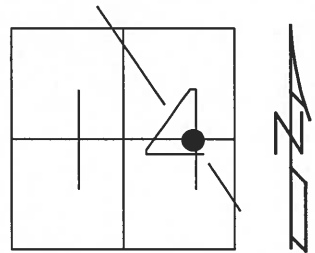

7 AC

SET MAG NAIL & WASHER
06/30/04
MC

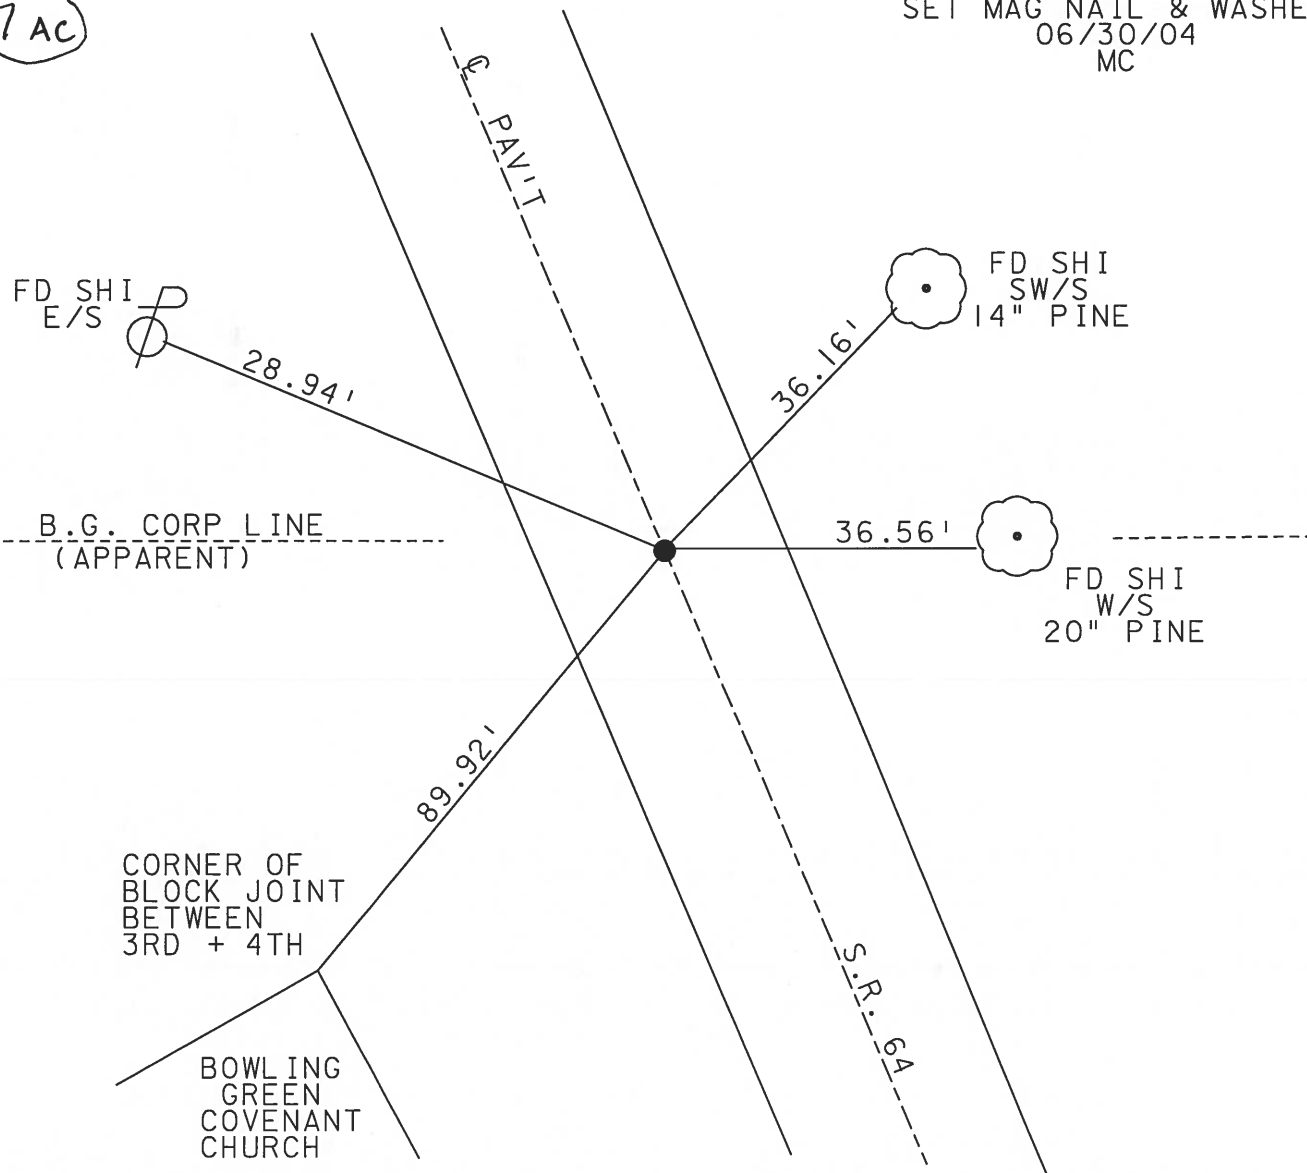

O.D.O.T. DISTRICT 2 SURVEY OFFICE

PERSONNEL

REFERENCE NO. FAC

SHEET 1 OF 27

NOTES Ituss

H.C. Cardes

R.C. VanNusen

Flag Cox

DATE 6-18-97

WEATHER Clidy-Rain

TEMP. 69°F

ROUTE SR-64

COUNTY Wood

TOWNSHIP Plain

SECTION 14

T 5 N R 10 E


TYPE MONUMENT Small R.R. Spk.

~~ON SURFACE~~ BELOW Yes


~~LEFT HAND PAINT.~~ RIGHT .2' Right

9.3 TO R+ EDGE PAVEMENT

S.L. # 6 + 648.91 218+14

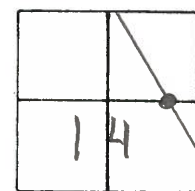

Set Small R.R. Spk. 6-9-88 MDR
 Set PK/W 12-01-97 SAH

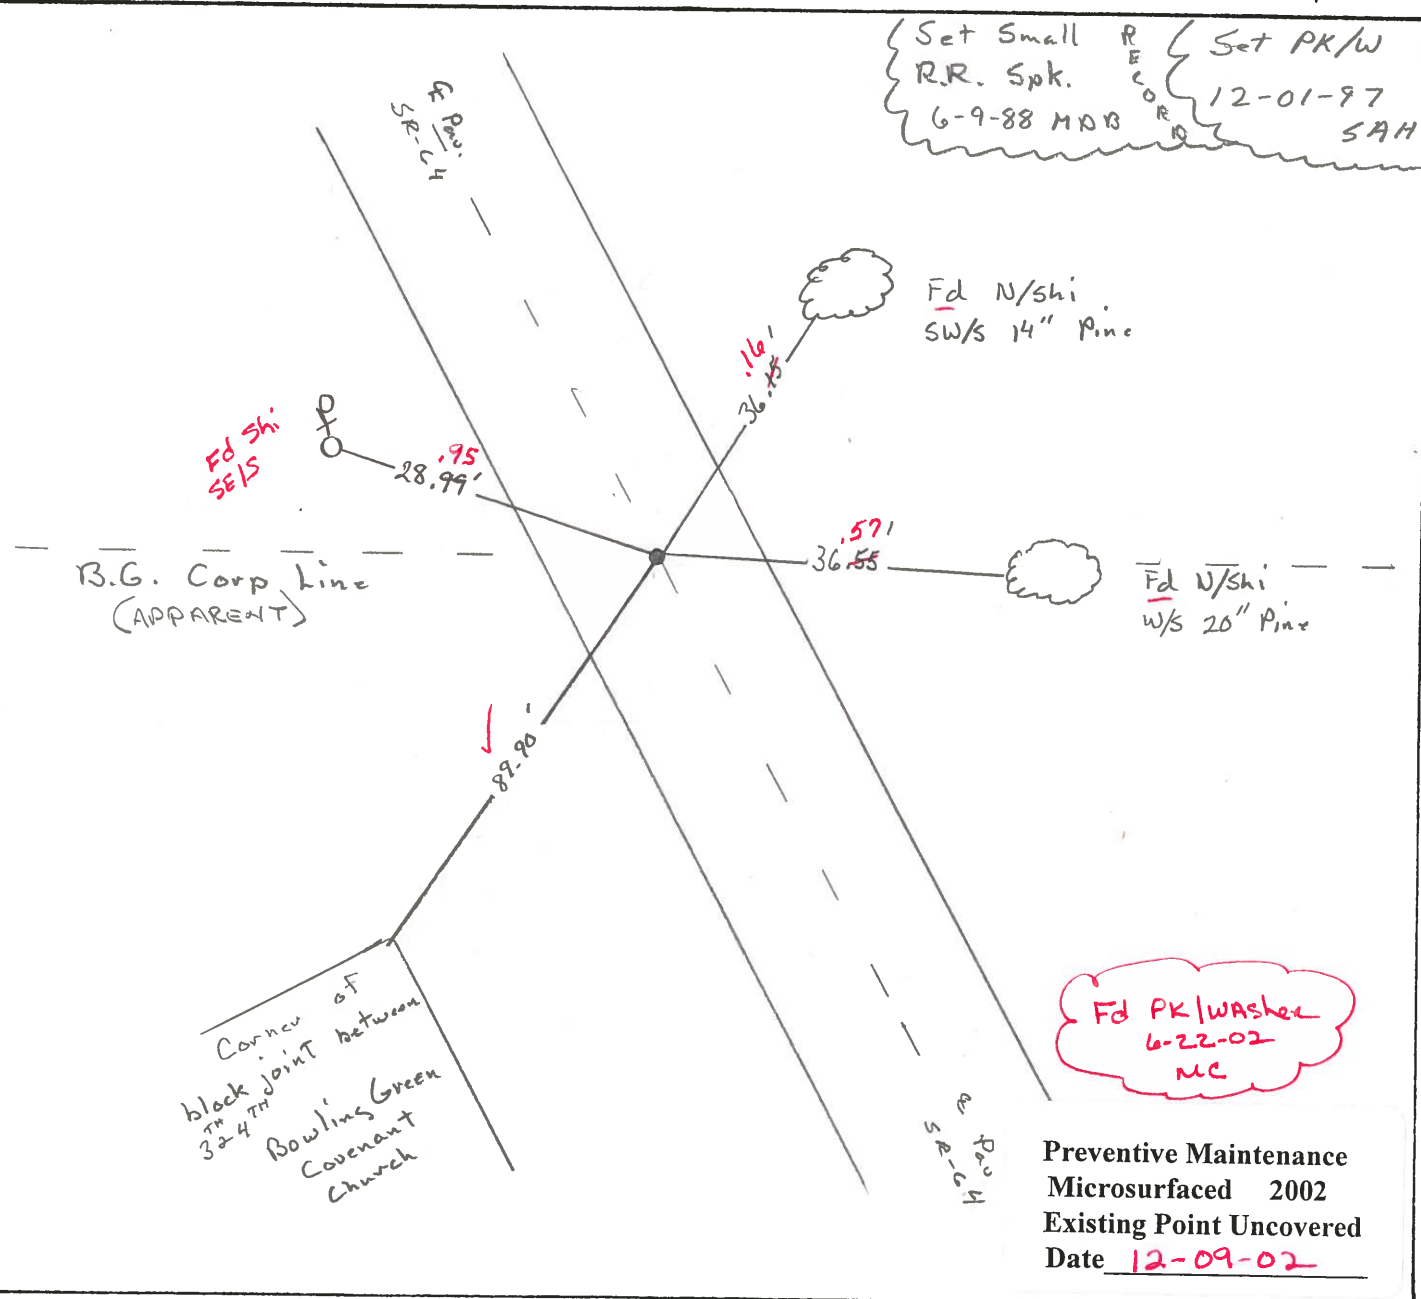

Resurfaced 1997

O.D.O.T. DISTRICT 2 SURVEY OFFICE

PERSONNEL

REFERENCE NO. 7AC

SHEET OF

NOTES HOFFMAN

H.C. LOSHRKE

DATE 4-20-88

ROUTE SR 64

R.C. BARANISER

WEATHER WINDY - CLEAR

COUNTY WOOD

ROAD

TEMP. 42°

TOWNSHIP PLAIN


SECTION 14

T5 N R 10 E

TYPE MONUMENT R.R. SPIKE

Set SMALL RR SPIKE 6-9-88 SWA

ON SURFACE - BELOW YES

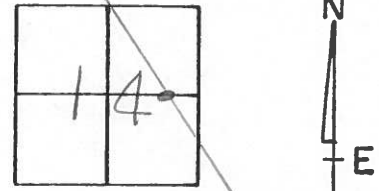

~~LEFT - & PAV'T. - RIGHT~~ YES

8.7 TO RT EDGE PAVEMENT

S.L.M. 218 + 14

